

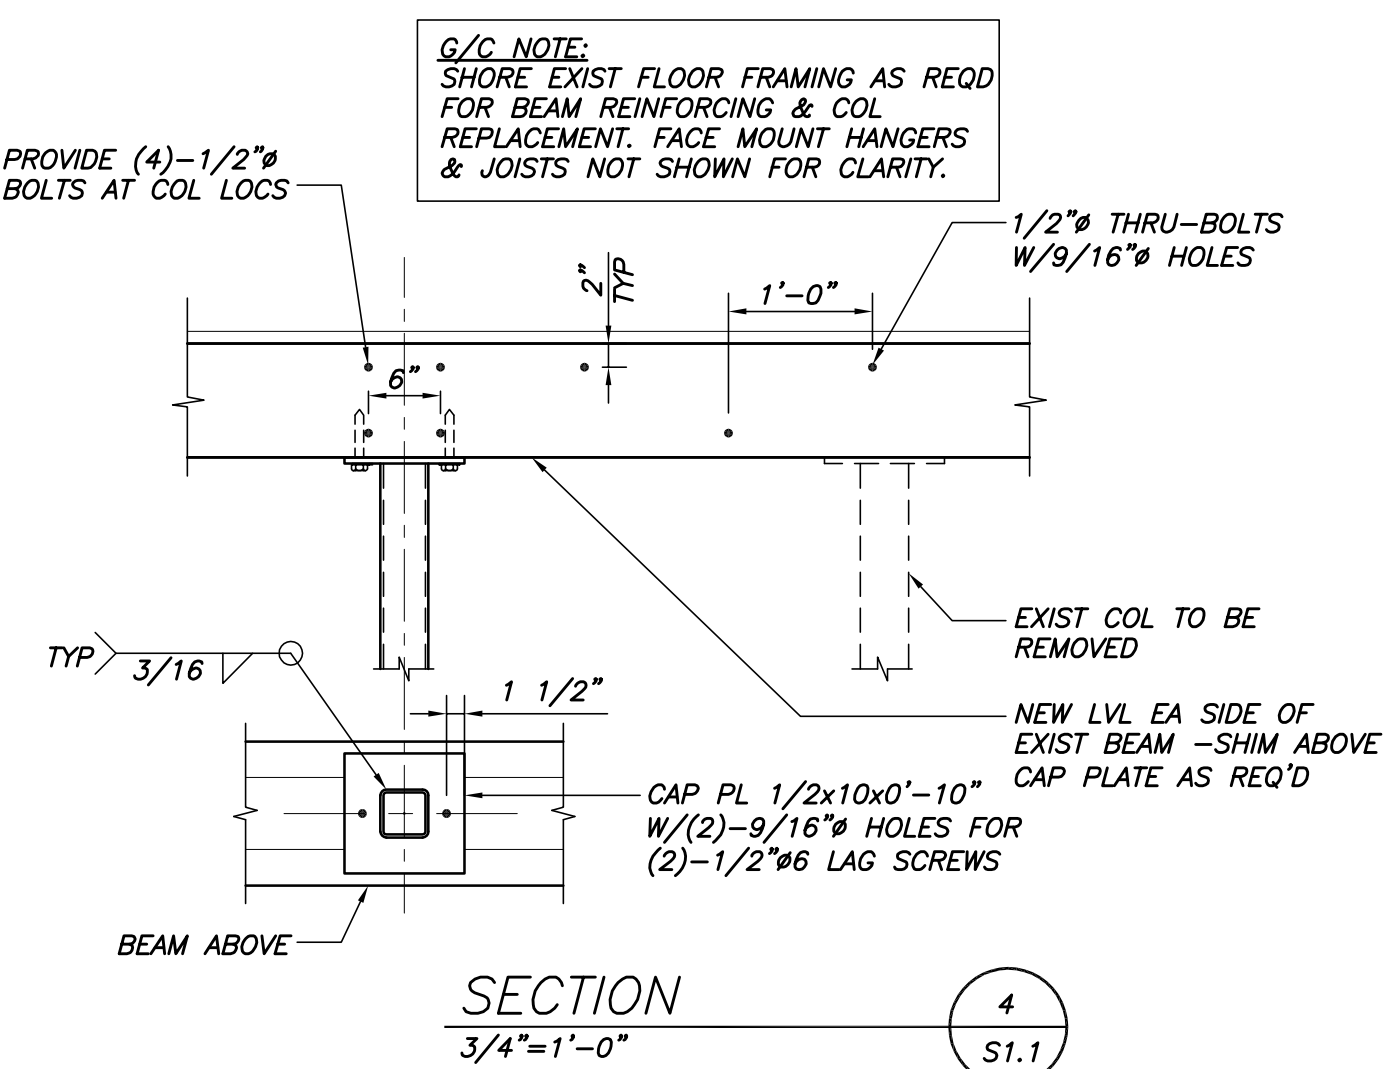
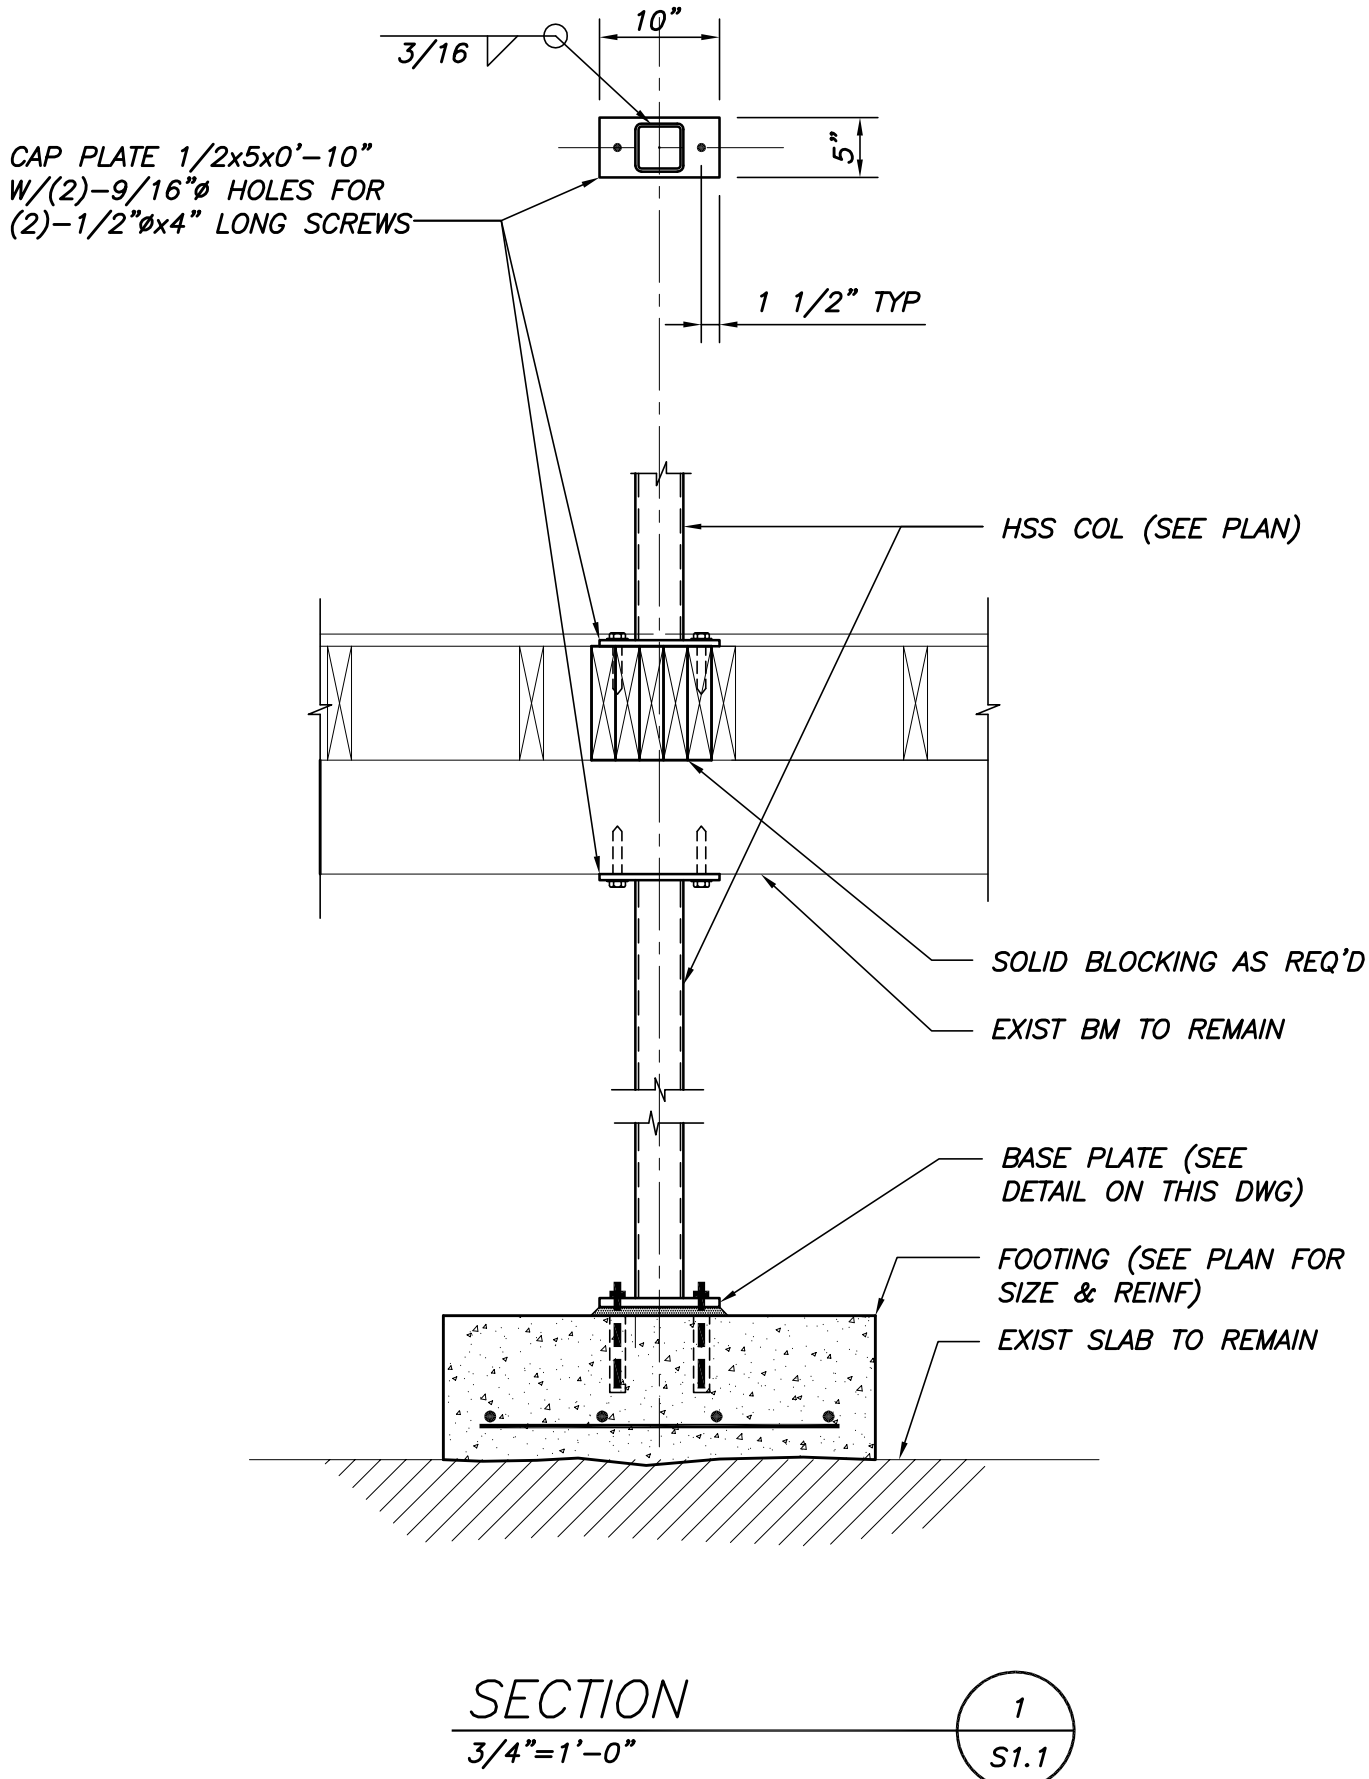
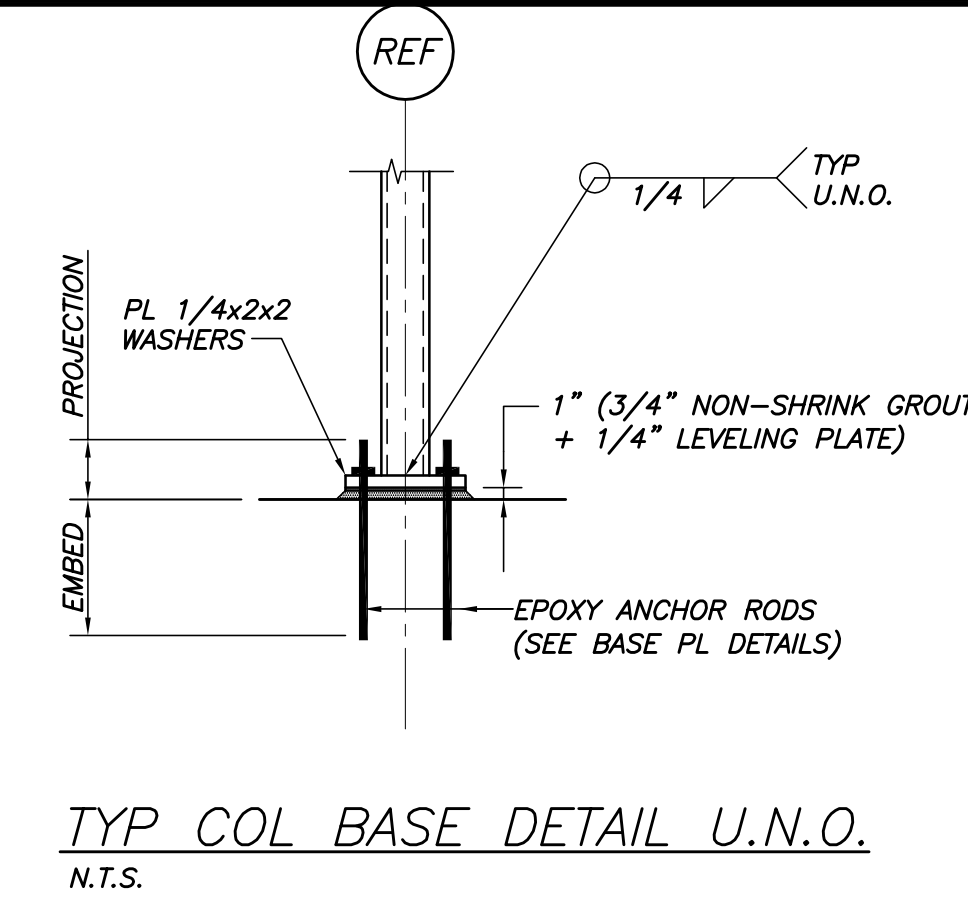
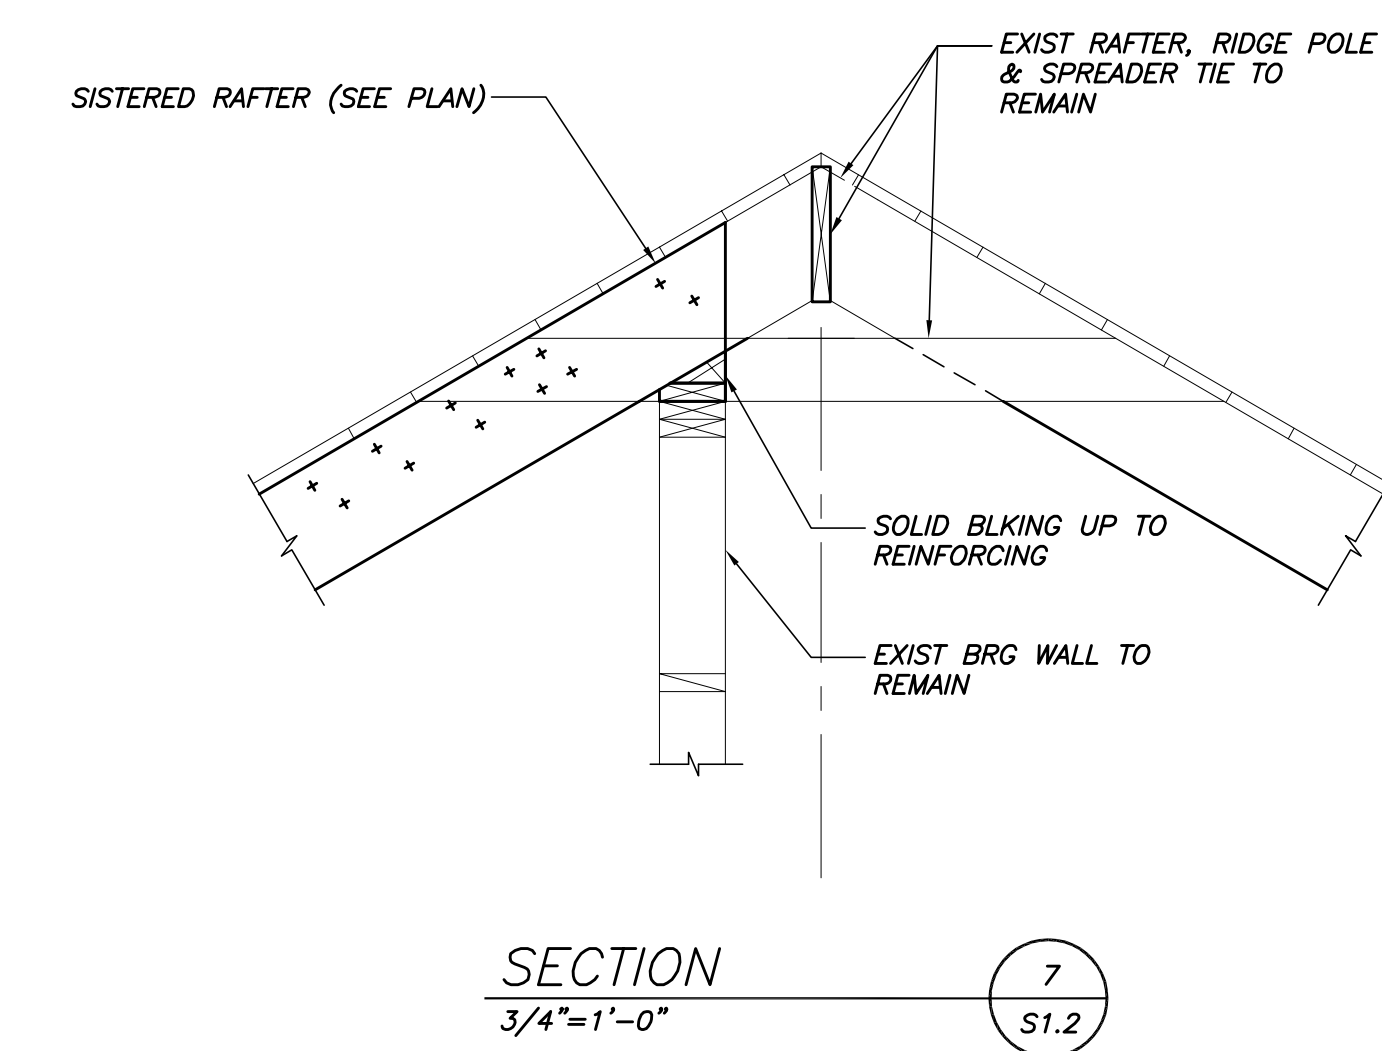
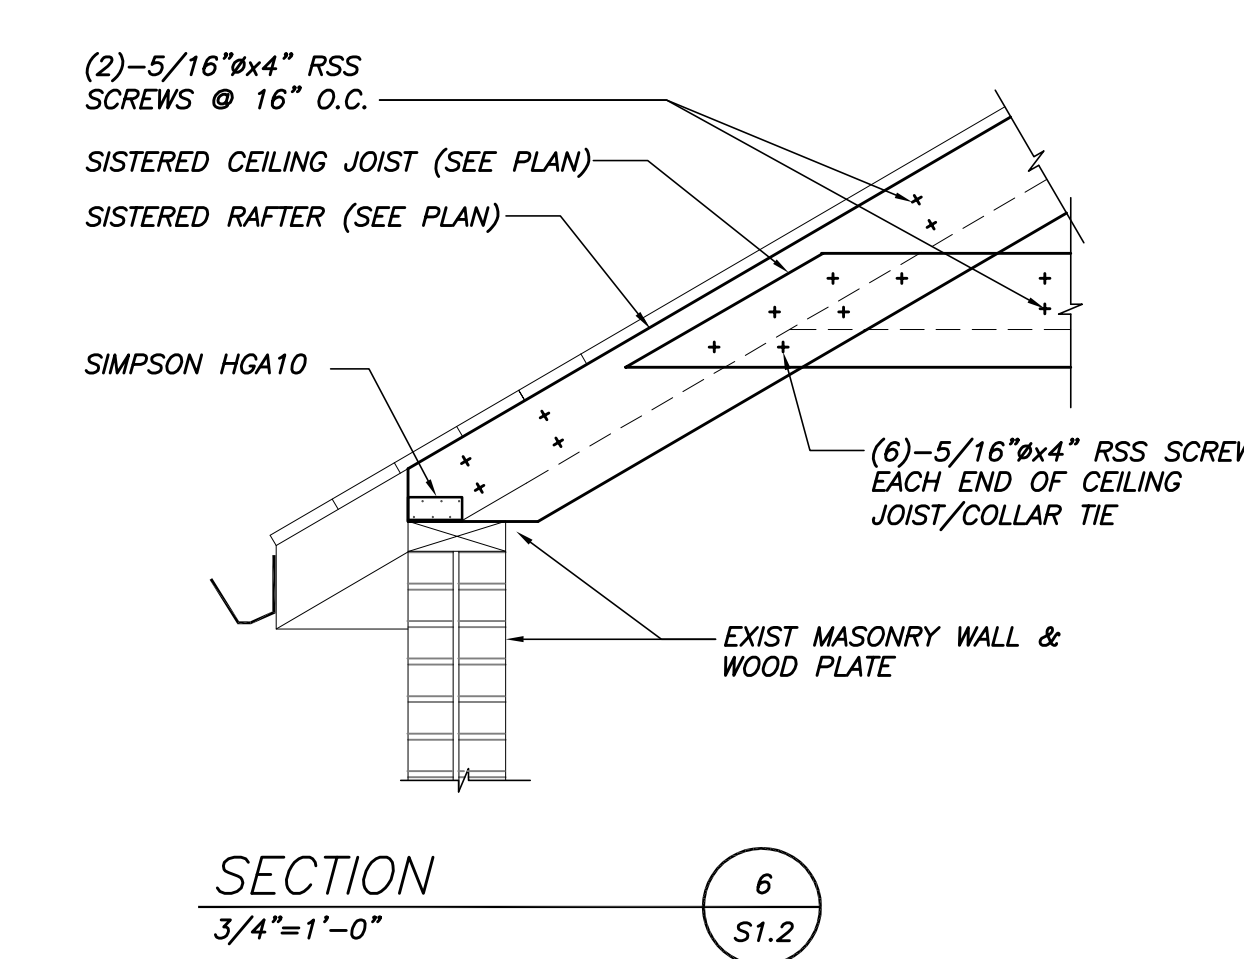
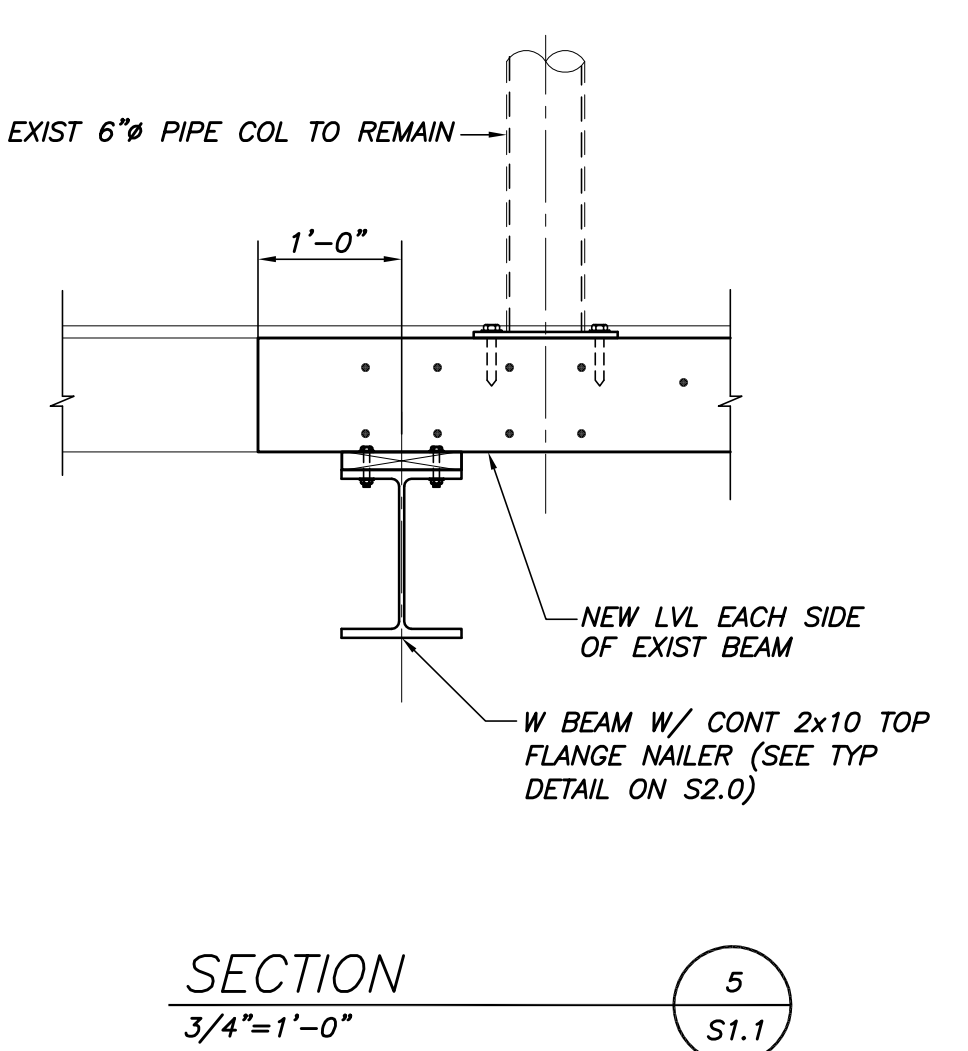



TYP WOOD NAILER/WEB BLKG TO W-BM DETAIL
N.T.S.

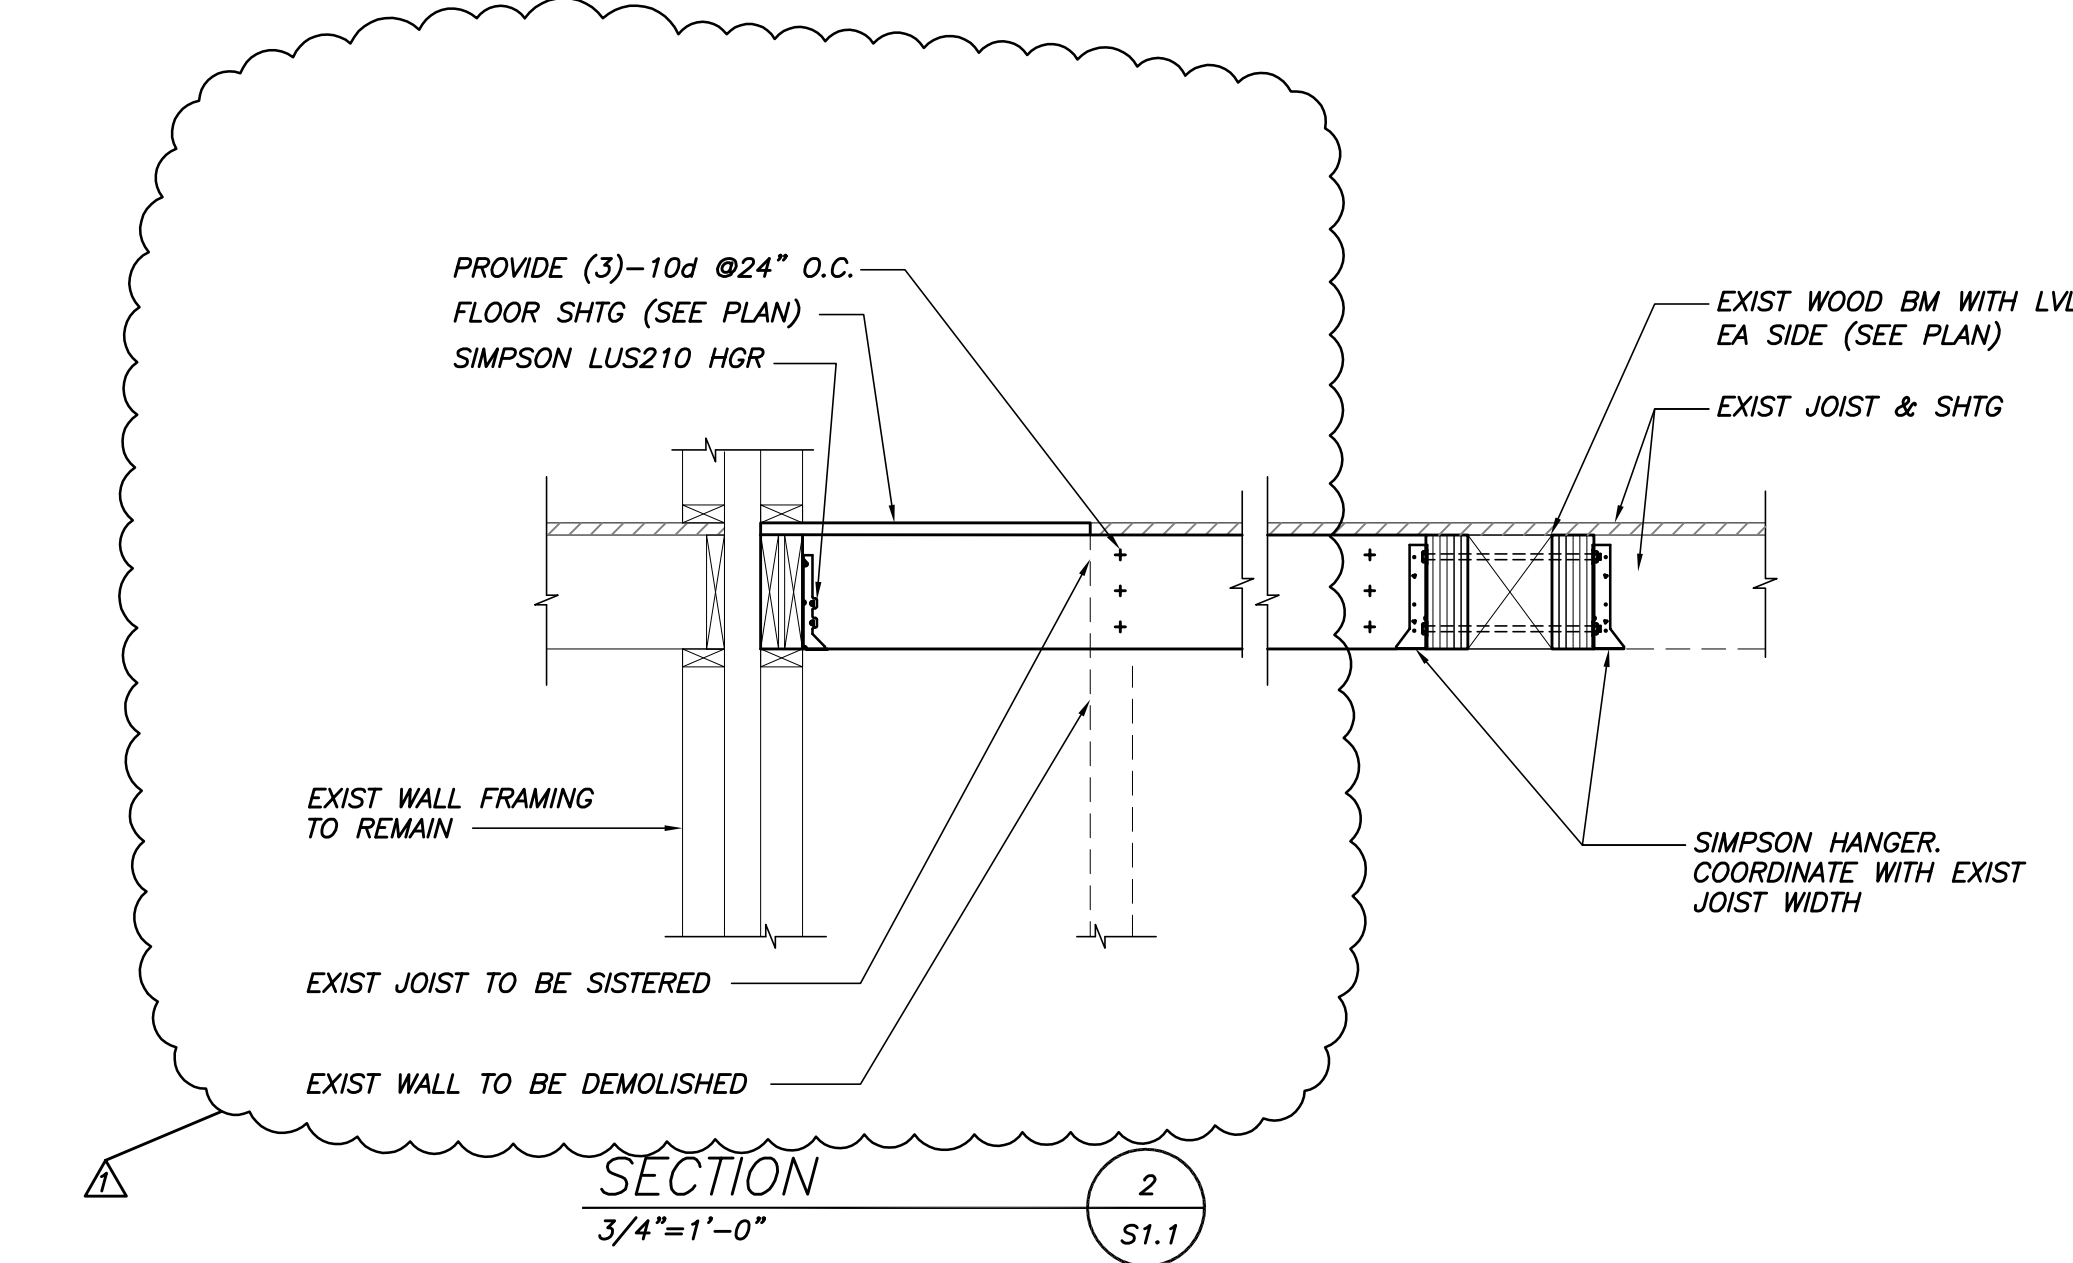


THIS DRAWING IS AN INSTRUMENT OF SERVICE AND SHALL REMAIN THE PROPERTY OF BECKER STRUCTURAL ENGINEERS INC. IT SHALL NOT BE REPRODUCED, COPIED, LENT OR DISPOSED OF DIRECTLY OR INDIRECTLY FOR ANY PURPOSE OTHER THAN FOR WHICH IT IS SPECIFICALLY FURNISHED AND MUST BE RETURNED TO BECKER STRUCTURAL ENGINEERS INC. ON COMPLETION OF WORK, IF REQUESTED.

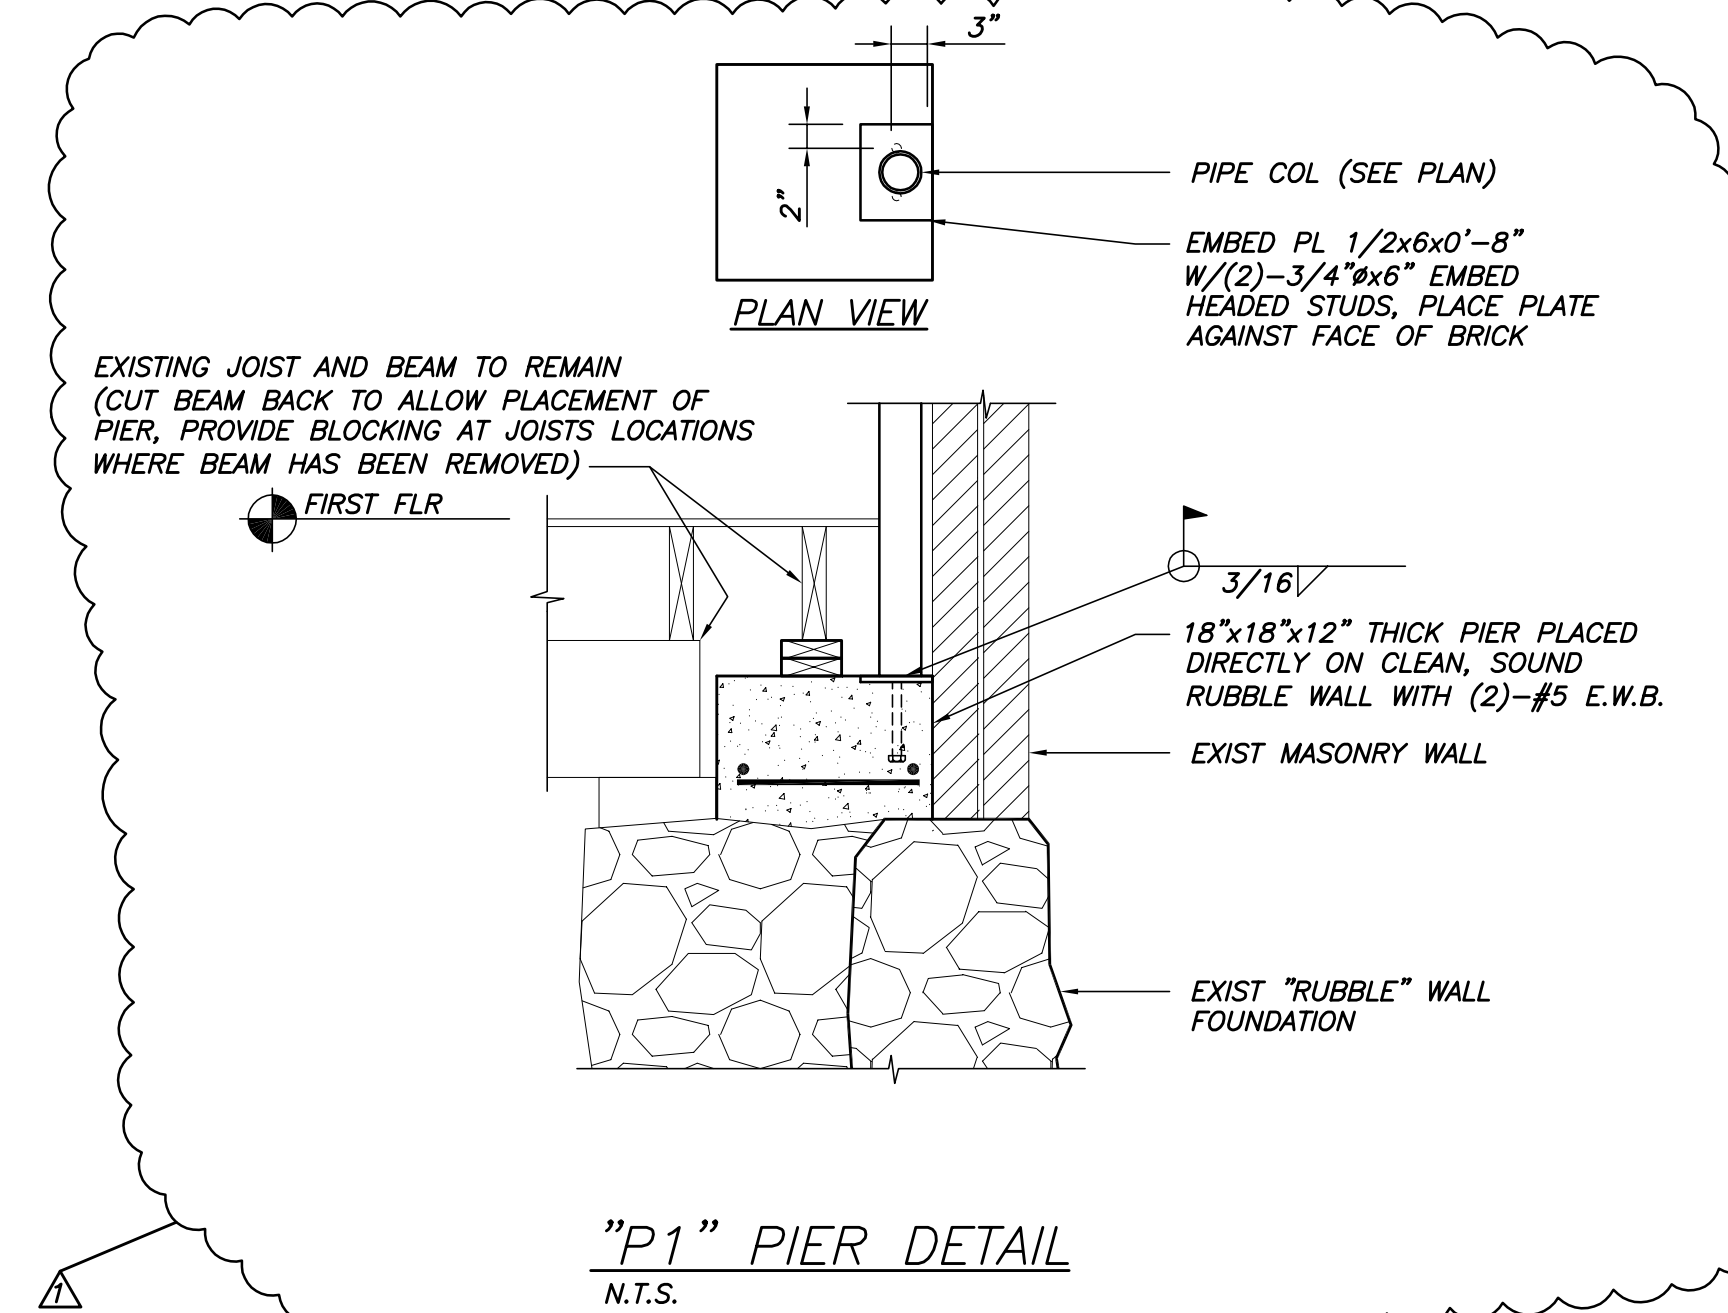

TYP COL BASE DETAIL U.N.O.
N.T.S.

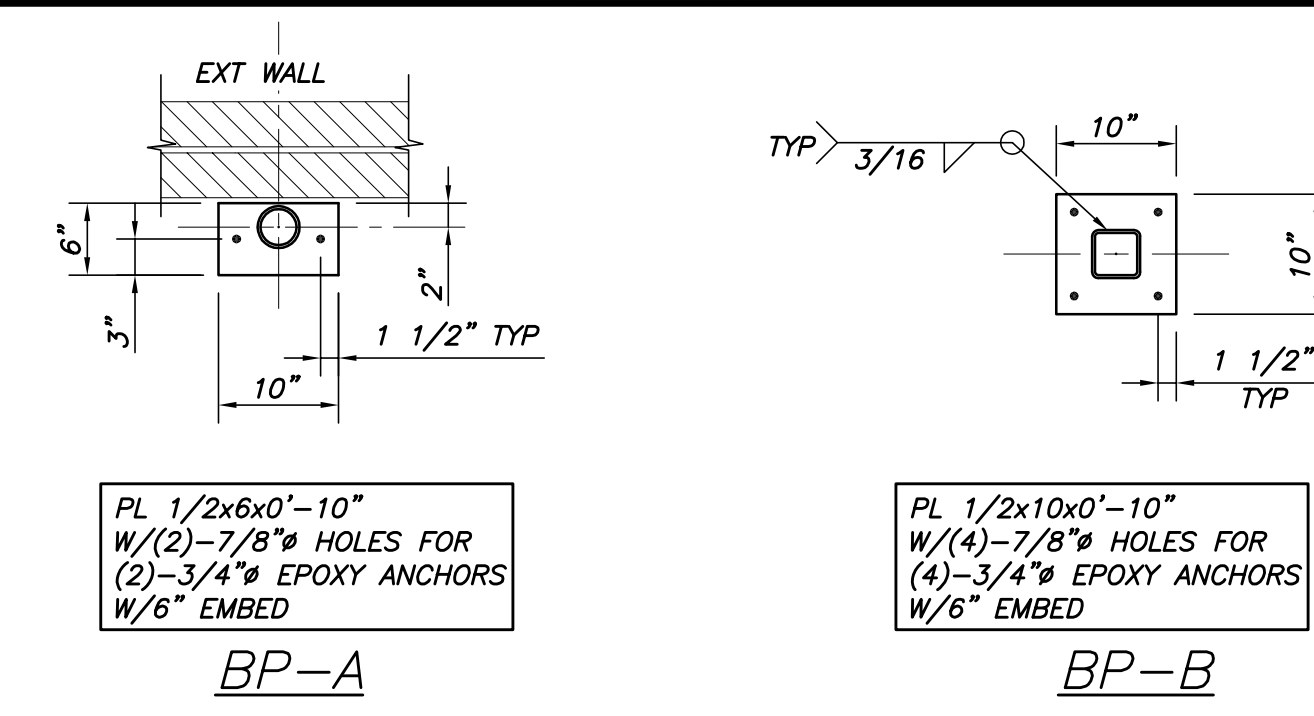

BASE PLATE DETAILS

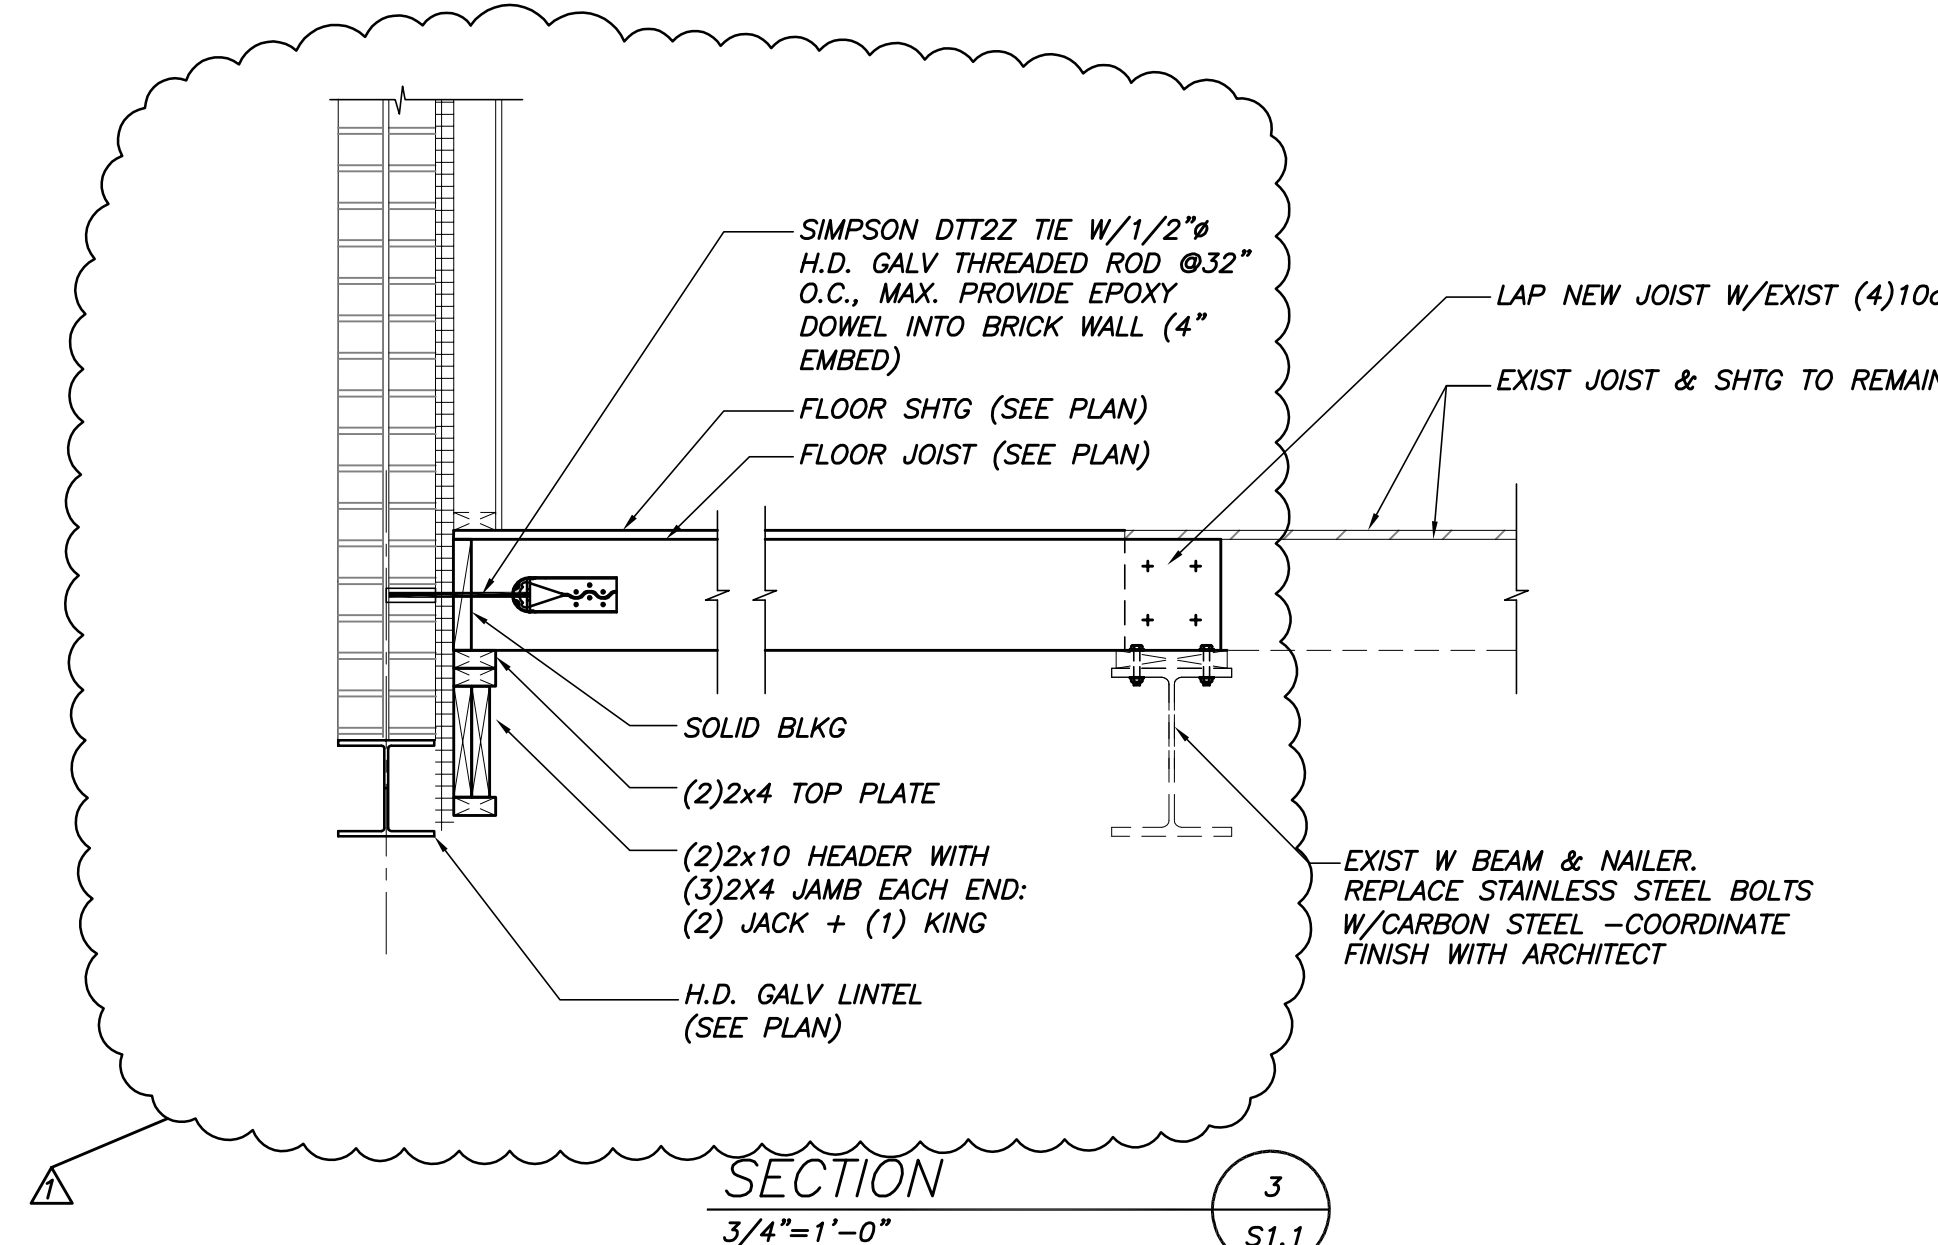

BECKER
STRUCTURAL ENGINEERS
75 York Street, Portland, Maine 04101
207.879.1838 • beckerstructural.com

STATE OF MAINE
NATHAN R. MERRILL
No. 12233
Professional Seal

Appr	X
Issued For	EXISTING CONDITIONS
Date	7/1/15
Rev No	1

PINE ST. RESIDENCE
159 PINE STREET - PORTLAND, ME

SECTIONS AND DETAILS

Designed	NRM	Scale	NOTED
Drawn	MSK	Date	05/05/2015
Checked	DSB	Becker Job Number	3544

S2.1