

GENERAL NOTES:

1. REFERENCE ARCHITECTURAL PLANS FOR DIMENSIONS NOT SHOWN. REFERENCE MECHANICAL, ELECTRICAL, AND ARCHITECTURAL PLANS FOR SIZES AND LOCATIONS OF WALL AND SLAB OPENINGS, DUCTS, PIPING, CURBS, AND EQUIPMENT PADS. IN THE EVENT OF A CONFLICT BETWEEN THE DRAWINGS, SPECIFICATIONS, OR NOTES ON THE DRAWINGS, THE ENGINEER SHALL BE NOTIFIED PRIOR TO CONSTRUCTION.
2. EXISTING DIMENSIONS AND CONDITIONS ARE FOR REFERENCE ONLY. CONTRACTOR SHALL VERIFY ALL EXISTING CONSTRUCTION AND DIMENSIONS IN THE FIELD PRIOR TO CONSTRUCTION OR FABRICATION. ALL DISCREPANCIES SHALL BE REPORTED TO THE ENGINEER PRIOR TO COMMENCING WORK.
3. THE CONTRACTOR SHALL NOTIFY THE ENGINEER IF DEVIATIONS OR CHANGES ARE REQUIRED TO THE CONTRACT DOCUMENTS OR APPROVED SHOP DRAWINGS DUE TO INTERFERENCES, FABRICATION ERRORS, OR OTHER CAUSES.
4. THE STRUCTURE IS SELF-SUPPORTING AND STABLE AFTER THE ENTIRE BUILDING IS COMPLETELY CONSTRUCTED. THE CONTRACTOR IS SOLELY RESPONSIBLE FOR ERECTION PROCEDURES AND SEQUENCING DURING CONSTRUCTION AND ERECTION TO PROVIDE AND ENSURE LOCAL AND OVERALL STABILITY OF THE BUILDING AND ITS COMPONENTS DURING CONSTRUCTION AND ERECTION. THE CONTRACTOR SHALL RETAIN A LICENSED STRUCTURAL ENGINEER TO DESIGN TEMPORARY BRACING/SHORING AND DETERMINE WHERE THE TEMPORARY BRACING/SHORING IS NEEDED.
5. THE CONTRACTOR SHALL BE RESPONSIBLE FOR ERECTION PROCEDURES, SEQUENCING AND FOR COMPLYING WITH ALL APPLICABLE SAFETY REGULATIONS DURING THE WORK.
6. ONE ELECTRONIC COPY OR TWO SETS OF HARD COPIES OF SHOP DRAWINGS SHALL BE SUBMITTED TO THE ENGINEER. ONE HARD COPY WILL BE RETURNED TO THE CONTRACTOR AND ONE HARD COPY WILL BE RETAINED BY THE ENGINEER.
7. REFERENCE THE PROJECT SPECIFICATIONS FOR MATERIAL, WORKMANSHIP AND ADDITIONAL INFORMATION NOT COVERED IN THESE NOTES (WHERE APPLICABLE)

DESIGN CRITERIA:


1. BUILDING CODES:
INTERNATIONAL BUILDING CODE (IBC), 2009 EDITION
ASCE 7-05 MINIMUM DESIGN LOADS FOR BUILDING AND OTHER STRUCTURES
MAINE UNIFORM BUILDING AND ENERGY CODE
2. LIVE LOADS:
ROOF LIVE LOAD = 20 PSF
3. SNOW LOADS:
GROUND SNOW LOAD (Pg) = 60 PSF
SNOW EXPOSURE FACTOR (Ce) = 1.0
SNOW LOAD IMPORTANCE FACTOR (Is) = 1.0
THERMAL FACTOR (Ct) = 1.1
FLAT ROOF SNOW LOAD (Pf) = 46.2 PSF + DRIFT
4. WIND LOADS:
BASIC WIND SPEED = 100 MPH
IMPORTANCE FACTOR (Iw) = 1.0
WIND EXPOSURE B

WOOD NOTES:

1. ALL TIMBER FRAMING SHALL BE IN ACCORDANCE WITH IBC 2009 REFERENCED EDITIONS OF THE AITC TIMBER CONSTRUCTION MANUAL AND AF&PA NATIONAL DESIGN SPECIFICATION FOR WOOD CONSTRUCTION (NDS).
2. ALL FRAMING SHALL BE SPRUCE-PINE-FIR, No.2 OR BETTER U.N.O. AND HAVE A MAXIMUM MOISTURE CONTENT OF 19%.
3. ALL WOOD IN CONTACT WITH MASONRY OR CONCRETE OR EXPOSED TO WEATHER SHALL BE PRESSURE TREATED (PT) SOUTHERN YELLOW PINE.
4. WHERE BEAMS ARE LABELED ON PLAN, DO NOT SPLICE BEAM NOR ANY PLY OF BEAM BETWEEN SUPPORTS.
5. FASTENERS USED IN CONTACT WITH PRESSURE TREATED (PT) LUMBER SHALL BE HOT-DIPPED GALVANIZED, STAINLESS STEEL, OR OTHER FINISH APPROVED BY ENGINEER.
6. ALIGN COLUMNS SUCH THAT COLUMNS BEAR CONTINUOUSLY TO FOUNDATION SUPPORT. INSTALL ADDITIONAL SOLID BLOCKING WITHIN FLOOR PACKAGE TO PROVIDE CONTINUITY OF LOAD PATH.
7. PROVIDE HORIZONTAL BLOCKING FOR ALL LOAD BEARING WALLS AT 4'-0" O.C. VERTICAL, MAXIMUM.

MASONRY NOTES:

1. GROUT SHALL CONFORM WITH ASTM C476 WITH MINIMUM COMPRESSIVE STRENGTH = 3,000 PSI
2. VERTICAL REINFORCEMENT, BOND BEAM REINFORCEMENT AND REINFORCEMENT IN LINTELS SHALL CONFORM TO ASTM A615, GRADE 60 DEFORMED BARS.

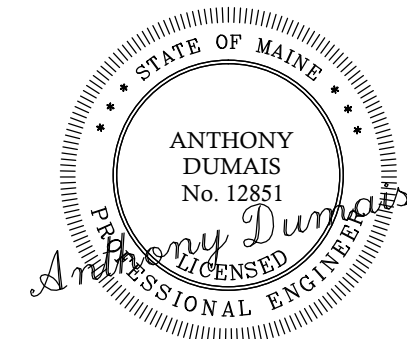

424 Fore Street
Portland, ME 04101
Phone 207.842.2800
Fax 207.842.2828
www.cascobayengineering.com

CLIENT:
JAY VILLANI
20 SALEM STREET
PORTLAND, ME 04102

**BUNKER BREWING
NEW CHILLER UNIT**
17 WESTFIELD STREET
PORTLAND, MAINE

No.	DATE	DESCRIPTION	ISSUE			
			ISSUED FOR CONSTRUCTION			
0	5-24-16					

SHEET TITLE:
**STRUCTURAL
NOTES**

DESIGNED: TD
DRAWN: TD
DATE: 3-16-16
PROJECT No: 16-038

SKO