


NORTH

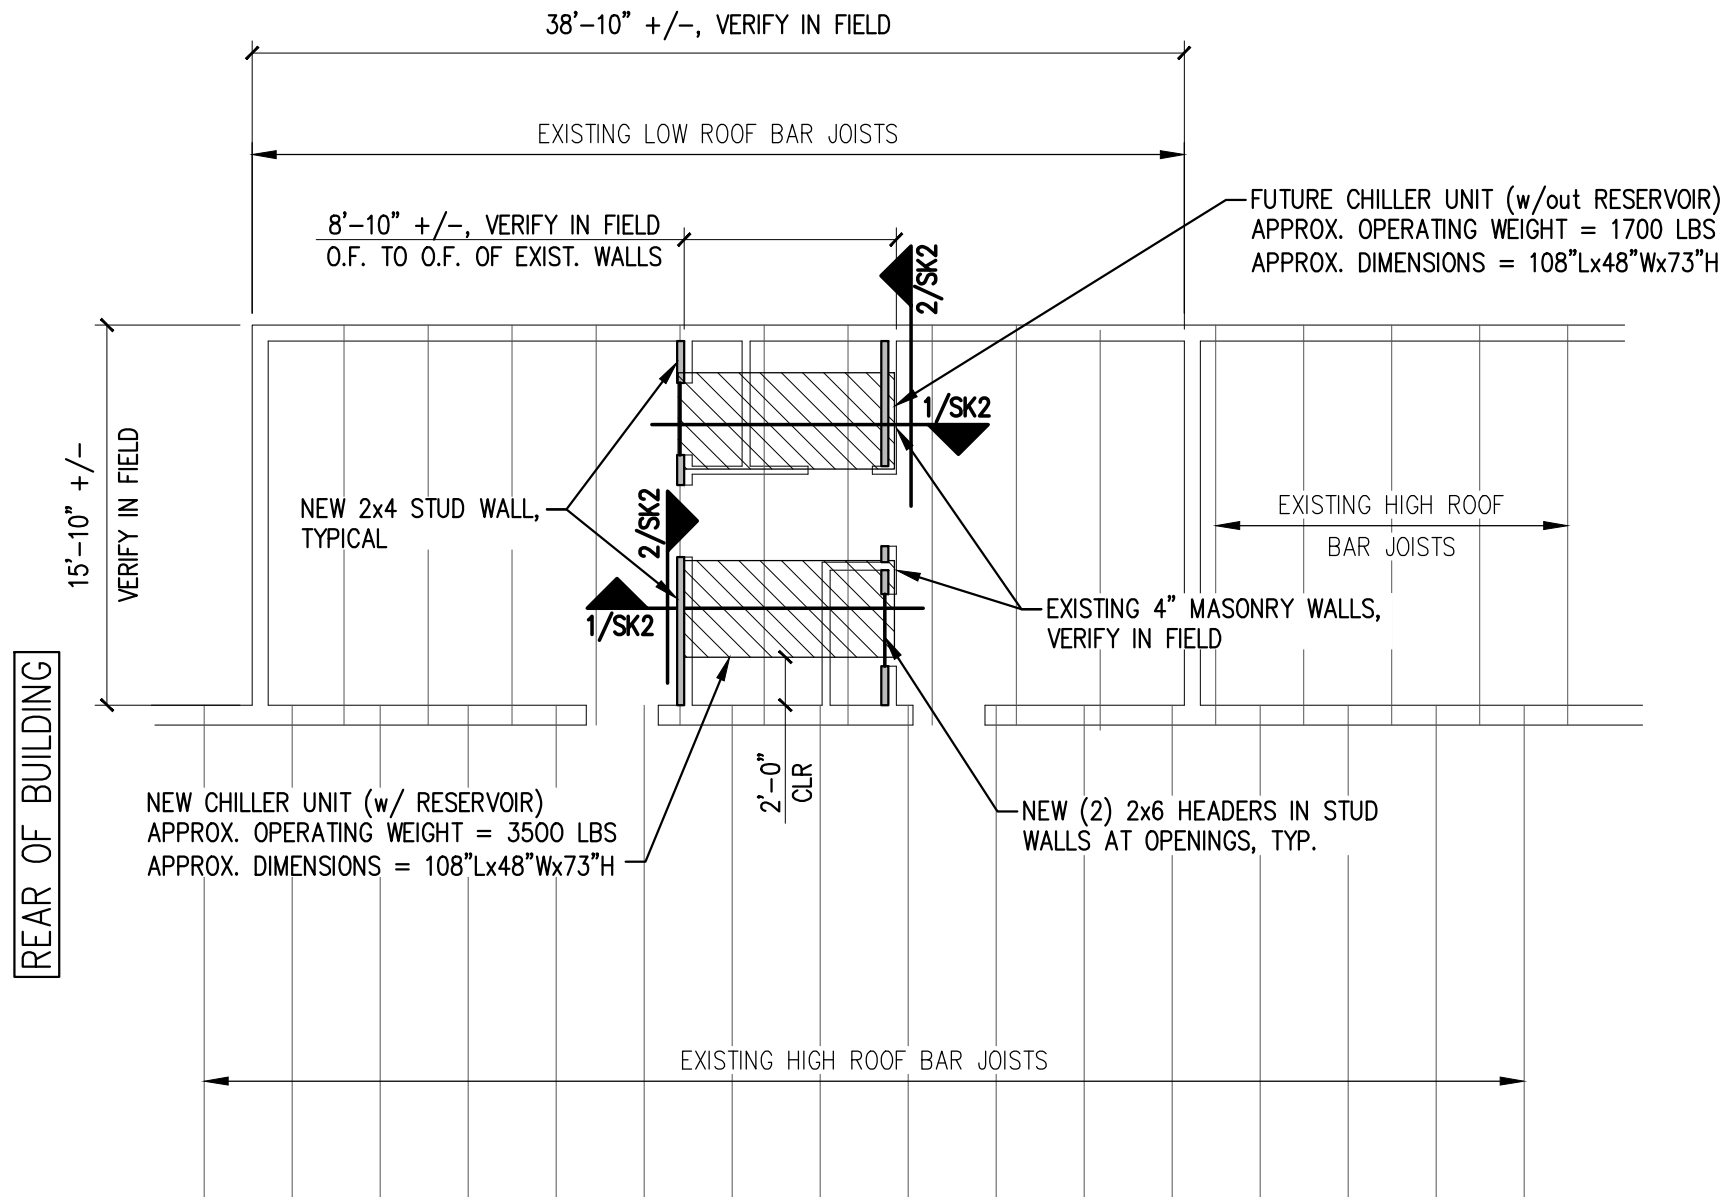



NOTES:

1. VERIFY EXISTING CONDITIONS IN FIELD AND NOTIFY ENGINEER OF ANY DISCREPANCIES.
2. VERIFY EXACT CHILLER DIMENSIONS WITH MANUFACTURER
3. FILL ANY OPENINGS IN EXISTING CMU WALLS UNDER NEW CHILLER UNITS SOLID WITH MASONRY & GROUT FOR CONTINUOUS BEARING
4. CONNECTION OF CHILLER UNIT TO WOOD CURB NOT DESIGNED BY CASCO BAY ENGINEERING

PARTIAL ROOF FRAMING PLAN

SCALE: 1/8"=1'-0"

1

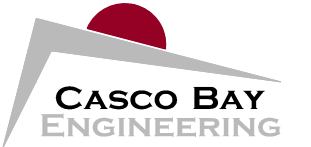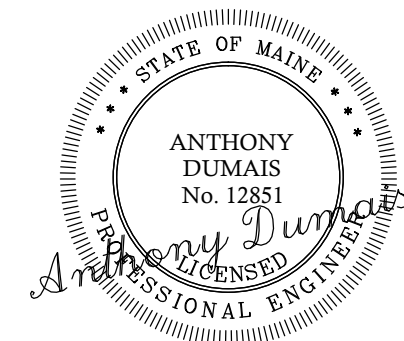

424 Fore Street
 Portland, ME 04101
 Phone 207.842.2800
 Fax 207.842.2828
www.cascobayengineering.com

CLIENT:

JAY VILLANI
 20 SALEM STREET
 PORTLAND, ME 04102

**BUNKER BREWING
 NEW CHILLER UNIT**
 17 WESTFIELD STREET
 PORTLAND, MAINE

ISSUE		DESCRIPTION
No.	DATE	ISSUED FOR CONSTRUCTION
0	5-24-16	

SHEET TITLE:

PARTIAL ROOF FRAMING PLAN

DESIGNED: TD
 DRAWN: TD
 DATE: 3-16-16
 PROJECT No: 16-038

SK1