


SECTION

SCALE: 3/8"=1'-0"

1

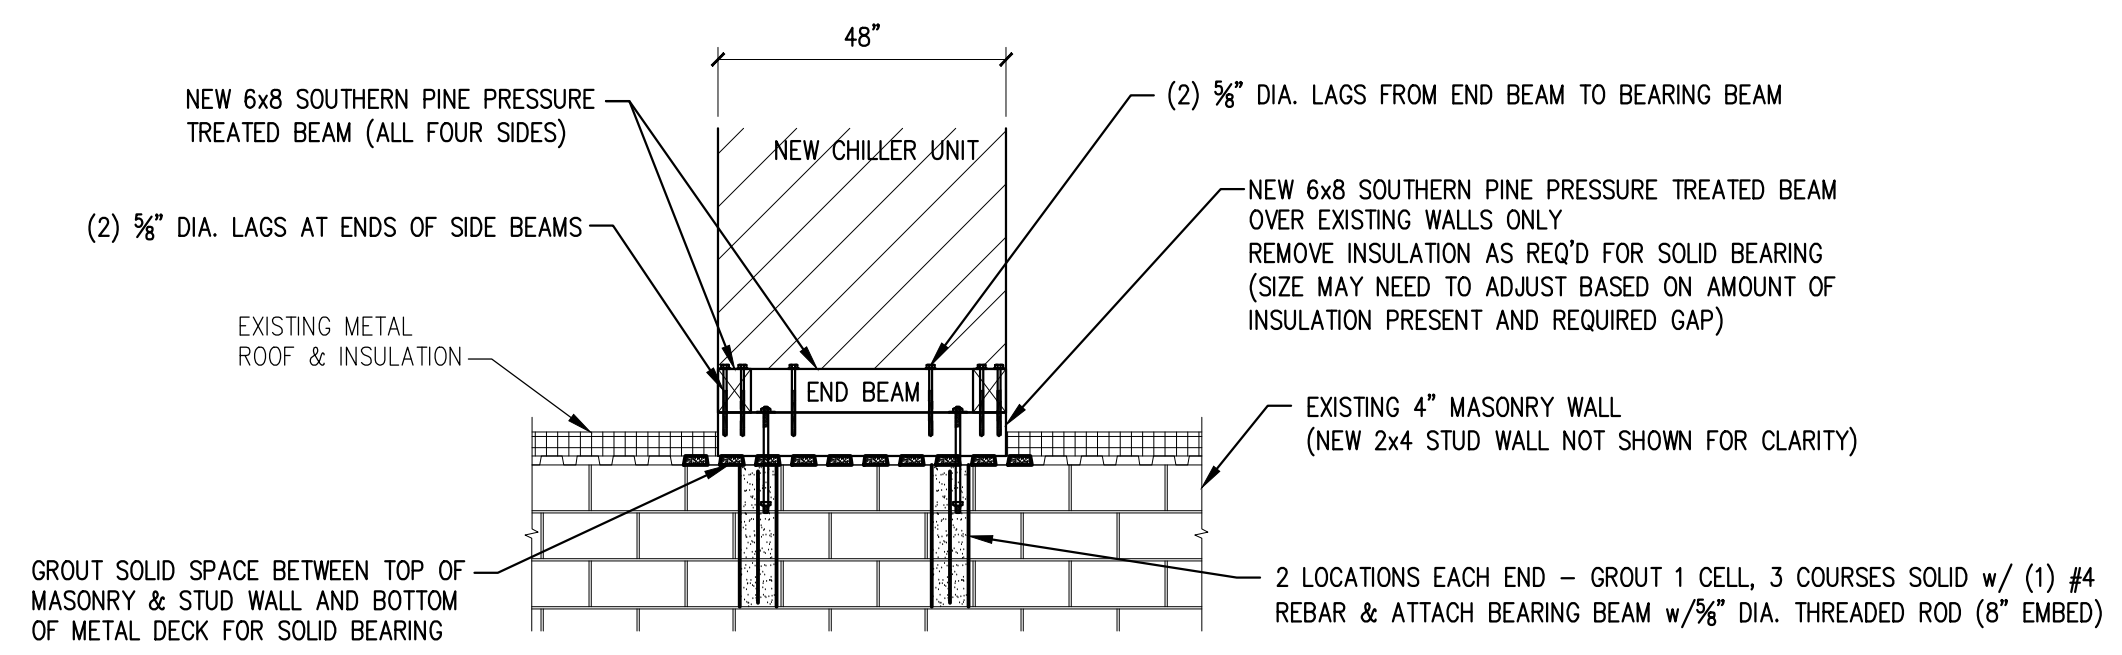

SECTION


SCALE: 3/8"=1'-0"

2

ISSUE		DESCRIPTION
No.	DATE	ISSUED FOR CONSTRUCTION
0	5-24-16	

SHEET TITLE:
**FRAMING
DETAILS**

DESIGNED:	TD
DRAWN:	TD
DATE:	3-16-16
PROJECT No:	16-038

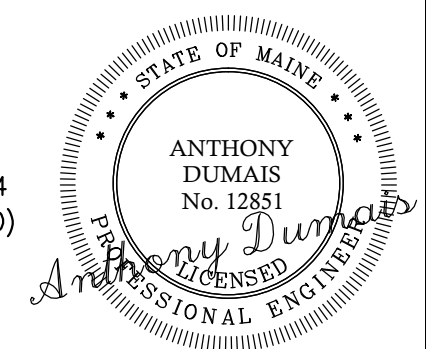

SK2