


New

New Bata
as of 2/29/15

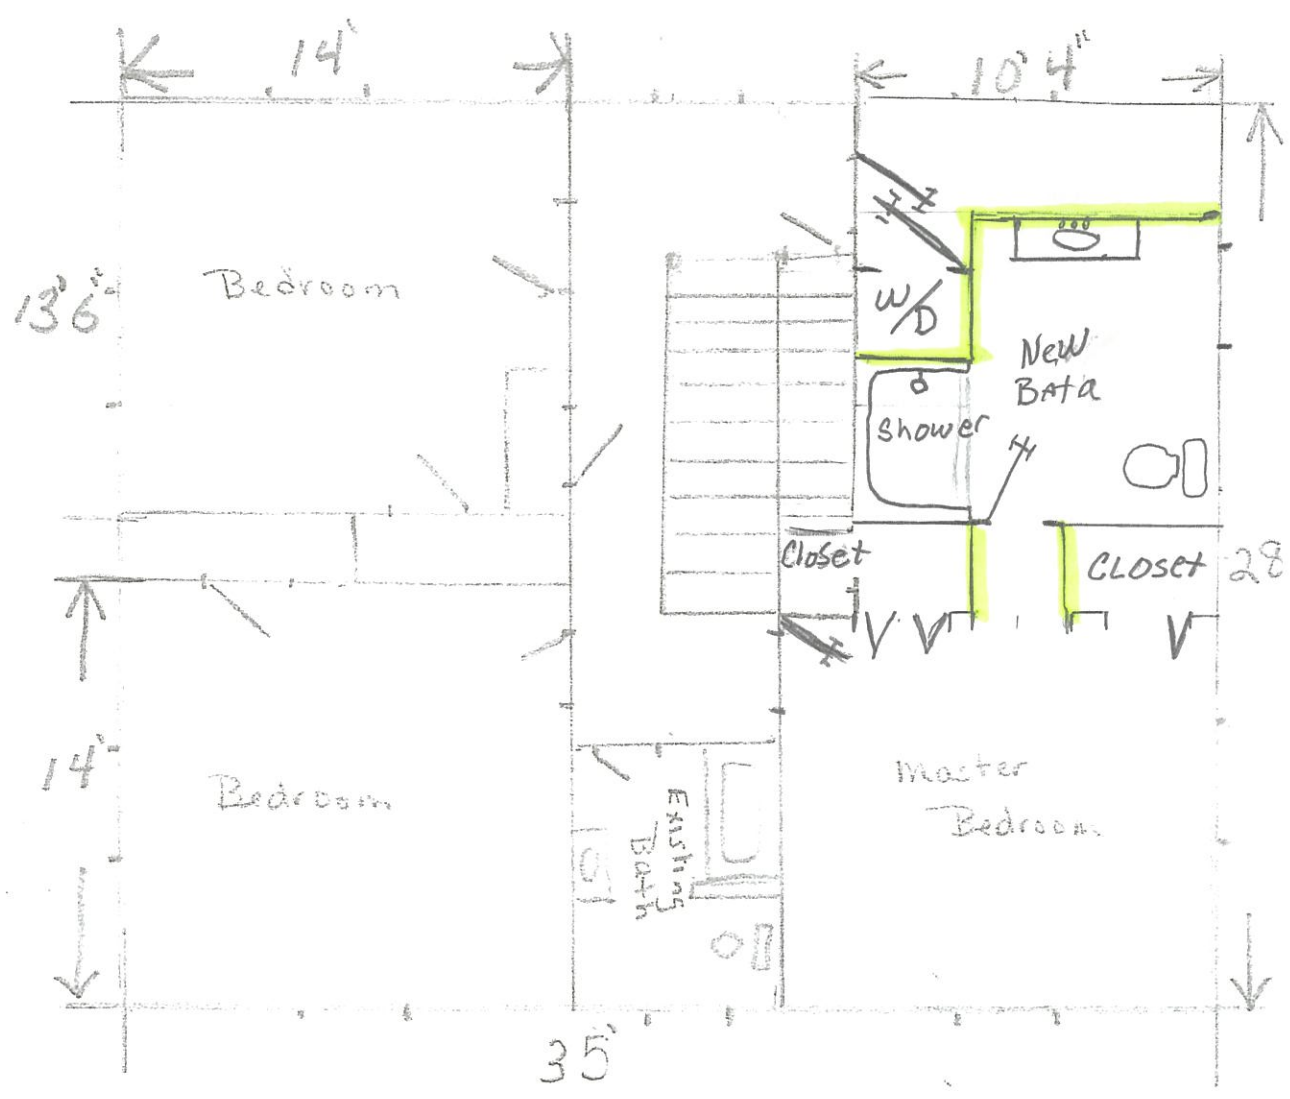

Kenwood Street
Box 32

Lot 54