

Please show 2010 ADA Standards compliance with clearances, grab bars and accessories.

1 PLAN SECTION
 A1.1 Scale: 1/2"=1'-0"


ALL CABINETRY FACES & CABINET DOORS MIN. 1" THICK
 ALL CABINETRY BACKS MIN. 1/2", (THICKER IF STRUCTURE REQUIRES)
 ALL OPEN SHELVEING TO HAVE 1/2" BEADED BOARD BACKS
 ALL CABINETRY PAINT GRADE, BRUSH PAINTED ON SITE IN OIL
 ALL OPEN CABINETRY PAINTED INSIDE, BRUSH PAINTED ON SITE IN OIL
 INTERIOR OF CLOSED CABINETS CAN BE PREFINISHED MAPLE OR SIMILAR, WITH 3/4" PREFINISHED SHELVEING (PLEASE ENSURE 3/4" THICKNESS WILL NOT BEND FROM WEIGHT OR LENGTH OF SHELF)
 PAINT ALL EXPOSED BRICK
 SEE FULL SCALE STEPPED PANEL MOULDING FOR DOOR PANELS, WALL PANELS, & RECESSED PANELS,
 ALL OPEN SHELVEING SURROUNDS HAVE A BEAD DETAIL AT OPENING, SEE FULL SCALE PROFILE
 DOUBLESIDED COUNTER TO HAVE 1-1/4" WALNUT TOP (OR SIMILAR HARDWOOD) STAINED AND FINISHED IN OIL BAEDS ATIN FINISH POLYURETHANE, 2 COATS MINIMUM
 COUNTER, UNDER WINDOWS, HONED AND SEALED CARRARA MARBLE 1-1/4" SLAB

ALL DIMENSIONS MUST BE VERIFIED IN THE FIELD PRIOR TO CONSTRUCTION

86 PONDFIELD ROAD WEST, BRONXVILLE, NEW YORK 10708

REVISIONS

DATE	REMARKS

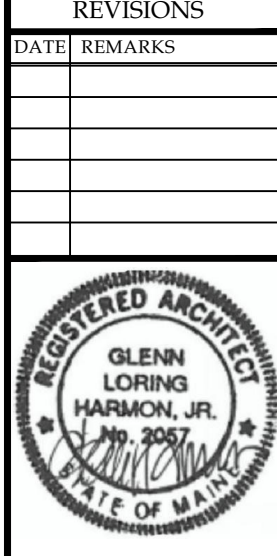

DIAMOND COVE GENERAL STORE
 PLAN SECTION

© COPYRIGHT 2017
 NASTASI VAIL DESIGN, LLC
 THIS DRAWING IS THE PROPERTY OF THE ARCHITECT AND IS NOT TO BE REPRODUCED OR TRANSMITTED IN ANY FORM OR BY ANY MEANS, ELECTRONIC OR MECHANICAL, WITHOUT THE WRITTEN PERMISSION.

NASTASI VAIL DESIGN, LLC

MRS. ALEXANDRA WIGHT
 GENERAL STORE, GREAT DIAMOND ISLAND
 PORTLAND, MAINE 04109

DATE: 1/24/18
 SCALE: 1/2"=1'-0"
 SHEET NO: A1.1