

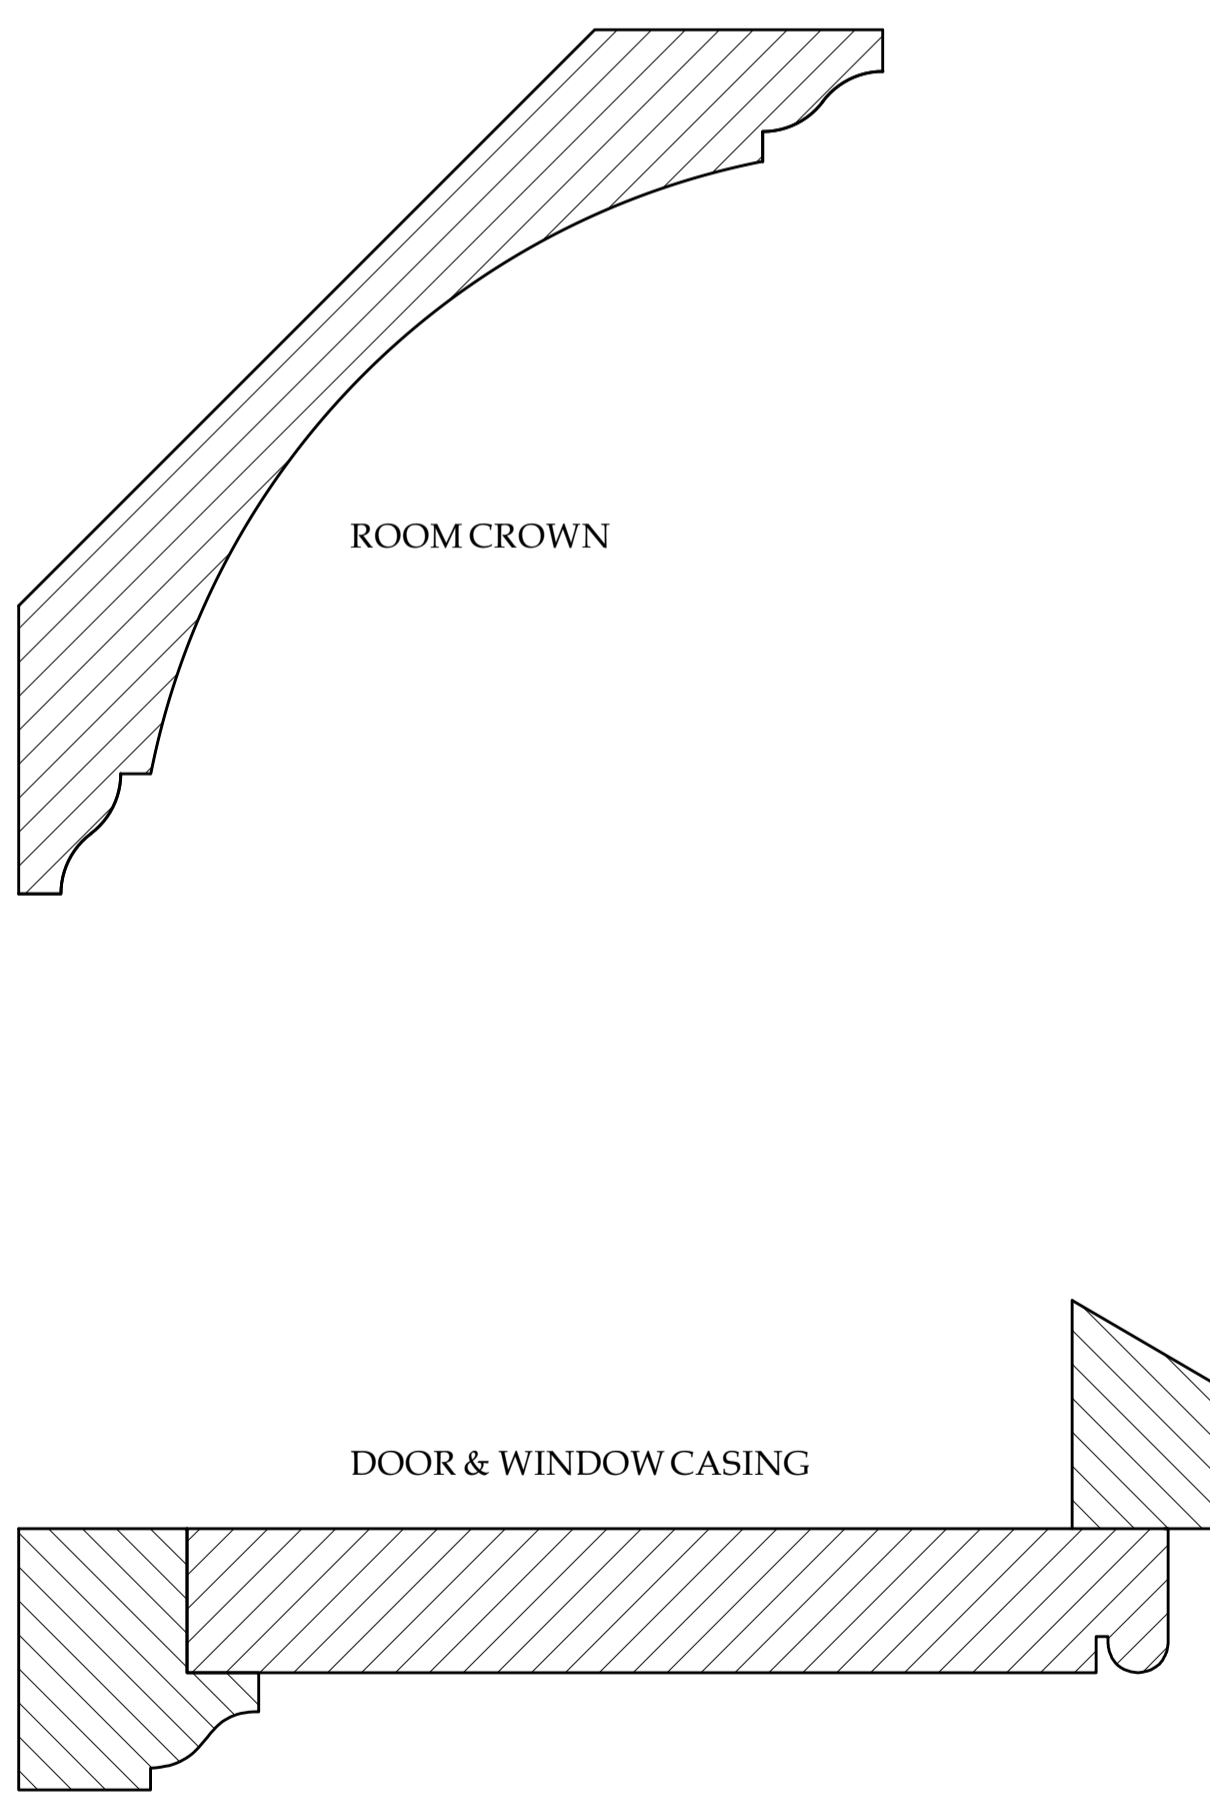


Please show 2010 ADA Standards compliance with door, toilet room and fixture clearances.

1 RESTROOM: PLAN SECTION
 Scale: 3/4"=1'-0"

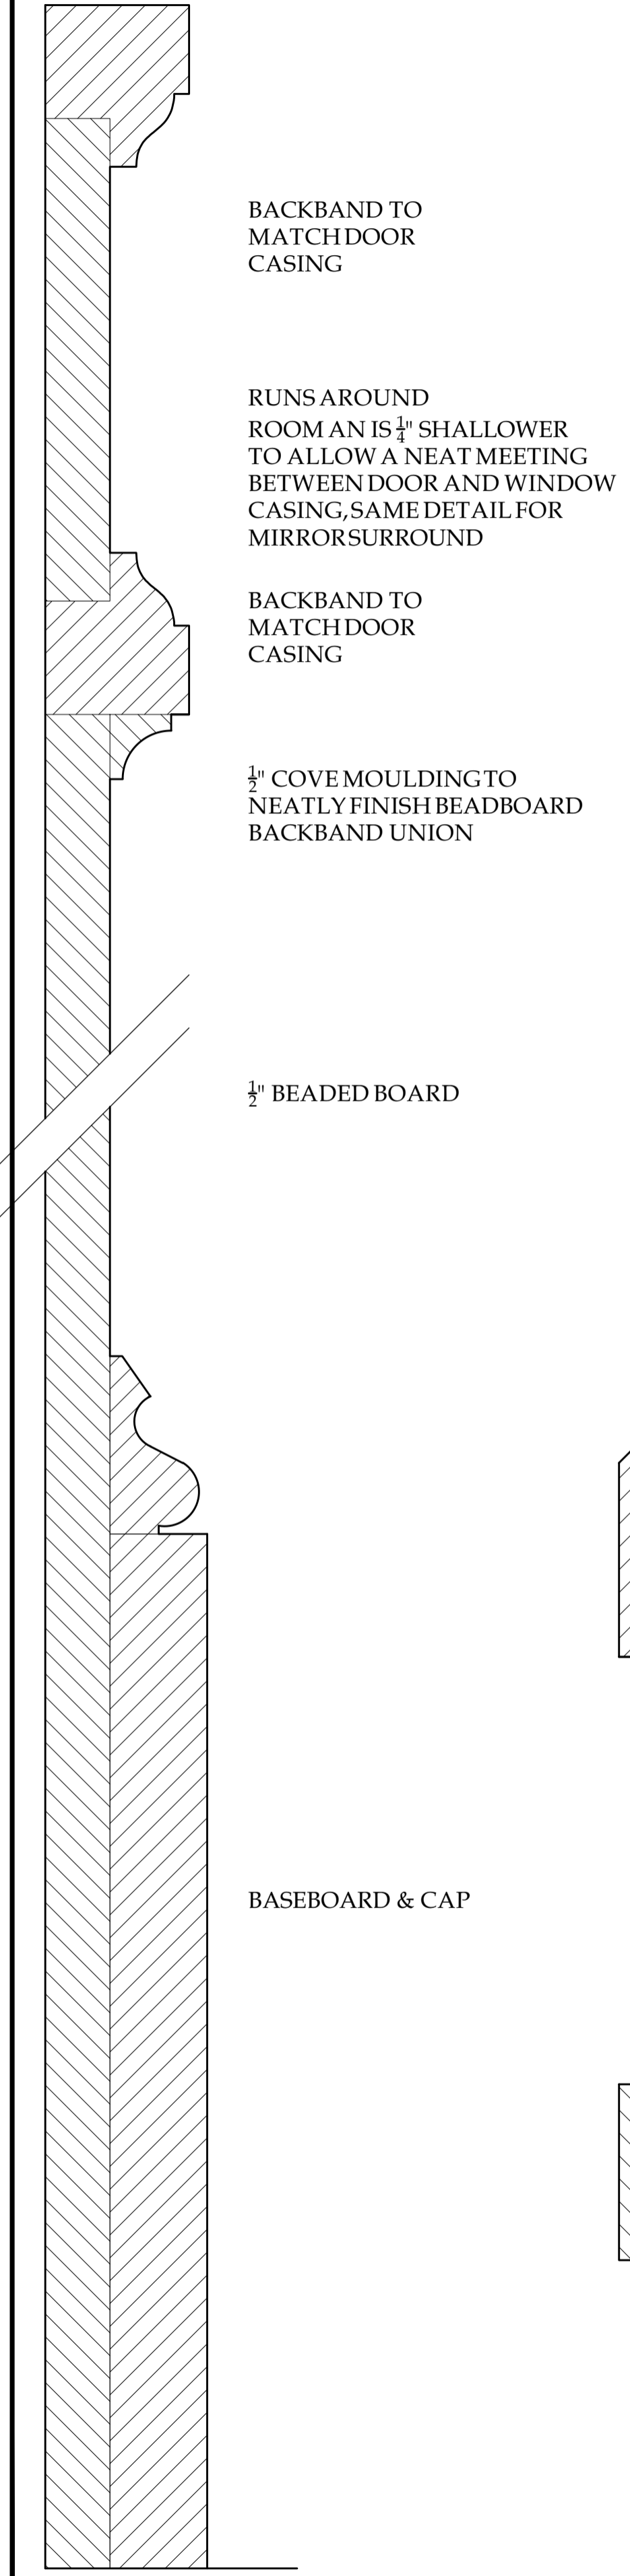


2 RESTROOM: WAINSCOT & MOULDING DETAILS
 Scale: FULL SIZE

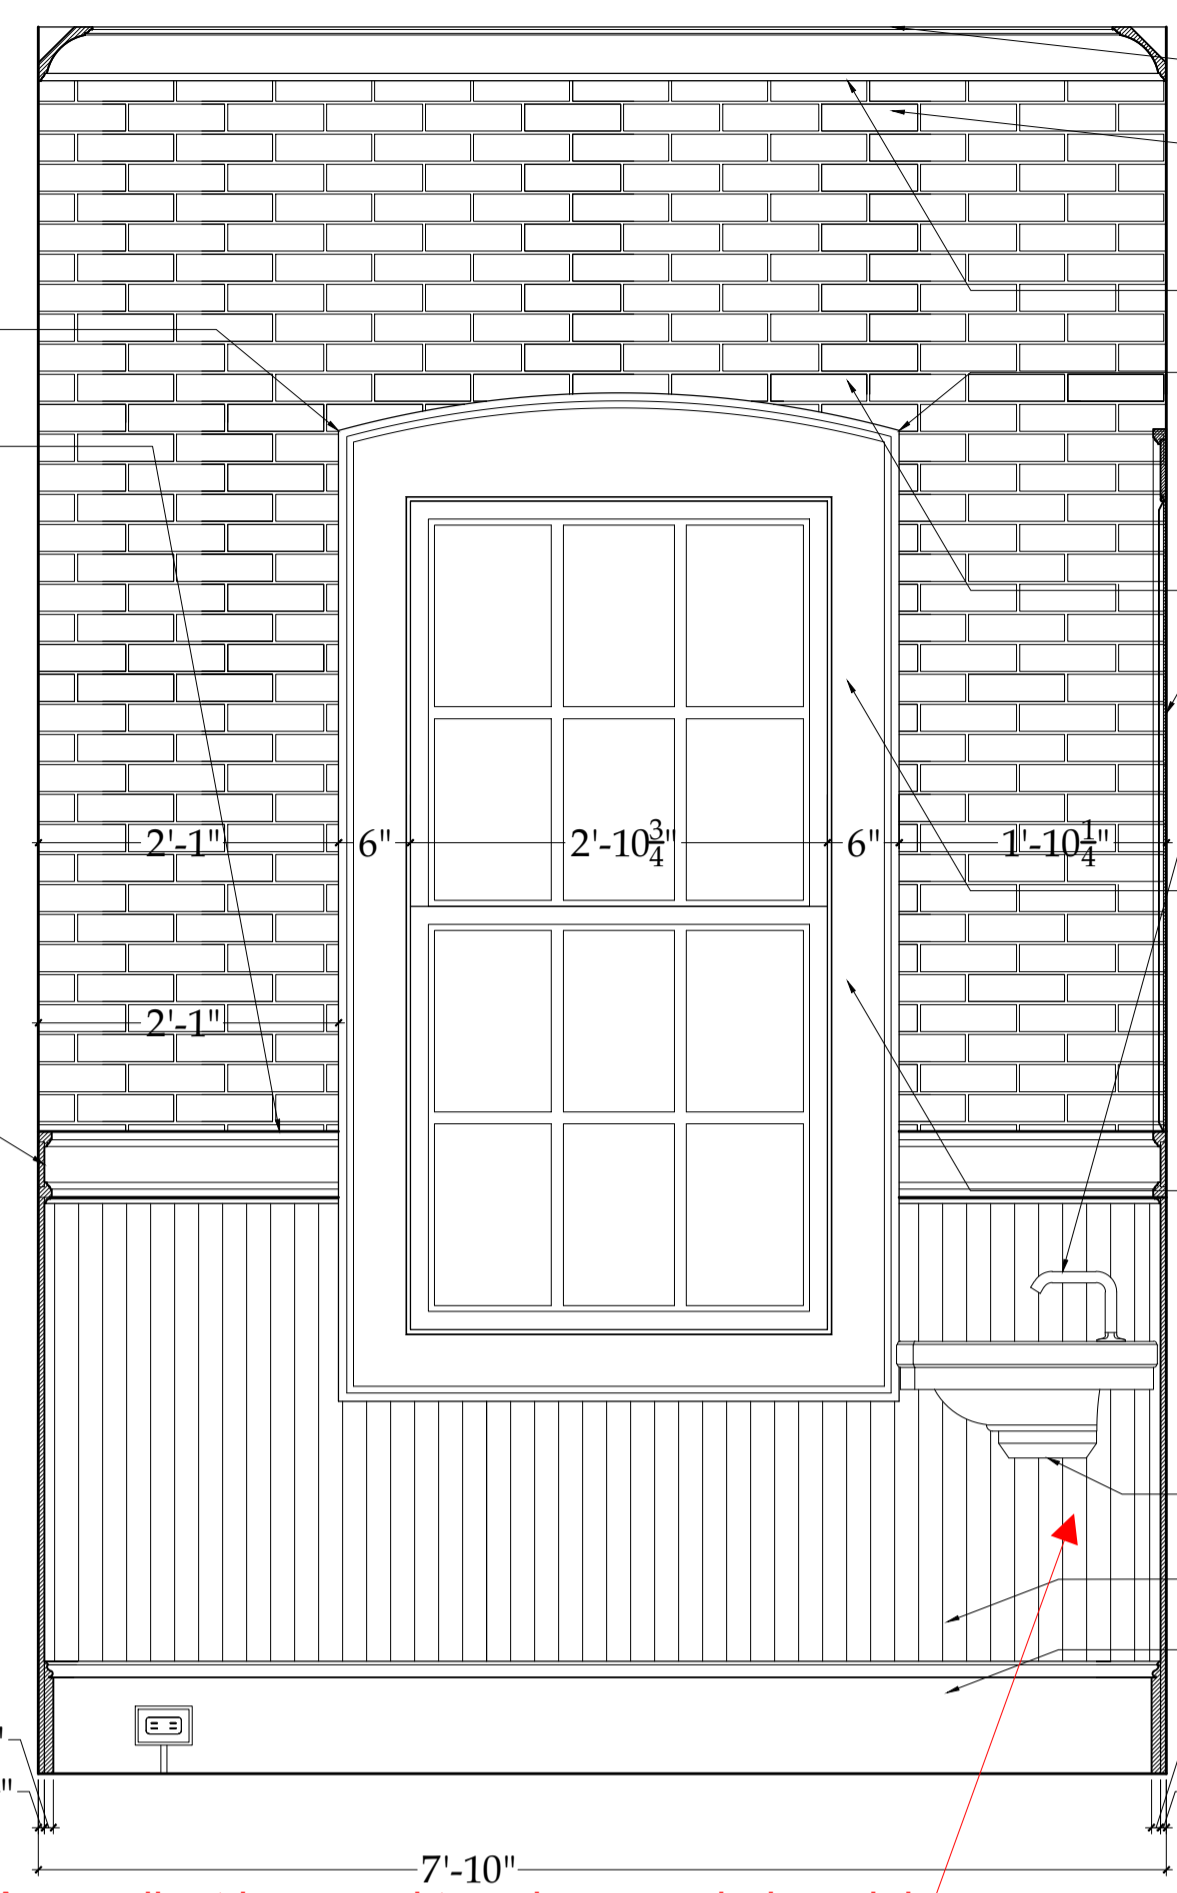


Show ADA compliant knee and toe clearance below sink

3 RESTROOM: EAST ELEV.
 Scale: 3/4"=1'-0"

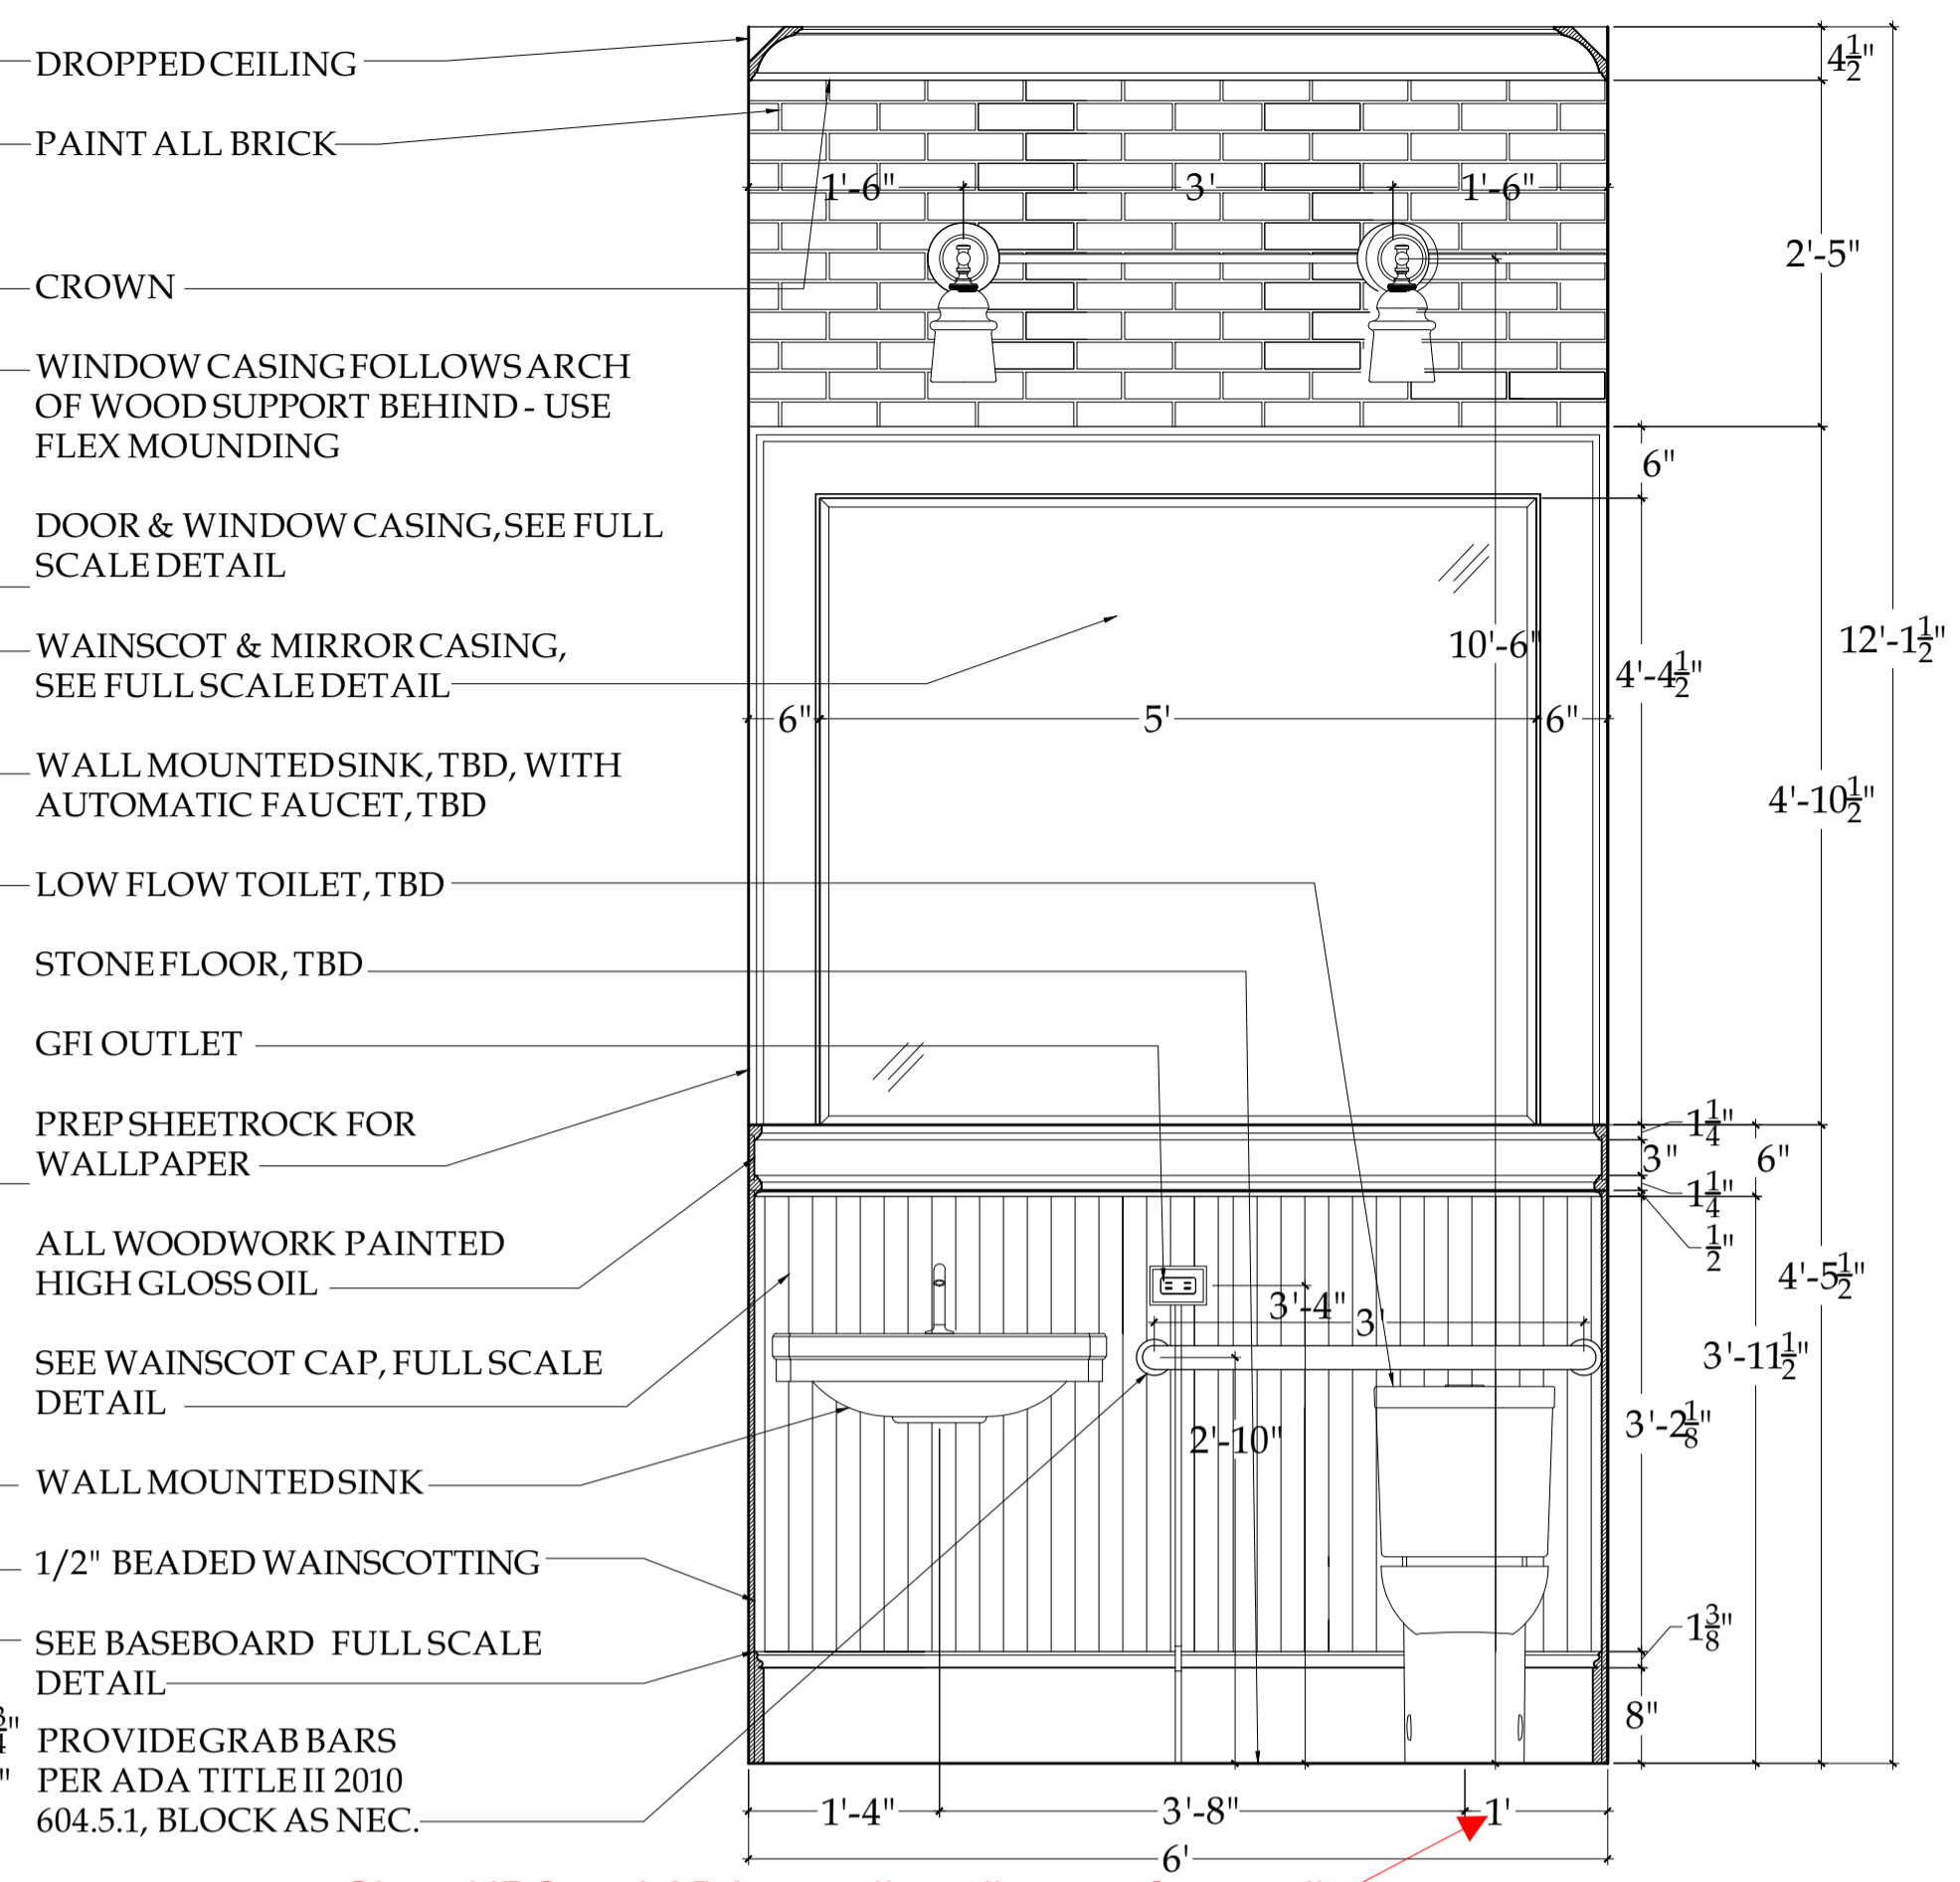


Show UPC and ADA compliant distance from wall

4 RESTROOM: SOUTH ELEV.
 Scale: 3/4"=1'-0"

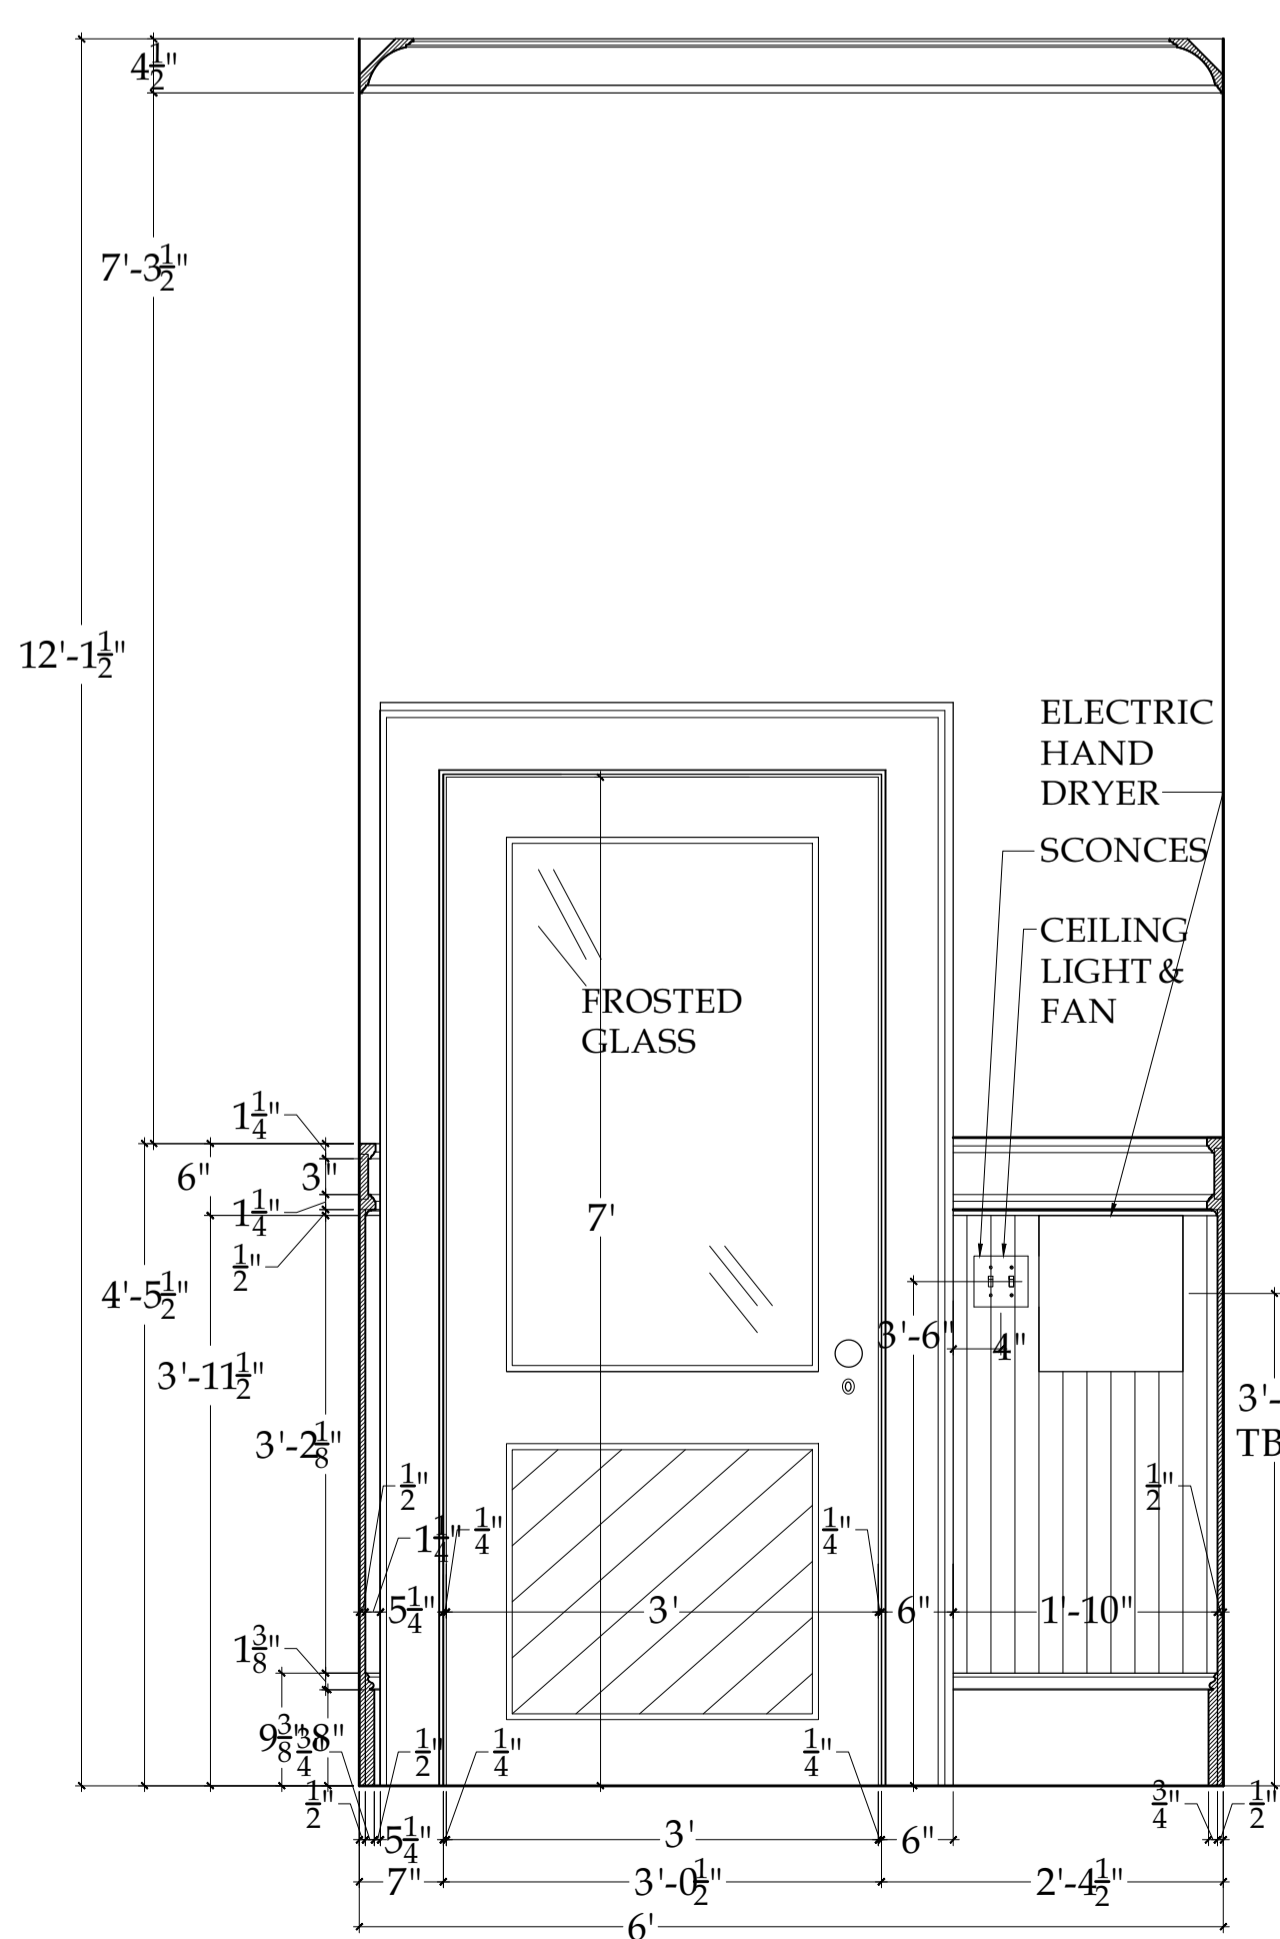

5 RESTROOM: NORTH ELEV.
 Scale: 3/4"=1'-0"

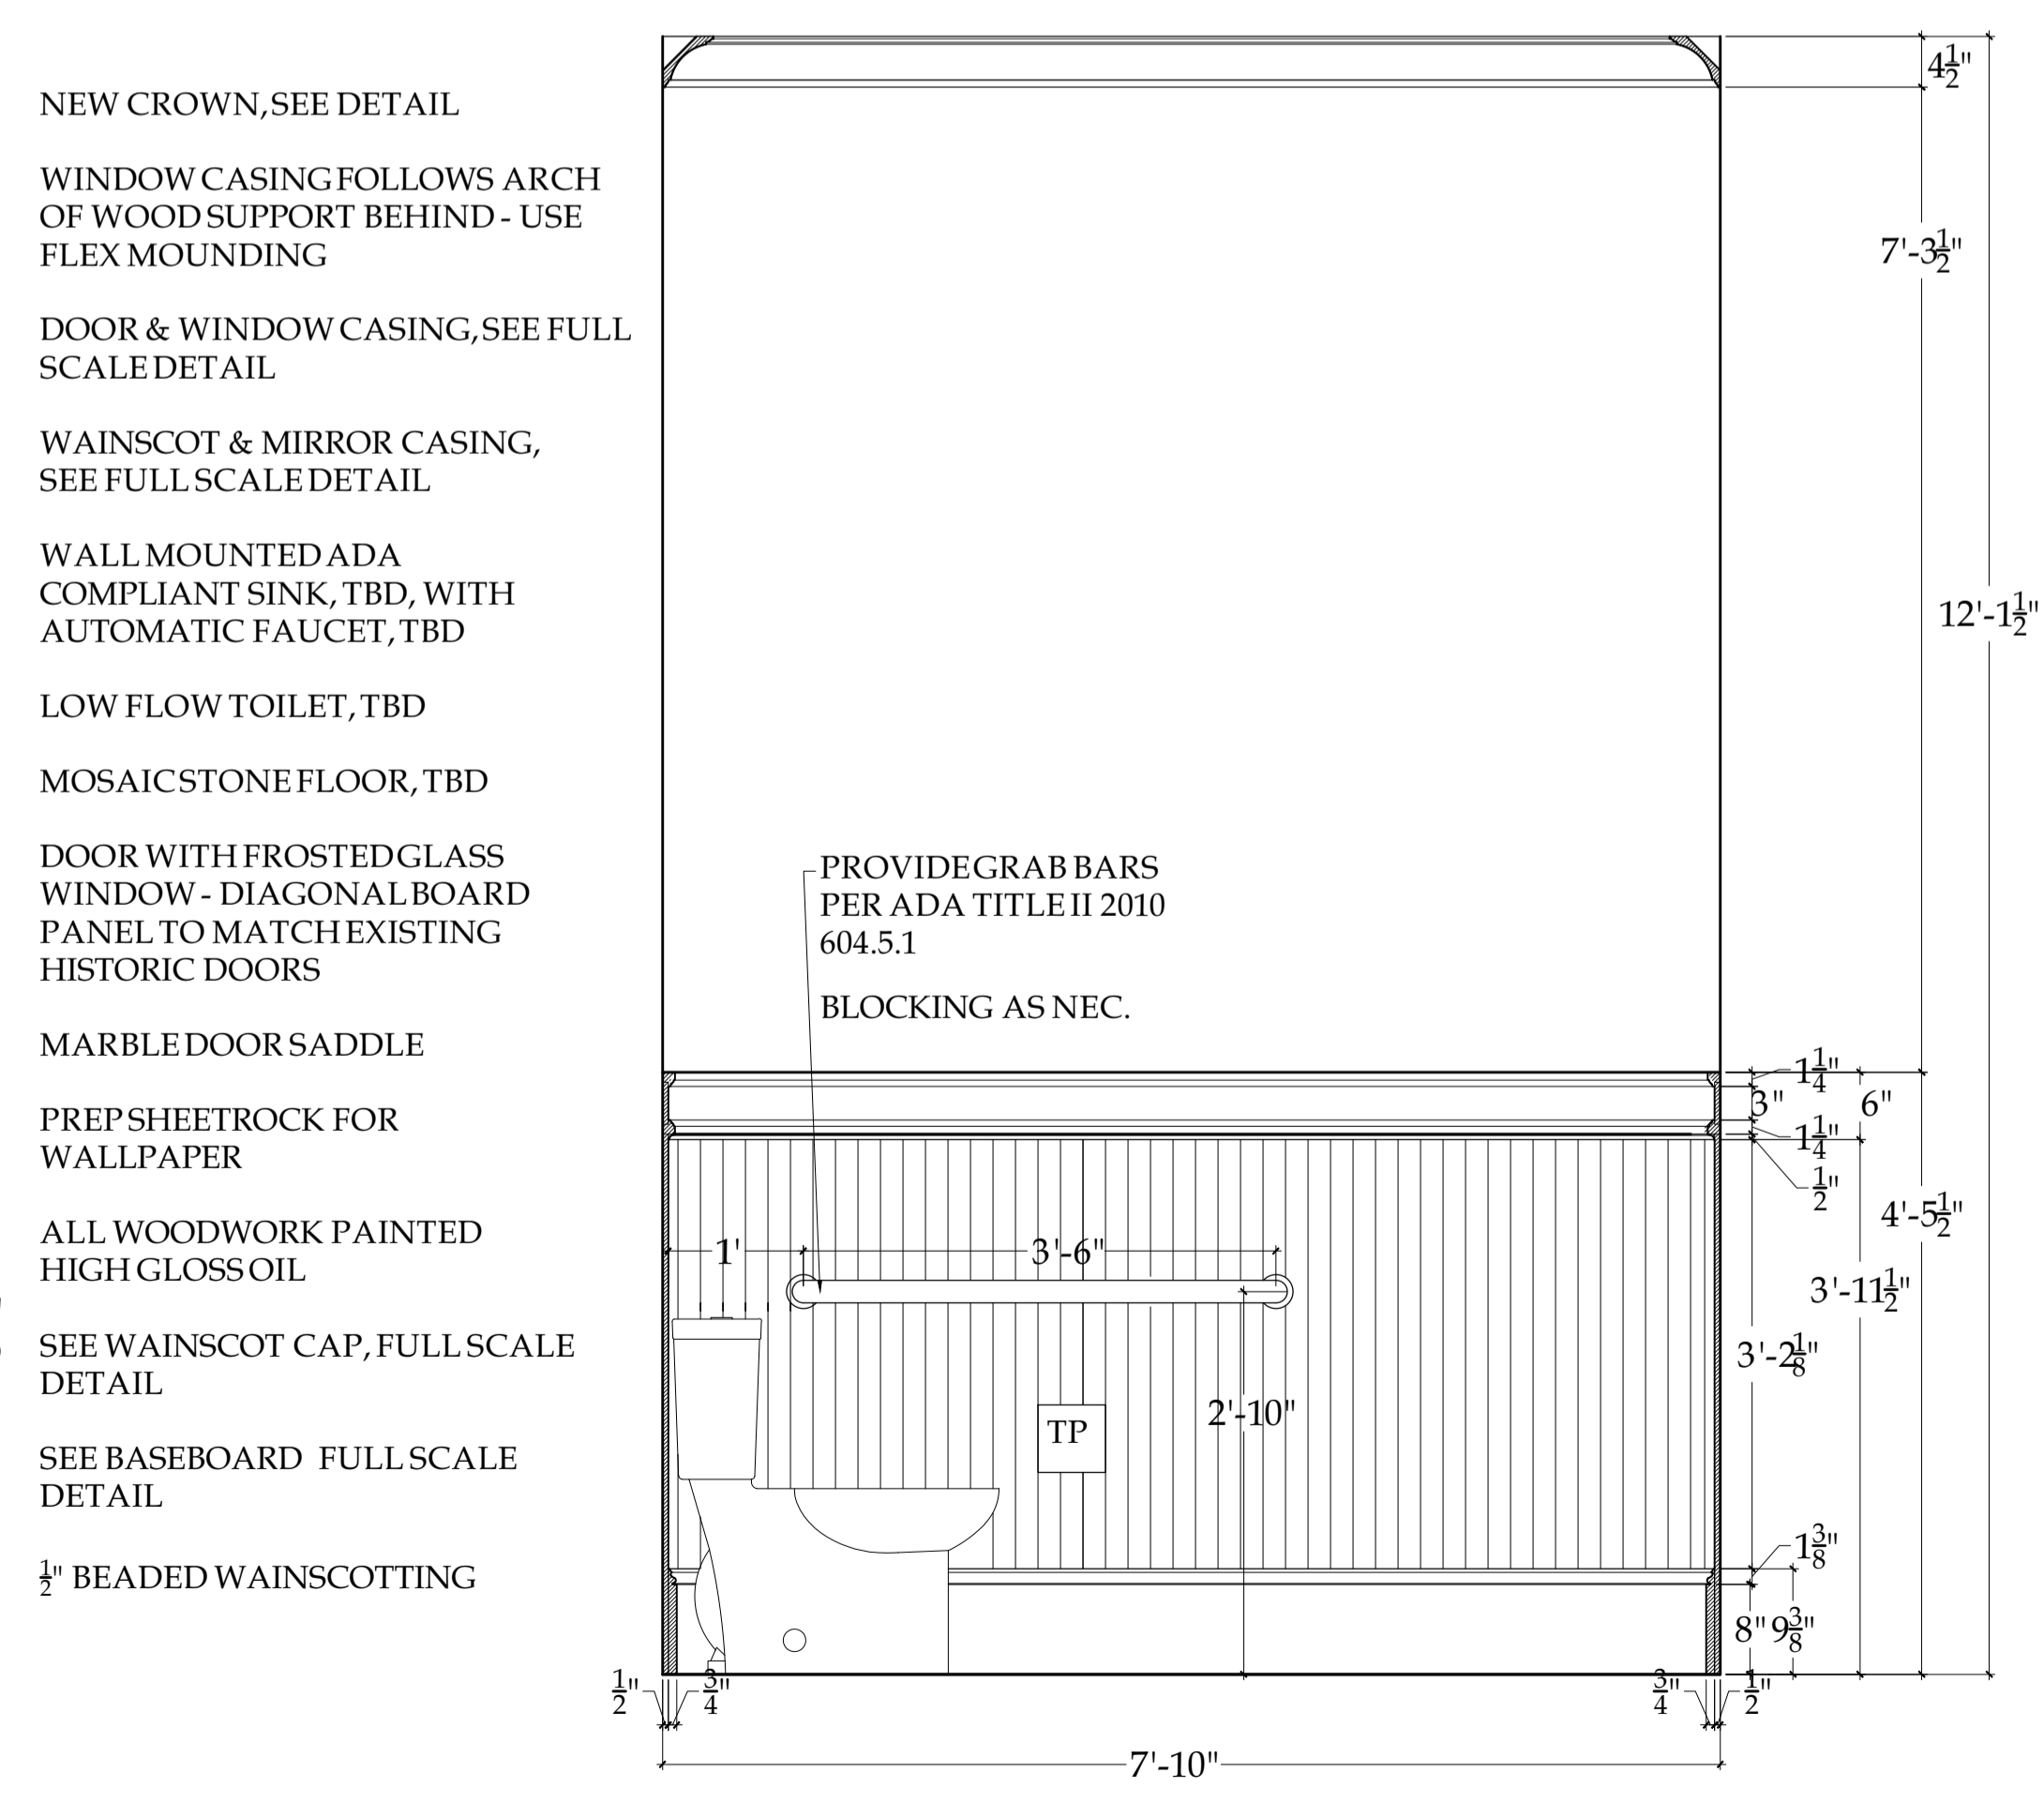


6 RESTROOM: WEST ELEV.
 Scale: 3/4"=1'-0"

86 PONDFIELD ROAD WEST, BRONXVILLE, NEW YORK 10708
 DIAMOND COVE GENERAL STORE
 RESTROOM INTERIOR ELEVATIONS AND MOULDING DETAILS
 NASTASI VAIL DESIGN, LLC
 MRS. ALEXANDRA WIGHT
 GENERAL STORE, GREAT DIAMOND ISLAND
 PORTLAND, MAINE 04109

REVISIONS

DATE	REMARKS

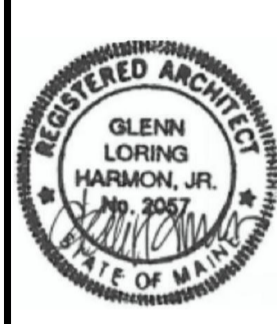

© COPYRIGHT 2017
 NASTASI VAIL DESIGN
 THESE DRAWINGS ARE THE
 PROPERTY OF THE DESIGNER
 AND MAY NOT BE
 REPRODUCED OR
 TRANSMITTED IN ANY FORM
 WITHOUT WRITTEN PERMISSION.

DATE: 1/24/18
 SCALE: 3/4"=1'-0"
 SHEET: 11.5