

City of Portland, Maine - Building or Use Permit Application

389 Congress Street, 04101 Tel: (207) 874-8703, Fax: (207) 874-8716

Permit No: 02-0190	Issue Date: MAR 13 2002	CBL: 087 W001001
-----------------------	----------------------------	---------------------

Location of Construction: 264 Island Ave <i>PI</i>	Owner Name: Costello Sarah A	Owner Address: 264 Island Ave	Phone: 207-766-2206
Business Name: n/a	Contractor Name: Crandell, Walter	Contractor Address: 14 Luther St. Peaks Island	Phone: 2077762273
Lessee/Buyer's Name n/a	Phone: n/a	Permit Type: Alterations - Dwellings	Zone: <i>IR-2</i>

Past Use: Single Family	Proposed Use: Single Family / Build 16' x 10' deck and add patio door.	Permit Fee: \$58.00	Cost of Work: \$5,000.00	CEO District: 3	<i>13,000#</i>
----------------------------	---	------------------------	-----------------------------	--------------------	----------------

Proposed Project Description: Build 16' x 10' deck and add patio door.	FIRE DEPT: <input type="checkbox"/> Approved <input type="checkbox"/> Denied	INSPECTION: Use Group <i>R3</i> Type <i>SB</i> <i>BOCA 1999</i>
	Signature:	Signature: <i>MUNSO</i>

Permit Taken By: <i>gg</i>	Date Applied For: 03/01/2002	Zoning Approval
-------------------------------	---------------------------------	------------------------

<ol style="list-style-type: none"> This permit application does not preclude the Applicant(s) from meeting applicable State and Federal Rules. Building permits do not include plumbing, septic or electrical work. Building permits are void if work is not started within six (6) months of the date of issuance. False information may invalidate a building permit and stop all work. 	Special Zone or Reviews <input type="checkbox"/> Shoreland <i>NA</i> <input type="checkbox"/> Wetland <input type="checkbox"/> Flood Zone <input type="checkbox"/> Subdivision <input type="checkbox"/> Site Plan Maj <input type="checkbox"/> Minor <input type="checkbox"/> MM <input type="checkbox"/> Denied Date: <i>OK with conditions 3/7/02</i>	Zoning Appeal <input type="checkbox"/> Variance <input type="checkbox"/> Miscellaneous <input type="checkbox"/> Conditional Use <input type="checkbox"/> Interpretation <input type="checkbox"/> Approved <input type="checkbox"/> Denied Date:	Historic Preservation <input checked="" type="checkbox"/> Not in District or Landmark <input type="checkbox"/> Does Not Require Review <input type="checkbox"/> Requires Review <input type="checkbox"/> Approved <input type="checkbox"/> Approved w/Conditions <input type="checkbox"/> Denied <i>g</i> Date:
--	---	---	---

CERTIFICATION

I hereby certify that I am the owner of record of the named property, or that the proposed work is authorized by the owner of record and that I have been authorized by the owner to make this application as his authorized agent and I agree to conform to all applicable laws of this jurisdiction. In addition, if a permit for work described in the application is issued, I certify that the code official's authorized representative shall have the authority to enter all areas covered by such permit at any reasonable hour to enforce the provision of the code(s) applicable to such permit.

SIGNATURE OF APPLICANT

ADDRESS

DATE

PHONE

3-12-06 Sawntube depth needs to be 4'-0" + 8" Min dia.

Guardrails need to be 36" around new deck.

Girder needs to be 4"x10" or add one more sawntube.

left message w/owner. 4:00 - Went over all of the above.

3- 2x12 stringers - 10" Tread + Max $7\frac{3}{4}$ " rise -
guards 36" high - stairs will be rebuilt
in same footprint - OK per 14-385.

Application ID Number: 2-0190

Delete Review

Save

Close

Department: Zoning

Status: Approved with Conditions

Reviewer: Marge Schmuckal

Comments: 264 Island Ave

Approval Date: 03/07/2002

Given On Date: 03/07/2002

OK to Issue Permit

Name: Marge Schmuckal

Date: 03/07/2002

Date 2:

Conditions Section:

Add New Condition From Default List

Add New Condition

Delete Condition

This permit is being approved on the basis of plans submitted. Any deviations shall require a separate approval before starting that work.

This property shall remain a single family dwelling. Any change of use shall require a separate permit application for review and approval.

This is NOT an approval for an additional dwelling unit. You SHALL NOT add any additional kitchen equipment including, but not limited to items such as stoves, microwaves, refrigerators, or kitchen sinks, etc. Without special approvals.

Separate permits shall be required for future decks, sheds, pools, and/or garages.

Create Date: 03/07/2002 By gg

Update Date: 03/07/2002 By mes

02 0190

THIS IS NOT A PERMIT/CONSTRUCTION CANNOT COMMENCE UNTIL THE PERMIT IS ISSUED

Minor/Minor Site Review for New Detached Single Family Dwelling, All Purpose Building Permit Application

In the interest of processing your application in the quickest possible manner, please complete the information below for a Building or Use Permit.

NOTE**If you or the property owner owes real estate or personal property taxes or user charges on any property within the City, payment arrangements must be made before permits of any kind are accepted.

Location/Address of Construction: 264 ISLAND AVE PEAKS IS ME 04108

Total Square Footage of Proposed Structure 164 Square Footage of Lot 13,832

Tax Assessor's Chart, Block & Lot Number 87 W 1-2 Chart# Block# Lot# Owner: SALLY COSTELLO 264 ISLAND AVE PEAKS IS ME 04108 Telephone#: 766-2206

Lessee/Buyer's Name (If Applicable) Owner's/Purchaser/Lessee Address: Cost Of Work: Fee: \$5000 - \$54-

Current use: SINGLE FAMILY DWELLING Proposed use: SAME Project description: CONSTRUCT OPEN DECK AND INSTALL PATIO DOOR. Owe \$4.00

Contractor's Name, Address & Telephone: 14 LUTHER ST PEAKS IS ME 04108 766-2273 Rec'd By: WALTER GRANDALL

Separate permits are required for Internal & External Plumbing, HVAC and Electrical installation.

- All construction must be conducted in compliance with the 1999 B.O.C.A. Building Code as amended by Section 6-Art II.
All plumbing must be conducted in compliance with the State of Maine Plumbing Code.
All Electrical Installation must comply with the 1999 National Electrical Code as amended by Section 6-Art III.
HVAC (Heating, Ventilation and Air Conditioning) installation must comply with the 1993 BOCA Mechanical Code.

YOU MUST INCLUDE THE FOLLOWING WITH YOUR APPLICATION:

- A Copy of Your Deed or Purchase and Sale Agreement if purchased in the last 365 days
A Plot Plan (Sample Attached) ON PAPER NO LARGER THAN 11" x 17" if you are doing anything other than interior rehab work.

By [Signature]

DEPT. OF BUILDING INSPECTION CITY OF PORTLAND ME MAR 1

THIS IS NOT A PERMIT/CONSTRUCTION CANNOT COMMENCE UNTIL THE PERMIT IS ISSUED

A PLOT PLAN INCLUDES THE FOLLOWING:

- The shape and dimension of the lot, all existing buildings (if any), the proposed structure and the distance from the actual property lines. Structures include decks porches, a bow windows cantilever sections and roof overhangs, as well as, sheds, pools, garages and any other accessory structures.
- Scale and North arrow; Zoning District & Setbacks
- First Floor sill elevation (based on mean sea level datum);
- Location and dimensions of parking areas and driveways;
- Location and size of both existing utilities in the street and the proposed utilities serving the building;
- Location of areas on the site that will be used to dispose of surface water.
- Existing and proposed grade contours

A "minor/minor" site plan review is required for New Single Family Homes Only. The Site plan must be prepared and sealed by a registered land surveyor. FOUR COMPLETE PACKETS OF ALL SUBMISSIONS ARE REQUIRED FOR NEW SINGLE FAMILY HOMES SHOWING CONSTRUCTION AND SITE DETAILS ON 32" x 48". ALONG WITH ONE SET ON PAPER NO LARGER THAN 11" X 17".

ON ALL OTHER BUILDING PERMIT SUBMISSIONS ONE SET OF SUBMISSIONS IS REQUIRED ON 11' X 17" AND ONE SETS ON 32" X 48" with the below stated details. (Sample Attached) Please note that single family additions and alterations may be hand drawn on regular paper, however the below details will still apply.

A complete set of construction drawings showing all of the following elements of construction:

- Cross Sections w/Framing details (including porches, decks w/ railings, and accessory structures)
- Floor Plans & Elevations
- Window and door schedules
- Foundation plans with required drainage and damp proofing
- Electrical and plumbing layout. Mechanical drawings for any specialized equipment such as furnaces, chimneys, gas equipment, HVAC equipment (air handling) or other types of work that may require special review must be included.


Certification

I hereby certify that I am the Owner of record of the named property, or that the proposed work is authorized by the owner of record and that I have been authorized by the owner to make this application as his/her authorized agent. I agree to conform to all applicable laws of this jurisdiction. In addition, if a permit for work described in this application is issued, I certify that the Code Official's authorized representative shall have the authority to enter all areas covered by this permit at any reasonable hour to enforce the provisions of the codes applicable to this permit.

Signature of applicant: <i>Sallyann Costello</i>	Date: <i>2.25-2</i>
--	---------------------

Minor/Minor Site Review Fee: \$300.00/Building Permit Fee: \$30.00 for the 1st \$1000.cost plus \$6.00 per \$1,000.00 construction cost thereafter.

ONE SET OF SUBMISSIONS INCLUDING CONSTRUCTION AND SITE PLAN DRAWINGS MUST BE SUBMITTED ON PAPER NO LARGER THAN 11" x 17" BEFORE ANY BUILDING PERMIT WILL BE ISSUED

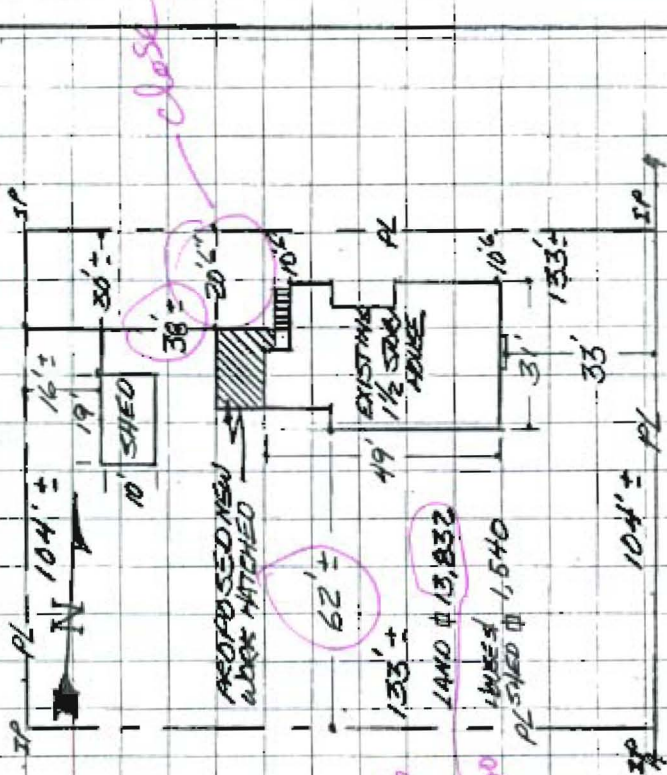

ISLAND AVE

SITE PLAN SCALE: 1" = 40'

IR-2-204

FRONT - N/A
 REAR: 25' min - 38' shown
 SIDE: 20' min - 26'± - 62' shown


APPRAISED COSTELLO DECK	
DATE:	2/21/02
SCALE:	AS NOTED
DRAWN BY:	NVC

4444
 2700
 137


will be 36" high

13,000 x 25% = 2600\$ w/mt

590
 132
 116
 1143
 503
 1365

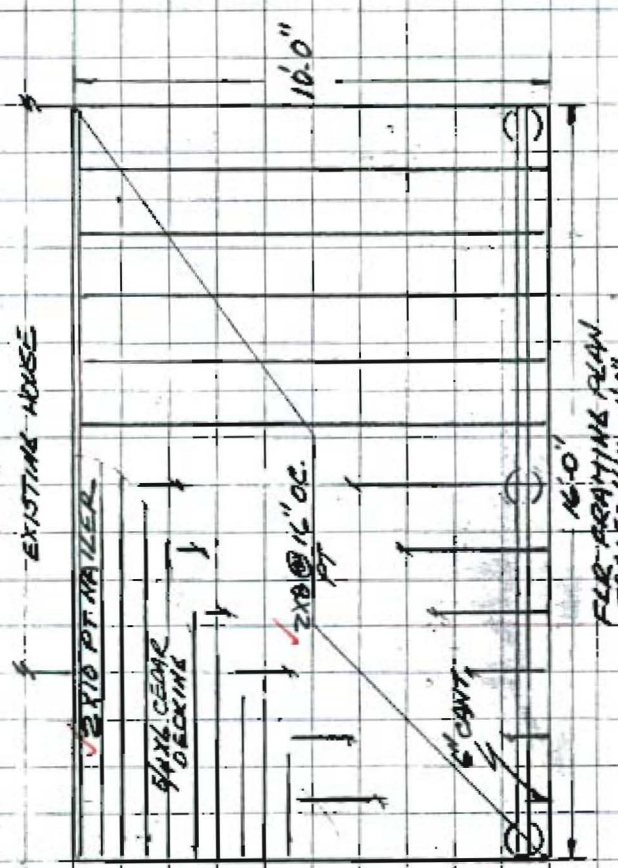

FLOOR FRAMING PLAN SCALE: 1/4" = 1'-0"

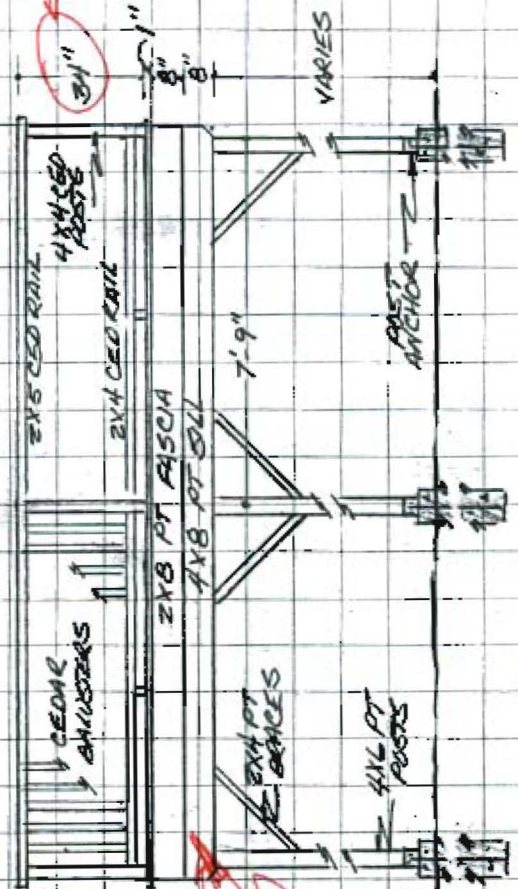

WEST ELEV. SCALE: 1/4" = 1'-0"

Needs to be 4x10 or more on the wall will be 4x10

will be double will be double



PROPOSED PATIO OR FRAMING
 @ WEST ELEVATION
 SCALE: 1/4" = 1'-0"


PROPOSED COSTELLO DOOR

DATE: 2/21/02

SCALE: 1/4" = 1'-0"

DRAWN BY: N/C

2

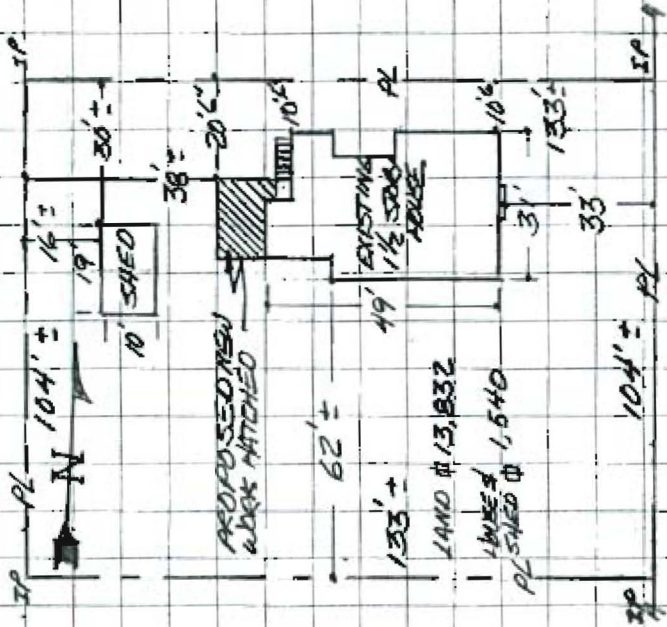


ISLAND AVE.


SITE PLAN
SCALE: 1" = 40'

PROPOSED COSTELLO DECK
DATE: 2/21/02
SCALE: AS NOTED
DRAWN BY: NJC

1

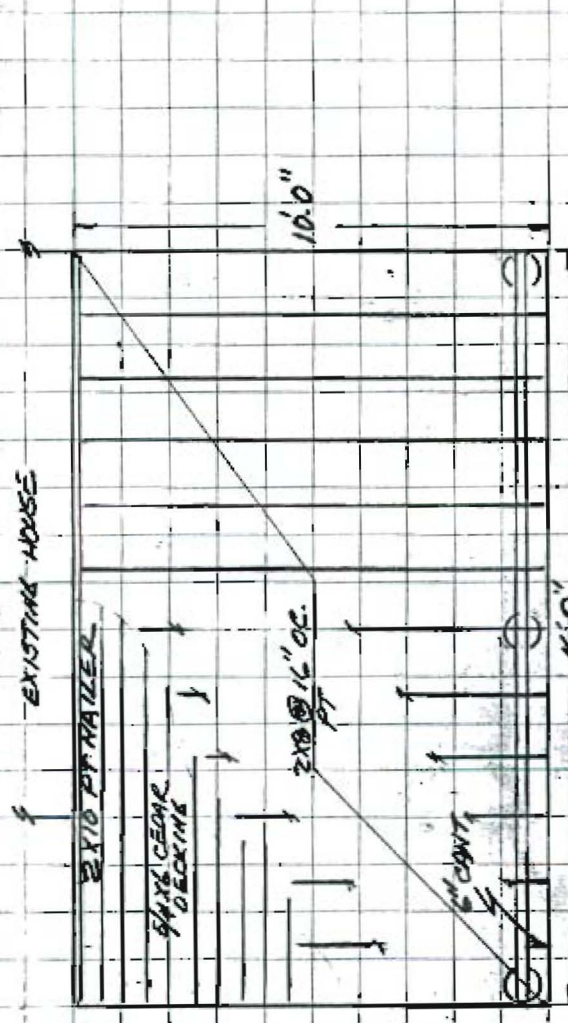

FLOOR FRAMING PLAN
SCALE: 1/4" = 1'-0"

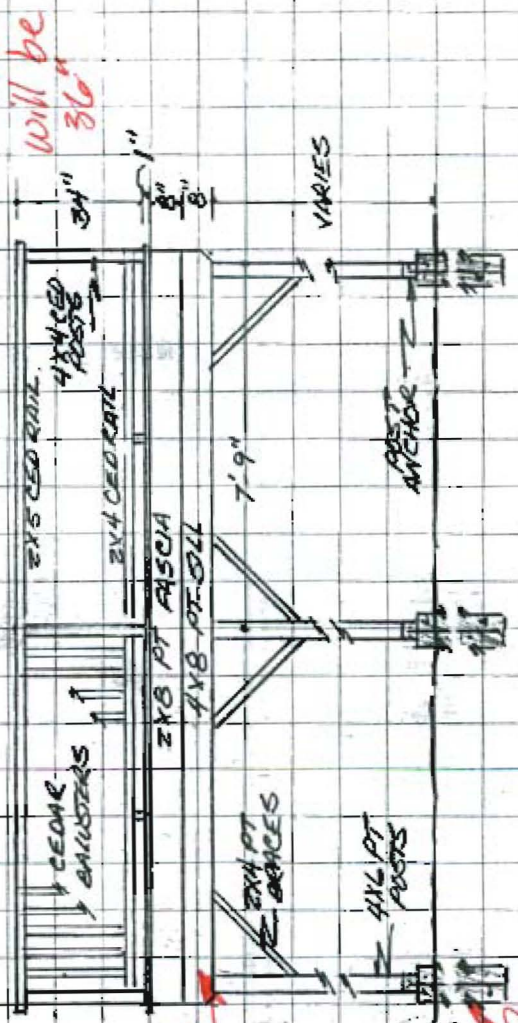


DECK ELEV.
SCALE: 1/4" = 1'-0"

will be 4x10" 2

will be 4x10" 2

8x10 @ 16" 10'

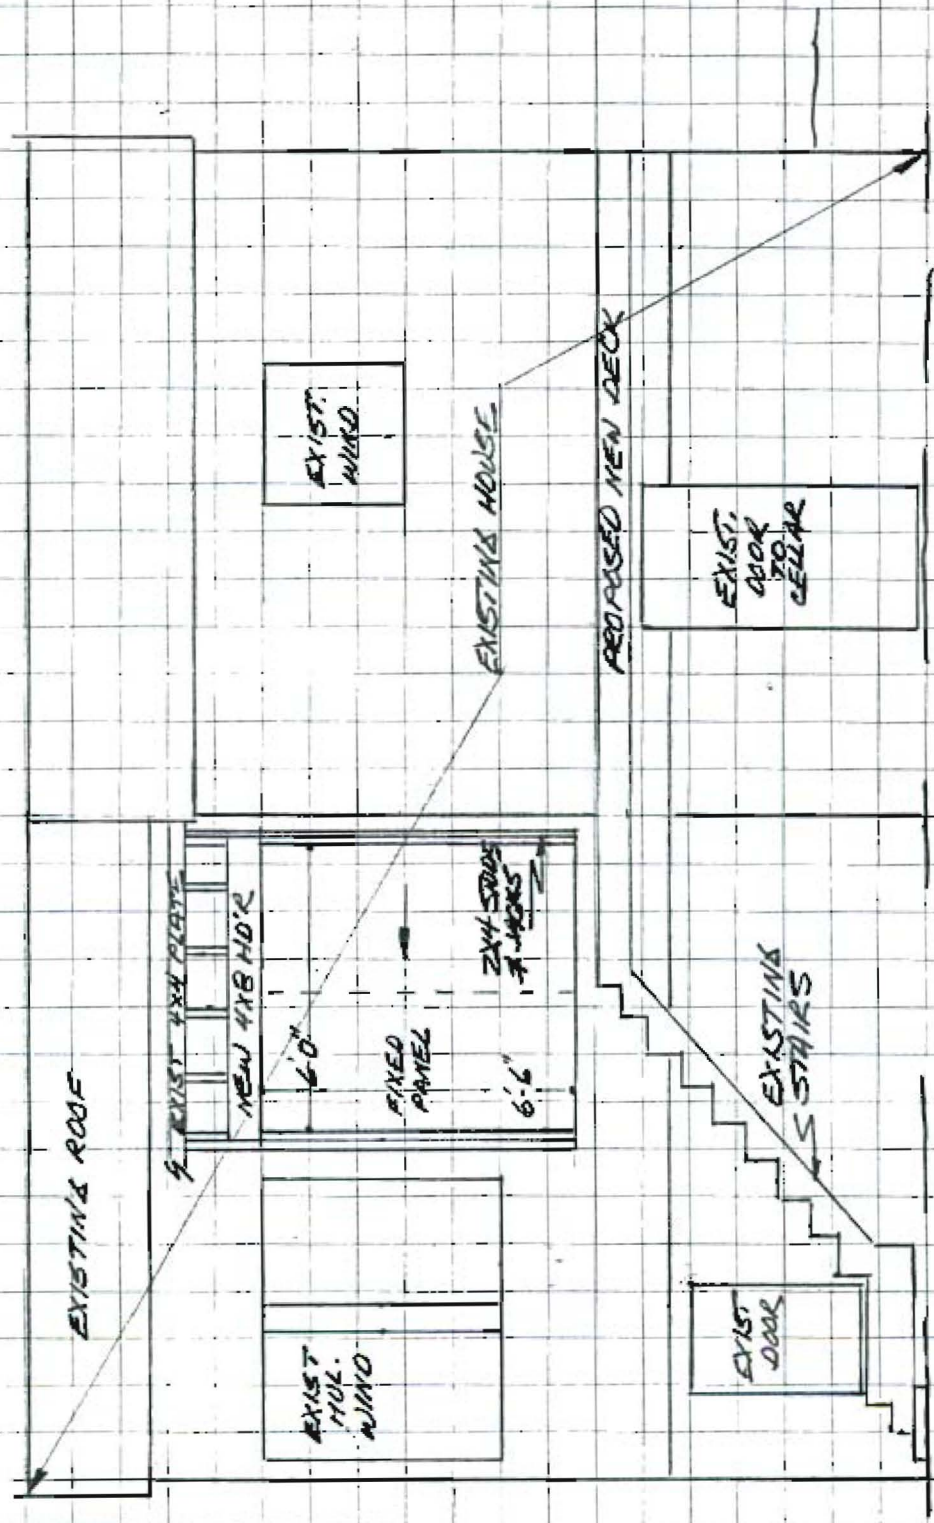

PROPOSED RATIO DR. FRAMING
 @ WEST ELEVATION,
 SCALE: 1/4" = 1'-0"

PROPOSED CASTELLO DOOR	
DATE: 2/21/02	2
SCALE: 1/4" = 1'-0"	
DRAWN BY: WJC	



CITY OF PORTLAND, MAINE

Department of Building Inspections

March 6 2007

Received from Waste Center

Location of Work 264 Island Ave

Cost of Construction \$ _____

Permit Fee \$ 54.00 ("owe 4.00")

Building (IL) Plumbing (IS) Electrical (I2) Site Plan (U2)

Other _____

CBL: 087 W 001

Check #: 4582 Total Collected \$ 54.00

THIS IS NOT A PERMIT

No work is to be started until PERMIT CARD is actually posted upon the premises. Acceptance of fee is no guarantee that permit will be granted. PRESERVE THIS RECEIPT. In case permit cannot be granted the amount of the fee will be refunded upon return of the receipt less \$10.00 or 10% whichever is greater.

WHITE - Applicant's Copy
YELLOW - Office Copy
PINK - Permit Copy

BUILDING PERMIT INSPECTION PROCEDURES

Please call 874-8703 or 874-8693 to schedule your inspections as agreed upon

Permits expire in 6 months, if the project is not started or ceases for 6 months.

The Owner or their designee is required to notify the inspections office for the following inspections and provide adequate notice. Notice must be called in 48-72 hours in advance in order to schedule an inspection:

By initializing at each inspection time, you are agreeing that you understand the inspection procedure and additional fees from a "Stop Work Order" and "Stop Work Order Release" will be incurred if the procedure is not followed as stated below.

_____ **Pre-construction Meeting:** Must be scheduled with your inspection team upon receipt of this permit. Jay Reynolds, Development Review Coordinator at 874-8632 must also be contacted at this time, before any site work begins on any project other than single family additions or alterations.

_____ **Footing/Building Location Inspection:** Prior to pouring concrete

N/A **Re-Bar Schedule Inspection:** Prior to pouring concrete

N/A **Foundation Inspection:** Prior to placing ANY backfill

_____ **Framing/Rough Plumbing/Electrical:** Prior to any insulating or drywalling

_____ **Final/Certificate of Occupancy:** Prior to any occupancy of the structure or use. NOTE: There is a \$75.00 fee per inspection at this point.

Certificate of Occupancy is not required for certain projects. Your inspector can advise you if your project requires a Certificate of Occupancy. All projects DO require a final inspection

_____ If any of the inspections do not occur, the project cannot go on to the next phase, REGARDLESS OF THE NOTICE OR CIRCUMSTANCES.

N/A **CERTIFICATE OF OCCUPANCIES MUST BE ISSUED AND PAID FOR, BEFORE THE SPACE MAY BE OCCUPIED**

Sally Costello
Signature of applicant/designee

Date 3/15/02

[Signature]
Signature of Inspections Official

Date

CBL: 087-000122 Building Permit #: 02-0190