



ISLAND AVE.

52'

EXISTING FENCE

#154

130'

EXISTING DECK TO REMAIN

#1

FOOTINGS

130'

#2

A

B

#3

55'

18'

C

NEW
REMOVABLE
ALUM. STAIRS


#4

D

#5

EXISTING SEA WALL
BEACH

52'

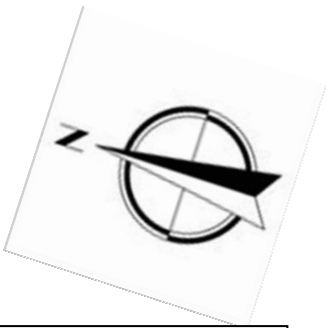

APPROX. LANDING SIZE

- LANDING #1 4'X4'
- LANDING #2 4'X8'
- LANDING #3 4'X5'
- LANDING #4 4'X4'-6"
- LANDING #5 4'X5'

APPROX. # STAIR STEPS

- STAIR A 14
- STAIR B 17
- STAIR C 17
- STAIR D 3
- REMOVABLE 12

Main Line Fence