



**Rachel Conly** 

Architectural Design

26 Sterling Street

26 Sterling Street
Peaks Island, Maine 04108
207.766.5625

Title Page

PROJECT

Branson Residence


5 Beach Road Peaks Island, Me. 04108

33,122	Rachel & Harvey
SCALE	DRAWN BY
DATE 5.9.14	REVISED 5.22.14 10.30.14 7.31.14

NOT





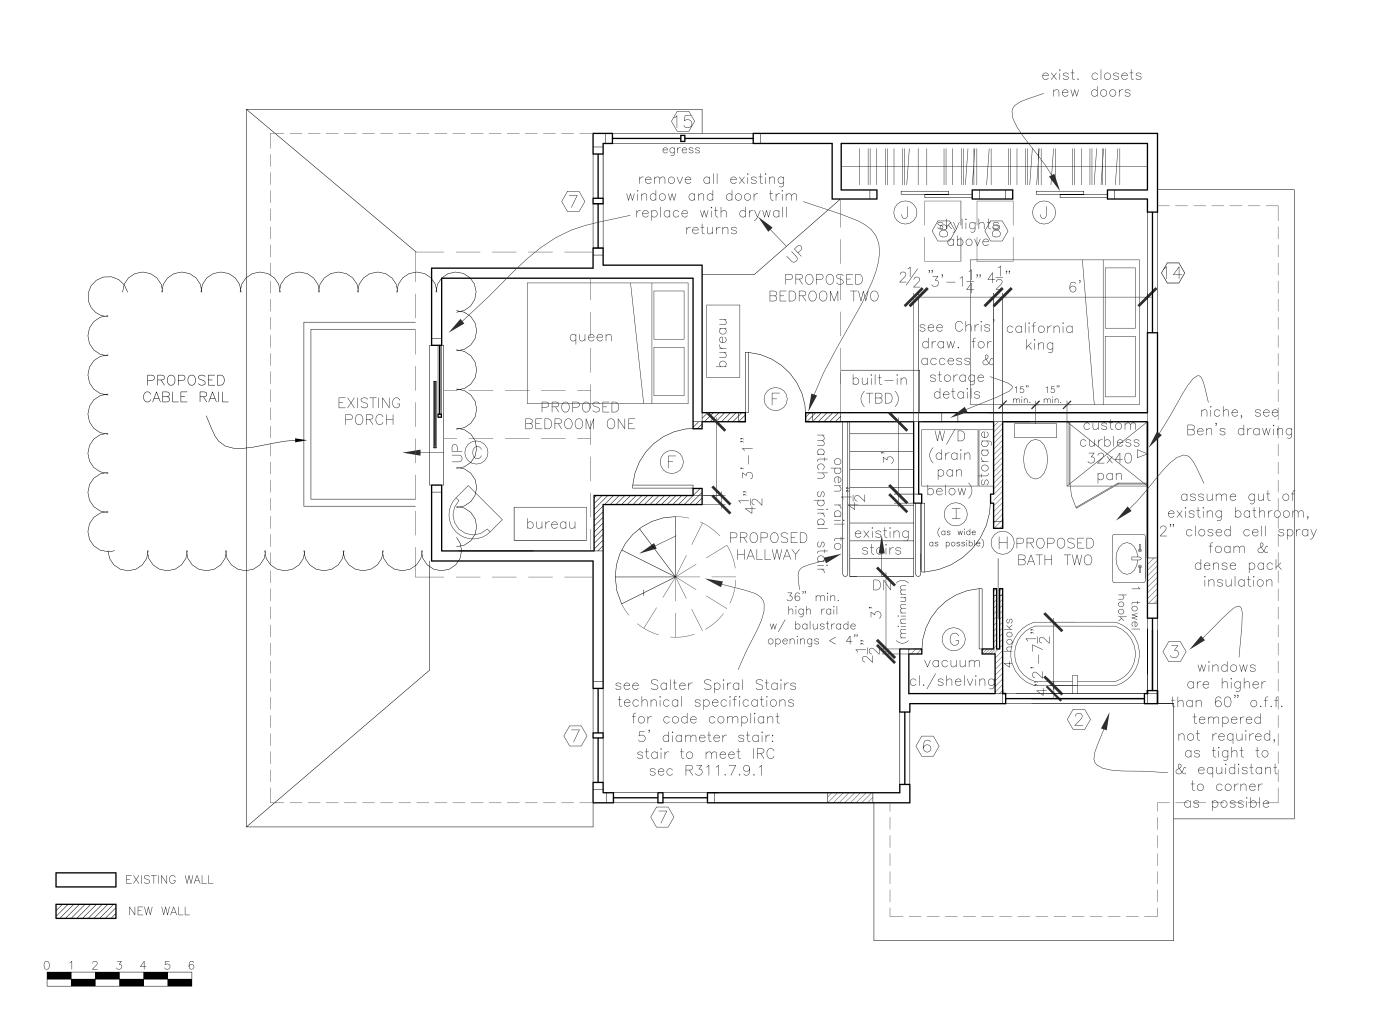

### **Rachel Conly**

Architectural Design

26 Sterling Street Peaks Island, Maine 04108 207.766.5625

> Proposed Second Floor Plan


PROJECT

Branson Residence


5 Beach Road Peaks Island, Me. 04108

1/ + 1 0	Harvey
1/4"=1'-0"	Rachel &
SCALE	DRAWN BY
5.9.14	7.31.14
DATE	REVISED 5.22.14 10.30.1

NOTES

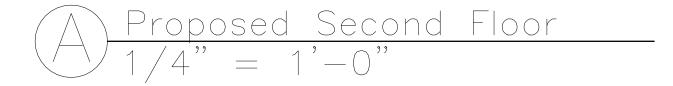



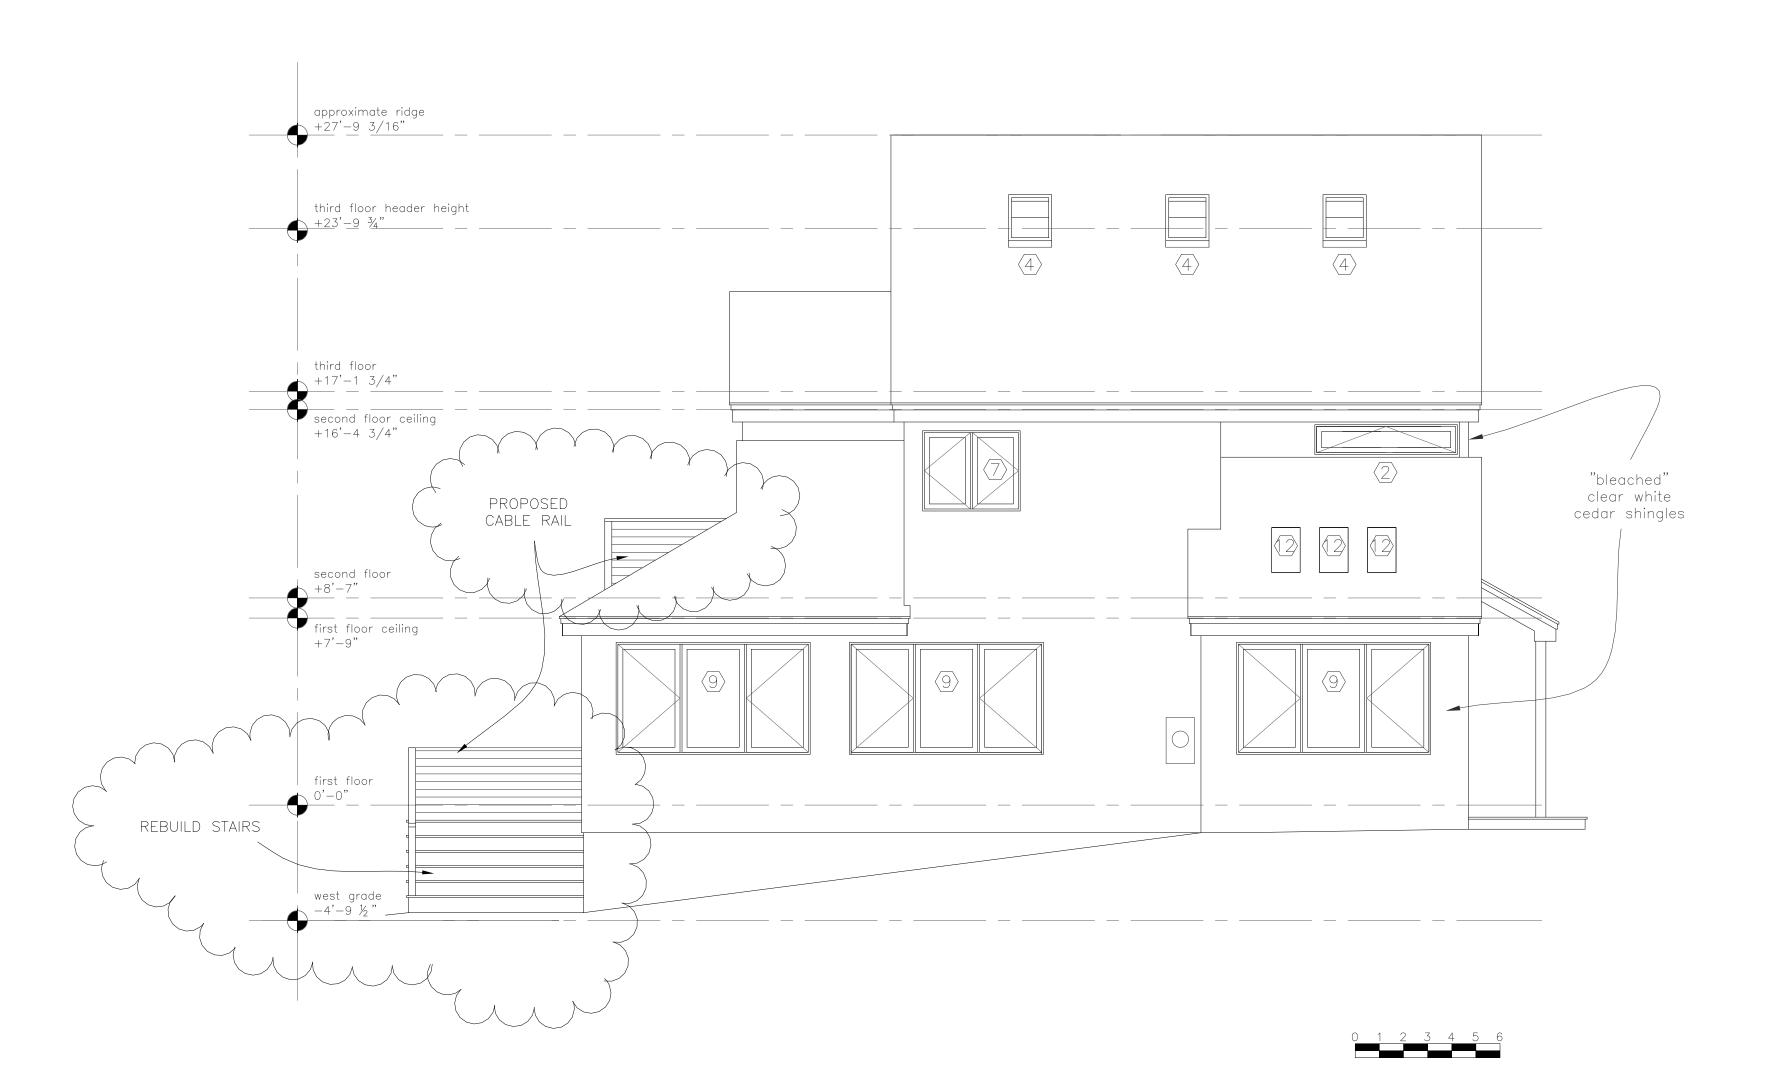

# Proposed South Elevation 1/4" = 1'-0"

### **Rachel Conly**

Architectural Design

26 Sterling Street Peaks Island, Maine 04108 207.766.5625

Proposed South Elevation


PROJECT


Branson Residence

5 Beach Road Peaks Island, Me. 04108

DATE REVISED 5.22.14 10.30.14 7.31.14 SCALE DRAWN BY	1/4"=1'-0"	Rachel & Harvey
	5.9.14	5.22.14 10.30.14 7.31.14

NOTE

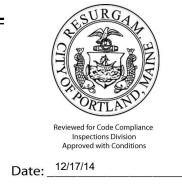

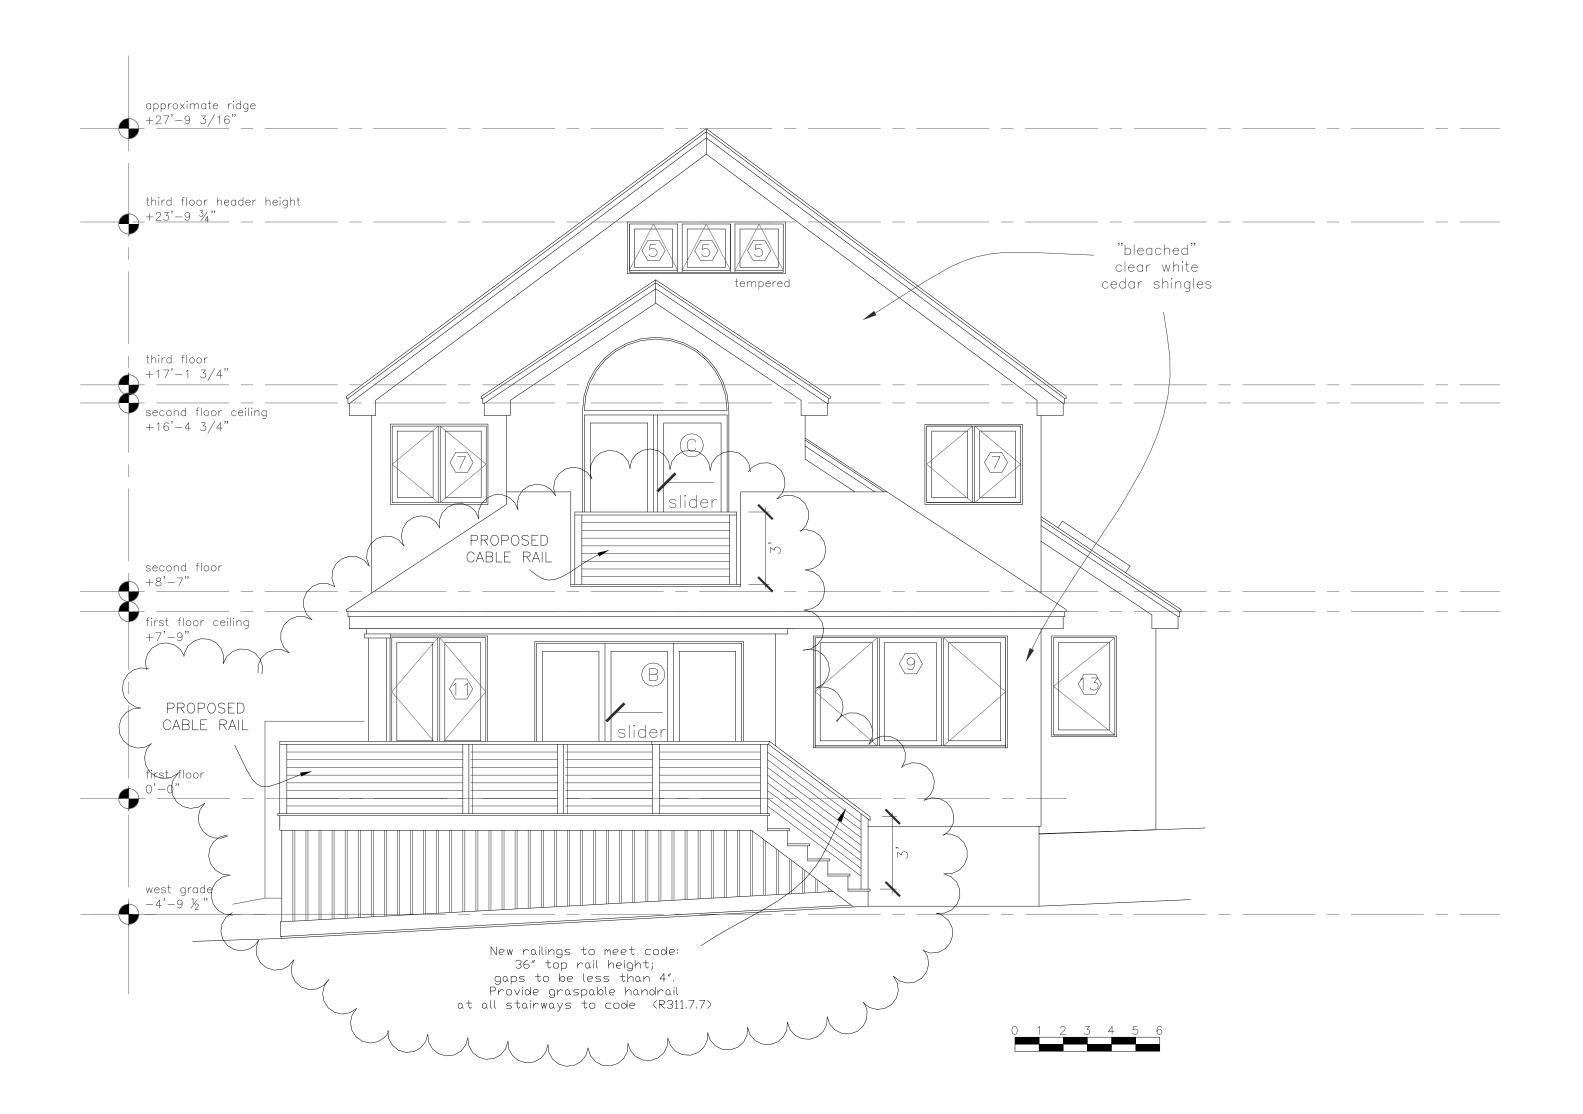

26 Sterling Street Peaks Island, Maine 04108 207.766.5625

**Rachel Conly** 

Architectural Design

Proposed West Elevation

PROJECT


Branson Residence

5 Beach Road Peaks Island, Me. 04108

,	Harvey
1/4"=1'-0"	Rachel &
SCALE	DRAWN BY
5.9.14	5.22.14 10.30.14 7.31.14
DATE	REVISED





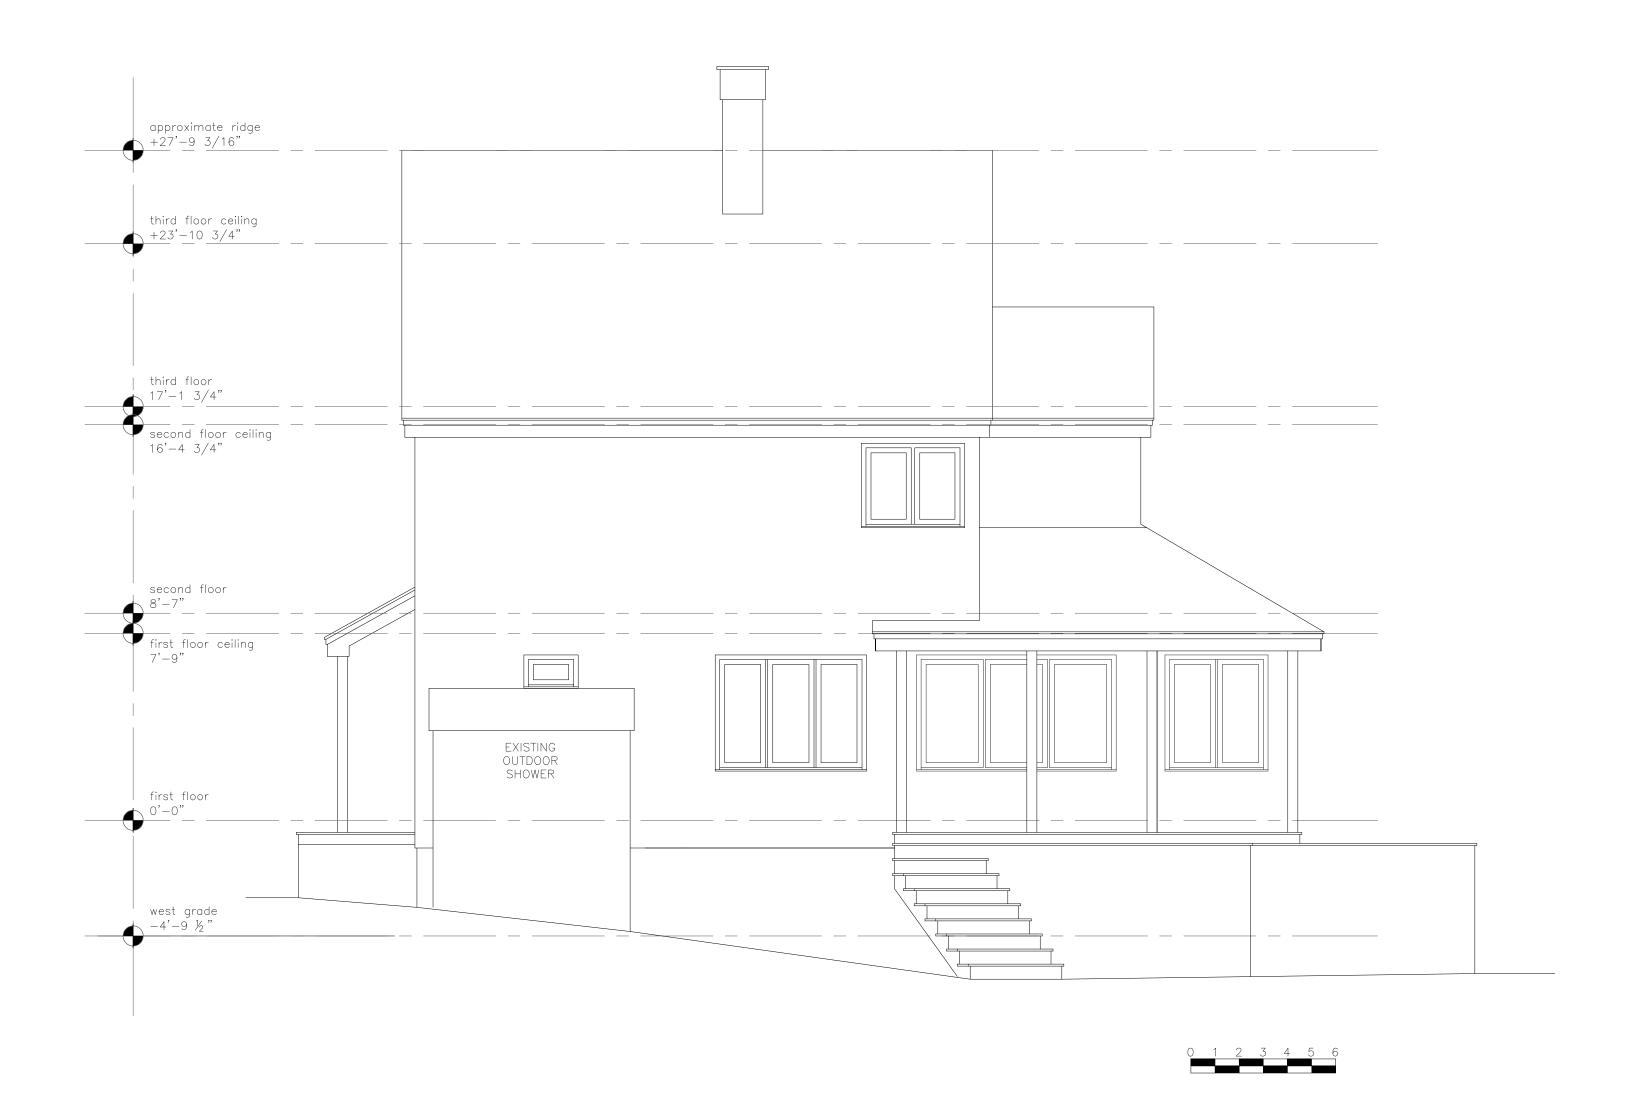

Rachel Conly
Architectural Design

26 Sterling Street
Peaks Island, Maine 04108
207.766.5625

Existing North Elevation

PROJECT


Branson Residence


5 Beach Road Peaks Island, Me. 04108

10.30.14 SCALE	REVISED  DRAWN BY
1/4"=1'-0"	Rachel & Harvey

NOTES



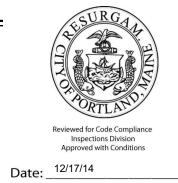

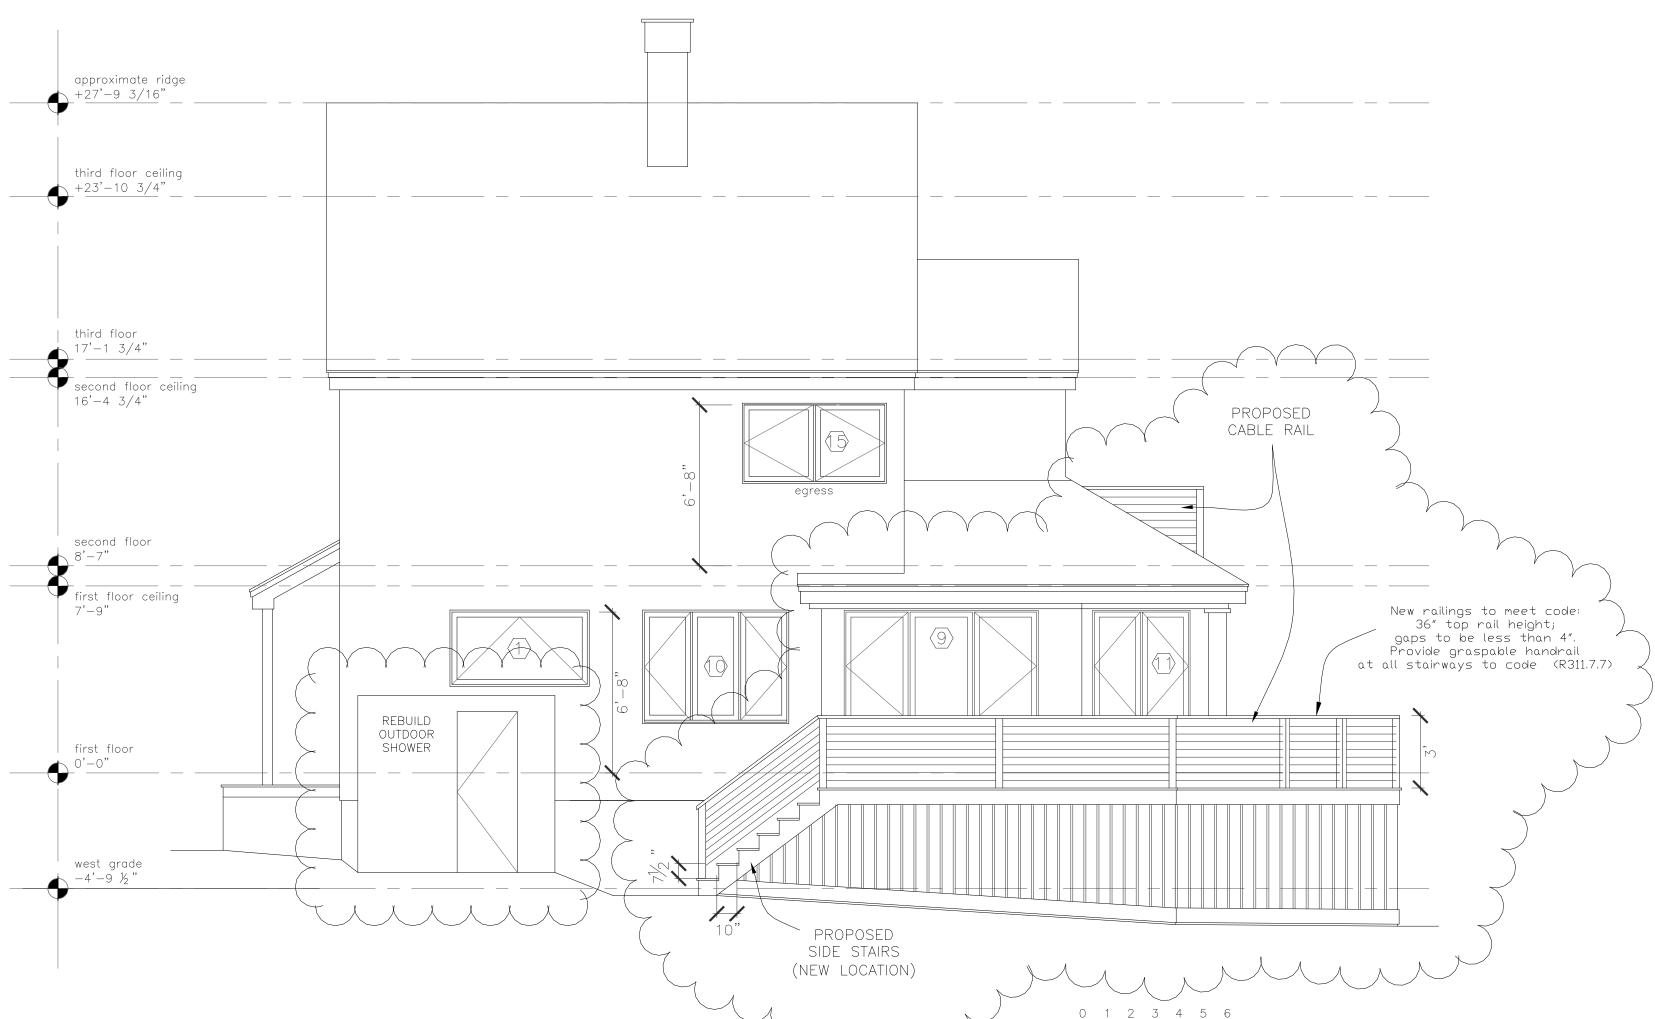

### **Rachel Conly**

Architectural Design

26 Sterling Street Peaks Island, Maine 04108 207.766.5625

> Proposed North Elevation

PROJECT


Branson Residence


5 Beach Road Peaks Island, Me. 04108


DATE	REVISED
10.30.14	
SCALE 1/4"=1'-0"	DRAWN BY  Rachel &
1/4 — 1 — 0	Harvey

NOTEC

 $\frac{\text{Proposed North Elevation}}{1/4" = 1'-0"}$ 

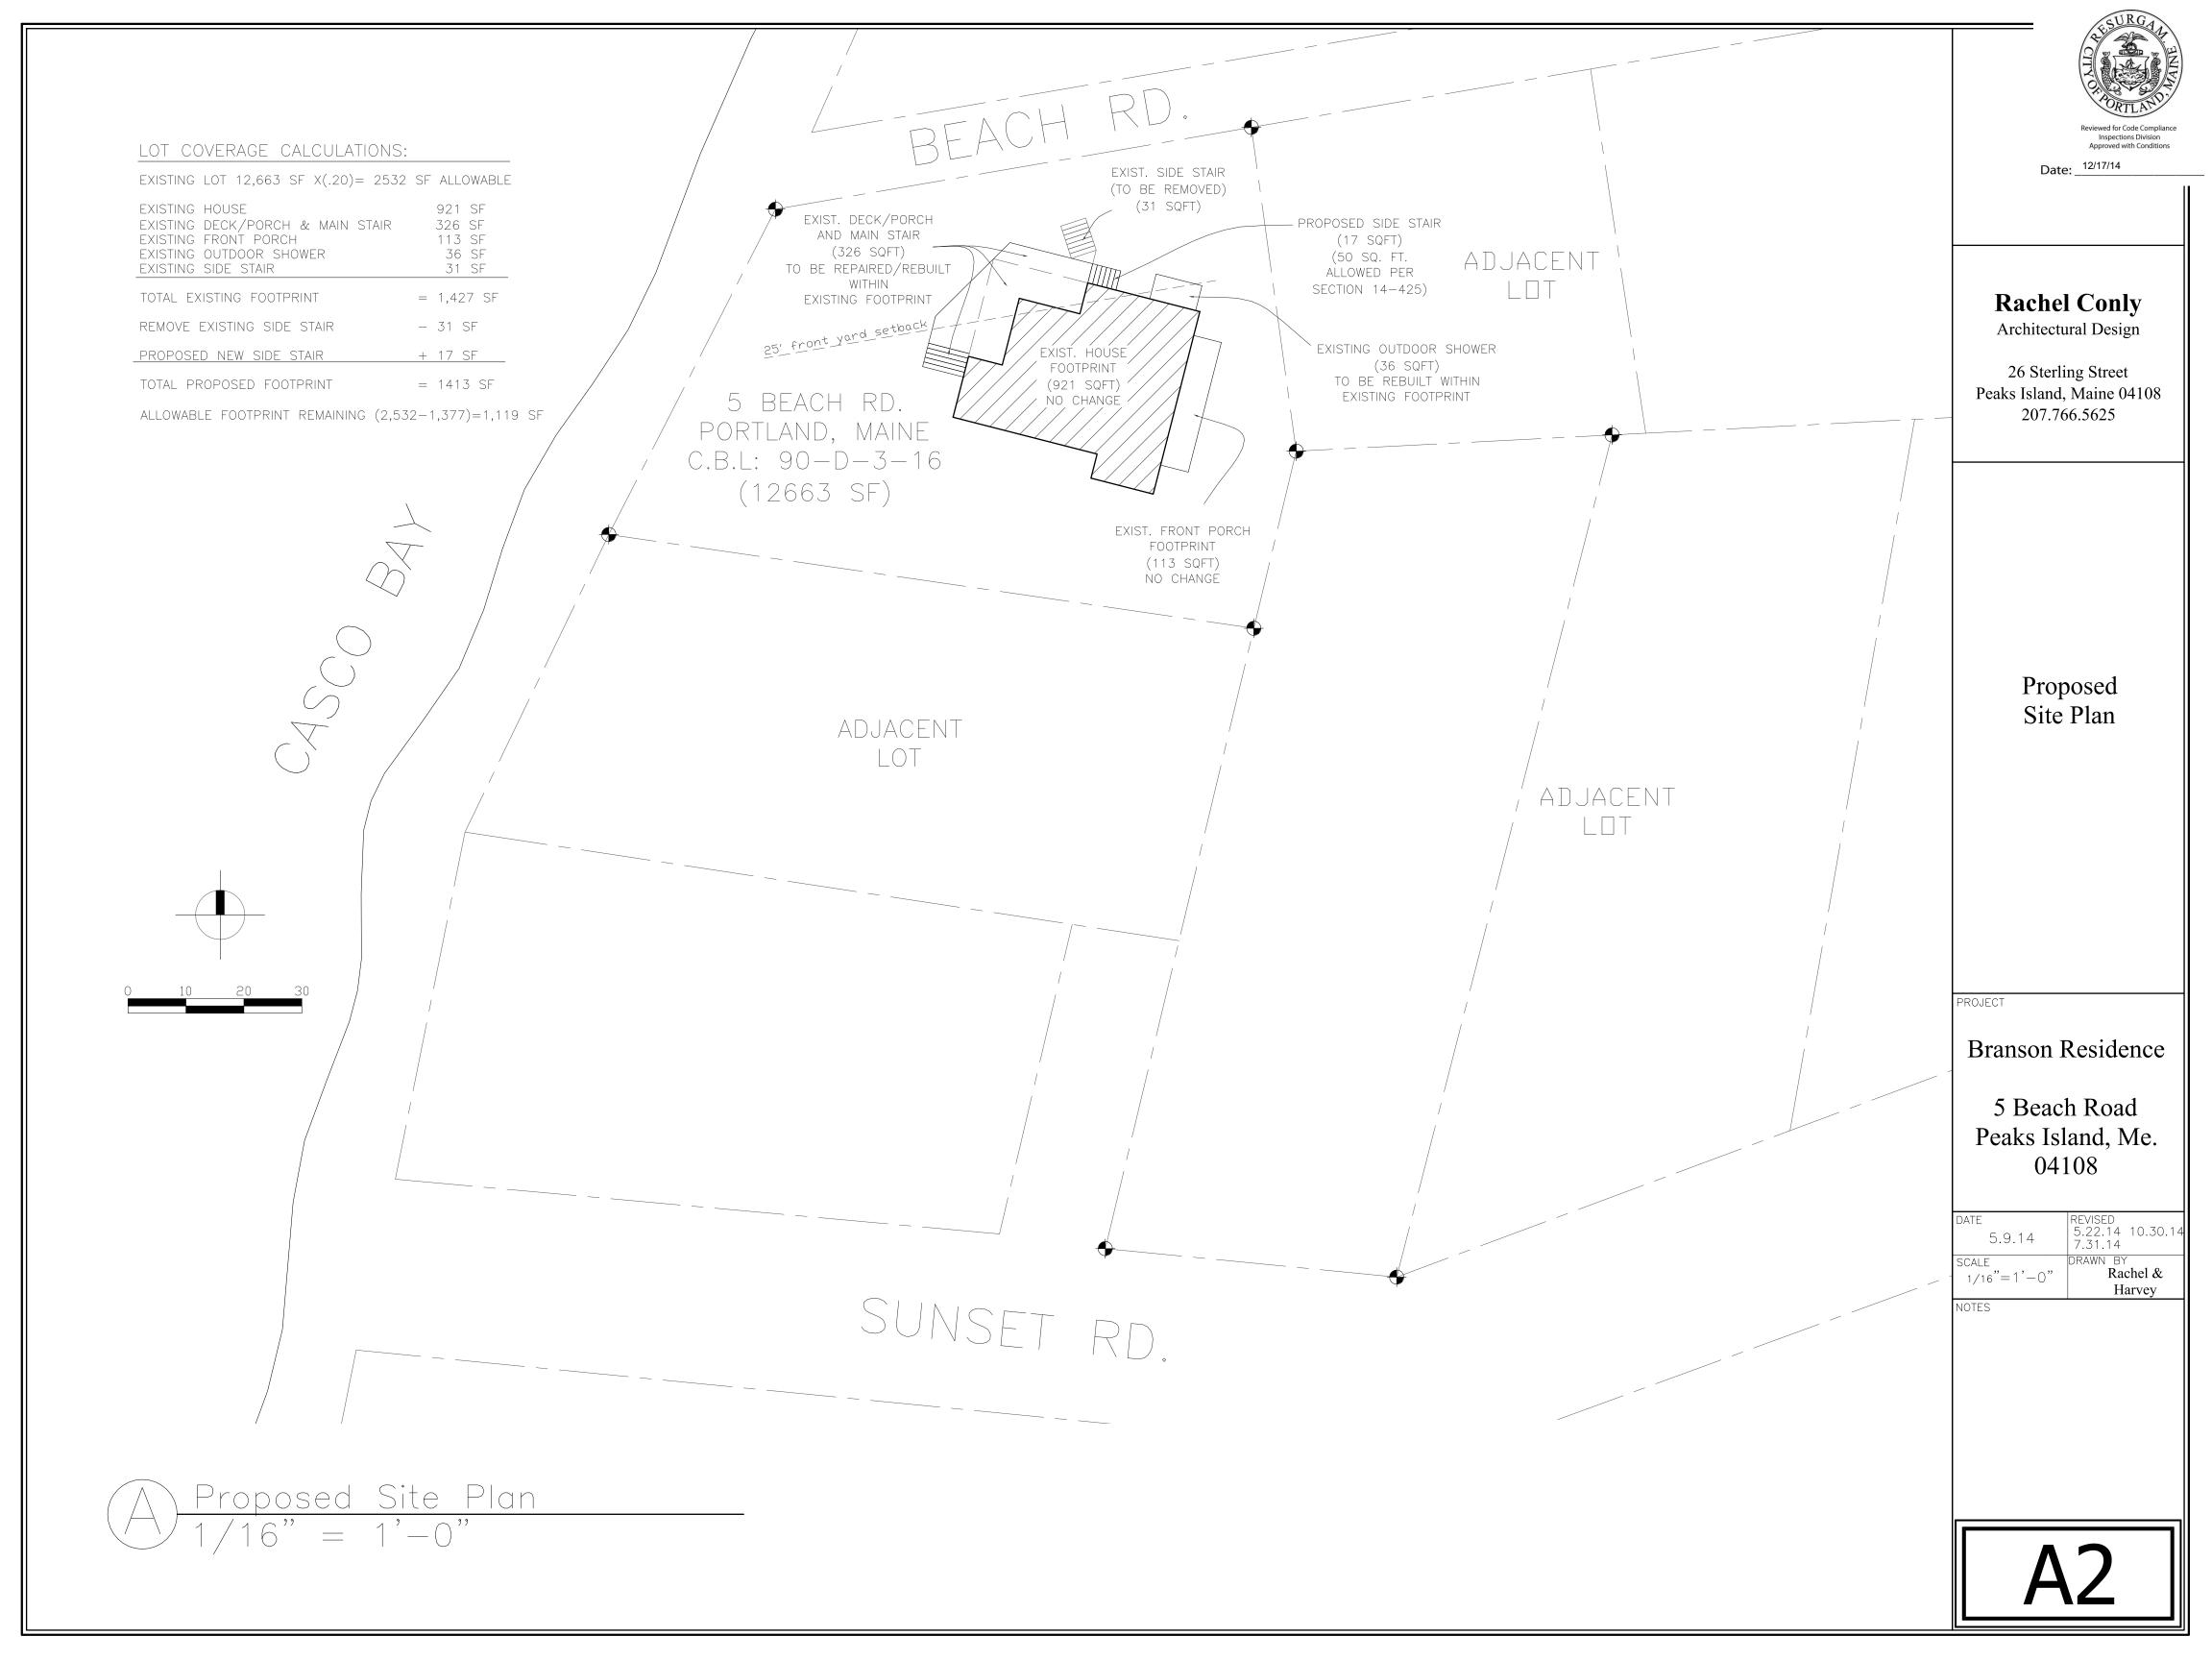

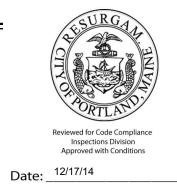

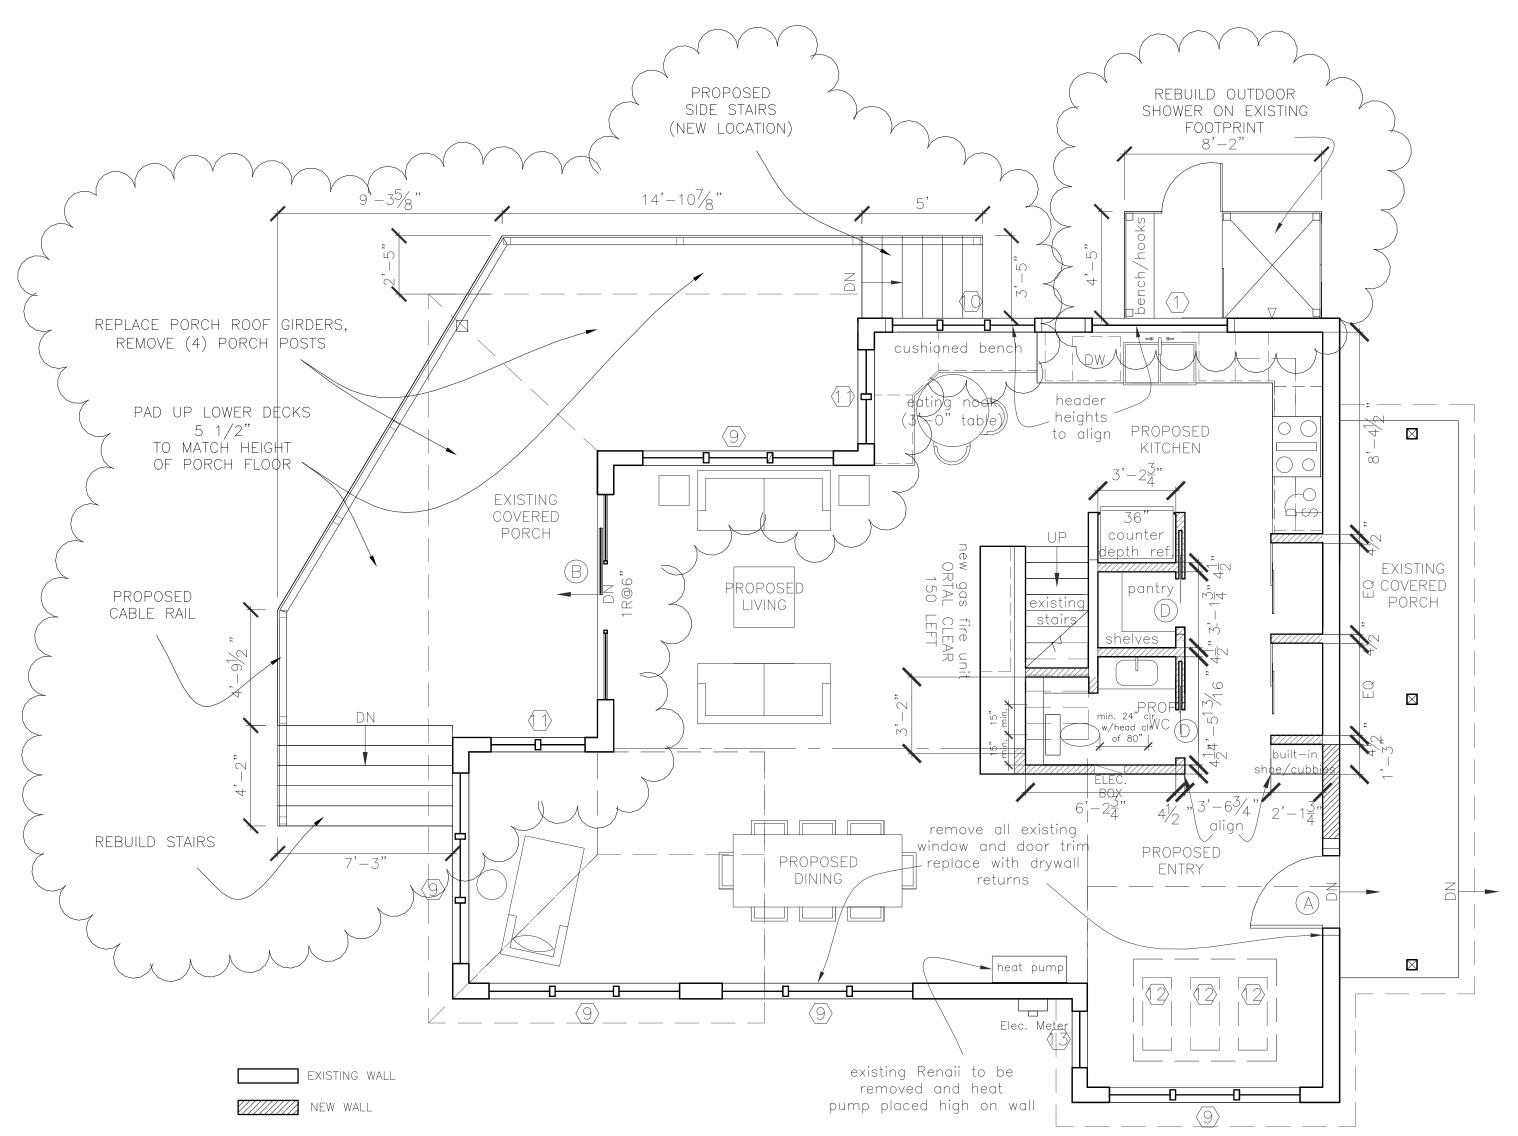

#### NOTES:

- 1.) ASSUME REMOVAL OF EXISTING FIBERGLASS AND INSTALLATION OF DENSEPACK CELLULOSE THROUGHOUT
- 2) ASSUMES MOVING UTILITIES TO INSULATED CRAWL 3) ASSUME SIZING FOR A HEAT PUMP AND HEAT RECOVERY VENTILATOR

### **Rachel Conly**

Architectural Design

26 Sterling Street Peaks Island, Maine 04108 207.766.5625

> Proposed First Floor Plan

PROJECT

Branson Residence

5 Beach Road Peaks Island, Me. 04108

,	Harvey
1/4"=1'-0"	Rachel &
SCALE	DRAWN BY
5.9.14	5.22.14 10.30.14 7.31.14
DATE	REVISED

NOTES







#### CORNER POST FOOTING SPECIFICATIONS

1) 22" SQUARE X 10" THICK FOOTING, MIN. 4'-0" DEEP ON SOIL (OR PINNED TO ROCK)

2) PIERS TO BE MIN. 10" SQUARE OR ROUND, DOWELED TO FOOTING WITH
(2) #3 24" LONG W/ 4" HOOK & (3) #3 VERTICAL BARS & #3 HOOPS AT 8" VERTICAL SPACING.

3) SIMPSON AB-TYPE POST BASE, OR EQUAL INSTALLED PER MANUFACTURER'S RECOMMENDATIONS.

4) PRESSURE TREATED 6X6 POST

5) SOLID BLOCKING WITHIN DECK JOIST BOX (OR CONTINUOS POST FROM ROOF TO PIER)

#### ■ END POST FOOTING SPECIFICATIONS

1) 12" SQUARE X 10" THICK FOOTING, MIN. 4'-0" DEEP ON SOIL (OR PINNED TO ROCK)

2) PIERS TO BE MIN. 8" SQUARE, DOWELED TO FOOTING WITH
(2) #3 24" LONG W/ 4" HOOK & (3) #3 VERTICAL BARS & #3 HOOPS AT 8" VERTICAL SPACING.

3) SIMPSON AB-TYPE POST BASE, OR EQUAL INSTALLED PER MANUFACTURER'S RECOMMENDATIONS.

4) PRESSURE TREATED 6X6 POST

5) SOLID BLOCKING WITHIN JOIST BOX

## EXTERIOR STAIR FOOTING SPECIFICATIONS

2) 8" HOLLOW CMU FROSTWALL (R404.1.1)

1) 12" X 6" FOOTING (R403.1.1) MIN 4'-0" DEEP ON SOIL (OR PINNED TO ROCK)


3) 2X8 P.T. SOLE PLATE ANCHORED TO FROSTWALL ACCORDING TO R403.1.6 (FULLY GROUT CELLS OF TOP COURSE OF CMU TO HOLD ANCHOR BOLTS)

#### O DUTDOOR SHOWER FOOTING SPECIFICATIONS

1) 8"ø X MIN. 48" DEEP CONCRETE "SONOTUBE" FOOTING

2) SIMPSON AB-TYPE POST BASE, OR EQUAL INSTALLED PER MANUFACTURER'S RECOMMENDATIONS

3) 4X4 P.T. POST (FULL HEIGHT OF SHOWER)

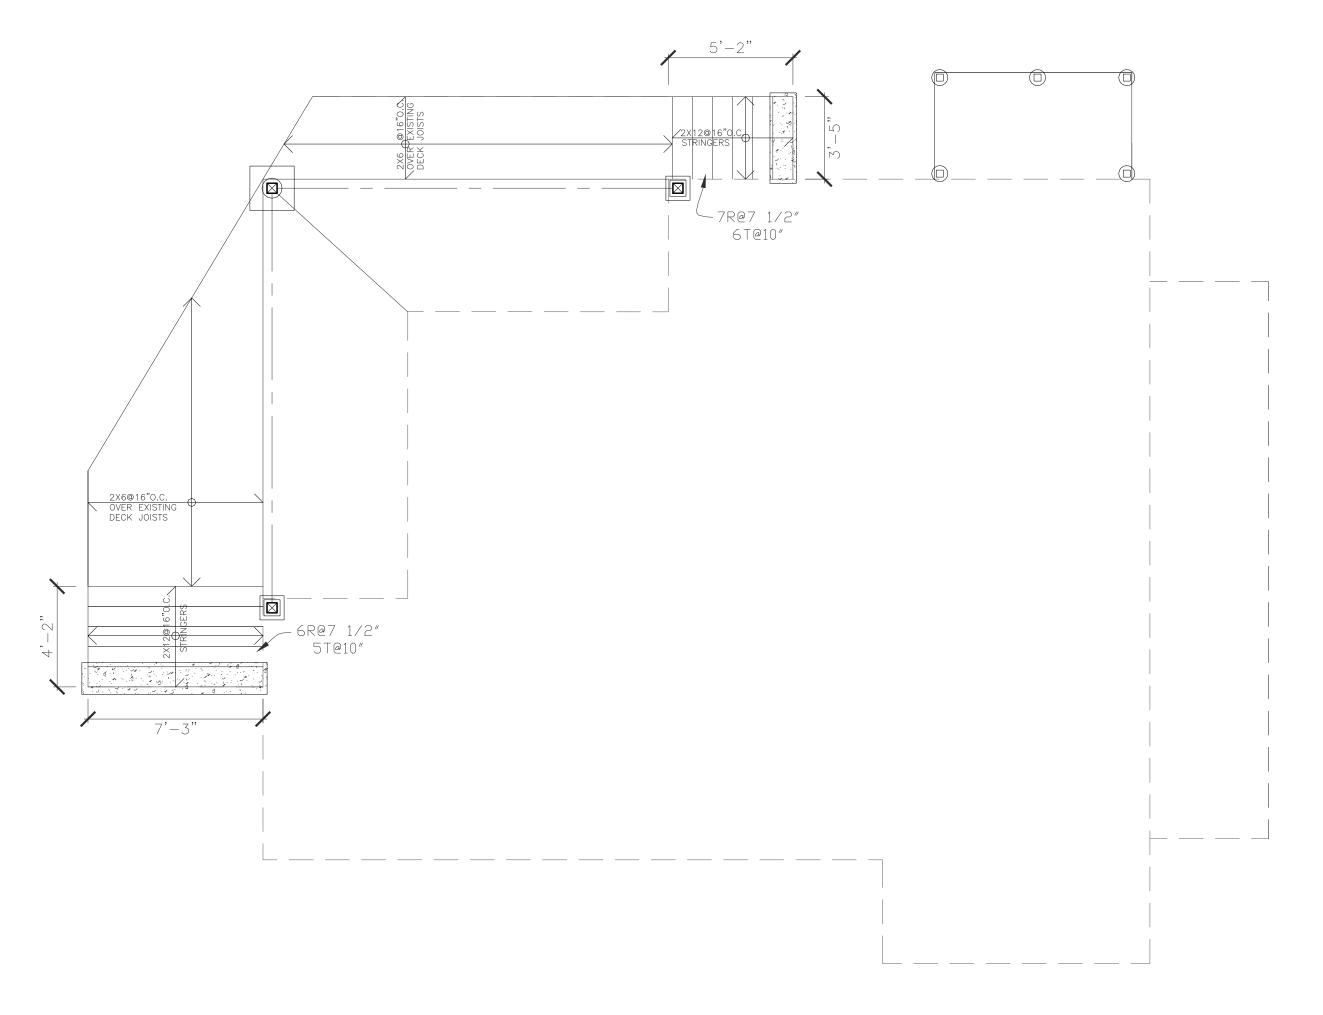





### **Rachel Conly**

Architectural Design

26 Sterling Street
Peaks Island, Maine 04108
207.766.5625

Proposed
Porch/Deck
Foundation
and
Floor Framing
Plan

PROJECT

### Branson Residence

5 Beach Road Peaks Island, Me. 04108

DATE	REVISED
10.30.14	
JUALL	DRAWN BY
1/4"=1'-0"	Rachel &
	Harvey

NIOT







## PORTAND MANE

Strengthening a Remarkable City, Building a Community for Life . www.portlandmaine.gov

Jeff Levine, AICP, Director Director of Planning and Urban Development

Tammy Munson Director, Inspections Division

### Electronic Signature and Fee Payment Confirmation

Notice: Your electronic signature is considered a legal signature per state law.

By digitally signing the attached document(s), you are signifying your understanding this is a legal document and your electronic signature is considered a *legal signature* per Maine state law. You are also signifying your intent on paying your fees by the opportunities below.

I, the undersigned, intend and acknowledge that no permit application can be reviewed until payment of appropriate permit fees are *paid in full* to the Inspections Office, City of Portland Maine by method noted below:

<b>✓</b>	Within 24-48 hours, once my complete p paperwork has been electronically delivered, I is 207-874-8703 and speak to an administrative recard over the phone.	intend to call the Inspections Office at
	Within 24-48 hours, once my permit applicat been electronically delivered, I intend to har Inspections Office, Room 315, Portland City Ha	1d deliver a payment method to the
	I intend to deliver a payment method through t permit paperwork has been electronically deliver	he U.S. Postal Service mail once my red.
Applicant Si	ignature: Rachel A. Conly	Date: 11.03.14
I have provid	ded digital copies and sent them on:	Date: 11.03.14

NOTE: All electronic paperwork must be delivered to <u>buildinginspections@portlandmaine.gov</u> or by physical means ie; a thumb drive or CD to the office.





### General Building Permit Application

If you or the property owner owes real estate or personal property taxes or user charges on any property within the City, payment arrangements must be made before permits of any kind are accepted.


Address/Location of Construction: 5	Beach R	d., Peaks Island. N	/aine 04108
Total Square Footage of Proposed Structure:			
		No Change (1372 sq.ft)	
Tax Assessor's Chart, Block & Lot	Applicant	Name: Idletide, LLC (Branson)	Telephone:
Chart# Block# Lot#	Address	idiondo, ELO (Didison)	207-232-9292
90-D-3-16	7 Tidewa	ter Cove	į
	City, State &	& Zip	Email:
to .	Falmouth	, MĖ 04105	christopher_branson(
Lessee/Owner Name :	Contracto	r Name:	Cost Of Work:
(if different than applicant)	(if different from	r Name: m Applicant) Trademark, Inc.	§ \$18,000 (additional)
Address:	Address:	,	
	380 Cot	tage Rd.	C of O Fee: \$
City, State & Zip:	City, State		
PT 4	South Po	ortland, ME 04106	Historic Rev \$
Telephone & E-mail:	Telephone	& E-mail:	
	207.767.	3552	Total Fees: \$
Current use (i.e. single family) single family			
If vacant, what was the previous use? n/a			···
Proposed Specific use: single family residen	tial (no chang	e)	, <u>, , , , , , , , , , , , , , , , , , </u>
is property part of a subdivision? If yes	, please name	e n/a	70
Project description:			
* This is an Addendum to Permit # 20	13-02605 -	Additional work: renovate	e deck/porch, rebuild ou
Who should we contact when the permit is rea	ady: Rachel	Conly, or Harvey Johnson	<del>t</del>
Address: 26 Sterling St.		my or marroy domination	
City, State & Zip: Peaks Island, ME			
E-mail Address: rachelconlydesign@gmail.	com and ha	arvey rachelconlydesign@	Damail com
Telephone: 207.766.5625		ydorroroomyddolgirid	29man.com
Please submit all of the information of	outlined on	the applicable checklist	Pailum to 1


Please submit all of the information outlined on the applicable checklist. Failure to do so causes an automatic permit denial.

In order to be sure the City fully understands the full scope of the project, the Planning and Development Department may request additional information prior to the issuance of a permit. For further information or to download copies of this form and other applications visit the Inspections Division on-line at <a href="https://www.portlandmaine.gov">www.portlandmaine.gov</a>, or stop by the Inspections Division office, room 315 City Hall or call 874-8703.

I hereby certify that I am the Owner of record of the named property, or that the owner of record authorizes the proposed work and that I have been authorized by the owner to make this application as his/her authorized agent. I agree to conform to all applicable laws of this jurisdiction. In addition, if a permit for work described in this application is issued, I certify that the Code Official's authorized representative shall have the authority to enter all areas covered by this permit at any reasonable hour to enforce the provisions of the codes applicable to this permit.

Signature: Rachel Conly	14.00.44
Signature: Macris Comy	<sub>Date:</sub> 11.03.14
<del></del>	Date:

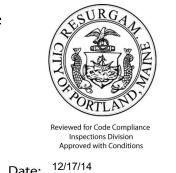

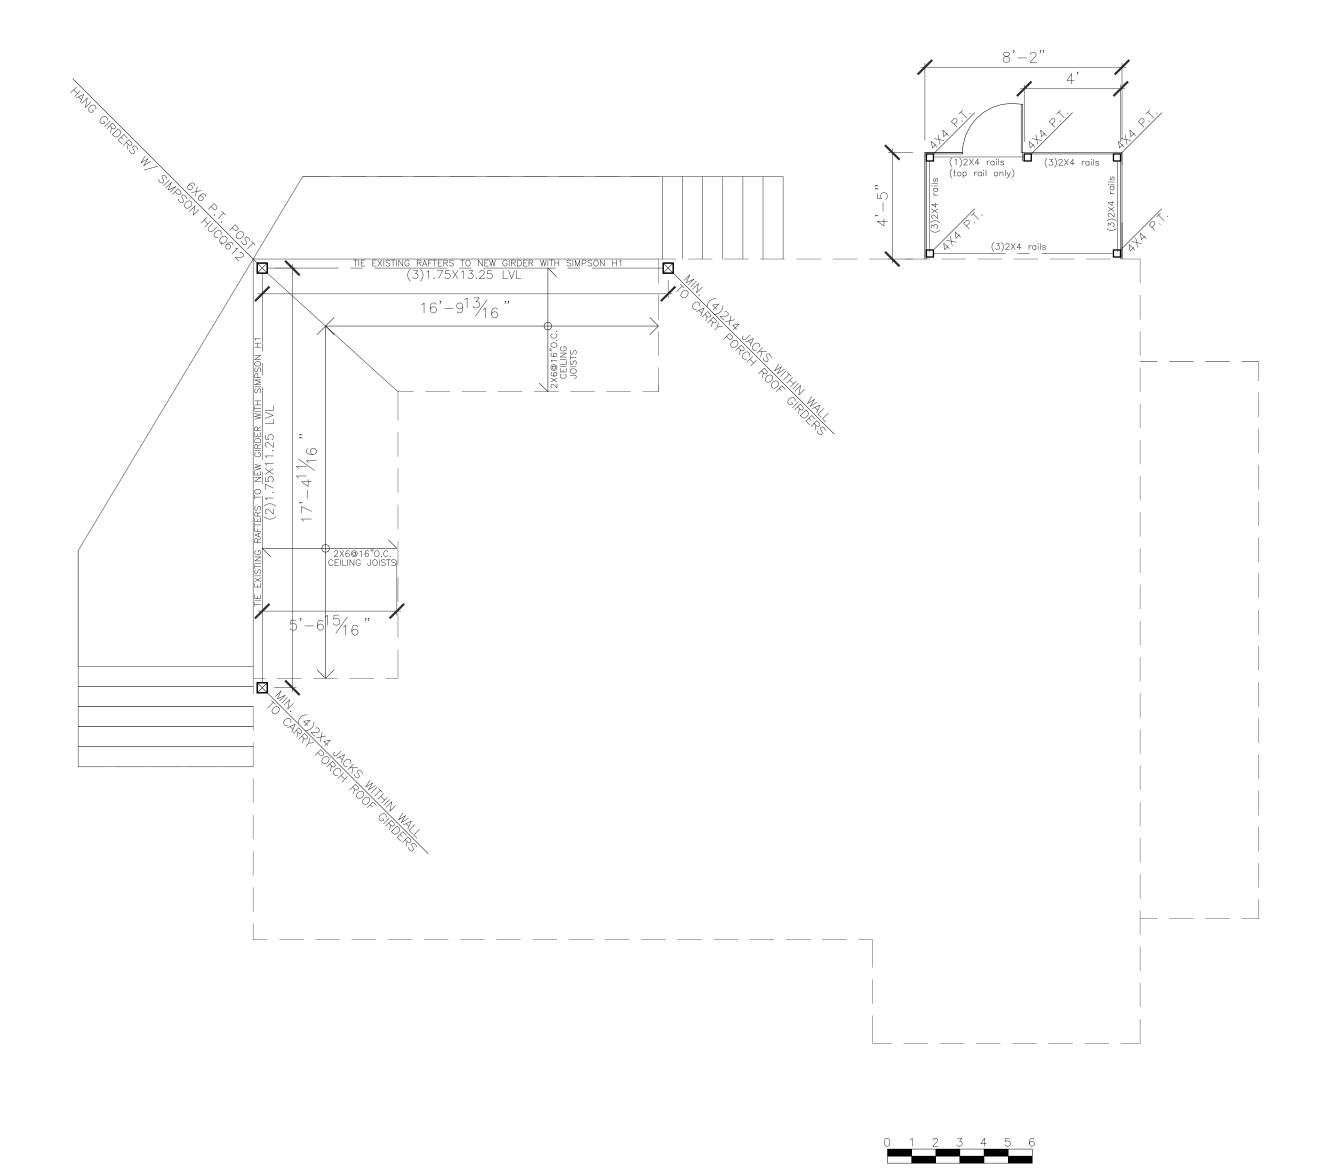

### **Rachel Conly** Architectural Design

26 Sterling Street Peaks Island, Maine 04108 207.766.5625

Proposed Porch Roof and Outdoor Shower Framing Plan

PROJECT

Branson Residence

5 Beach Road Peaks Island, Me. 04108

DATE	REVISED
10.30.14	
10.30.14	
SCALE	DRAWN BY
1/4"=1'-0"	Rachel &
,	Harvey

Proposed Porch Roof and Outdoor Shower Framing 1/4" = 1'-0"