




A SECTION OF EXISTING STRUCTURE
SCALE: 1/2" = 1'-0"

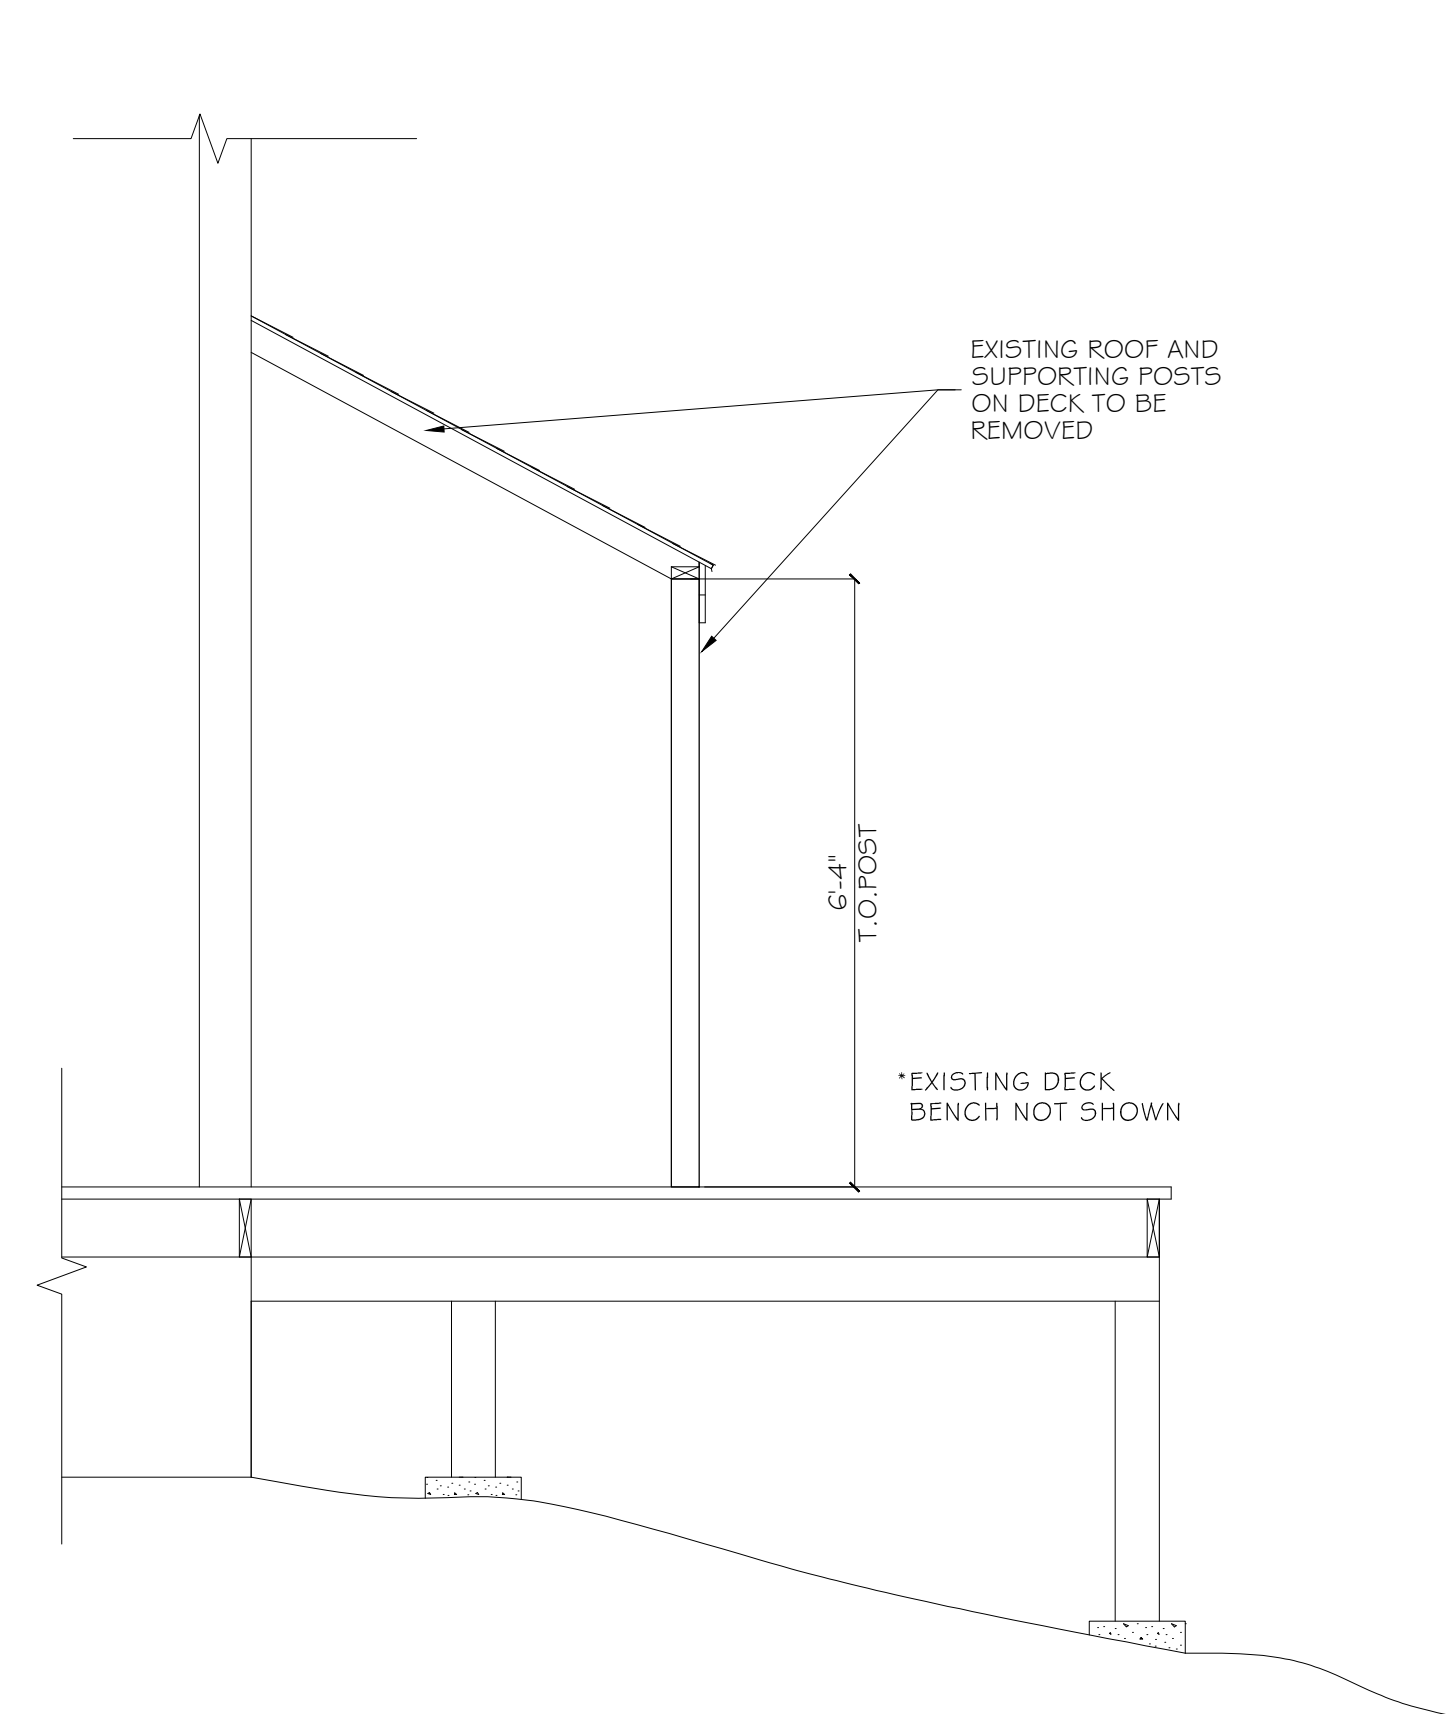

B SECTION OF EXISTING STRUCTURE
SCALE: 1/2" = 1'-0"

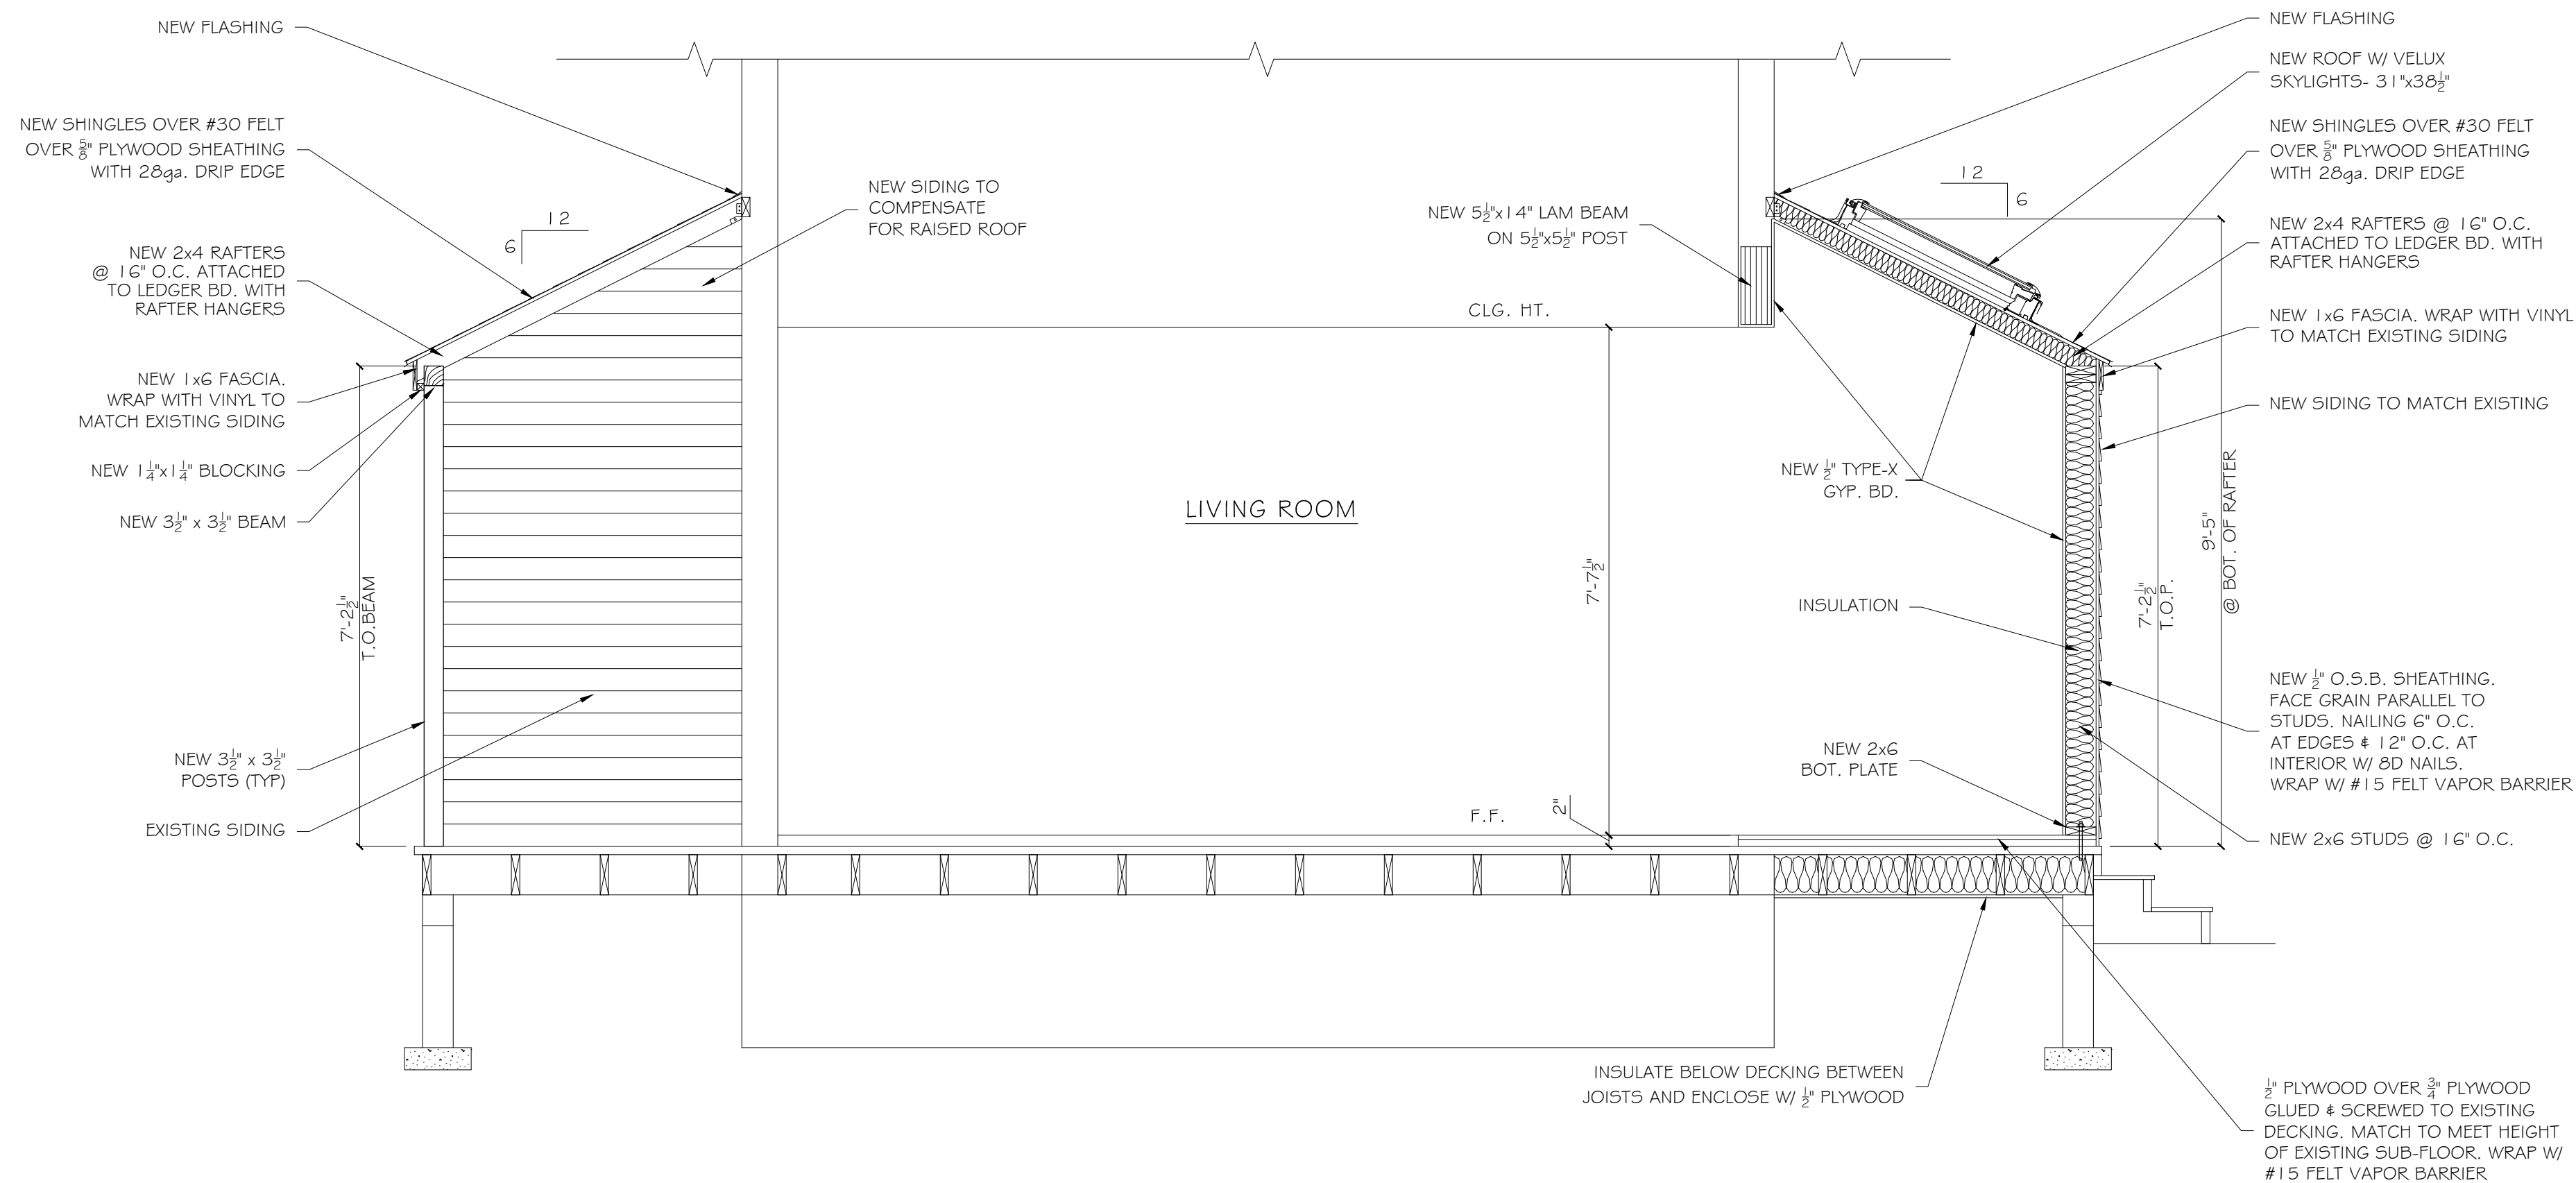

C NEW SECTION
SCALE: 1/2" = 1'-0"

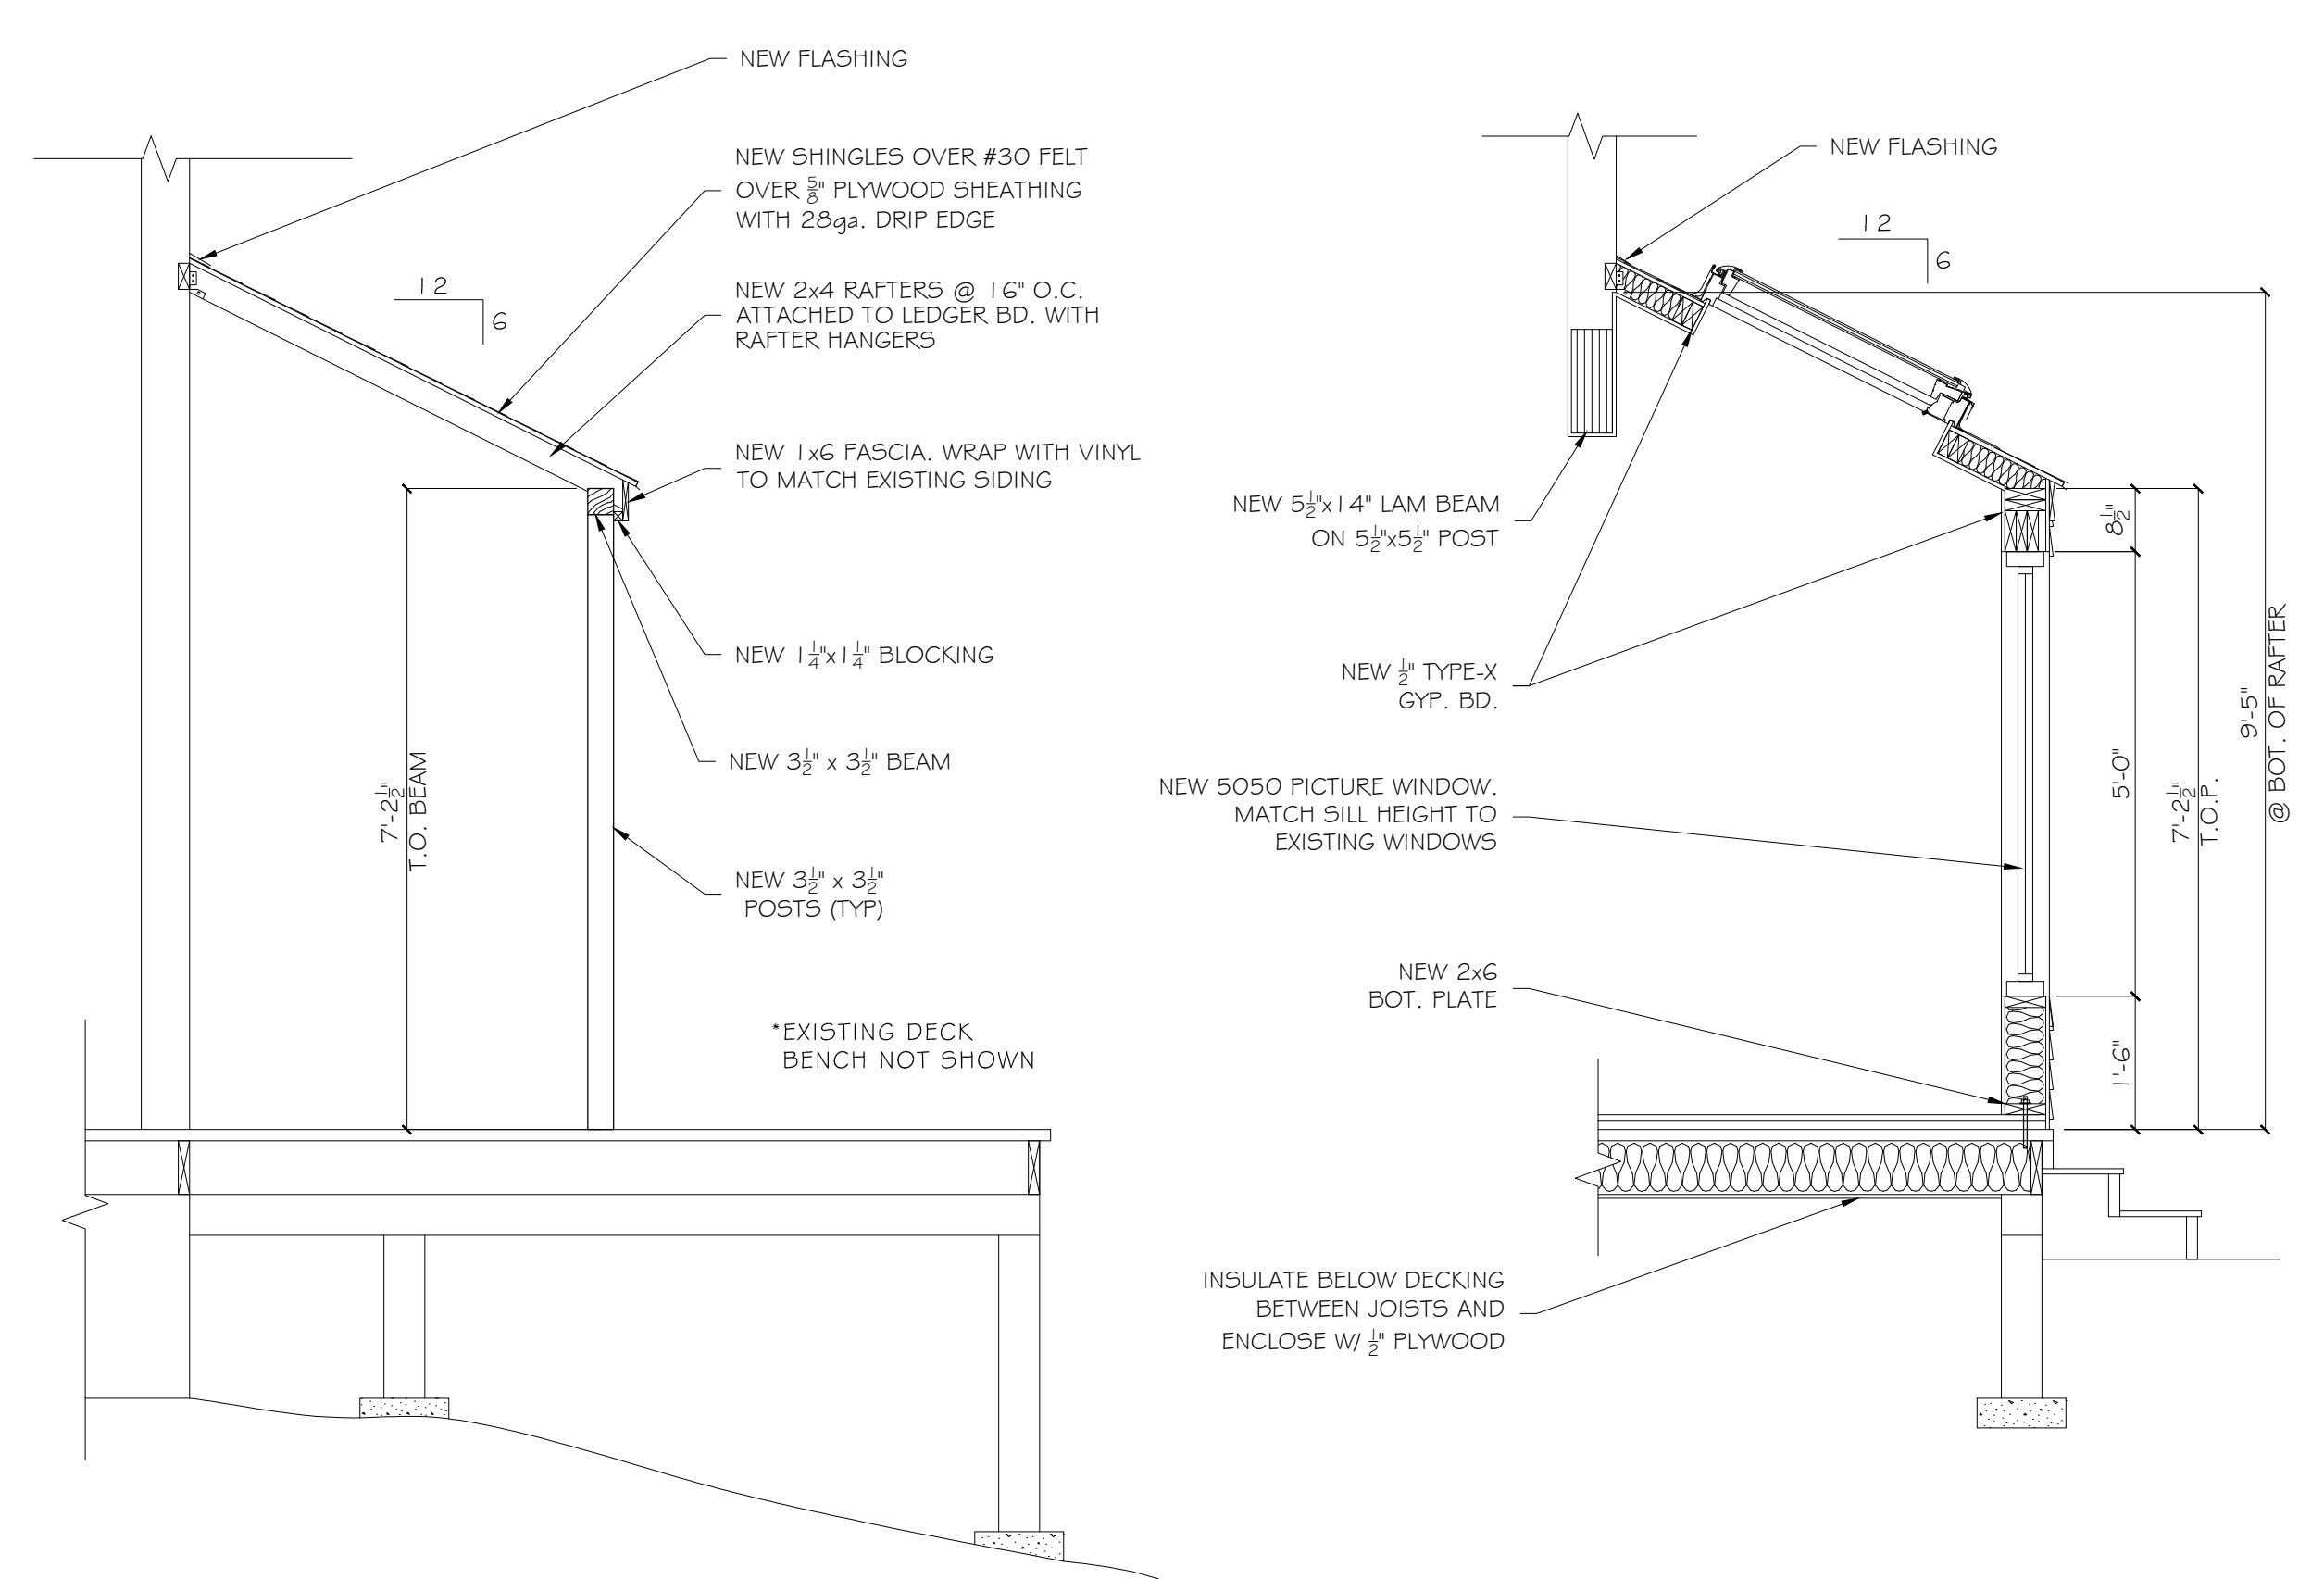

D NEW SECTION
SCALE: 1/2" = 1'-0"

E NEW SECTION
SCALE: 1/2" = 1'-0"

* CONTRACTOR/BUILDER TO VERIFY ALL DIMENSIONS, MATERIALS, FASTENING SCHEDULES, ETC., AND TO COMPLY WITH ALL LOCAL BUILDING CODES AND ORDINANCES.

| | |
|---|--|
| | |
| DATE | |
| BY | |
| DESCRIPTION | |
| No. | |
| <p>SHEET TITLE: "AS BUILT" DWGS AND RENOVATION</p> | |
| <p>PROJECT DESCRIPTION: JEREMY SHERMAN PEAKS ISLAND, MAINE</p> | |
| <p>DRAWINGS PROVIDED BY: HELEN E. AUGUST -DRAFTING & DESIGN- 44 Congress Street #3 Portland, Maine 04101 T. 214-606-4129 helenaugust@hotmail.com</p> | |
| <p>JOB #:</p> | |
| <p>DATE: NOV. 15, 2014</p> | |
| <p>SCALE: AS NOTED</p> | |
| <p>SHEET: 3 OF 3</p> | |