



ROOF & FLOOR PLAN OF RENOVATIONS
SCALE: 1/4" = 1'-0"


CODE: IBC
 Snow: $P_g = 60$ PSF
 $P_F = 42 + \text{DRIFT}$
 $W_{LL} = 30$ PSF
 2ND
 TEMP. SHORING, MEANS
 & METHODS BY CONTRACTOR.
 LVL BY BOISE CASCADE
 OR EQUAL

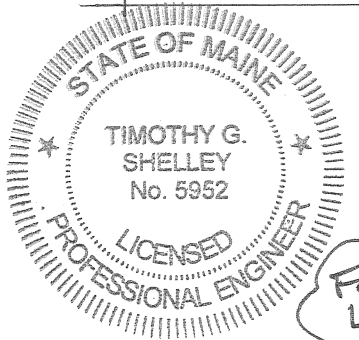


FOR NEW LVL BEAM
 TGS

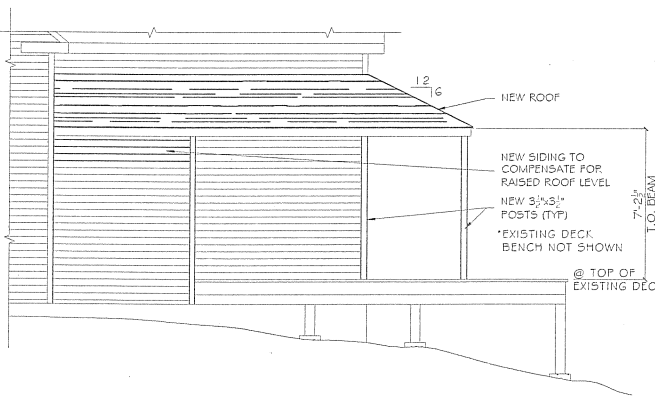

① LEFT ELEVATION OF NEW RENOVATIONS
SCALE: 1/4" = 1'-0"

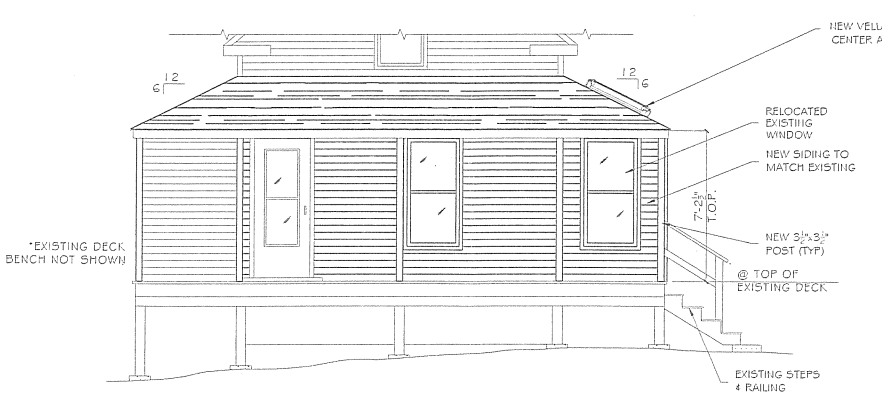


② FRONT ELEVATION OF NEW RENOVATIONS
SCALE: 1/4" = 1'-0"

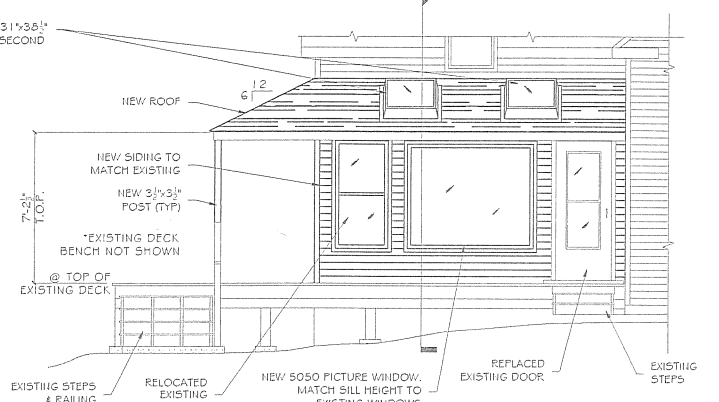


③ RIGHT ELEVATION OF NEW RENOVATIONS
SCALE: 1/4" = 1'-0"

* CONTRACTOR/BUILDER TO VERIFY ALL DIMENSIONS, MATERIALS, FASTENING SCHEDULES, ETC., AND TO COMPLY WITH ALL LOCAL BUILDING CODES AND ORDINANCES.


DATE	
BY	
DESCRIPTION	
NO.	
SHEET TITLE: "AS BUILT" DWGS AND RENOVATION	
PROJECT DESCRIPTION: JEREMY SHERMAN PEARS ISLAND, MAINE	
DRAWINGS PROVIDED BY: HELEN E. AUGUST -DRAFTING & DESIGN- 44 Congress Street #3 Portland, Maine 04101 T: 204-606-1129 helenaugust@frontiernet.net	
JOB #:	
DATE: NOV. 15, 2014	
SCALE: AS NOTED	
SHEET: 2 OF 3	

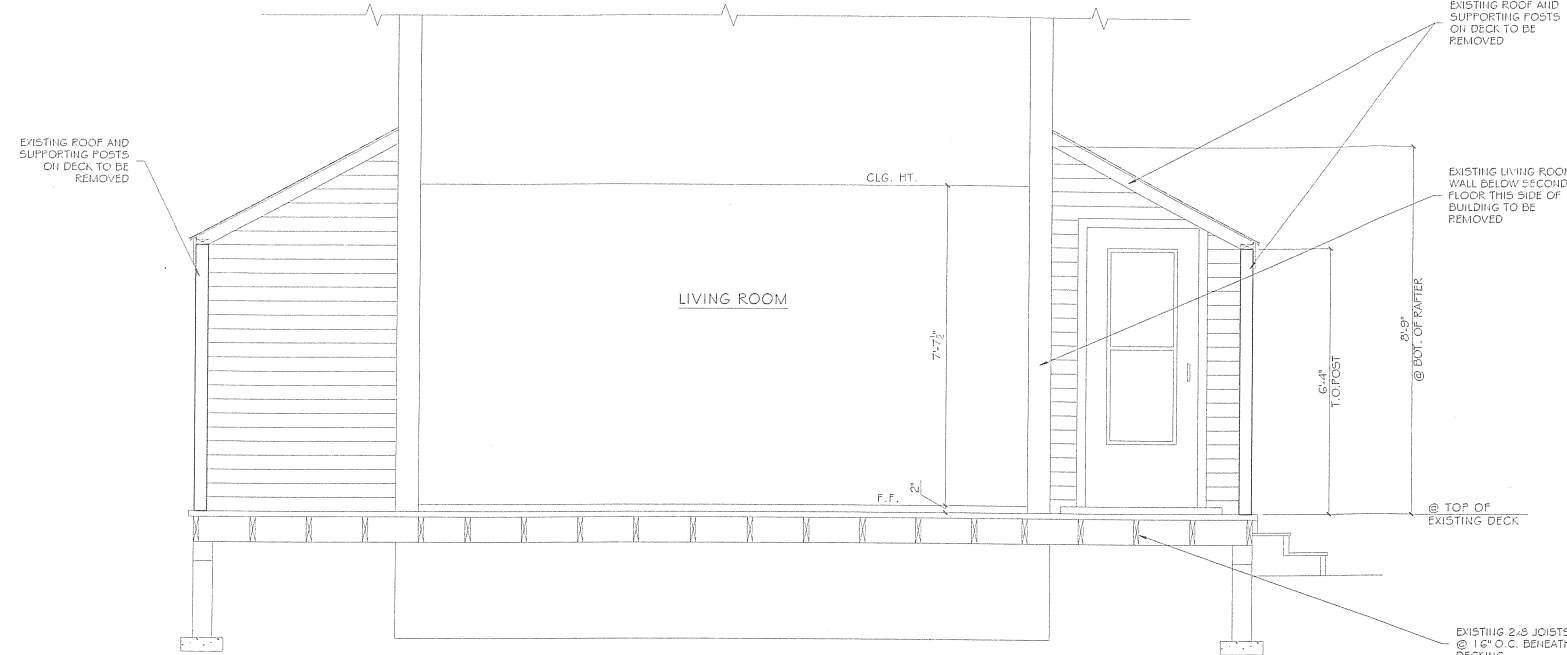


A SECTION OF EXISTING STRUCTURE
SCALE: 1/2" = 1'-0"

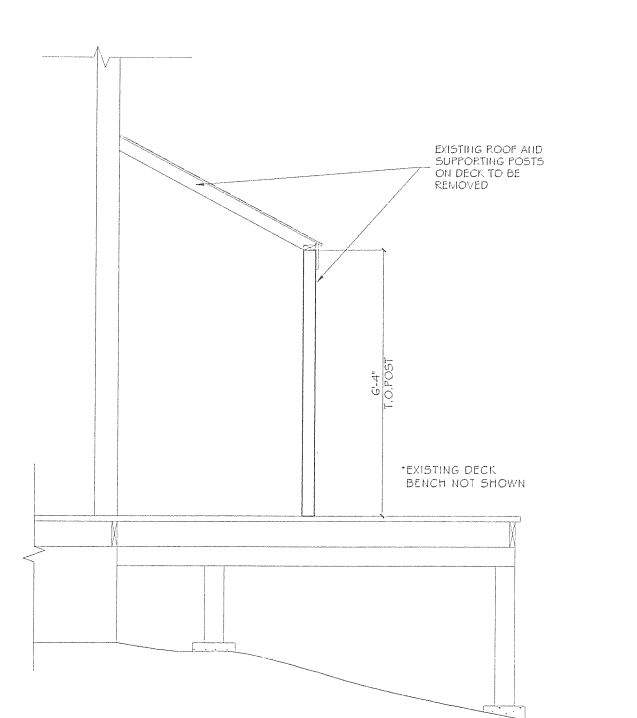


B SECTION OF EXISTING STRUCTURE
SCALE: 1/2" = 1'-0"

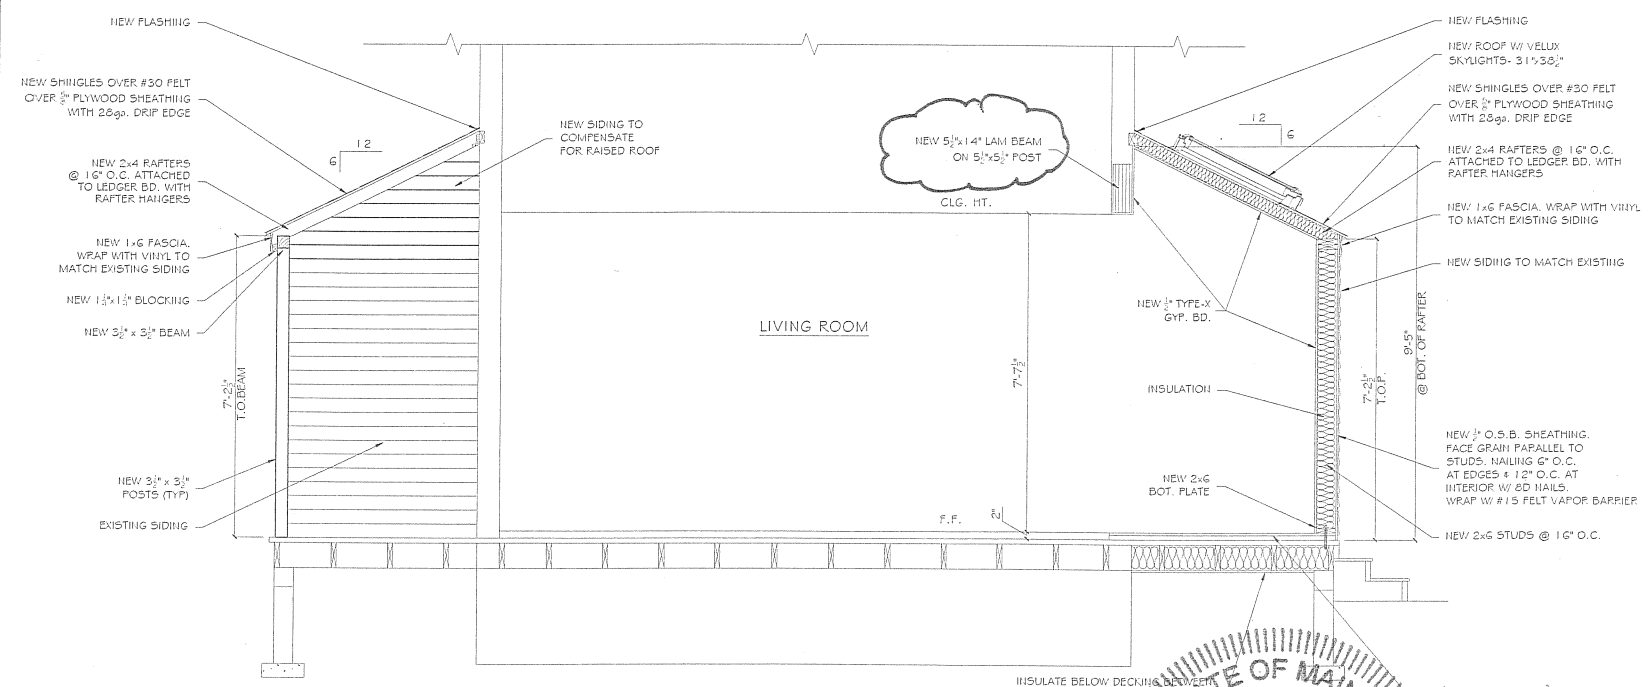


C NEW SECTION
SCALE: 1/2" = 1'-0"

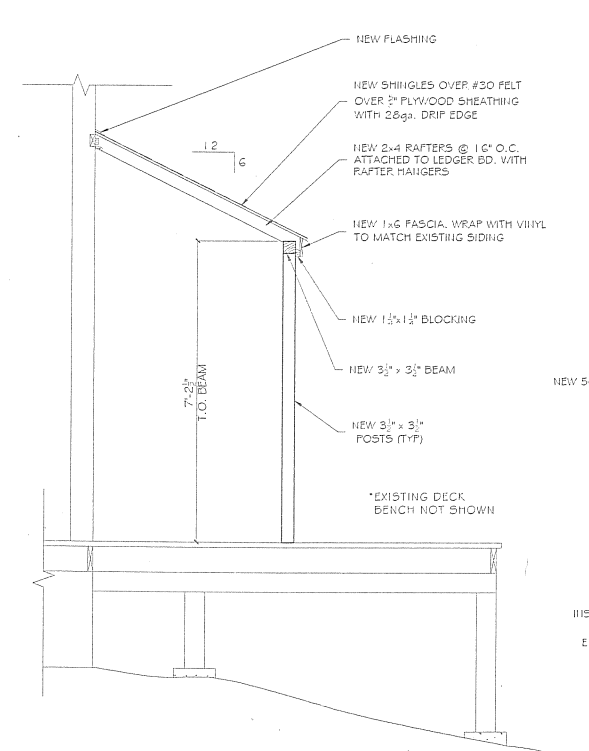

D NEW SECTION
SCALE: 1/2" = 1'-0"

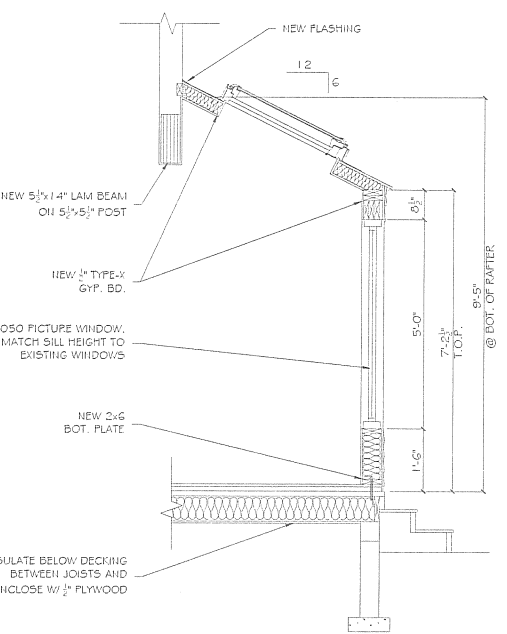

E NEW SECTION
SCALE: 1/2" = 1'-0"

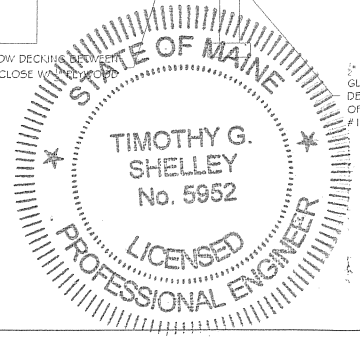

FOR NEW LVL BEAM
T45

* CONTRACTOR/BUILDER TO VERIFY ALL DIMENSIONS, MATERIALS, FASTENING SCHEDULES, ETC., AND TO COMPLY WITH ALL LOCAL BUILDING CODES AND ORDINANCES.

NO.	DESCRIPTION
BY	DATE
SHEET TITLE: "AS BUILT" DWGS AND RENOVATION	
PROJECT DESCRIPTION: JEREMY SHERMAN PEAKS ISLAND, MAINE	
DRAWINGS PROVIDED BY: HELEN E. AUGUST -DRAFTING & DESIGN- 44 Congress Street #3 Portland, Maine 04101 T. 214-600-1129 helenaugust@hotmail.com	
JOB #:	
DATE: NOV. 15, 2014	
SCALE: AS NOTED	
SHEET: 3 OF 3	