


"AS-BUILT" NOTE:
 NEW CONCRETE
 PIERS + FOOTINGS
 BY EZ-TUBE PRECAST,
 TYPICAL

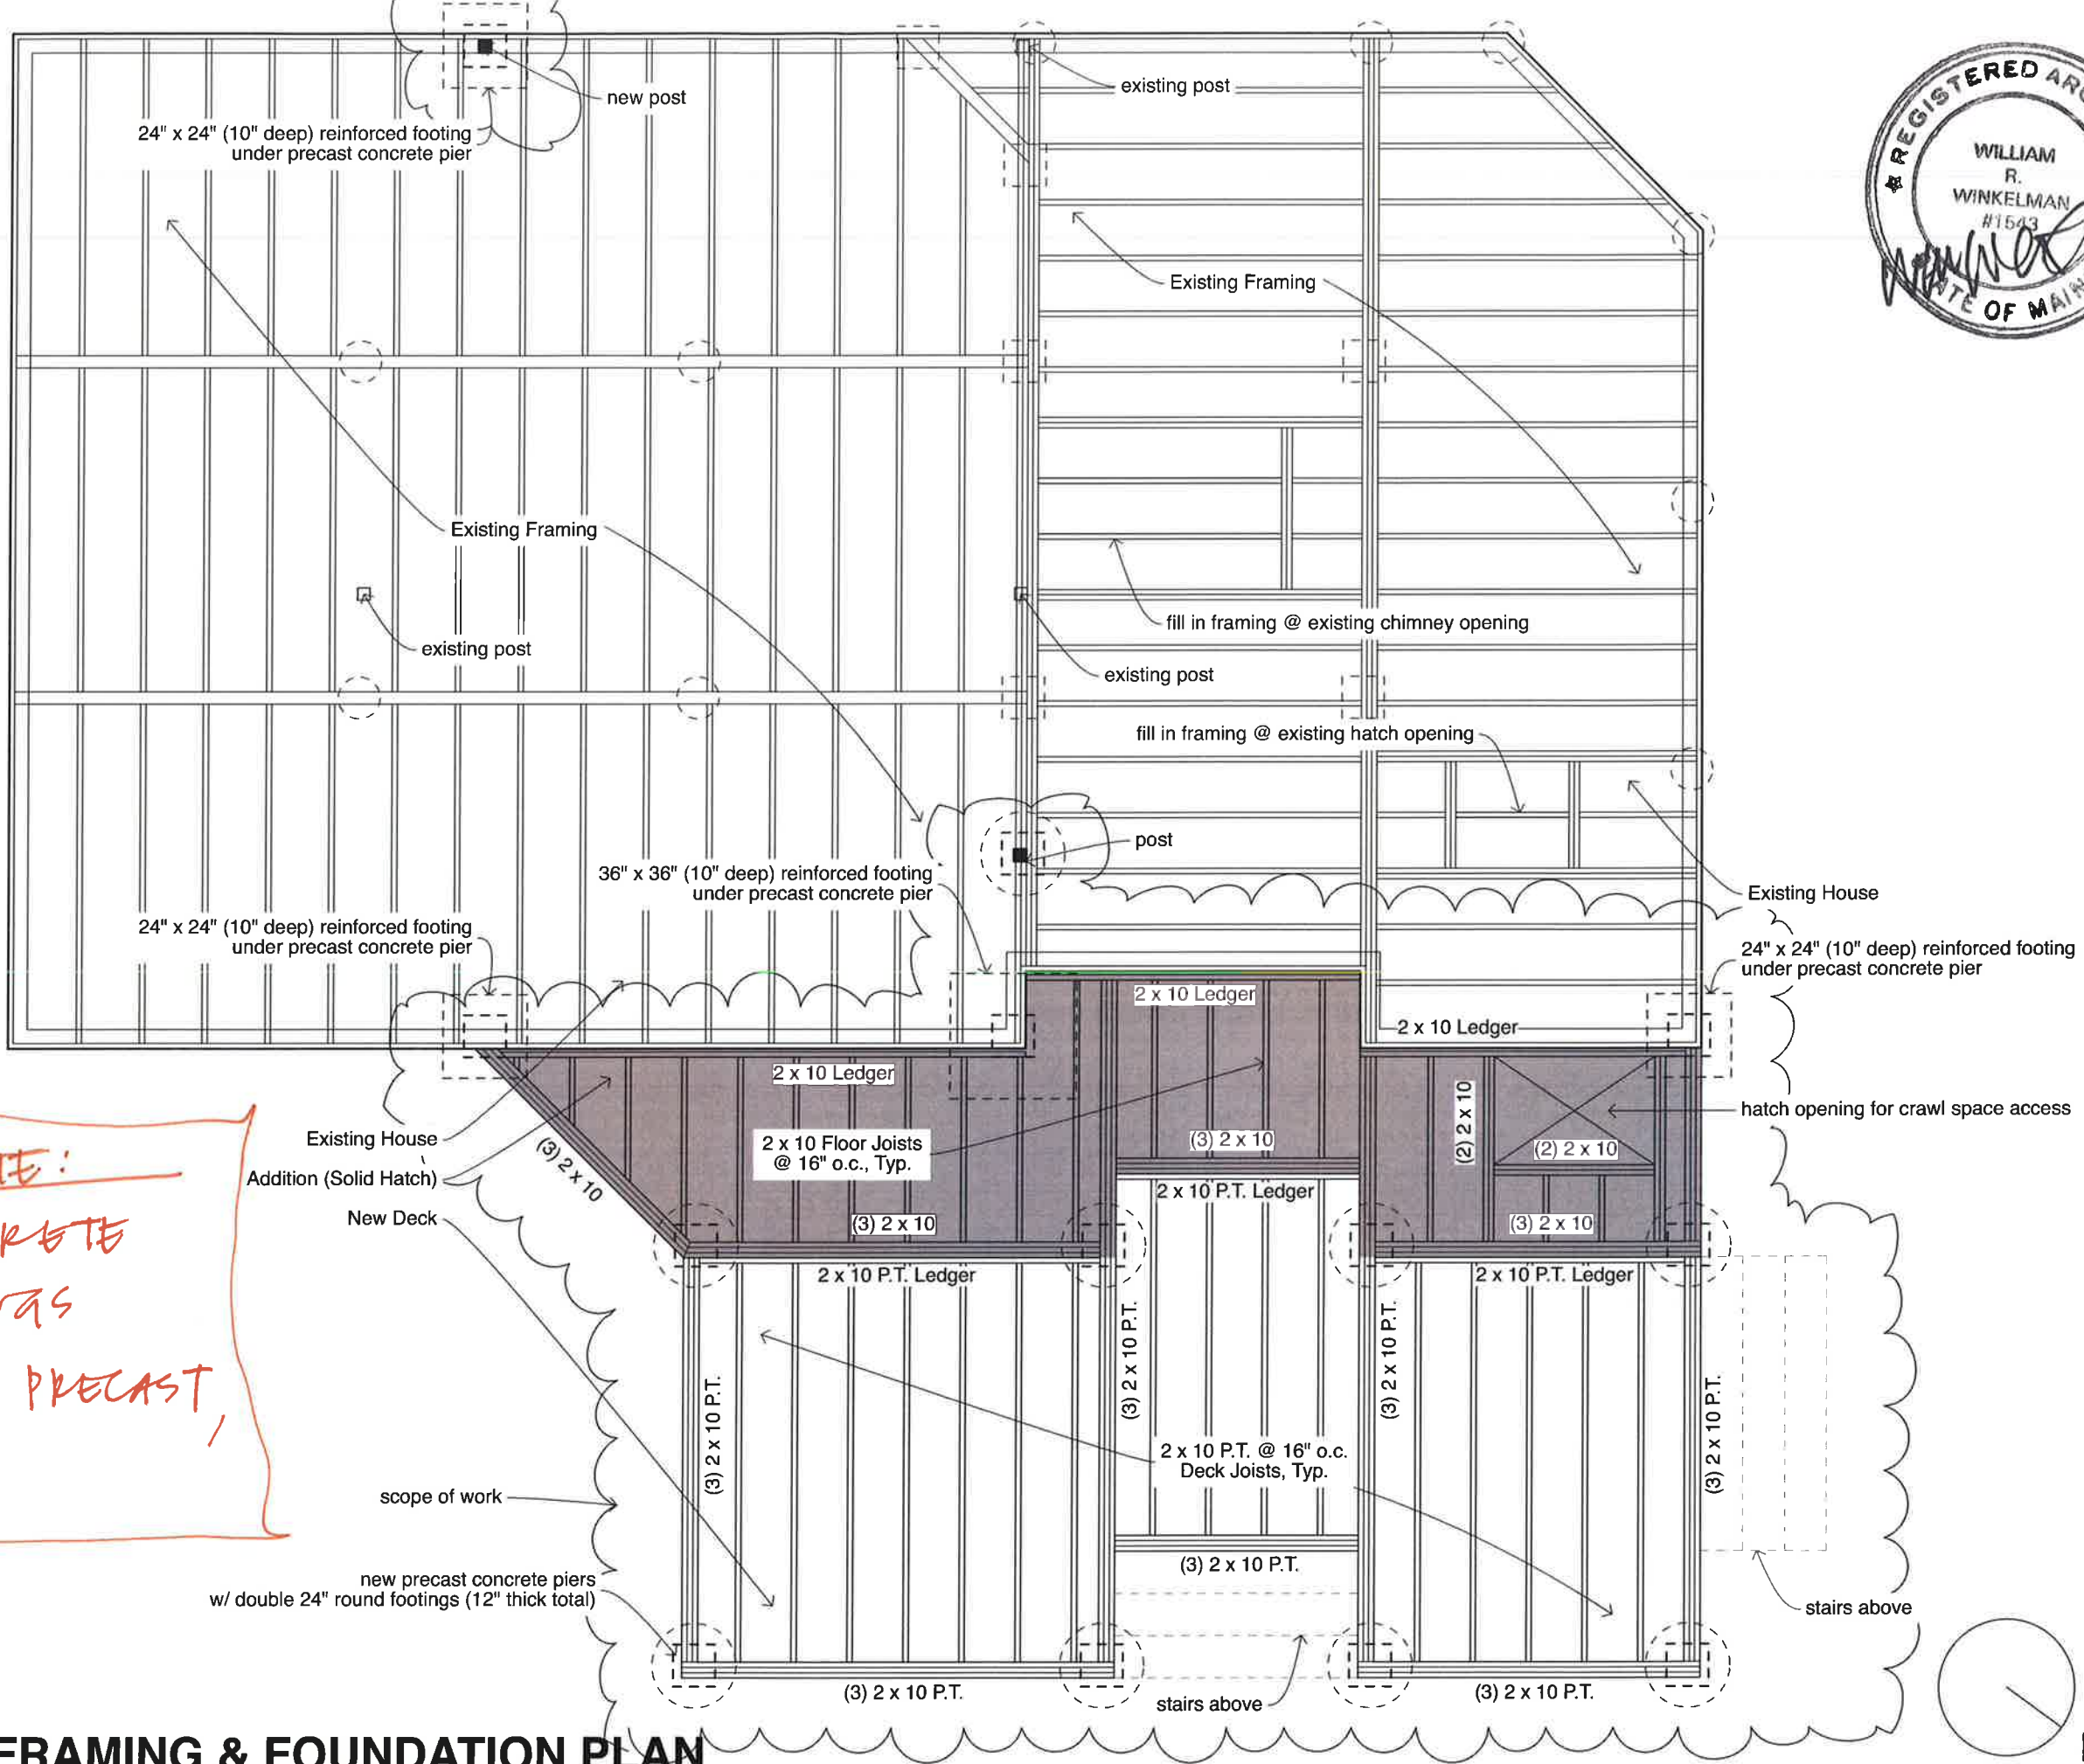

FIRST FLOOR FRAMING & FOUNDATION PLAN