



CABLE COLLAR TIE SECTION
 1 1/2" = 1'-0"

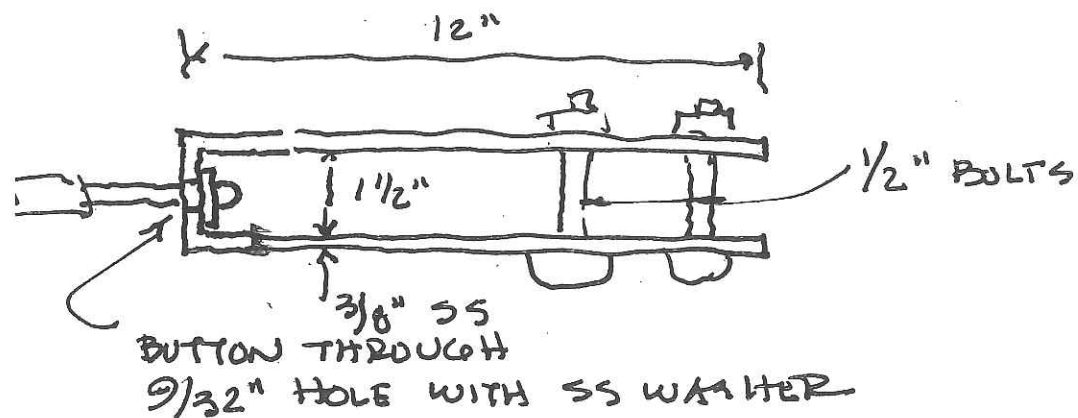

SS STEEL SADDLE PLAN (OR - PAINTED STEEL PLATE)
 3" = 1'-0"

STEVENS LDI GUEST COTTAGE
 COLLAR TIE DETAILS
 (PART #S ARE JOHNSON ARCHITECTURAL)

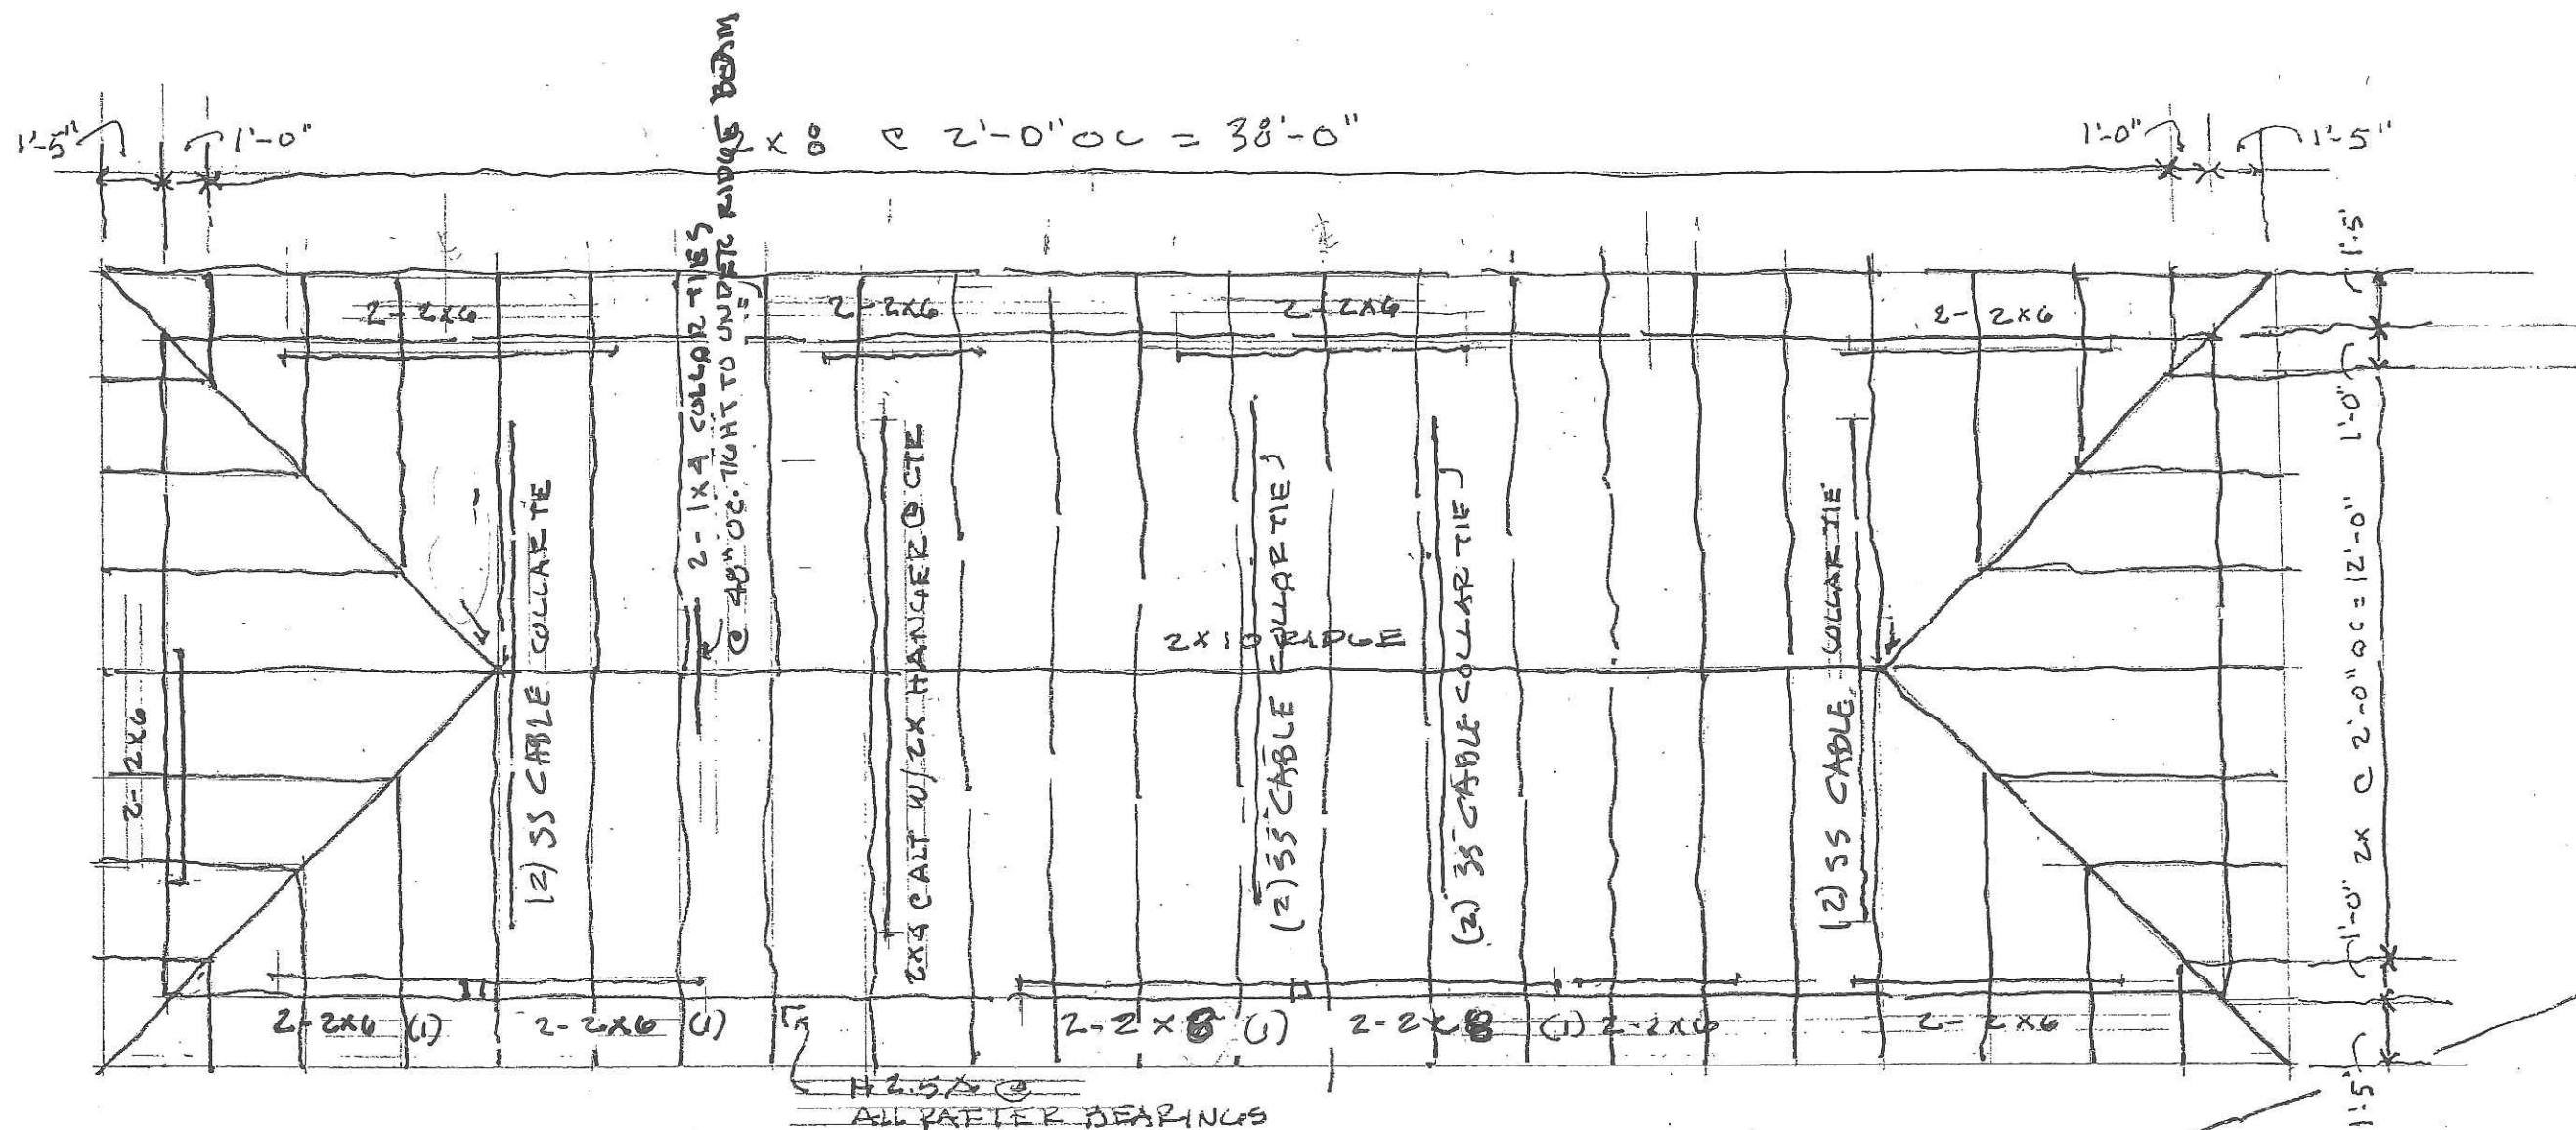


STEVENS IDI
 ROOF FRAMING PLAN 1/4" = 1'-0"

SPF #2 OR BETTER
 SIMPSON MODEL #3
 ALL METAL TO BE HD GALV. UN TREATED WOOD STAIN SIL & TREATED W/P

- 12/21/12 REV 4/21/13 REV 8/10/13
- AS BUILT HEADERS (1)
 - SS CABLE COLLAR TIES (2)
SEE ATTACHED DETAILS
 - OTHER COLLAR TIES (3)

(3) AT HIDDEN LOCATIONS USE 1" 2x4 FASTENED WITH 5# 8 x 2 1/2" SCREWS AT EACH END

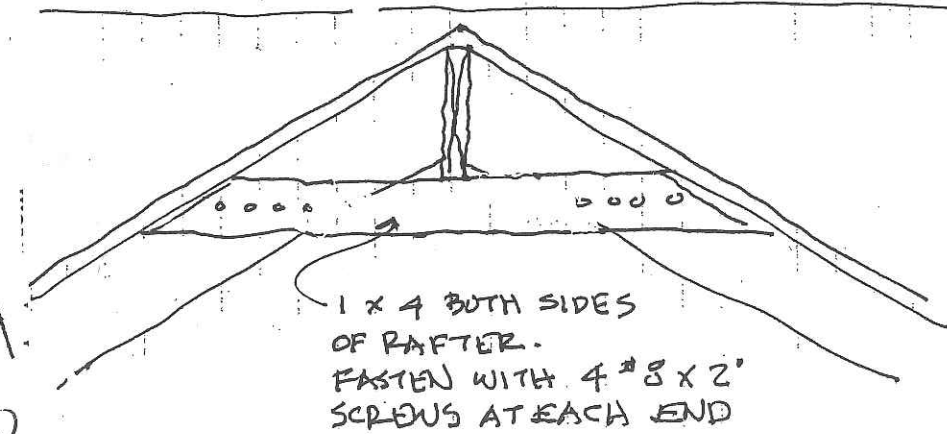

(3) COLLAR TIE DETAIL @ 4 EXPOSED COLLAR TIE LOCATIONS NOT TO SCALE

H 2.5 x 6 @ ALL RAFTER BEARINGS