


Existing footprint of cottage including stairs to shed 855 s.f per G. Schleh note - verify deck? Deck included in Schleh calc. verified. Existing lot size is 22,569.1 s.f. per G. Schleh measured to high water mark (EI 6').

Dashed red line is subsurface septic line & septic tank.

Solid red circle is existing pumped well.

Planned addition is shown by blue outline.

Addition will consist of a single floor bedroom supported by concrete posts with a small bath and a closet.

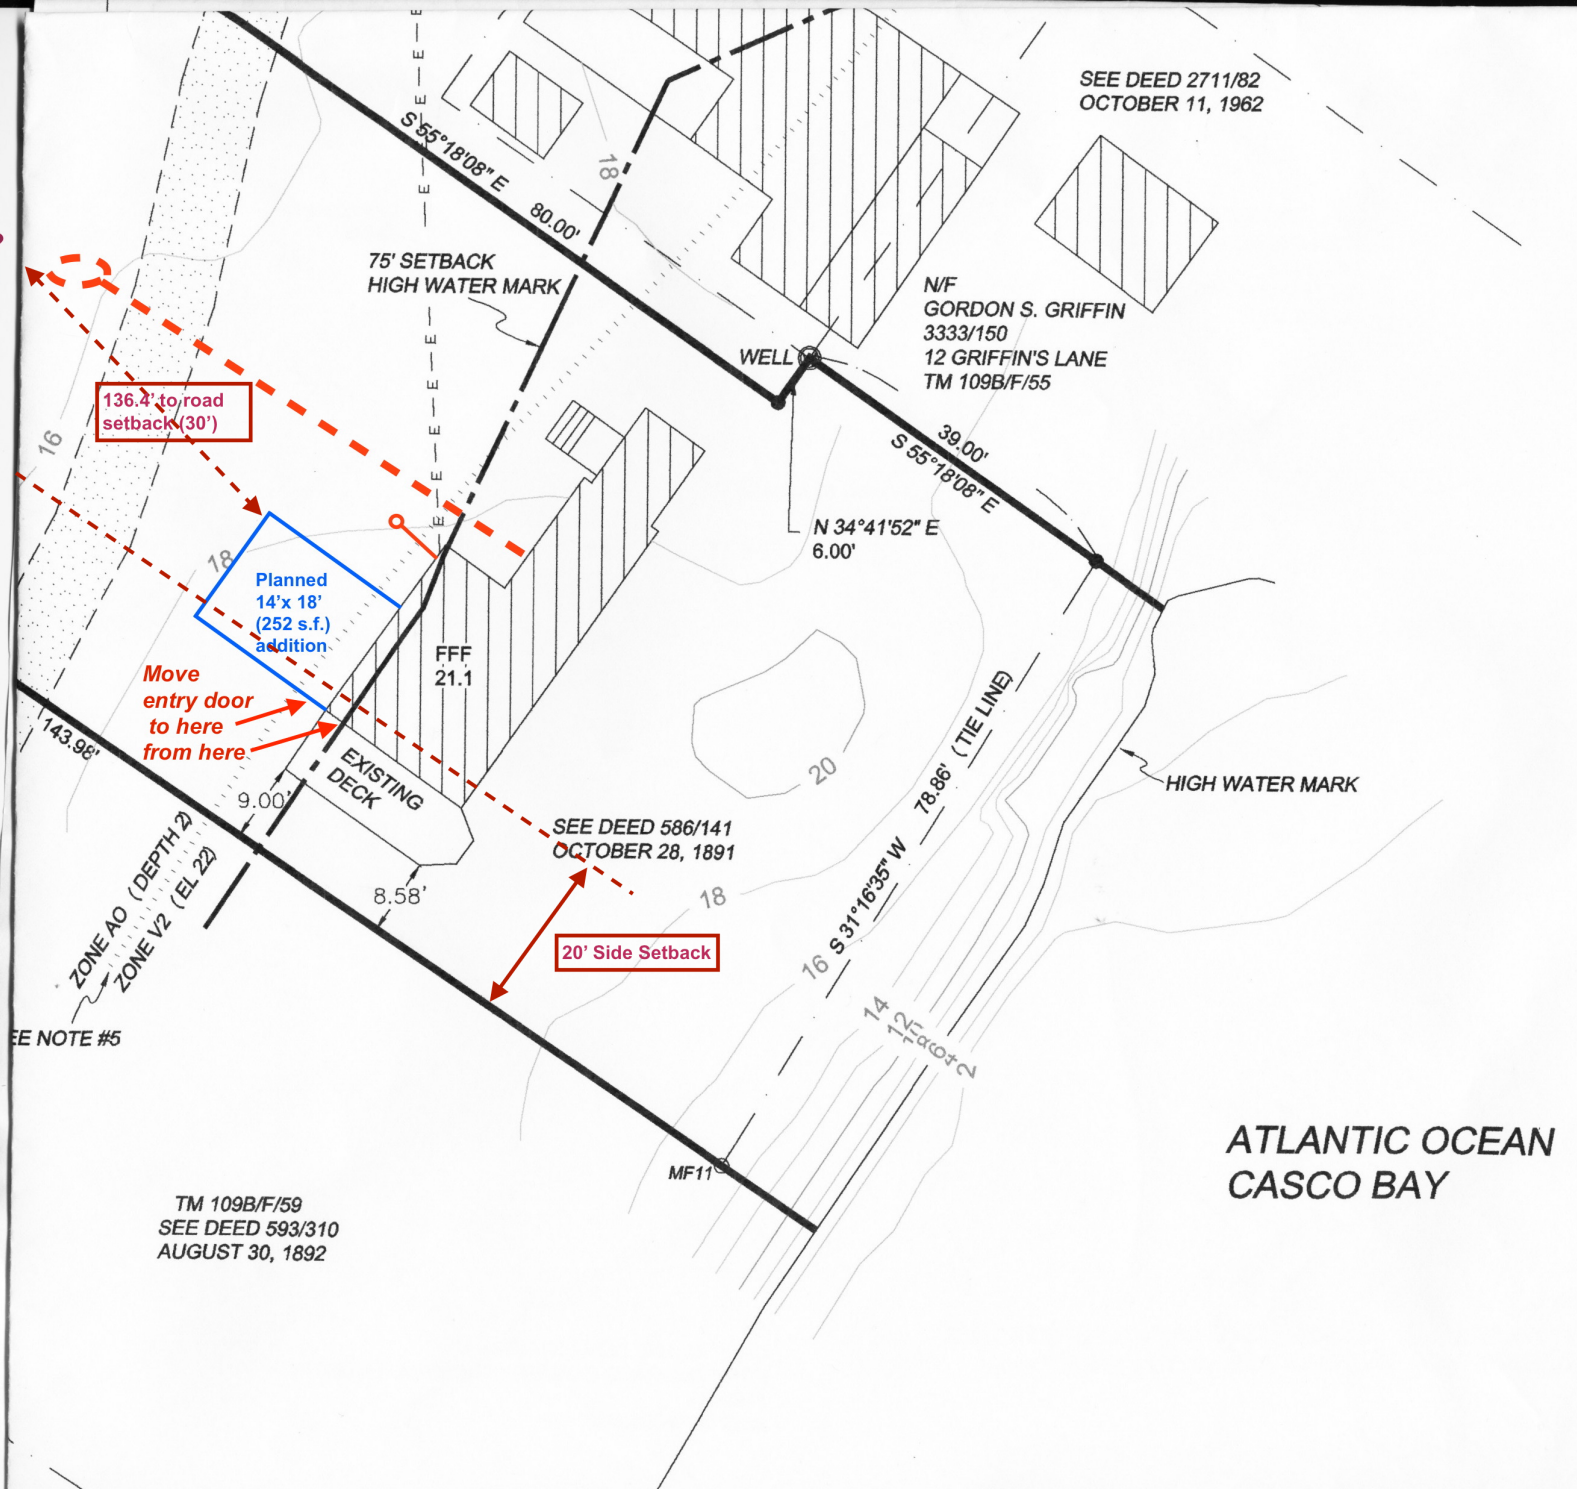

ATLANTIC OCEAN
CASCO BAY