



**SUBMITTAL REVIEW:**  
 Submittal Package: 25-503 Submittal No: \_\_\_\_\_  
 REVIEWED NO EXCEPTIONS TAKEN  REVISE AND RESUBMIT  
 NOTE MARKINGS  REJECTED  
 Reviewed for general conformance with the design concept and contract documents. Markings or comments shall not be construed as relieving the Subcontractor from compliance with the project plans and specifications, nor departure therefrom. The Subcontractor remains responsible for details and accuracy, for conforming and correlating all quantities and dimensions, for selecting fabrication processes, for techniques of assembly, and for performing the work in a safe manner.  
**WRIGHT-RYAN CONSTRUCTION, INC.**  
 BY: S. H. POIN DATE: 10/28/07

**SHOP NOTE:**  
 VENT HOLES REQ'D FOR HOT DIP GALV.

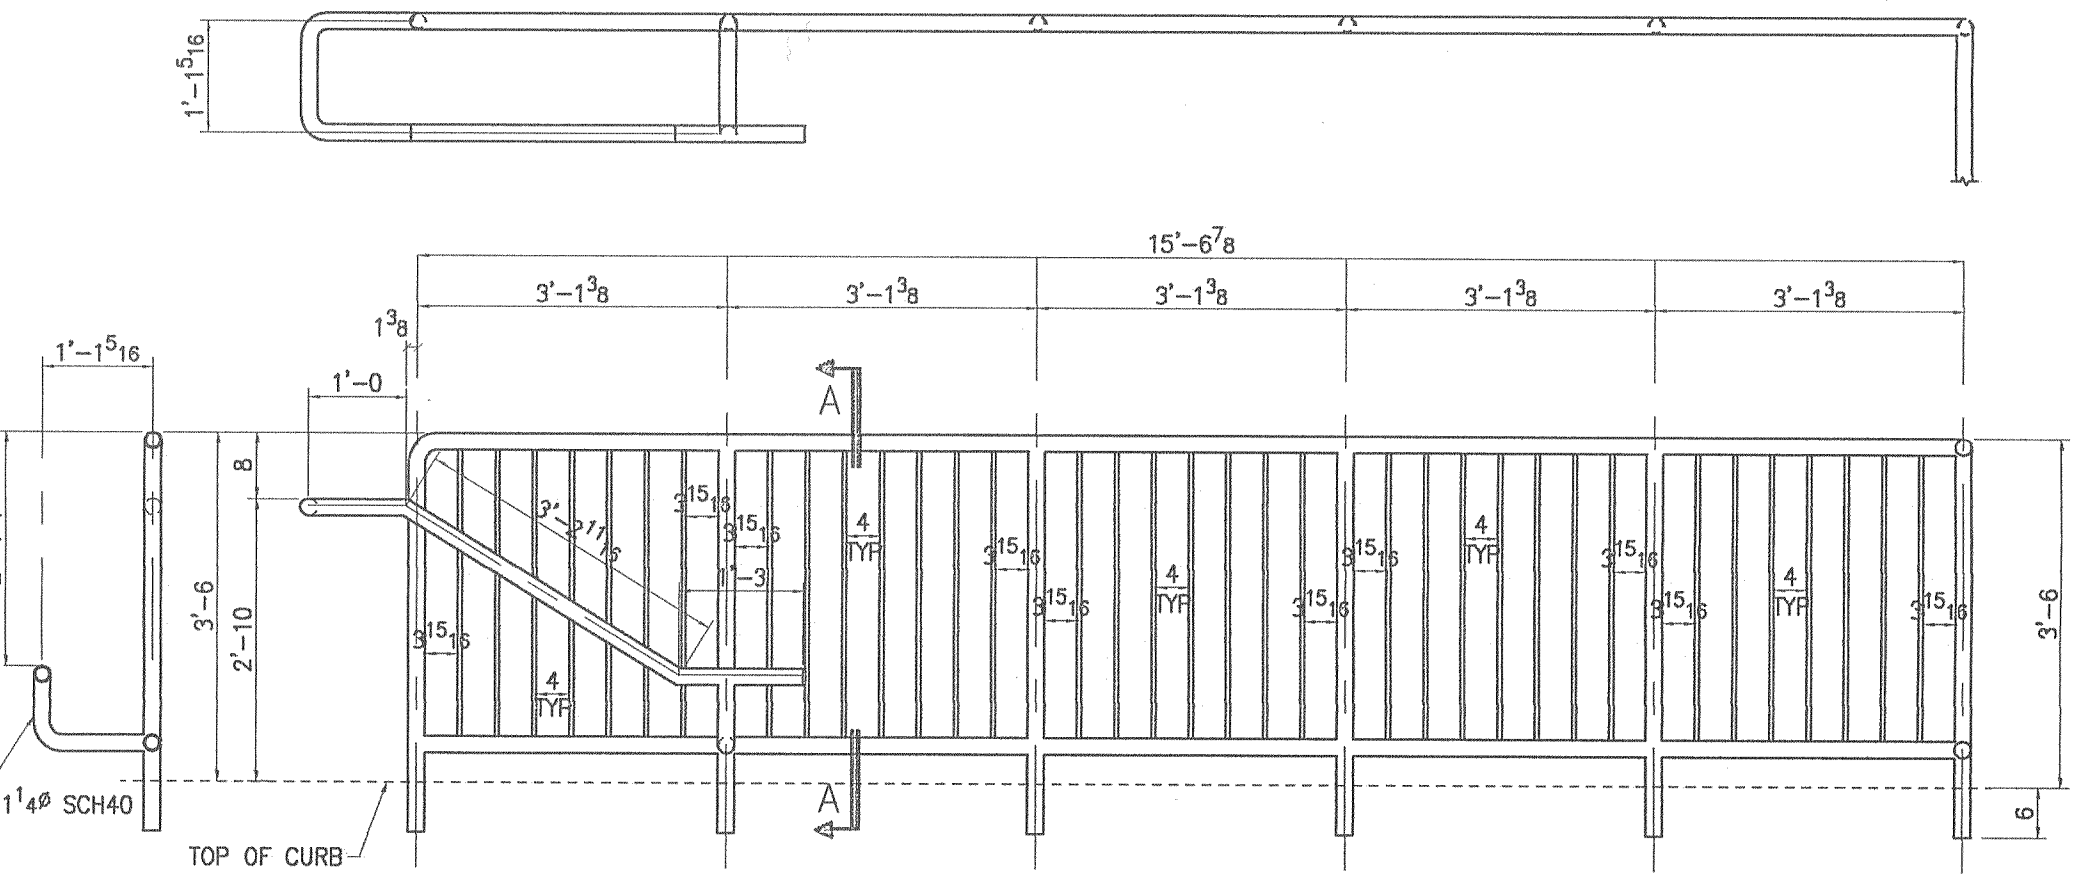

ONE HANDRAIL R4

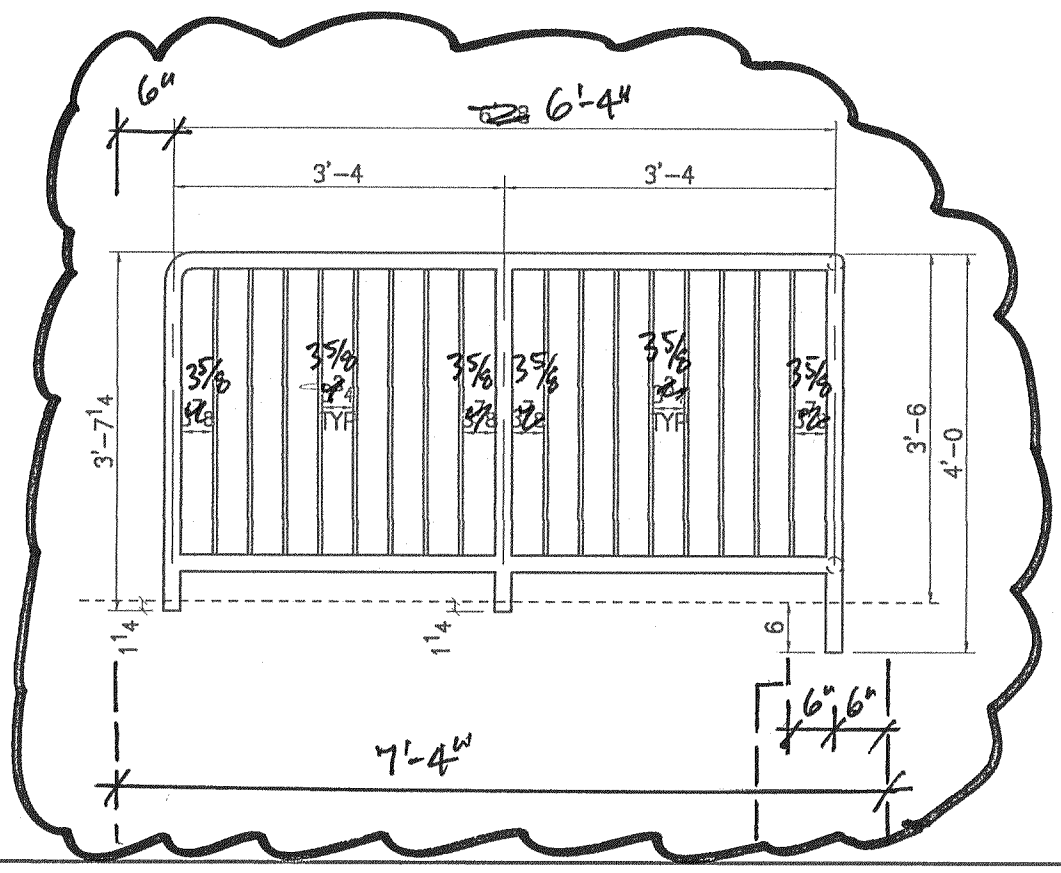

SHIP		BILL OF MATERIAL				
MARK	QUAN	PC MK	DESCRIPTION	FT INCHES	WT	REMARKS
1						
2						
16	R3	ONE	HANDRAIL			HOT DIPPED GALV.
17		ONE	1 1/4" SCH40	25 0	31.25	+/- LIN.FT
18		6	3 5/8" WALL BRKT			R&B WAGNER
19						
20						
21						
22	R4	ONE	HANDRAIL			HOT DIPPED GALV.
23		ONE	1 1/4" SCH40	19 0	23.75	+/- LIN.FT
24		ONE	820 3-WAY			R&B WAGNER
25						
26						
PRINT RECORD			MATERIAL: AS NOTED		
USE	QUAN	DATE	HOLES: 5/16" DIA. UON		
OFA	5	12-5-07	ELECTRODES: E70XX		
			FIELD CONN:		
SHOP			SURFACE PREP: SSPC-SP3		
			PAINT: HOT DIPPED GALVANIZED		
FIELD			REF. DWGS:		
CUSTOMER: WRIGHT-RYAN CONSTRUCTION					
JOB: UNIVERSITY COMMONS, U.S.M.					
DESCRIPTION: EXTERIOR GALV. STAIR AND RAILS					
ARCHITECT: KOETTER/KIM & ASSOCIATES INC.					
ENGINEER: WEIDLINGER					
DRAWN BY JRC 6-25-07		CHKD BY		DRAWING NUMBER 8	REVISION NUMBER
LMC LIGHT IRON, INC.					JOB NUMBER
E RANGE ROAD P.O. BOX 521					2700
LIMERICK, MAINE 04048					
TEL: (207) 793-9957					FAX: (207) 793-3919