
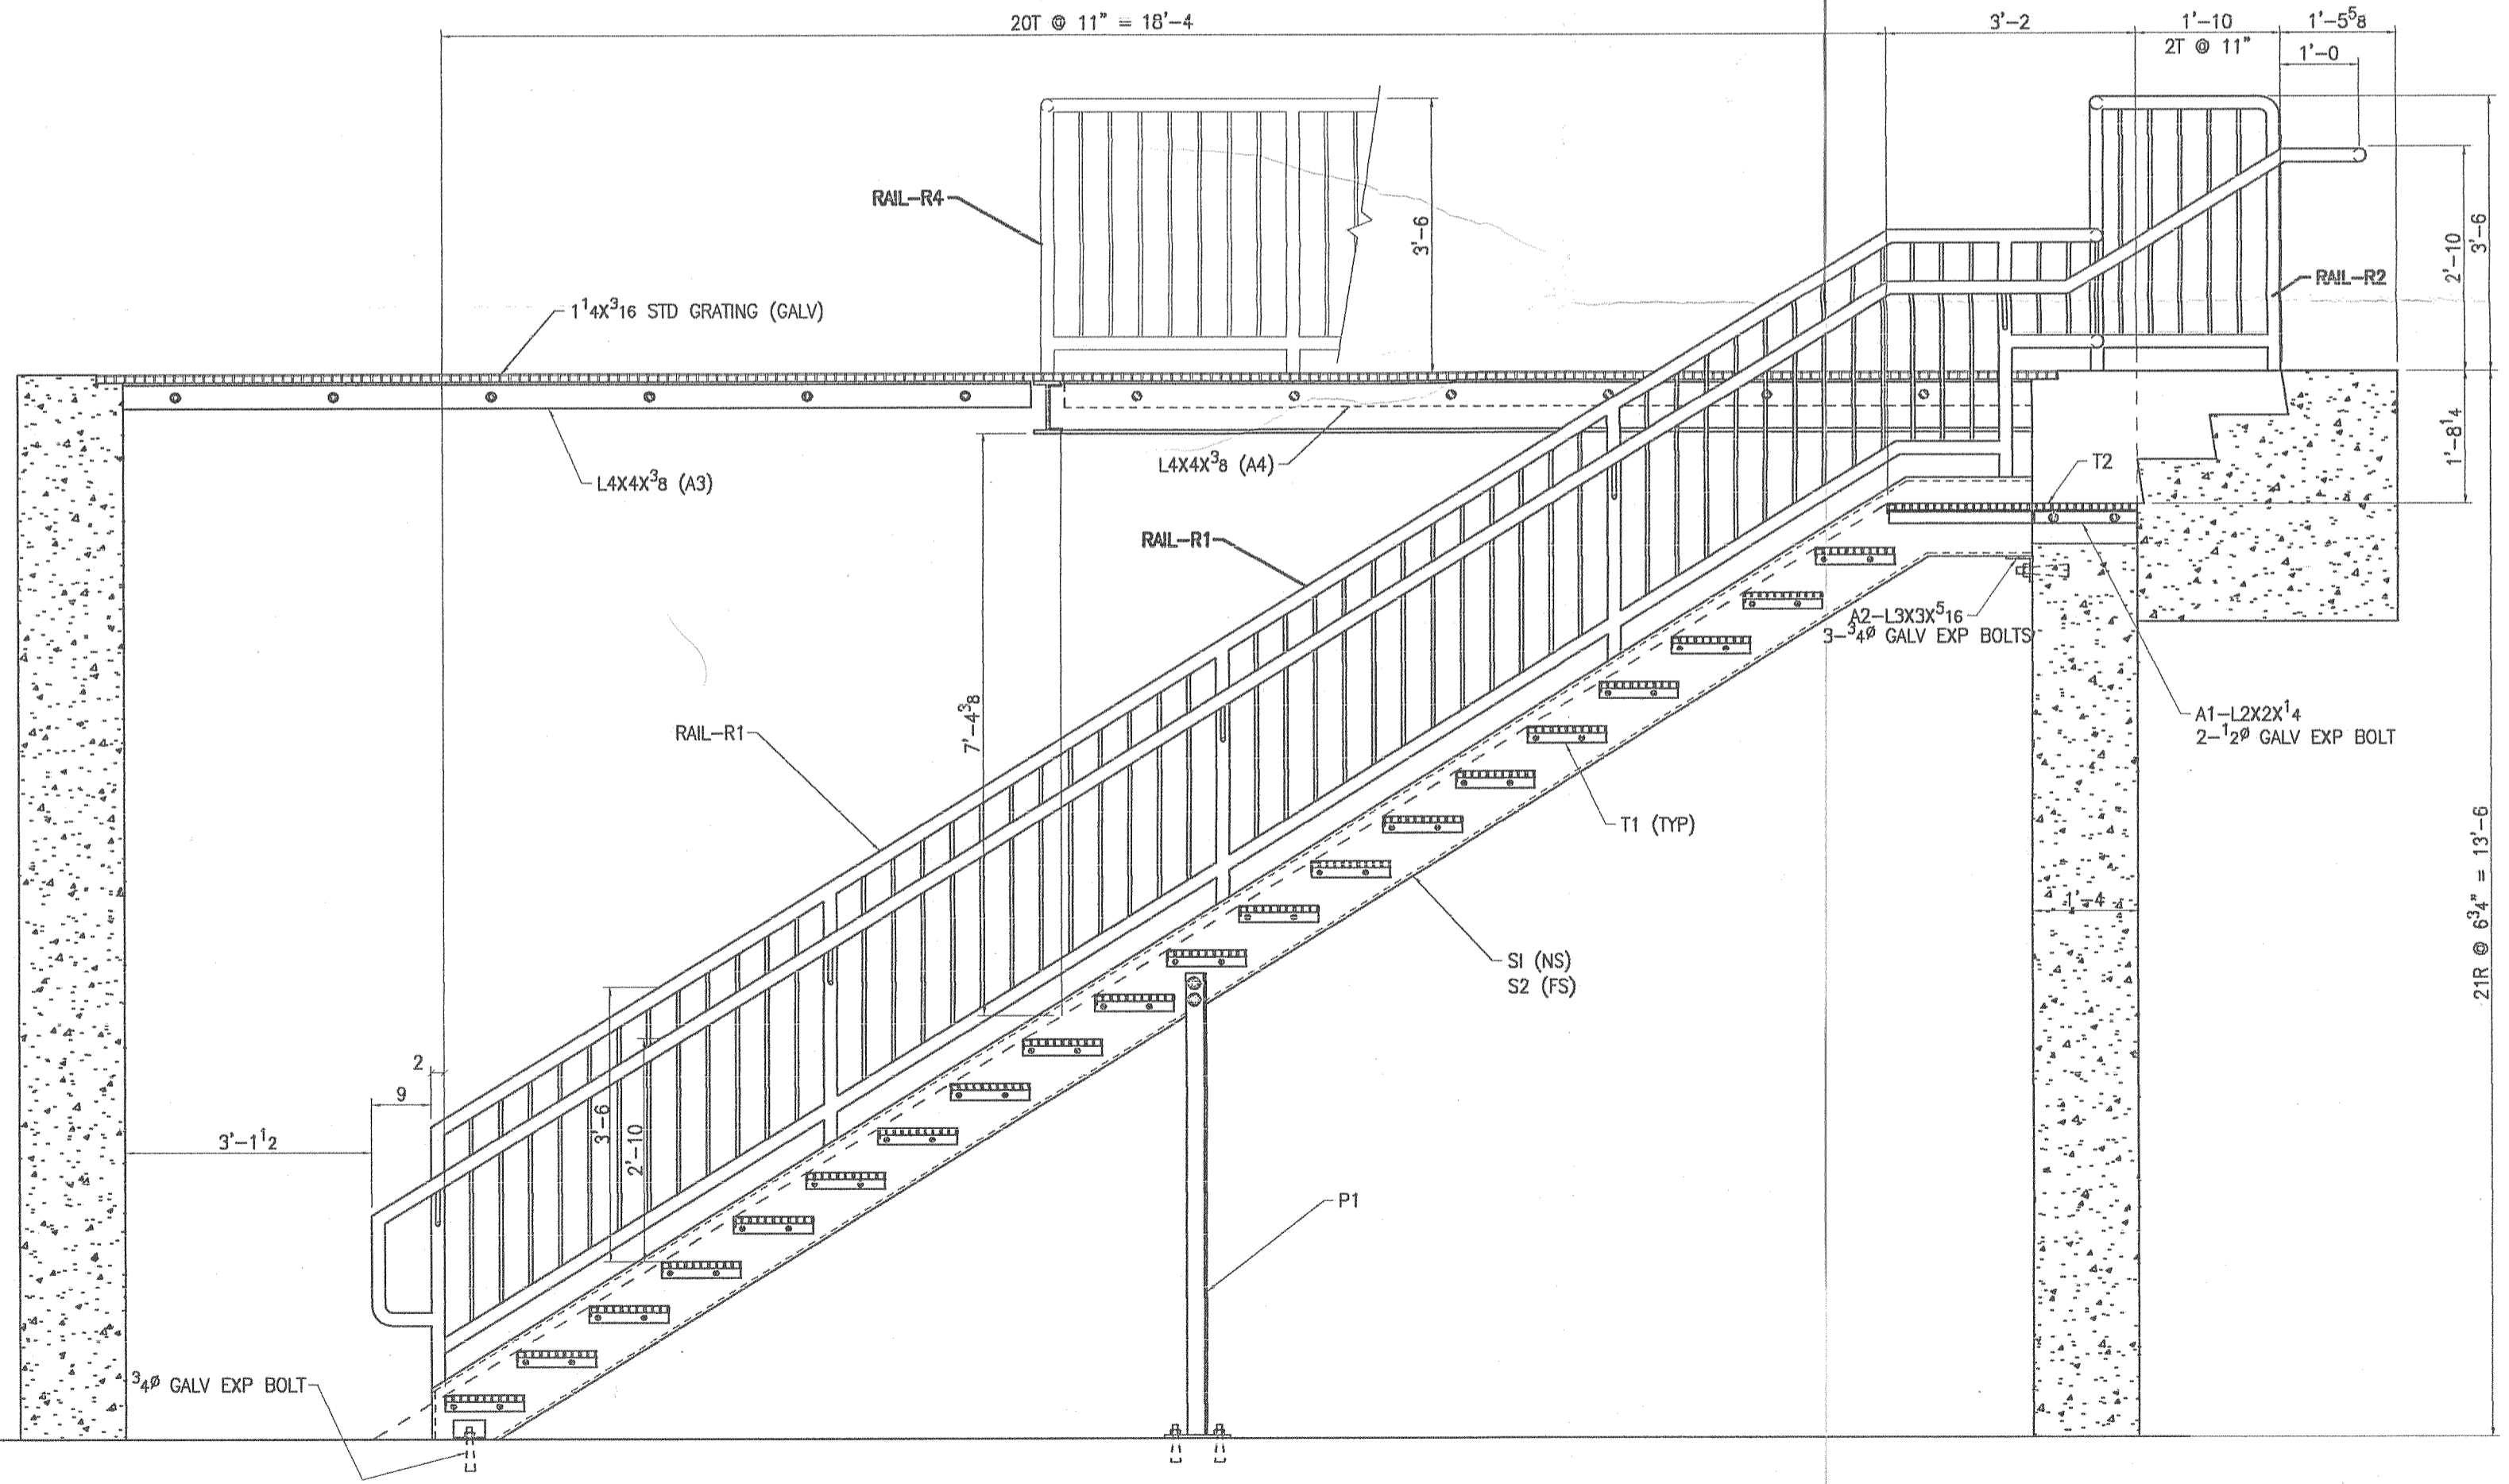


SUBMITTAL REVIEW:
 Submittal Package: 05-506 Submittal No: 0551021298
 REVIEWED-NO EXCEPTIONS TAKEN REVISE AND RESUBMIT
 NOTE MARKINGS REJECTED
 Reviewed for general conformance with the design concept and contract documents. Markings or comments shall not be construed as relieving the Subcontractor from compliance with the project plans and specifications, nor departure therefrom. The Subcontractor remains responsible for details and accuracy, for conforming and correlating all quantities and dimensions, for selecting fabrication processes, for techniques of assembly, and for performing the work in a safe manner.
WRIGHT-RYAN CONSTRUCTION, INC.
 BY: 1342104 DATE: 10 DEC 07

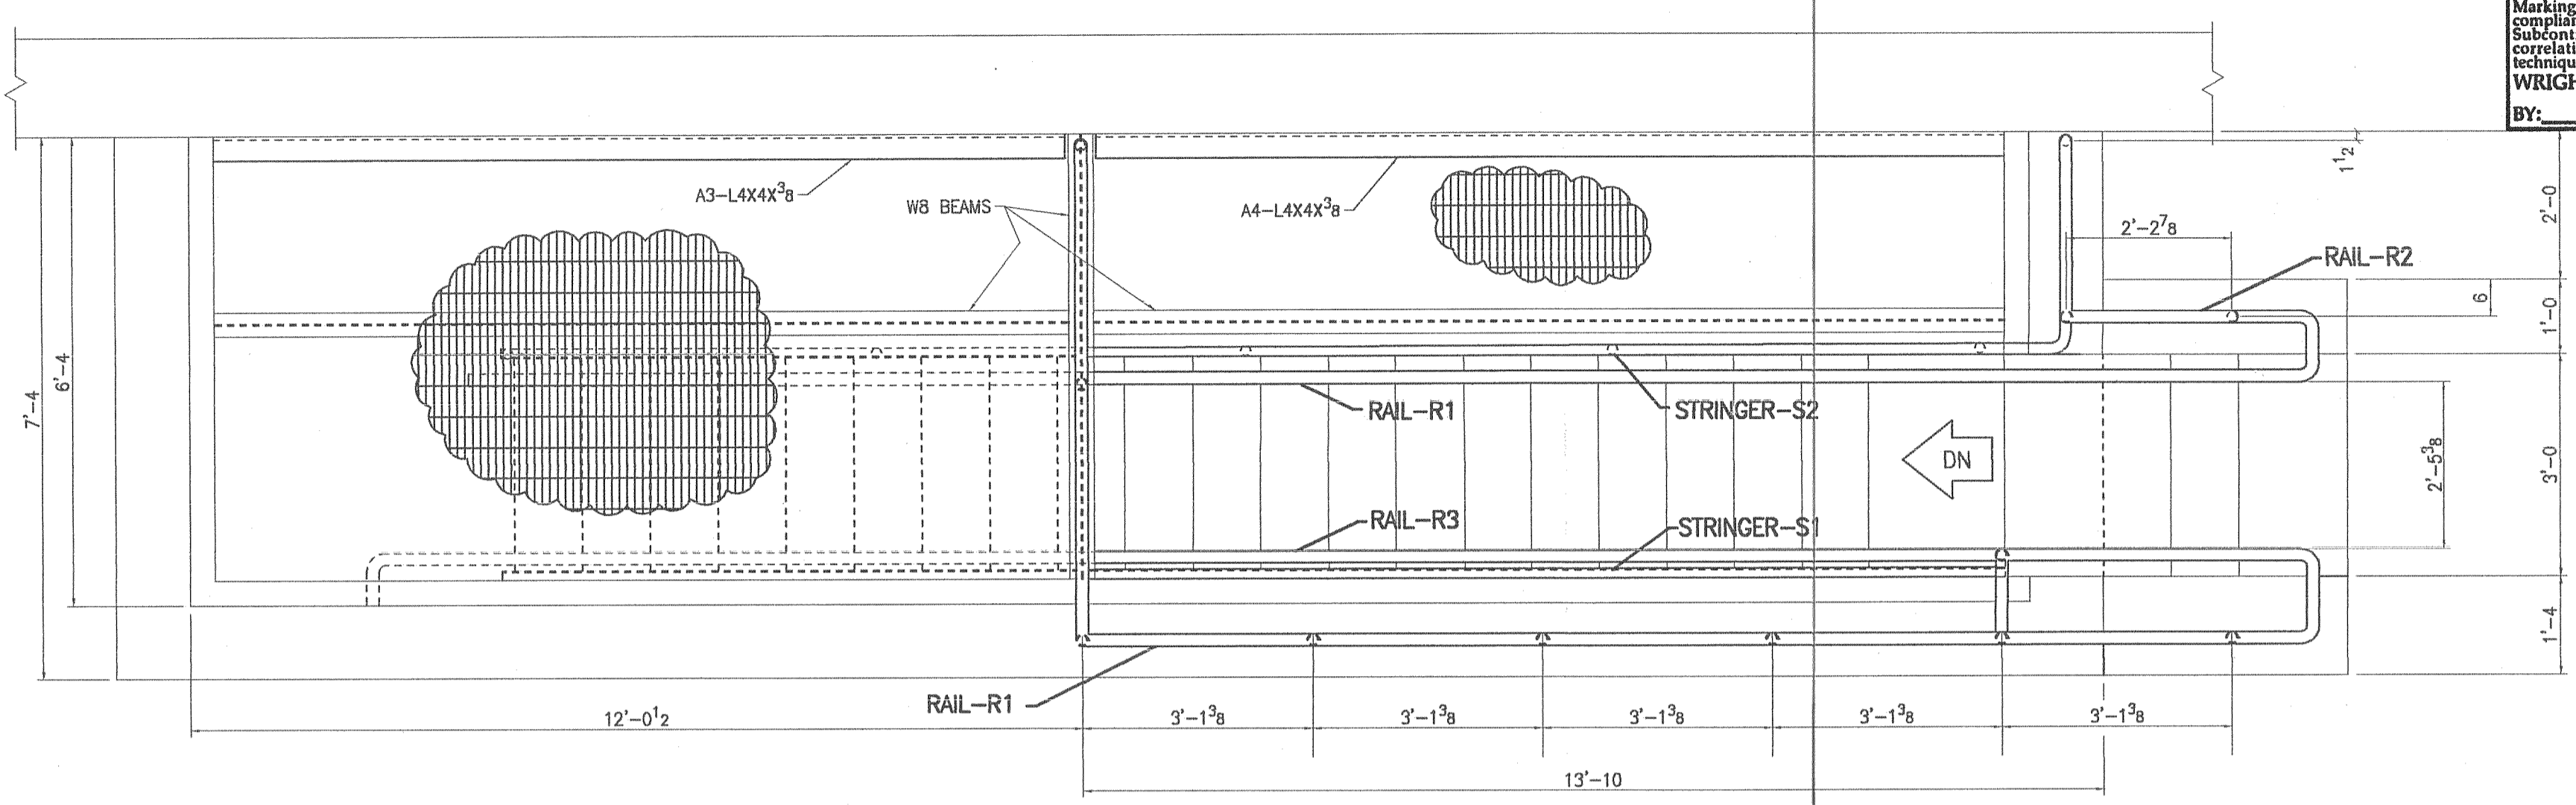

PLAN AND SECTION
 @ EXTERIOR STAIR

PRINT RECORD			MATERIAL: AS NOTED
USE	QUAN	DATE	HOLES: 5/16" DIA. UON
OFA	5	11-28-07	ELECTRODES: E70XX
			FIELD CONN:
SHOP			SURFACE PREP: SSPC-SP3
			PAINT: 1-S/C RED OXIDE PRIMER
FIELD			REF. DWGS:
CUSTOMER: WRIGHT-RYAN CONSTRUCTION			
JOB: UNIVERSITY COMMONS, U.S.M.			
DESCRIPTION: EXTERIOR GALV. STAIR DETAILS			
ARCHITECT: KOETTER/KIM & ASSOCIATES INC.			
ENGINEER: WEIDLINGER			
DRAWN BY	JRC 7-9-07	CHKD BY	DRAWING NUMBER SE1
REVISION NUMBER			JOB NUMBER
LMC LIGHT IRON, INC.			2700
E RANGE ROAD - P.O. BOX 521 TEL: (207) 793-9957 LIMERICK, MAINE 04048 FAX: (207) 793-3919			