


ONE HANDRAIL R3

**SHOP NOTE:**  
VENT HOLES REQ'D  
FOR HOT DIP GALV.

**SUBMITTAL REVIEW:**  
 Submittal Package: 25-503 Submittal No: \_\_\_\_\_  
 REVIEWED, NO EXCEPTIONS TAKEN  REVISE AND RESUBMIT  
 NOTE MARKINGS  REJECTED  
 Reviewed for general conformance with the design concept and contract documents. Markings or comments shall not be construed as relieving the Subcontractor from compliance with the project plans and specifications, nor departure therefrom. The Subcontractor remains responsible for details and accuracy, for conforming and correlating all quantities and dimensions, for selecting fabrication processes, for techniques of assembly, and for performing the work in a safe manner.  
**WRIGHT-RYAN CONSTRUCTION, INC.**  
 BY: SUTTON DATE: 12/8/07

LINE	SHIP BILL OF MATERIAL						
	MARK	QUAN	PC MK	DESCRIPTION	FT INCHES	WT	REMARKS
1							
2							
16	R3	ONE		HANDRAIL			HOT DIPPED GALV.
17		ONE		1 1/4" SCH40	25 0	31.25	+/- LIN.FT
18		6	3418	WALL BRKT			R&B WAGNER
19							
20							
21							
22	R4	ONE		HANDRAIL			HOT DIPPED GALV.
23		ONE		1 1/4" SCH40	19 0	23.75	+/- LIN.FT
24		ONE	820	3-WAY			R&B WAGNER
25							
26							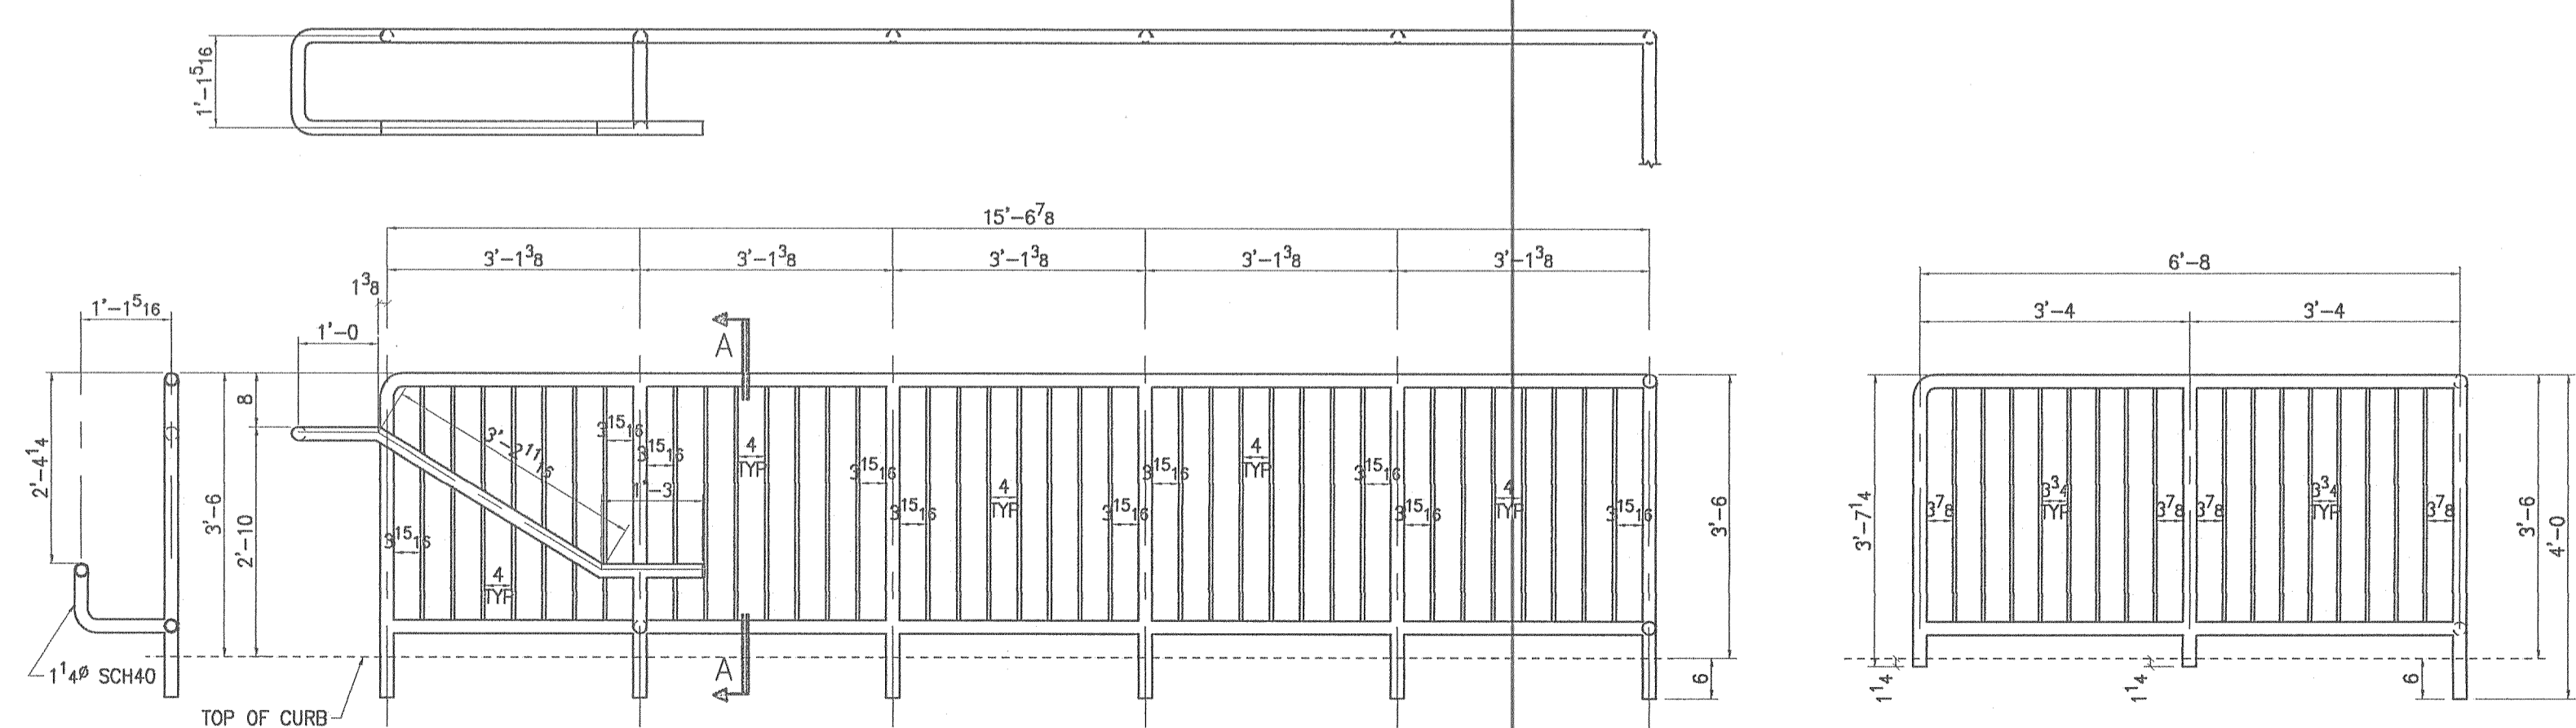
ONE HANDRAIL R4

PRINT RECORD			MATERIAL: AS NOTED		
USE	QUAN	DATE	HOLES: 5/16" DIA. UON		
OFA	5	12-5-07	ELECTRODES: E70XX		
			FIELD CONN:		
SHOP			SURFACE PREP: SSPC-SP3		
			PAINT: HOT DIPPED GALVANIZED		
FIELD			REF. DWGS:		
CUSTOMER: WRIGHT-RYAN CONSTRUCTION					
JOB: UNIVERSITY COMMONS, U.S.M.					
DESCRIPTION: EXTERIOR GALV. STAIR AND RAILS					
ARCHITECT: KOETTER/KIM & ASSOCIATES INC.					
ENGINEER: WEIDLINGER					
DRAWN BY	JRC 6-25-07	CHKD BY	DRAWING NUMBER	8	REVISION NUMBER
<b>LMC LIGHT IRON, INC.</b>					<b>2700</b>
E RANGE ROAD - P.O. BOX 521					
LIMERICK, MAINE 04048 TEL: (207) 793-9957 FAX: (207) 793-3919					