DISPLAY THIS CARD ON PRINCIPAL FRONTAGE OF WORK



### CITY OF PORTLAND BUILDING PERMIT



This is to certify that **JENEPHER S BURTON** 

Located At 96 HIGHLAND ST

Job ID: 2012-09-4887-ALTR

CBL: 123- E-018-001

has permission to Add a 21' x 13'6" screened porch

provided that the person or persons, firm or corporation accepting this permit shall comply with all of the provisions of the Statues of Maine and of the Ordinances of the City of Portland regulating the construction, maintenance and use of the buildings and structures, and of the application on file in the department.

Notification of inspection and written permission procured before this building or part thereof is lathed or otherwise closed-in. 48 HOUR NOTICE IS REQUIRED.

A final inspection must be completed by owner before this building or part thereof is occupied. If a certificate of occupancy is required, it must be

**Fire Prevention Officer** 

Code Enforcement Officer / Plan Reviewer

THIS CARD MUST BE POSTED ON THE STREET SIDE OF THE PROPERTY PENALTY FOR REMOVING THIS CARD

#### **BUILDING PERMIT INSPECTION PROCEDURES**

Please call 874-8703 or 874-8693 (ONLY)

or email: buildinginspections@portlandmaine.gov

With the issuance of this permit, the owner, builder or their designee is required to provide adequate notice to the city of Portland Inspections Services for the following inspections. Appointments must be requested 48 to 72 hours in advance of the required inspection. The inspection date will need to be confirmed by this office.

- Please read the conditions of approval that is attached to this permit!! Contact this office if you have any questions.
- Permits expire in 6 months. If the project is not started or ceases for 6 months.
- If the inspection requirements are not followed as stated below additional fees may be incurred due to the issuance of a "Stop Work Order" and subsequent release to continue.

Footings/Setbacks prior to pouring concrete

Close In Elec/Plmb/Frame prior to insulate or gyp

**Final Inspection** 

The project cannot move to the next phase prior to the required inspection and approval to continue, REGARDLESS OF THE NOTICE OF CIRCUMSTANCES.

IF THE PERMIT REQUIRES A CERTIFICATE OF OCCUPANCY, IT MUST BE PAID FOR AND ISSUED TO THE OWNER OR DESIGNEE BEFORE THE SPACE MAY BE OCCUPIED.



## PORTLAND MAINE

Strengthening a Remarkable City, Building a Community for Life . www.portlandmaine.gov

Director of Planning and Urban Development Jeff Levine

Job ID: 2012-09-4887-ALTR

Located At: 96 HIGHLAND ST

CBL: 123- E-018-001

#### **Conditions of Approval:**

#### **Building**

Separate permits are required for any electrical, plumbing, sprinkler, fire alarm HVAC systems, heating appliances, commercial hood exhaust systems and fuel tanks. Separate plans may need to be submitted for approval as a part of this process.

#### City of Portland, Maine - Building or Use Permit Application

389 Congress Street, 04101 Tel: (207) 874-8703, FAX: (207) 8716

RESPONSIBLE PERSON IN CHARGE OF WORK, TITLE

Job No: 2012-09-4887-ALTR	Date Applied: 9/5/2012		CBL: 123- E-018-001				
Location of Construction: 96 HIGHLAND ST	Owner Name: JENEPHER S BURTON & DAVID JOHANSON		Owner Address: 96 HIGHLAND ST PORTLAND, ME 04103			Phone: 712-2752	
Business Name:	Contractor Name: David Johanson - owner		Contractor Address: 96 HIGHLAND ST., PORTLAND, ME 04103			Phone:	
Lessee/Buyer's Name:	Phone:		Permit Type: BLDG ADD			Zone: R-3	
Past Use: Single Family Dwelling	Proposed Use: Same: Single Family	Dwelling	Cost of Work: \$4,000.00			CEO District:	
Single Lumin, 2 weiming	- to add 13'6" x 21' screened porch addition		Fire Dept:  Approved Denied N/A  Signature:			Inspection: Use Group: Type: 58 Signature	
Proposed Project Description 21' x 13'6" screened porch	n:		Pedestrian Activ	rities District (P.A.D.)		700	
Permit Taken By: Gayle				Zoning Approva	l		
<ol> <li>This permit application does not preclude the Applicant(s) from meeting applicable State and Federal Rules.</li> <li>Building Permits do not include plumbing, septic or electrial work.</li> <li>Building permits are void if work is not started within six (6) months of the date of issuance. False informatin may invalidate a building permit and stop all work.</li> </ol>		e to conform to all applicable laws of		his jurisdiction. In addition	Not in Di  Does not  Requires  Approved  Denied  Date:	Date:  at I have been authorized by a permit for work described in	
IGNATURE OF APPLICAN	T AI	DDRESS		DATE		PHONE	

DATE

**PHONE** 

# General Building Permit Application

If you or the property owner owes real estate or personal property taxes or user charges on any operty within the City, payment arrangements must be made before permits of any kind are accepted.

Location/Address of Construction: 96 High	hland Street			
Total Square Footage of Proposed Structure/A 283.5 sq. ft.	rea S	Square Footage of Lot 32294 SQ FT	Number of Stories	
Tax Assessor's Chart, Block & Lot Chart# Block# Lot#  123-E-18	Applicant : (m Name	nust be owner, lessee or buye DAVID JOHANSON 96 HIGHLAND PORTLAND, ME 04103	207-712-2752	
Lessee/DBA RECEIVED SEP 0 5 2012	Owner: (if diff Name Address	ferent from applicant)	Cost of Work: \$4000. C of O Fee: \$ Historic Review: \$ Planning Amin.: \$	
Dept. of Building Inspections City of Portland Maine			Total Fee: \$ 60.00	
Current legal use (i.e. single family)  If vacant, what was the previous use?  Proposed Specific use:  Is property part of a subdivision?  Project description:	Porch a	res, please name		
Contractor's name: DAVID JOHNASON		Er	mail:	
Address: City, State & Zip Who should we contact when the permit is read		T	-	
Mailing address: 96 HIGHLAND ST. POR	TLAND 0410	3		

do so will result in the automatic denial of your permit.

In order to be sure the City fully understands the full scope of the project, the Planning and Development Department may request additional information prior to the issuance of a permit. For further information or to download copies of this form and other applications visit the Inspections Division on-line at www.portlandmaine.gov, or stop by the Inspections Division office, room 315 City Hall or call 874-8703.

and I hereby certify that I am the Owner of record of the named property, or that the owner of record authorizes the proposed work and that I have been authorized by the owner to make this application as his/her authorized agent. I agree to conform to all applicable laws of this jurisdiction. In addition, if a permit for work described in this application is issued, I certify that the Code Official's authorized representative shall have the authority to enter all areas covered by this permit at any reasonable hour to enforce the provisions of the codes applicable to this permit.

Signature:	my	1	2	Date:	Sept 5	201	12	
		1-1						

This is not a permit; you may not commence ANY work until the permit is issued



## PORTLAND MAINE

Strengthening a Remarkable City, Building a Community for Life . www.portlandmaine.gov

#### Receipts Details:

Tender Information: Check, BusinessName: Daivid P. Johanson, Check Number: 3761

**Tender Amount: 60.00** 

Receipt Header:

Cashier Id: gguertin Receipt Date: 9/5/2012 Receipt Number: 47873


Receipt Details:


Referance ID:	7910	Fee Type:	BP-Constr
Receipt Number:	0	Payment Date:	
Transaction Amount:	60.00	Charge Amount:	60.00

Job ID: Job ID: 2012-09-4887-ALTR - 21' x 13'6" screened porch


Additional Comments: 96 Highland St., David Johanson

Thank You for your Payment!

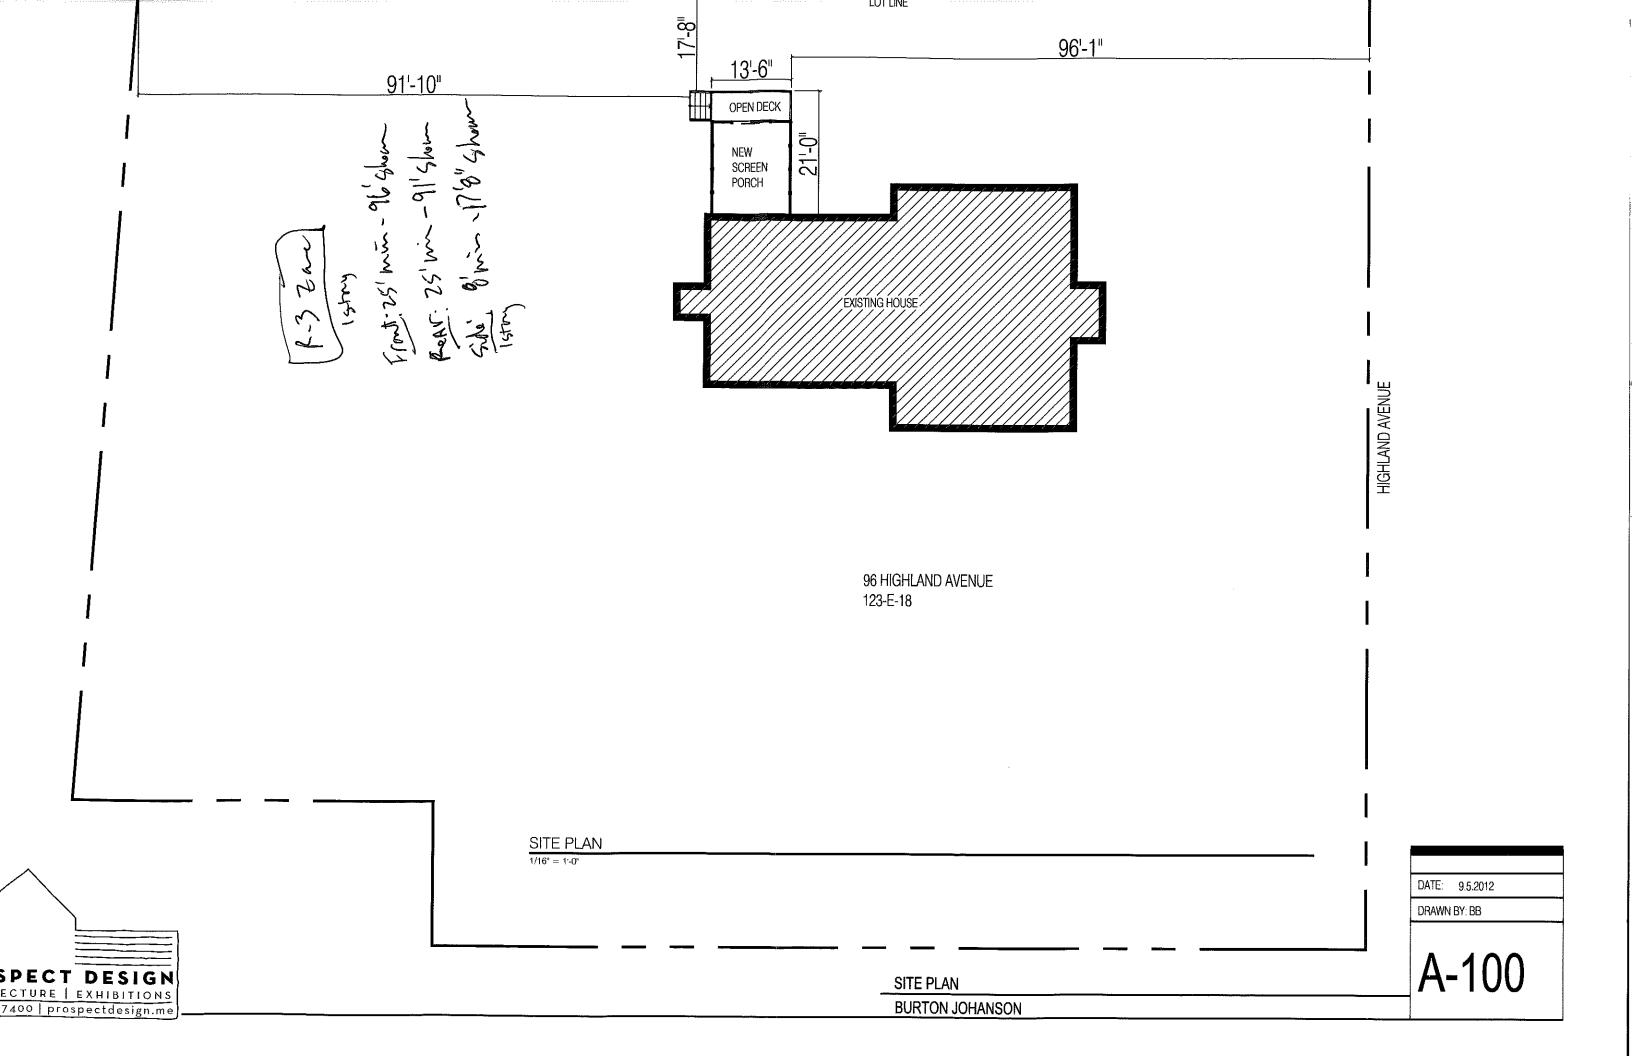

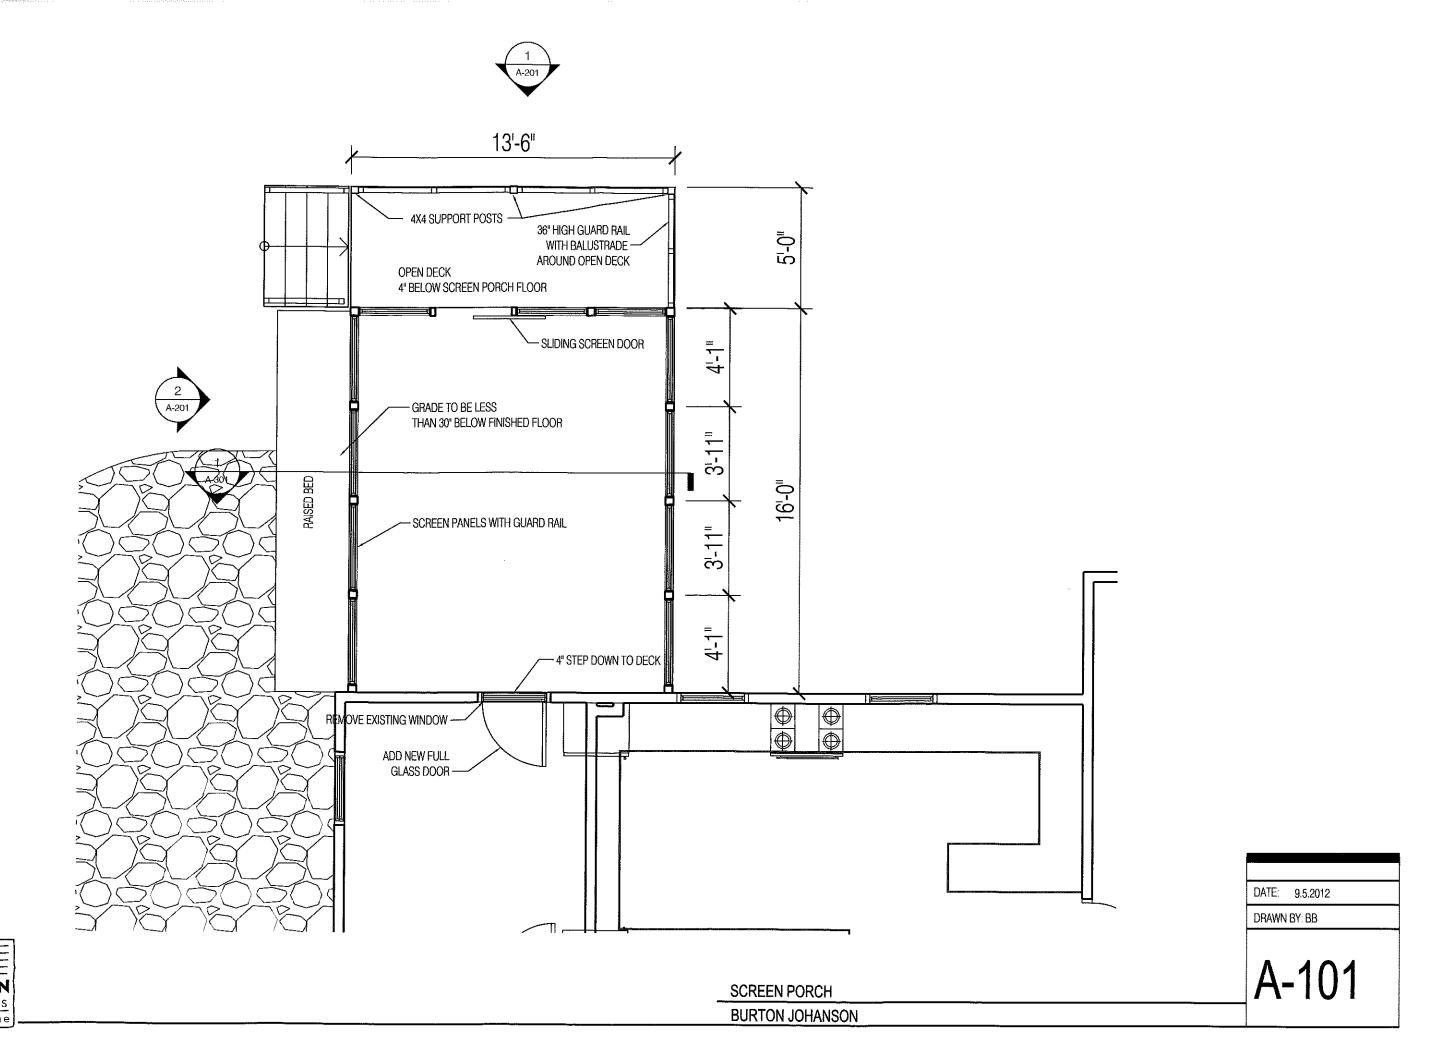

PECT DESIGN ECTURE | EXHIBITIONS 7400 | prospectdesign.me

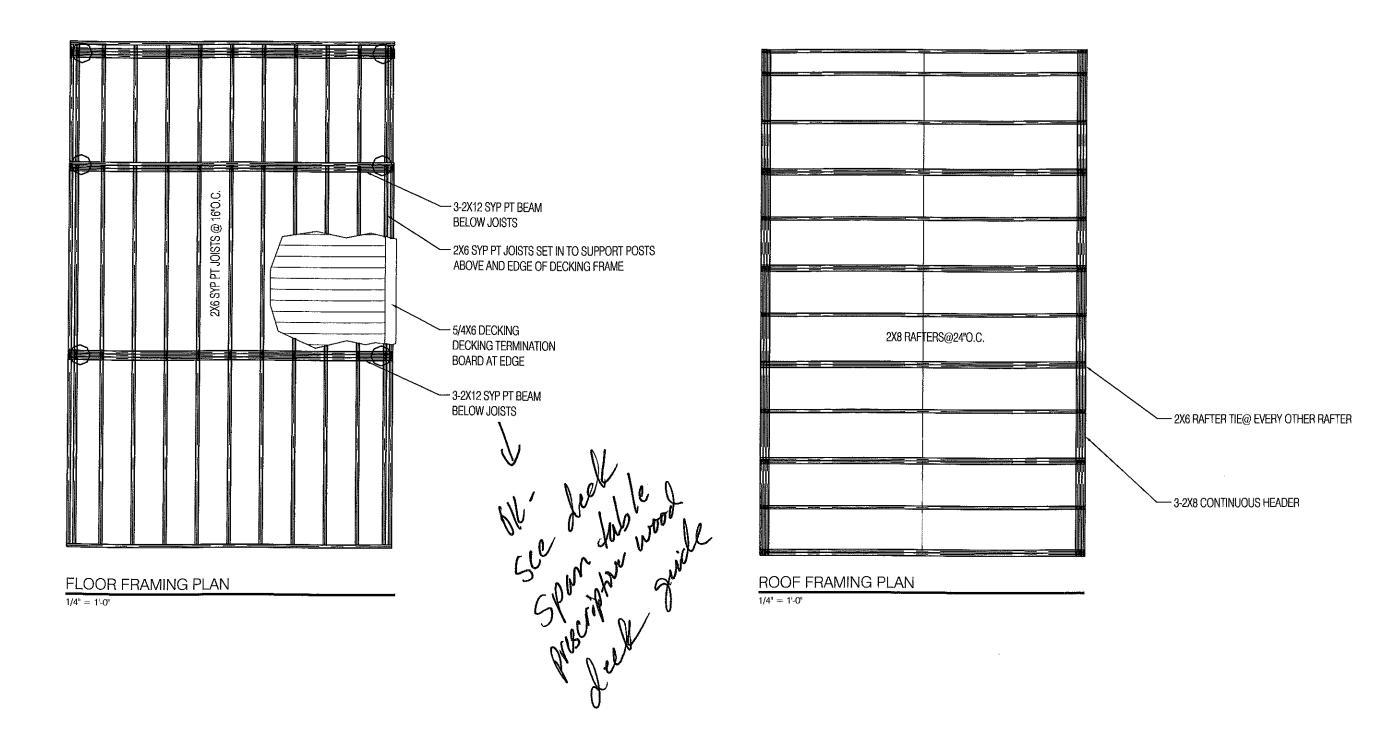

SPECT DESIGN
ECTURE | EXHIBITIONS
7400 | prospectdesign.me

FRAMING PLAN
BURTON JOHANSON

DATE: 9.5.2012

DRAWN BY: BB

A-102




SPECT DESIGN
ECTURE | EXHIBITIONS
7400 | prospectdesign.me

SCREEN PORCH ELEVATIONS
BURTON JOHANSON

DATE: 9.5.2012

DRAWN BY: BB

A-201

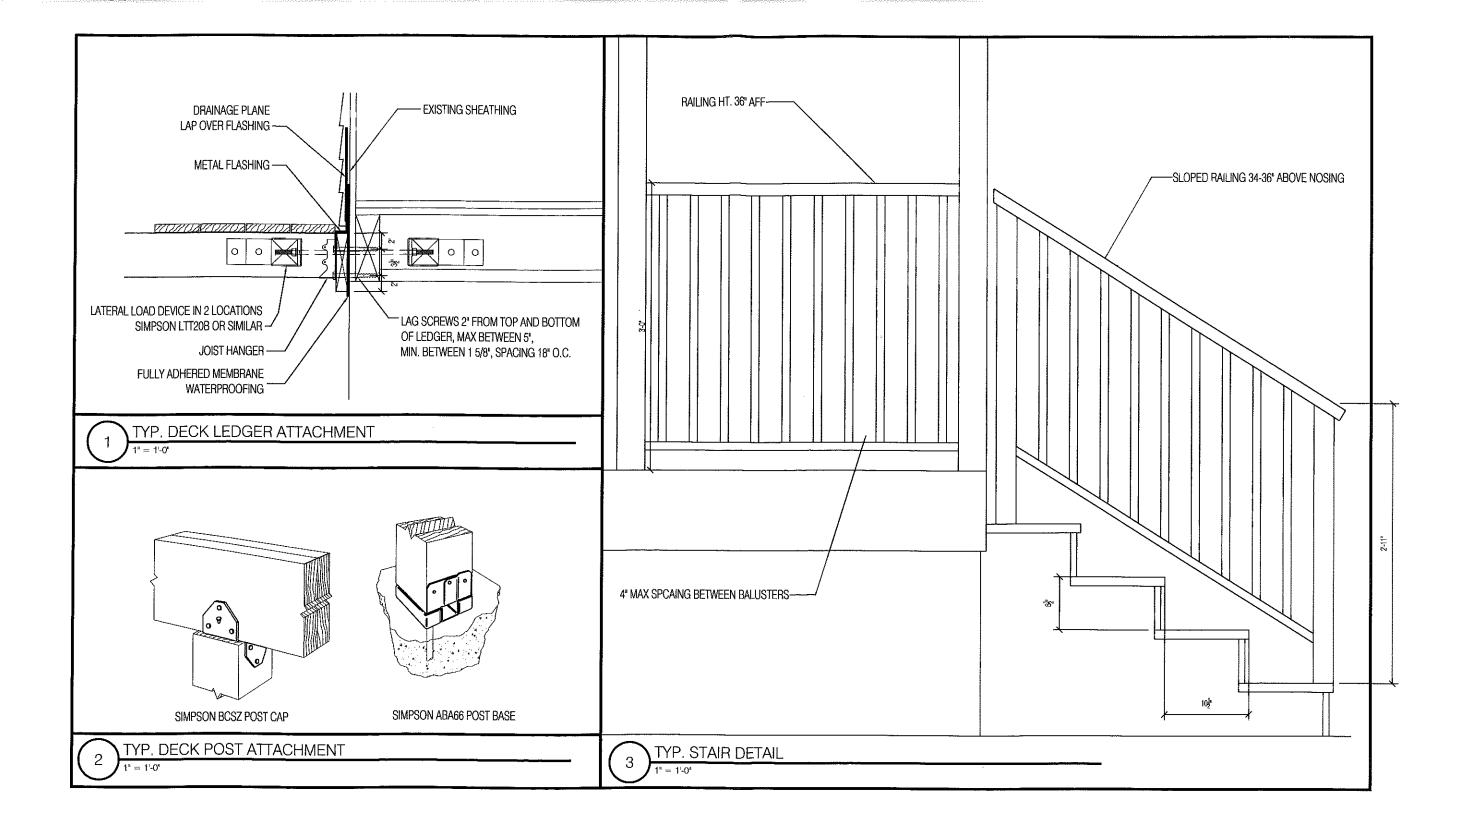


SPECT DESIGN
ECTURE | EXHIBITIONS
7400 | prospectdesign.me

TYPICAL DETAILS
BURTON JOHANSON

A-202

DATE: 9.5.2012

DRAWN BY: BB

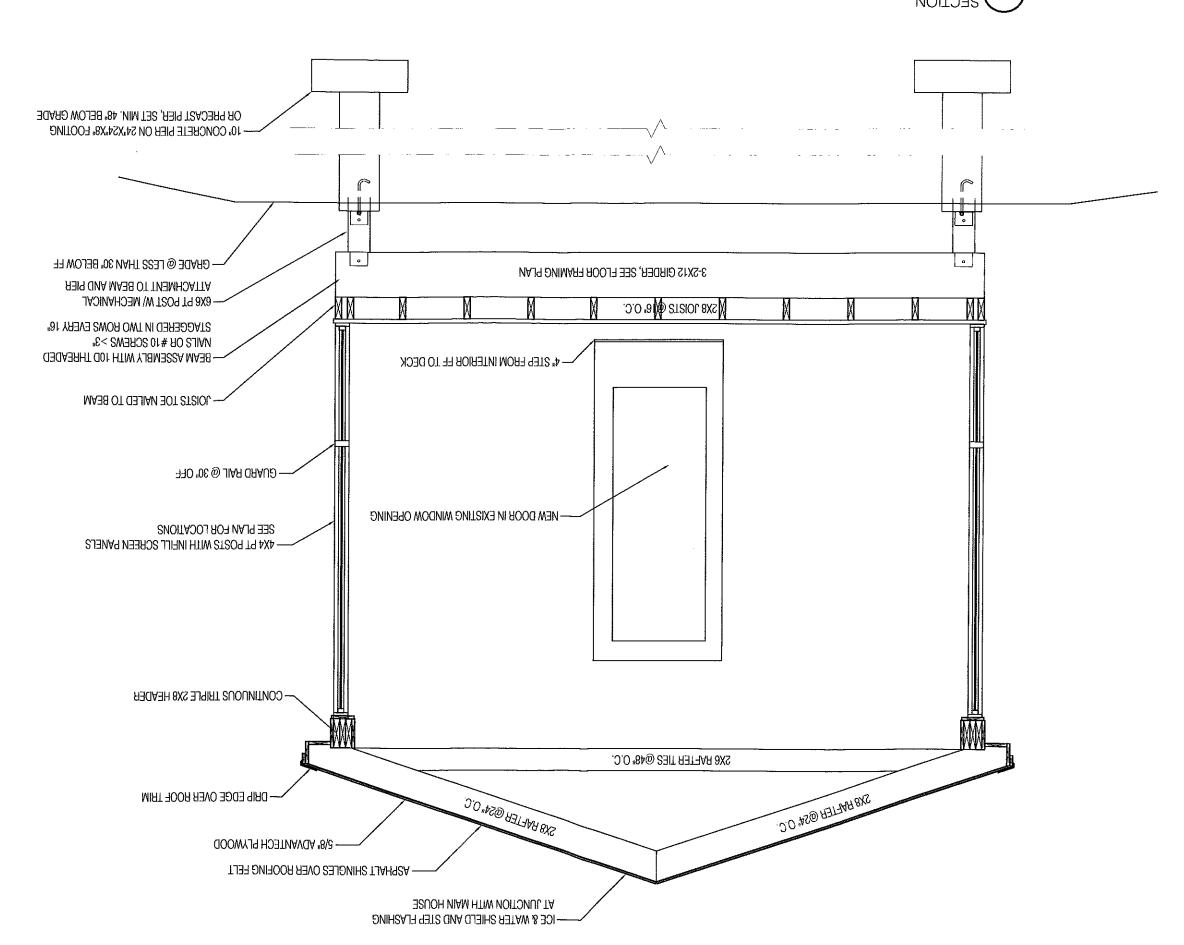

DATE: 9.5.2012

DRAWA BY: BB



SECTION

**BURTON JOHANSON**