


PERMIT PLANS FOR
KEVIN ROPER
 93 GLENWOOD DR
 PORTLAND, ME


brayden
 tuscher

603.583.6469
 tdgdesign@hotmail.com

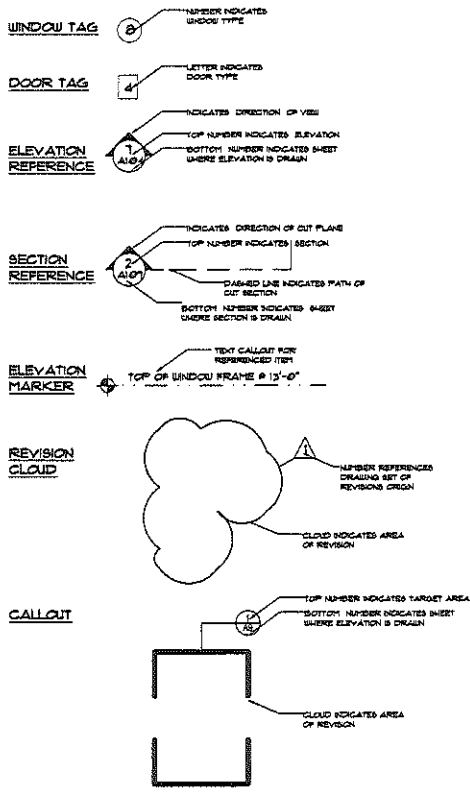

DRAWING INDEX

ARCHITECTURAL	
A0	COVER SHEET & PLOT PLAN
A1	AS-BUILT & DEMO PLANS
A2	AS-BUILT ELEVATIONS
A3	PROPOSED FLOOR PLANS
A4	PROPOSED ELEVATIONS
A5	PROPOSED SECTION

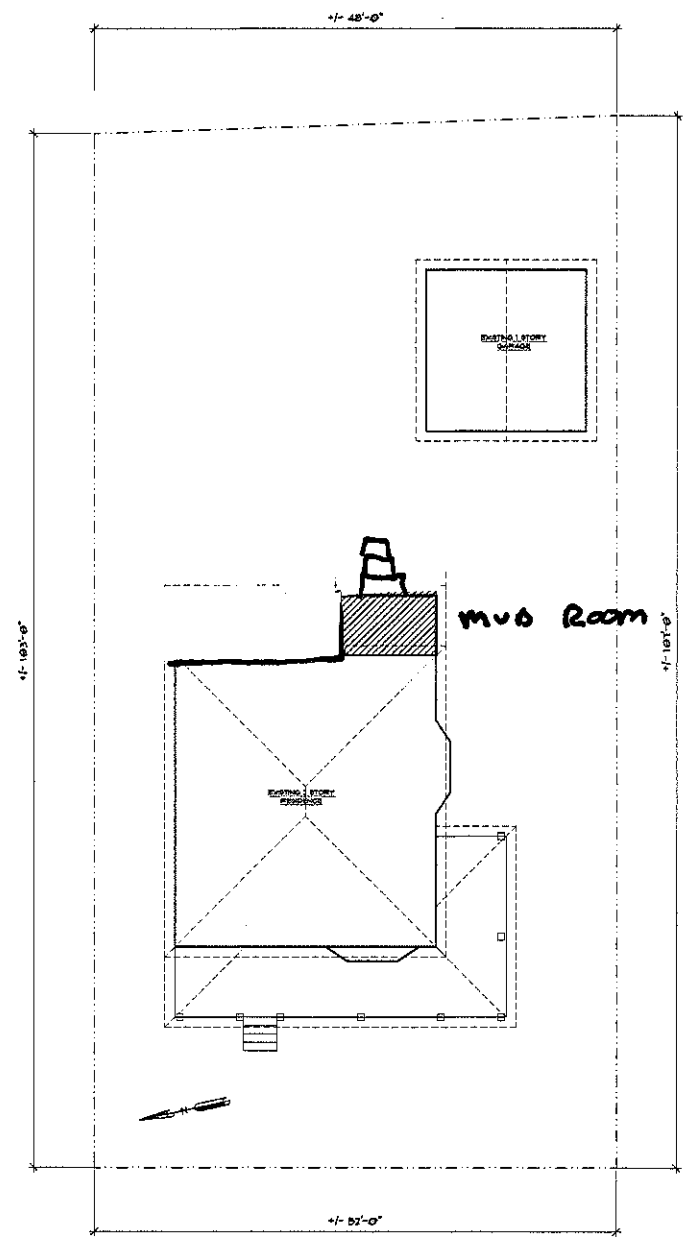

1 PLOT PLAN
 1"=16'-0"

GLENWOOD AVENUE

A0