
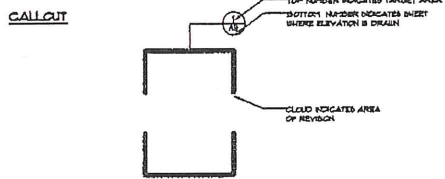
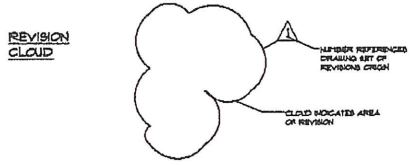
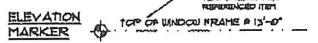
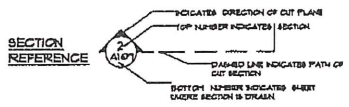


PERMIT PLANS FOR  
**KEVIN ROPER**  
 93 GLENWOOD DR  
 PORTLAND, ME


brayden  
 tuscher

603.583.6469  
 tdgdesign@hotmail.com

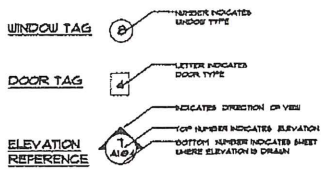

**DRAWING INDEX**

ARCHITECTURAL	
A0	COVER SHEET & PLOT PLAN
A1	AS-BUILT & DEMO PLANS
A2	AS-BUILT ELEVATIONS
A3	PROPOSED FLOOR PLANS
A4	PROPOSED ELEVATIONS
A5	PROPOSED SECTION

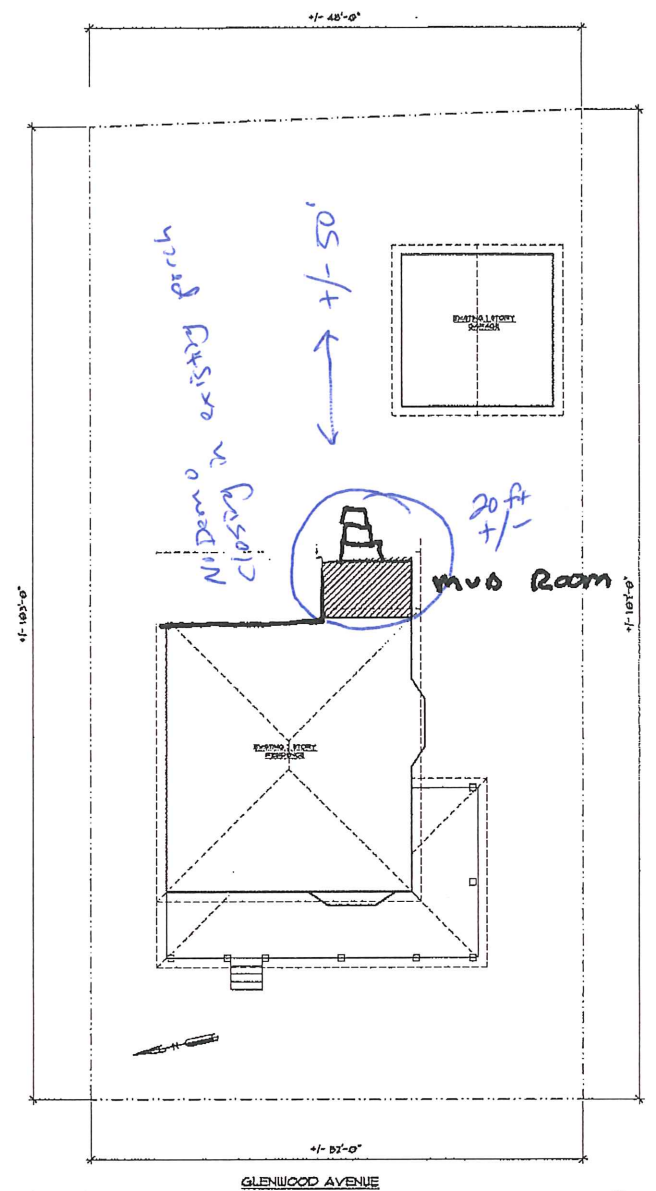

1 PLOT PLAN  
 1"=10'-0"

A0