


N/F RAY
From Book 9 Page 5

EXISTING

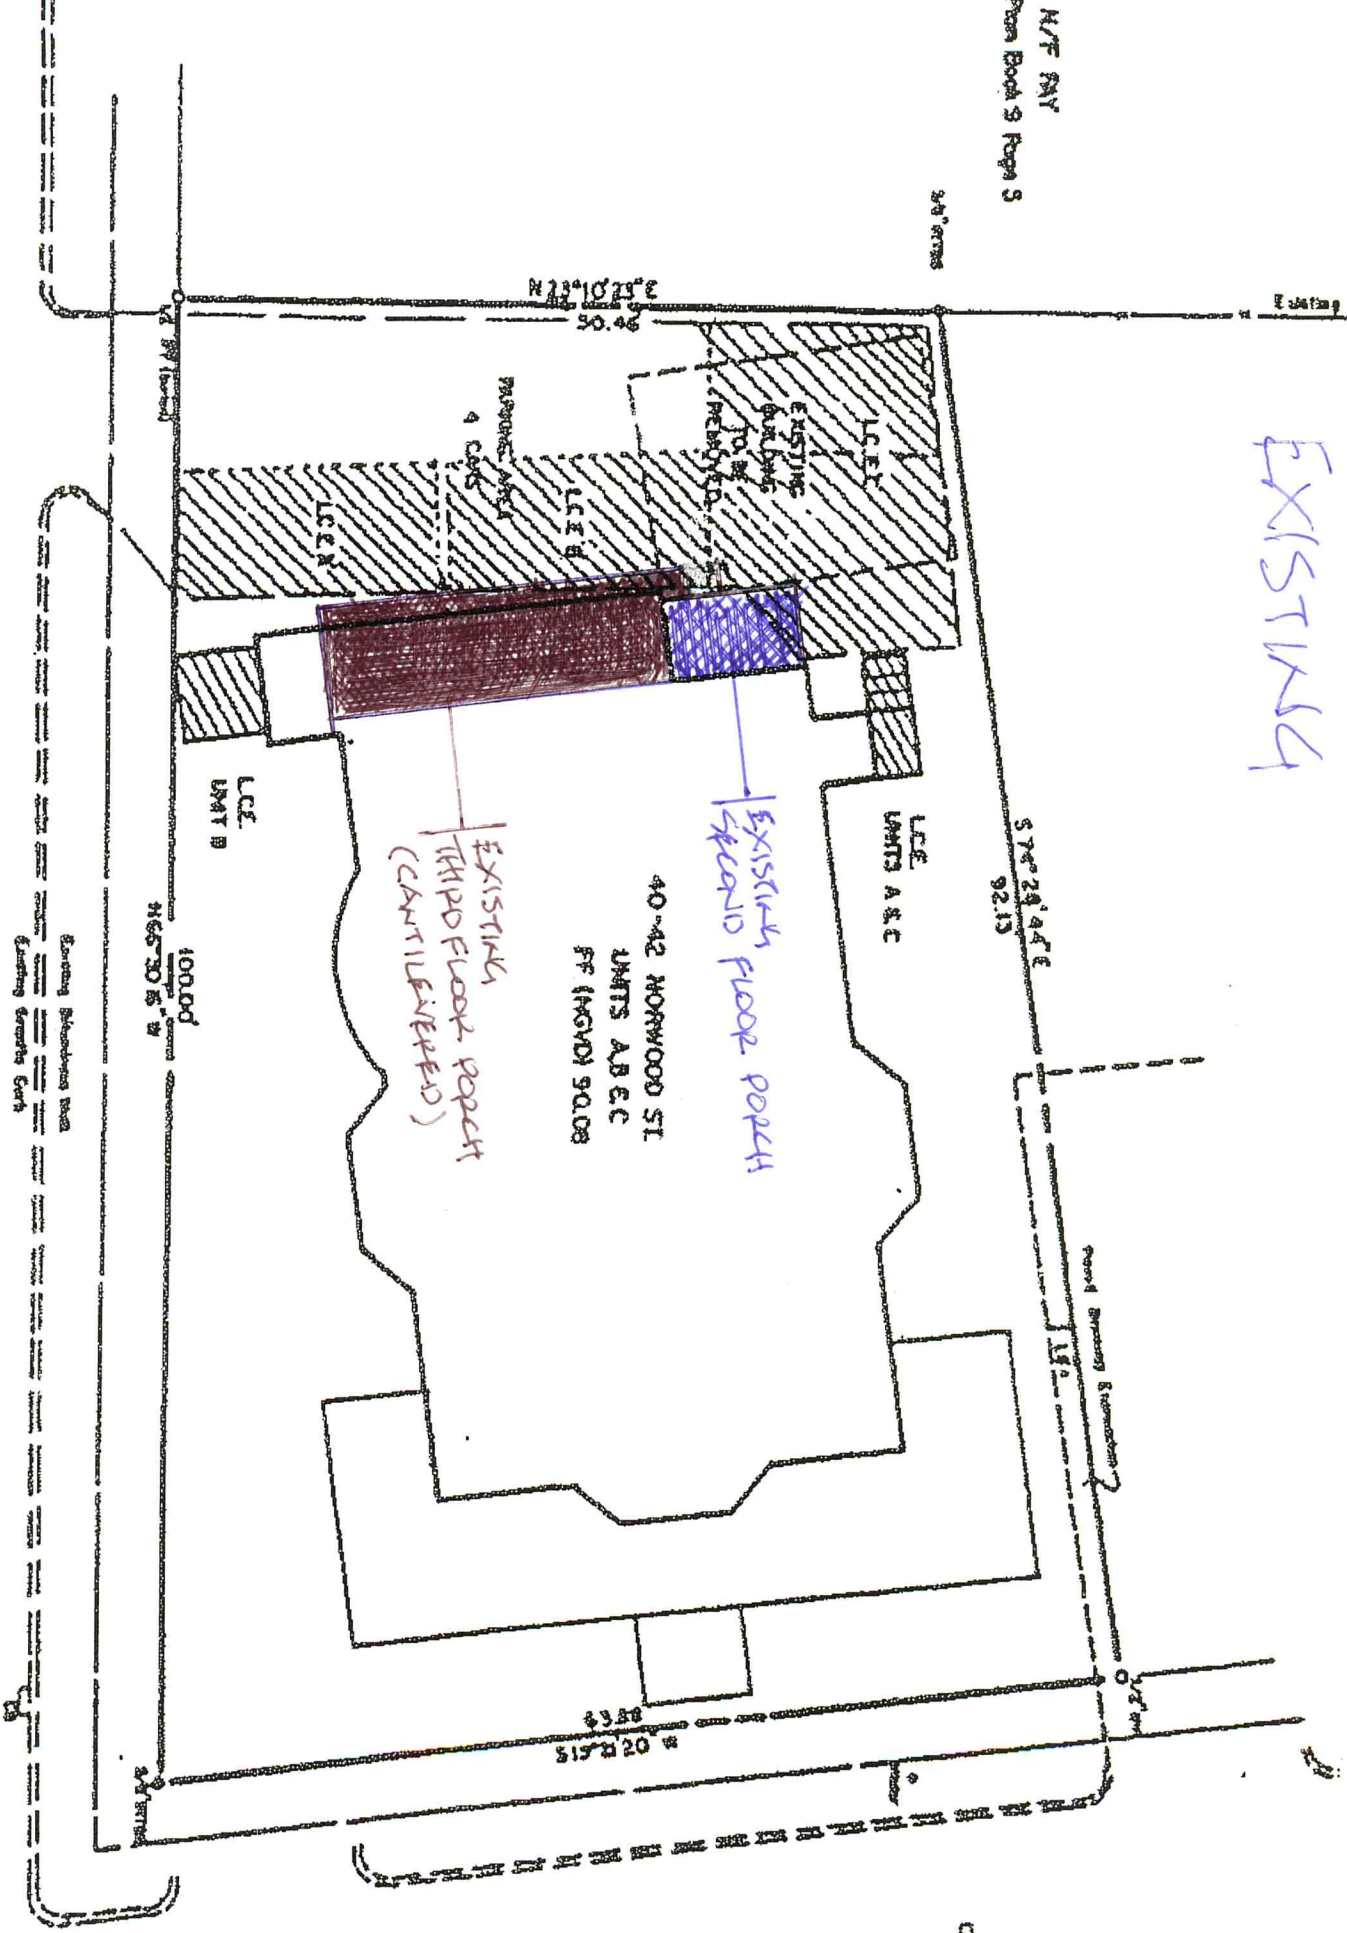

40 NORWOOD ST.
PORTLAND, ME

As Built Information
As Shown on Drawing