

1 Site Plan
 T-1 SCALE: 1" = 10'

DRAWING LIST

- A 1.1 FOUNDATION PLAN
- A 1.2 GROUND FLOOR PLAN
- A 1.3 SECOND FLOOR PLAN
- A 1.4 THIRD FLOOR PLAN
- A 2.1 EXTERIOR ELEVATIONS
- A 3.1 BUILDING SECTIONS
- A 5.1 STRUCTURAL PLANS
- A 6.1 FINISH/DOOR/WINDOW SCHEDULE
- A 6.2 WALL DETAILS


Plymouth House

145 GLENWOOD AVENUE PORTLAND, MAINE


OWNER-
 SSB HOLDINGS
 446 MAIN STREET
 PLYMOUTH, N.H. 03264

ARCHITECT
 WHIPPLE-CALLENDER ARCHITECTS
 136 PLEASANT AVE.
 PORTLAND, ME 0410
 207.775.2696 ext.104
 CONTACT: JOE DELANEY

GENERAL CONTRACTOR
 PAPI & ROMANO BUILDERS
 P.O. BOX 1079
 PORTLAND, MAINE 04104
 207.797-3381
 CONTACT: RICK ROMANO

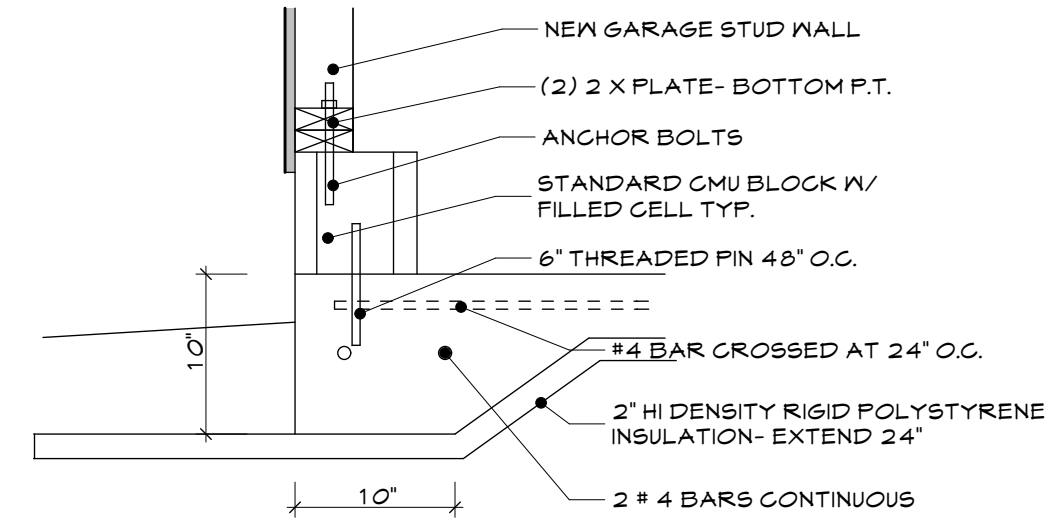

3
A1.1 Slab Edge
SCALE: 1" = 1'-0"

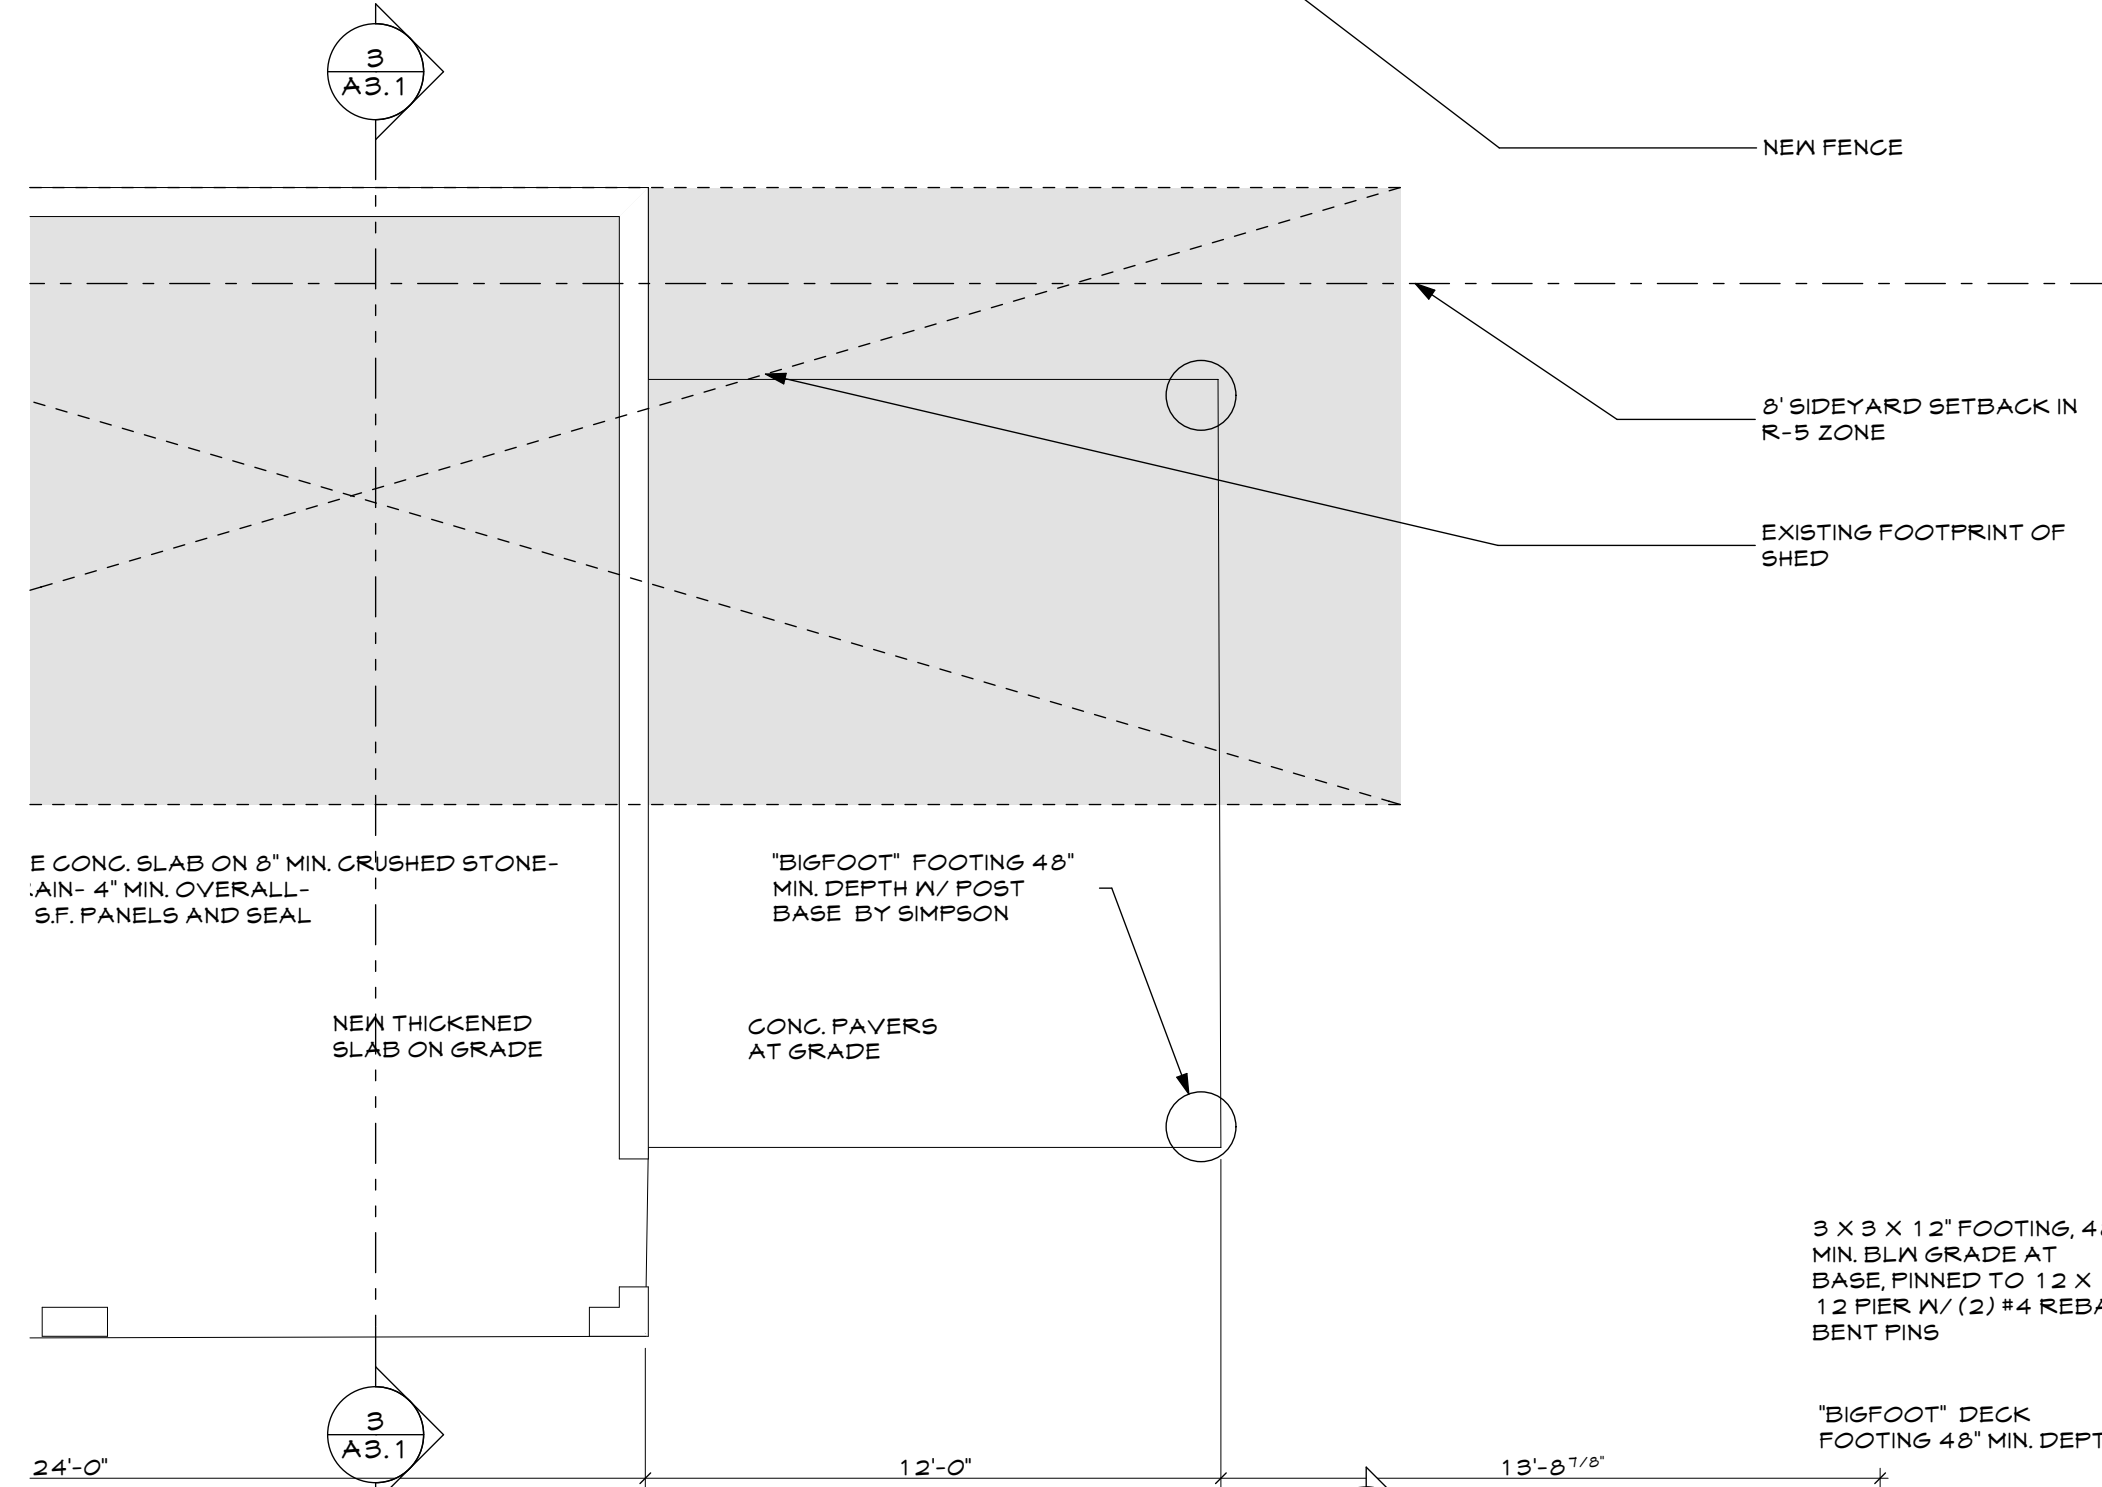

2
A2.1 Garage Slab
SCALE: 1/4" = 1'-0"

ELECTRICAL SYMBOLS


- DUPLEX OUTLET 18" A.F.F. UNLESS NOTED OTHERWISE "WP" INDICATES WATERPROOF OUTLET PROVIDE GPI WHERE NOTED
- DOUBLE DUPLEX OUTLET 18" A.F.F. UNLESS NOTED OTHERWISE "WP" INDICATES WATERPROOF OUTLET PROVIDE GPI WHERE NOTED
- SPECIAL PURPOSE POWER OUTLET - CONSULT OWNER - RE STOVE, MICROWAVE, DISPOSAL
- WALL PHONE JACK 18" A.F.F. UNLESS NOTED OTHERWISE
- CABLE TV IF REQ'D - ASK OWNER
- SWITCH
- THREE-WAY SWITCH
- COMPUTER - CONSULT OWNER - RE INTERNET CONNECTION
- DUPLEX FLOOR OUTLET
- CEILING FAN
- EXHAUST FAN

LIGHTING SYMBOLS

- RECESSED CAN FIXTURE
- WALL SCONCE
- EXTERIOR WALL SCONCE
- UTILITY LIGHT
- SURFACE MOUNTED FIXTURE
- PENDANT

LIFE SAFETY SYMBOLS

- EXIT SIGN
- EMERGENCY LIGHTING
- SMOKE DETECTOR
- FIRE EXT. WALL MTD.

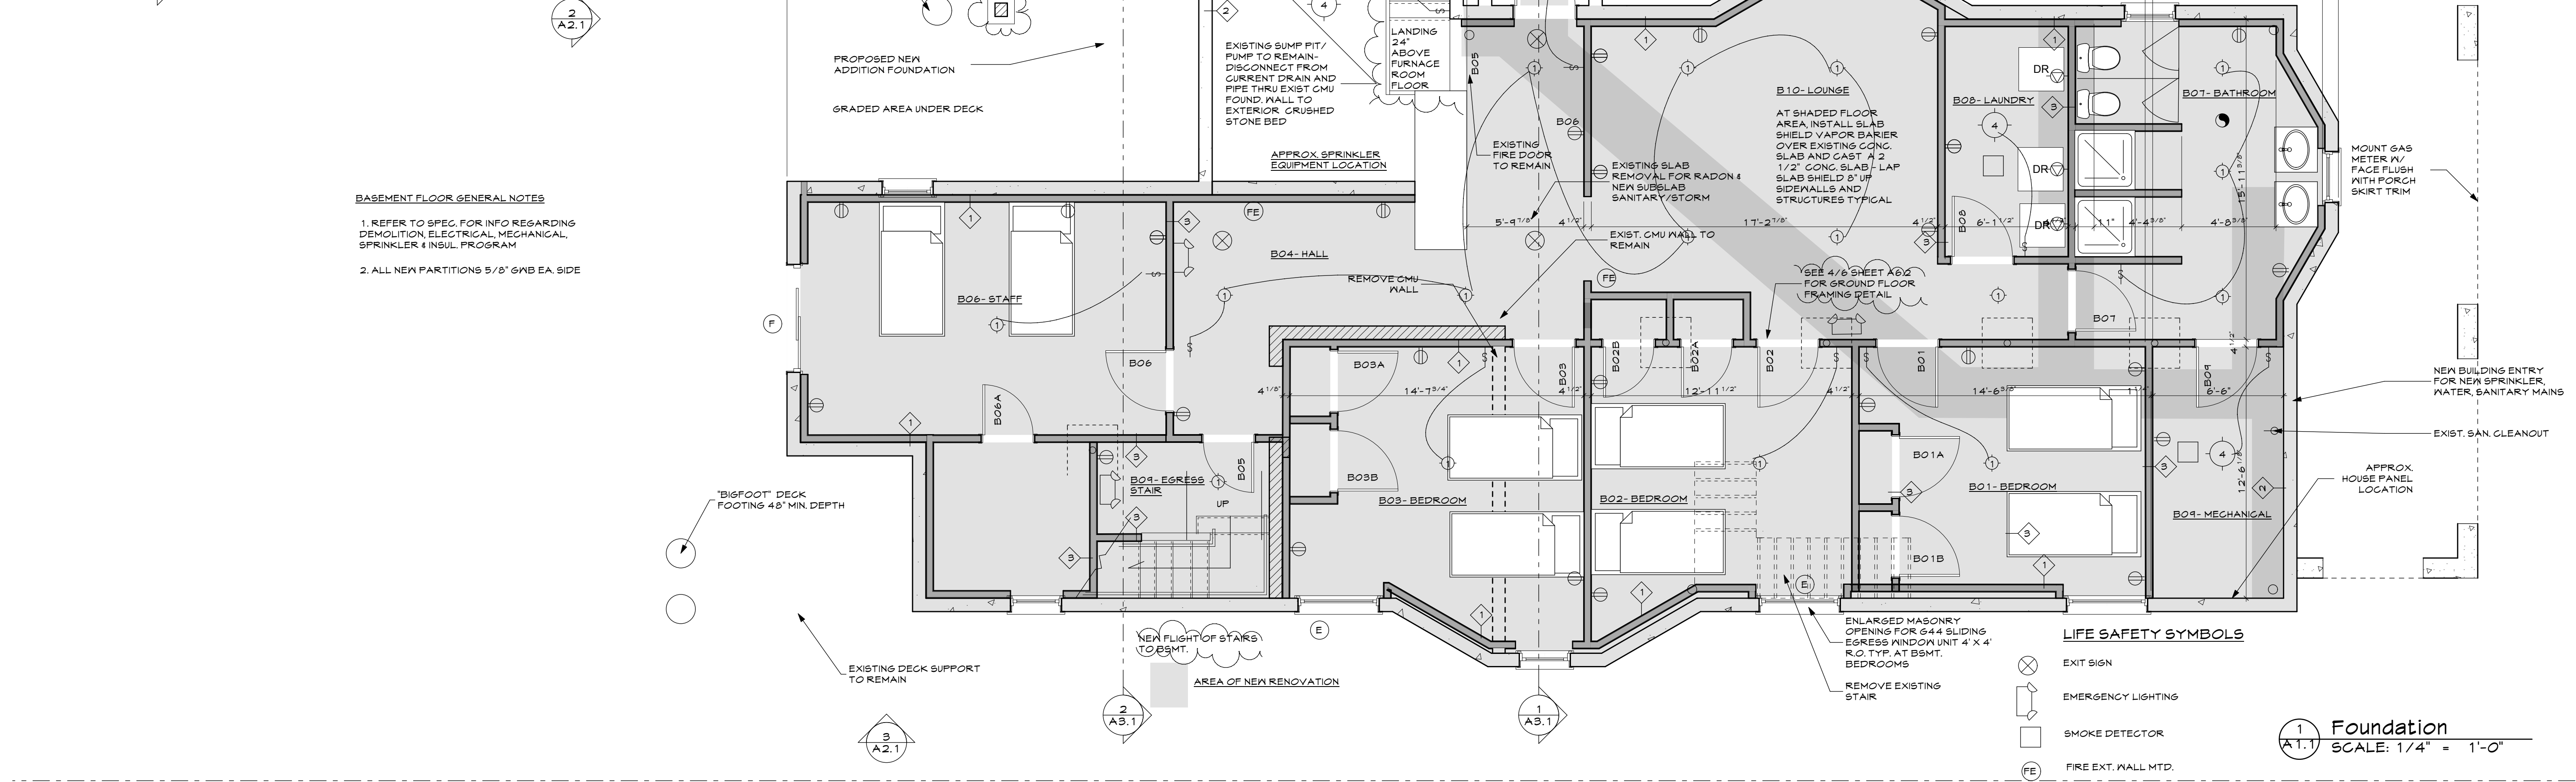

BASEMENT FLOOR GENERAL NOTES

- REFER TO SPEC. FOR INFO REGARDING DEMOLITION, ELECTRICAL, MECHANICAL, SPRINKLER, & INSUL. PROGRAM
- ALL NEW PARTITIONS 5/8" GNB EA. SIDE


Plymouth House
Portland, MAINE
145 Glenwood Avenue

136 PLEASANT AVE.
PORTLAND, ME 04103
P 207.115.2616
F 207.115.5631
www.whipplecallender.com

| DESCRIPTION |
|-------------|
| |
| |
| | |
|--------------|--------------------|
| DATE: | 3.7.13-REV. PERMIT |
| CHECKED BY: | JAD |
| DRAWN BY: | JAD |
| JOB: | O1-2013 |
| SHEET TITLE: | BASEMENT PLAN |

A1.1

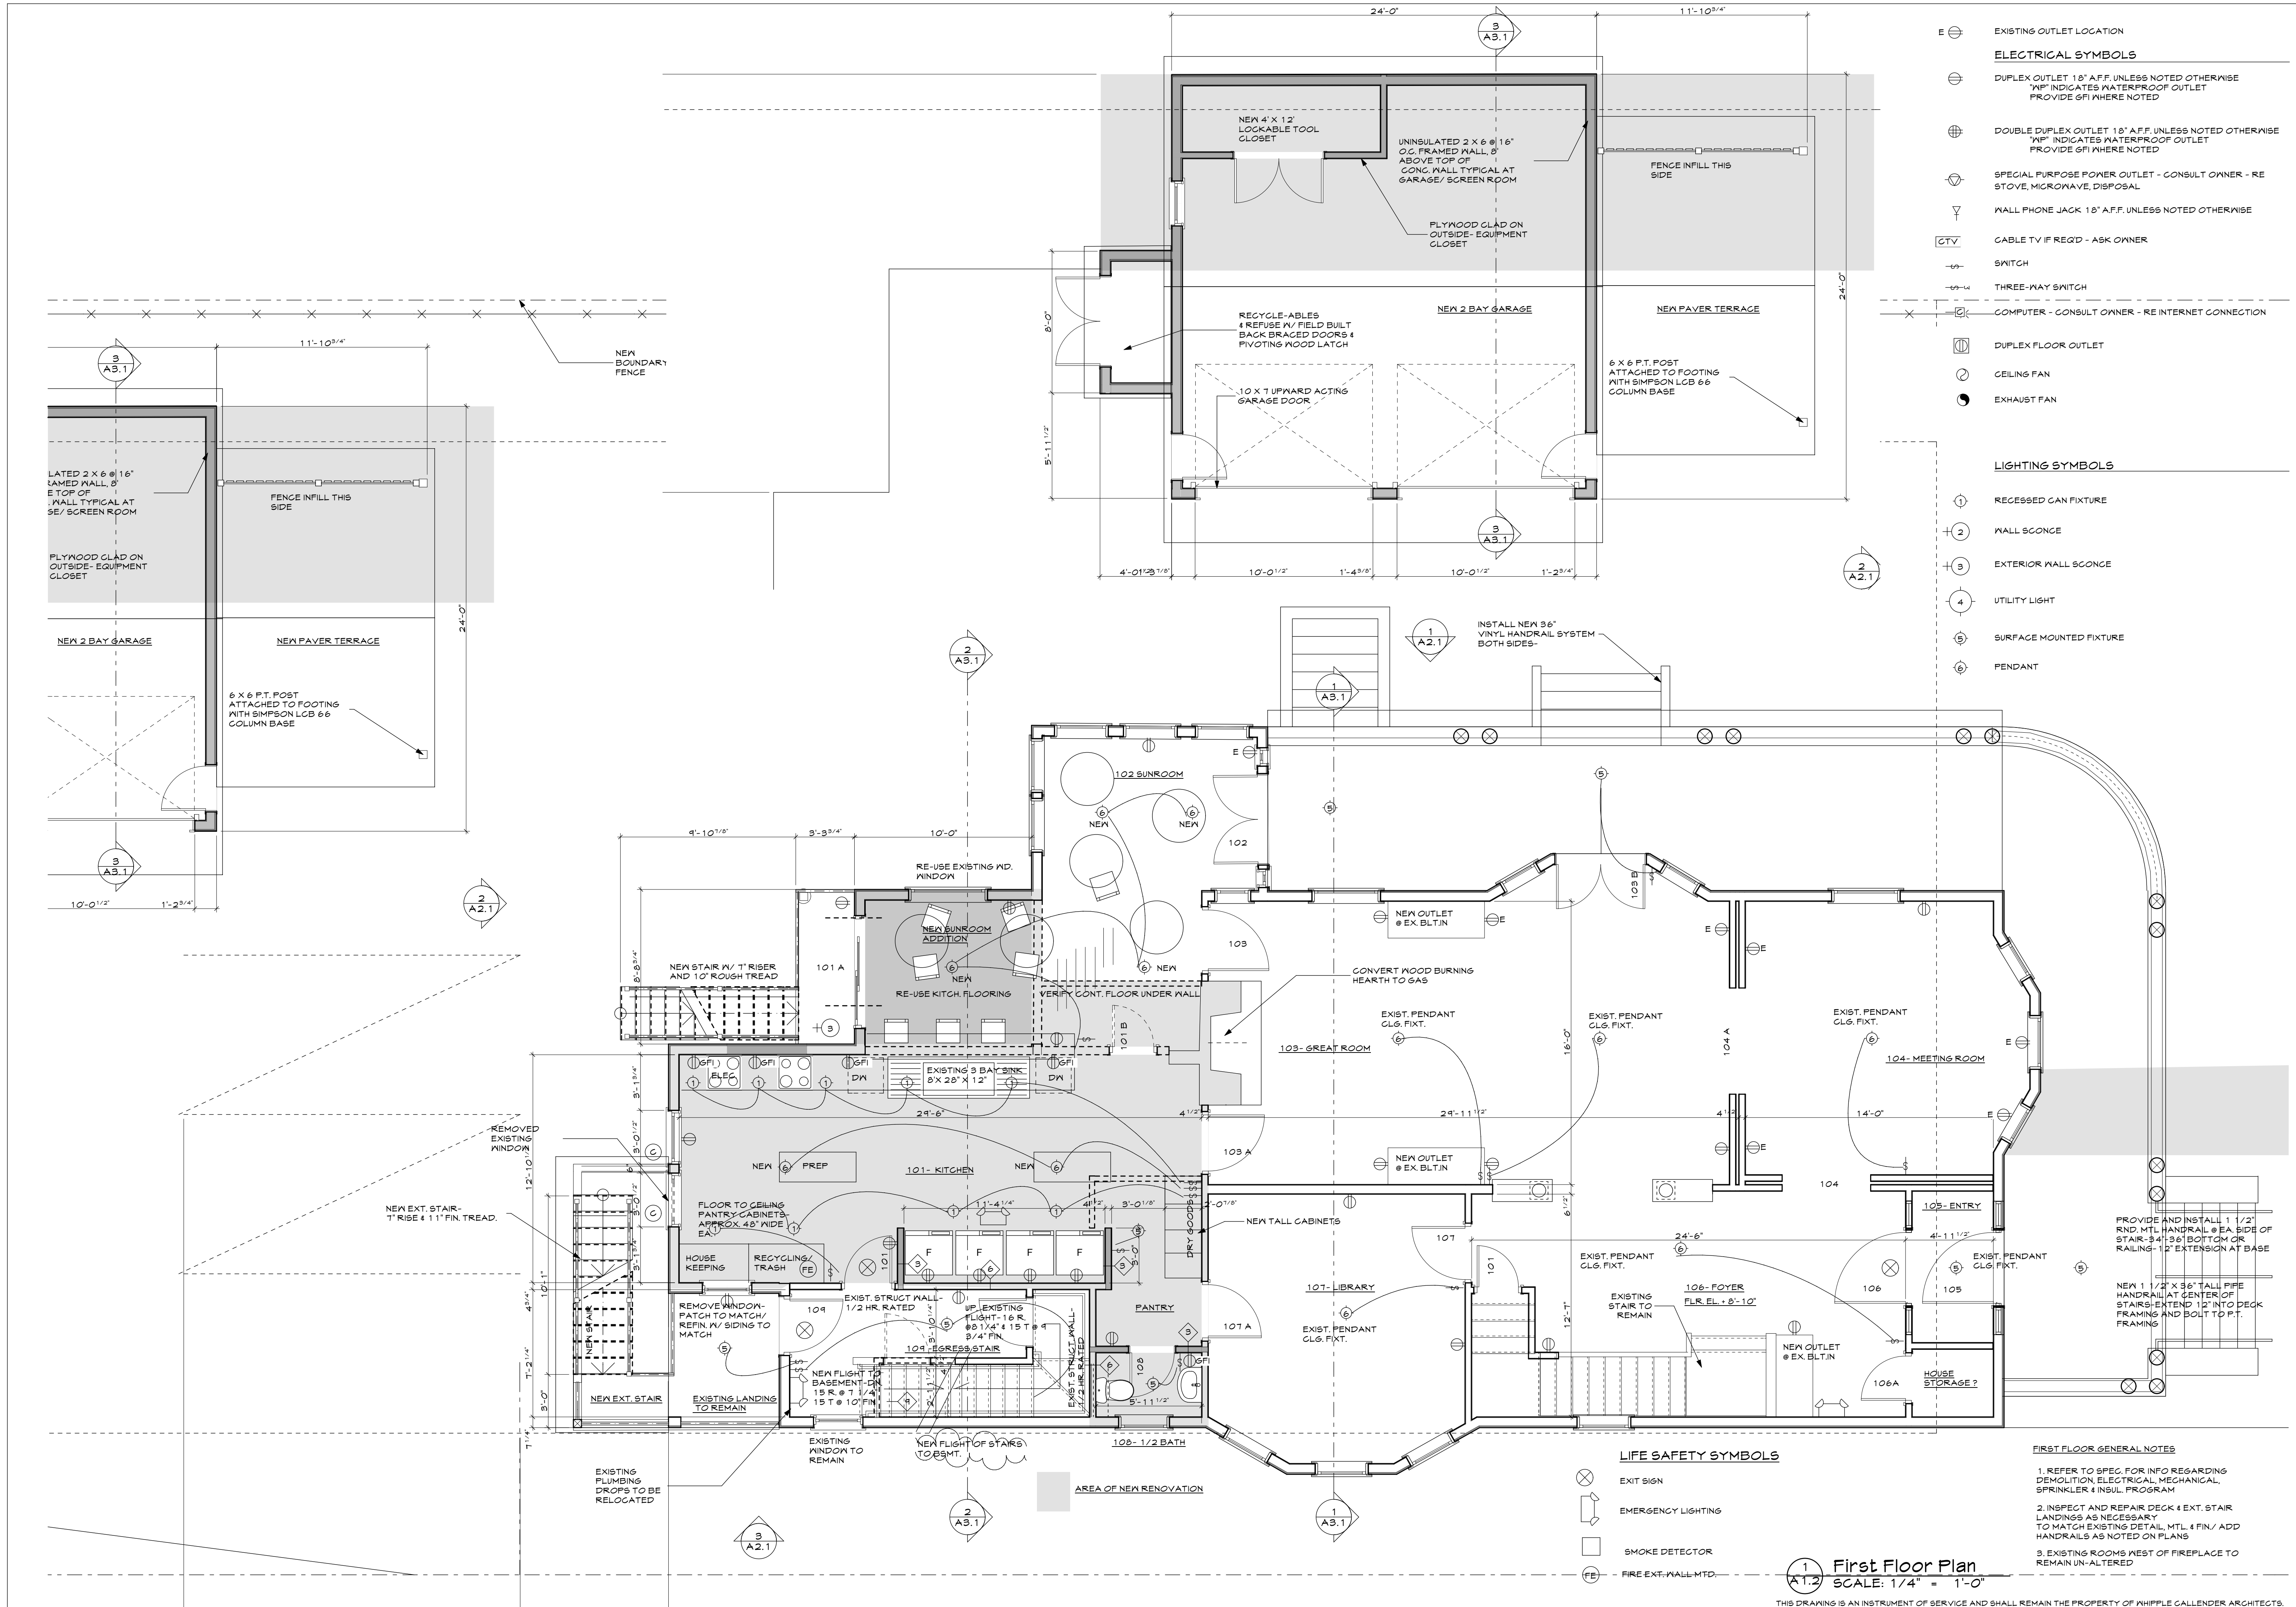

- ELECTRICAL SYMBOLS**
- ⊖ EXISTING OUTLET LOCATION
 - ⊖ DUPLEX OUTLET 18" AFF. UNLESS NOTED OTHERWISE
"WP" INDICATES WATERPROOF OUTLET
PROVIDE GFI WHERE NOTED
 - ⊖ DOUBLE DUPLEX OUTLET 18" AFF. UNLESS NOTED OTHERWISE
"WP" INDICATES WATERPROOF OUTLET
PROVIDE GFI WHERE NOTED
 - ⊖ SPECIAL PURPOSE POWER OUTLET - CONSULT OWNER - RE
STOVE, MICROWAVE, DISPOSAL
 - ⊖ WALL PHONE JACK 18" AFF. UNLESS NOTED OTHERWISE
 - ⊖ CABLE TV IF REQ'D - ASK OWNER
 - ⊖ SWITCH
 - ⊖ THREE-WAY SWITCH
 - ⊖ COMPUTER - CONSULT OWNER - RE INTERNET CONNECTION
 - ⊖ DUPLEX FLOOR OUTLET
 - ⊖ CEILING FAN
 - ⊖ EXHAUST FAN
- LIGHTING SYMBOLS**
- ⊖ RECESSED CAN FIXTURE
 - ⊖ WALL SCONCE
 - ⊖ EXTERIOR WALL SCONCE
 - ⊖ UTILITY LIGHT
 - ⊖ SURFACE MOUNTED FIXTURE
 - ⊖ PENDANT
- LIFE SAFETY SYMBOLS**
- ⊖ EXIT SIGN
 - ⊖ EMERGENCY LIGHTING
 - ⊖ SMOKE DETECTOR
 - ⊖ FIRE EXT. WALL MTD.

1 First Floor Plan
A1.2 SCALE: 1/4" = 1'-0"

THIS DRAWING IS AN INSTRUMENT OF SERVICE AND SHALL REMAIN THE PROPERTY OF WHIPPLE CALLENDER ARCHITECTS. IT SHALL NOT BE USED FOR ANY OTHER PURPOSE THAT FOR WHICH IT IS SPECIFICALLY FURNISHED.

Plymouth House
 Portland, MAINE
 145 Glenwood Avenue



WHIPPLE — CALLENDER ARCHITECTS

136 PLEASANT AVE.
 PORTLAND, ME 04103
 P 207.115.2646
 F 207.115.5631
 www.whipplecallender.com

| DATE | DESCRIPTION |
|------|-------------|
| | |
| | |
| | |
| | |

DATE: 3.7.13-REV. PERMIT
 CHECKED BY: JAD
 DRAWN BY: JAD
 JOB: 01-2013
 SHEET TITLE: FIRST FLOOR PLAN

A1.2

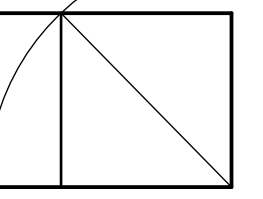
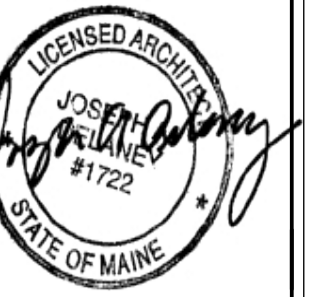



| MARK | DATE | DESCRIPTION |
|--------------|-------------------|-------------|
| DATE | 3.7.13 | REV. PERMIT |
| CHECKED BY: | JAD | |
| DRAWN BY: | JAD | |
| JOB: | 01-2013 | |
| SHEET TITLE: | SECOND FLOOR PLAN | |

- ELECTRICAL SYMBOLS**
- EXISTING OUTLET LOCATION
 - DUPLEX OUTLET 15" A.F.F. UNLESS NOTED OTHERWISE
"WF" INDICATES WATERPROOF OUTLET
PROVIDE GFI WHERE NOTED
 - DOUBLE DUPLEX OUTLET 15" A.F.F. UNLESS NOTED OTHERWISE
"WF" INDICATES WATERPROOF OUTLET
PROVIDE GFI WHERE NOTED
 - SPECIAL PURPOSE POWER OUTLET - CONSULT OWNER - RE
STOVE, MICROWAVE, DISPOSAL
 - WALL PHONE JACK 15" A.F.F. UNLESS NOTED OTHERWISE
 - CABLE TV IF REQ'D - ASK OWNER
 - SWITCH
 - THREE-WAY SWITCH
 - COMPUTER - CONSULT OWNER - RE INTERNET CONNECTION
 - DUPLEX FLOOR OUTLET
 - CEILING FAN
 - EXHAUST FAN
- LIGHTING SYMBOLS**
- RECESSED CAN FIXTURE
 - WALL SCONCE
 - EXTERIOR WALL SCONCE
 - UTILITY LIGHT
 - SURFACE MOUNTED FIXTURE
 - PENDANT


- LIFE SAFETY SYMBOLS**
- EXIT SIGN
 - EMERGENCY LIGHTING
 - SMOKE DETECTOR
 - FIRE EXT. WALL MTD.

1 Second Floor Plan
 A1.3 SCALE: 1/4" = 1'-0"

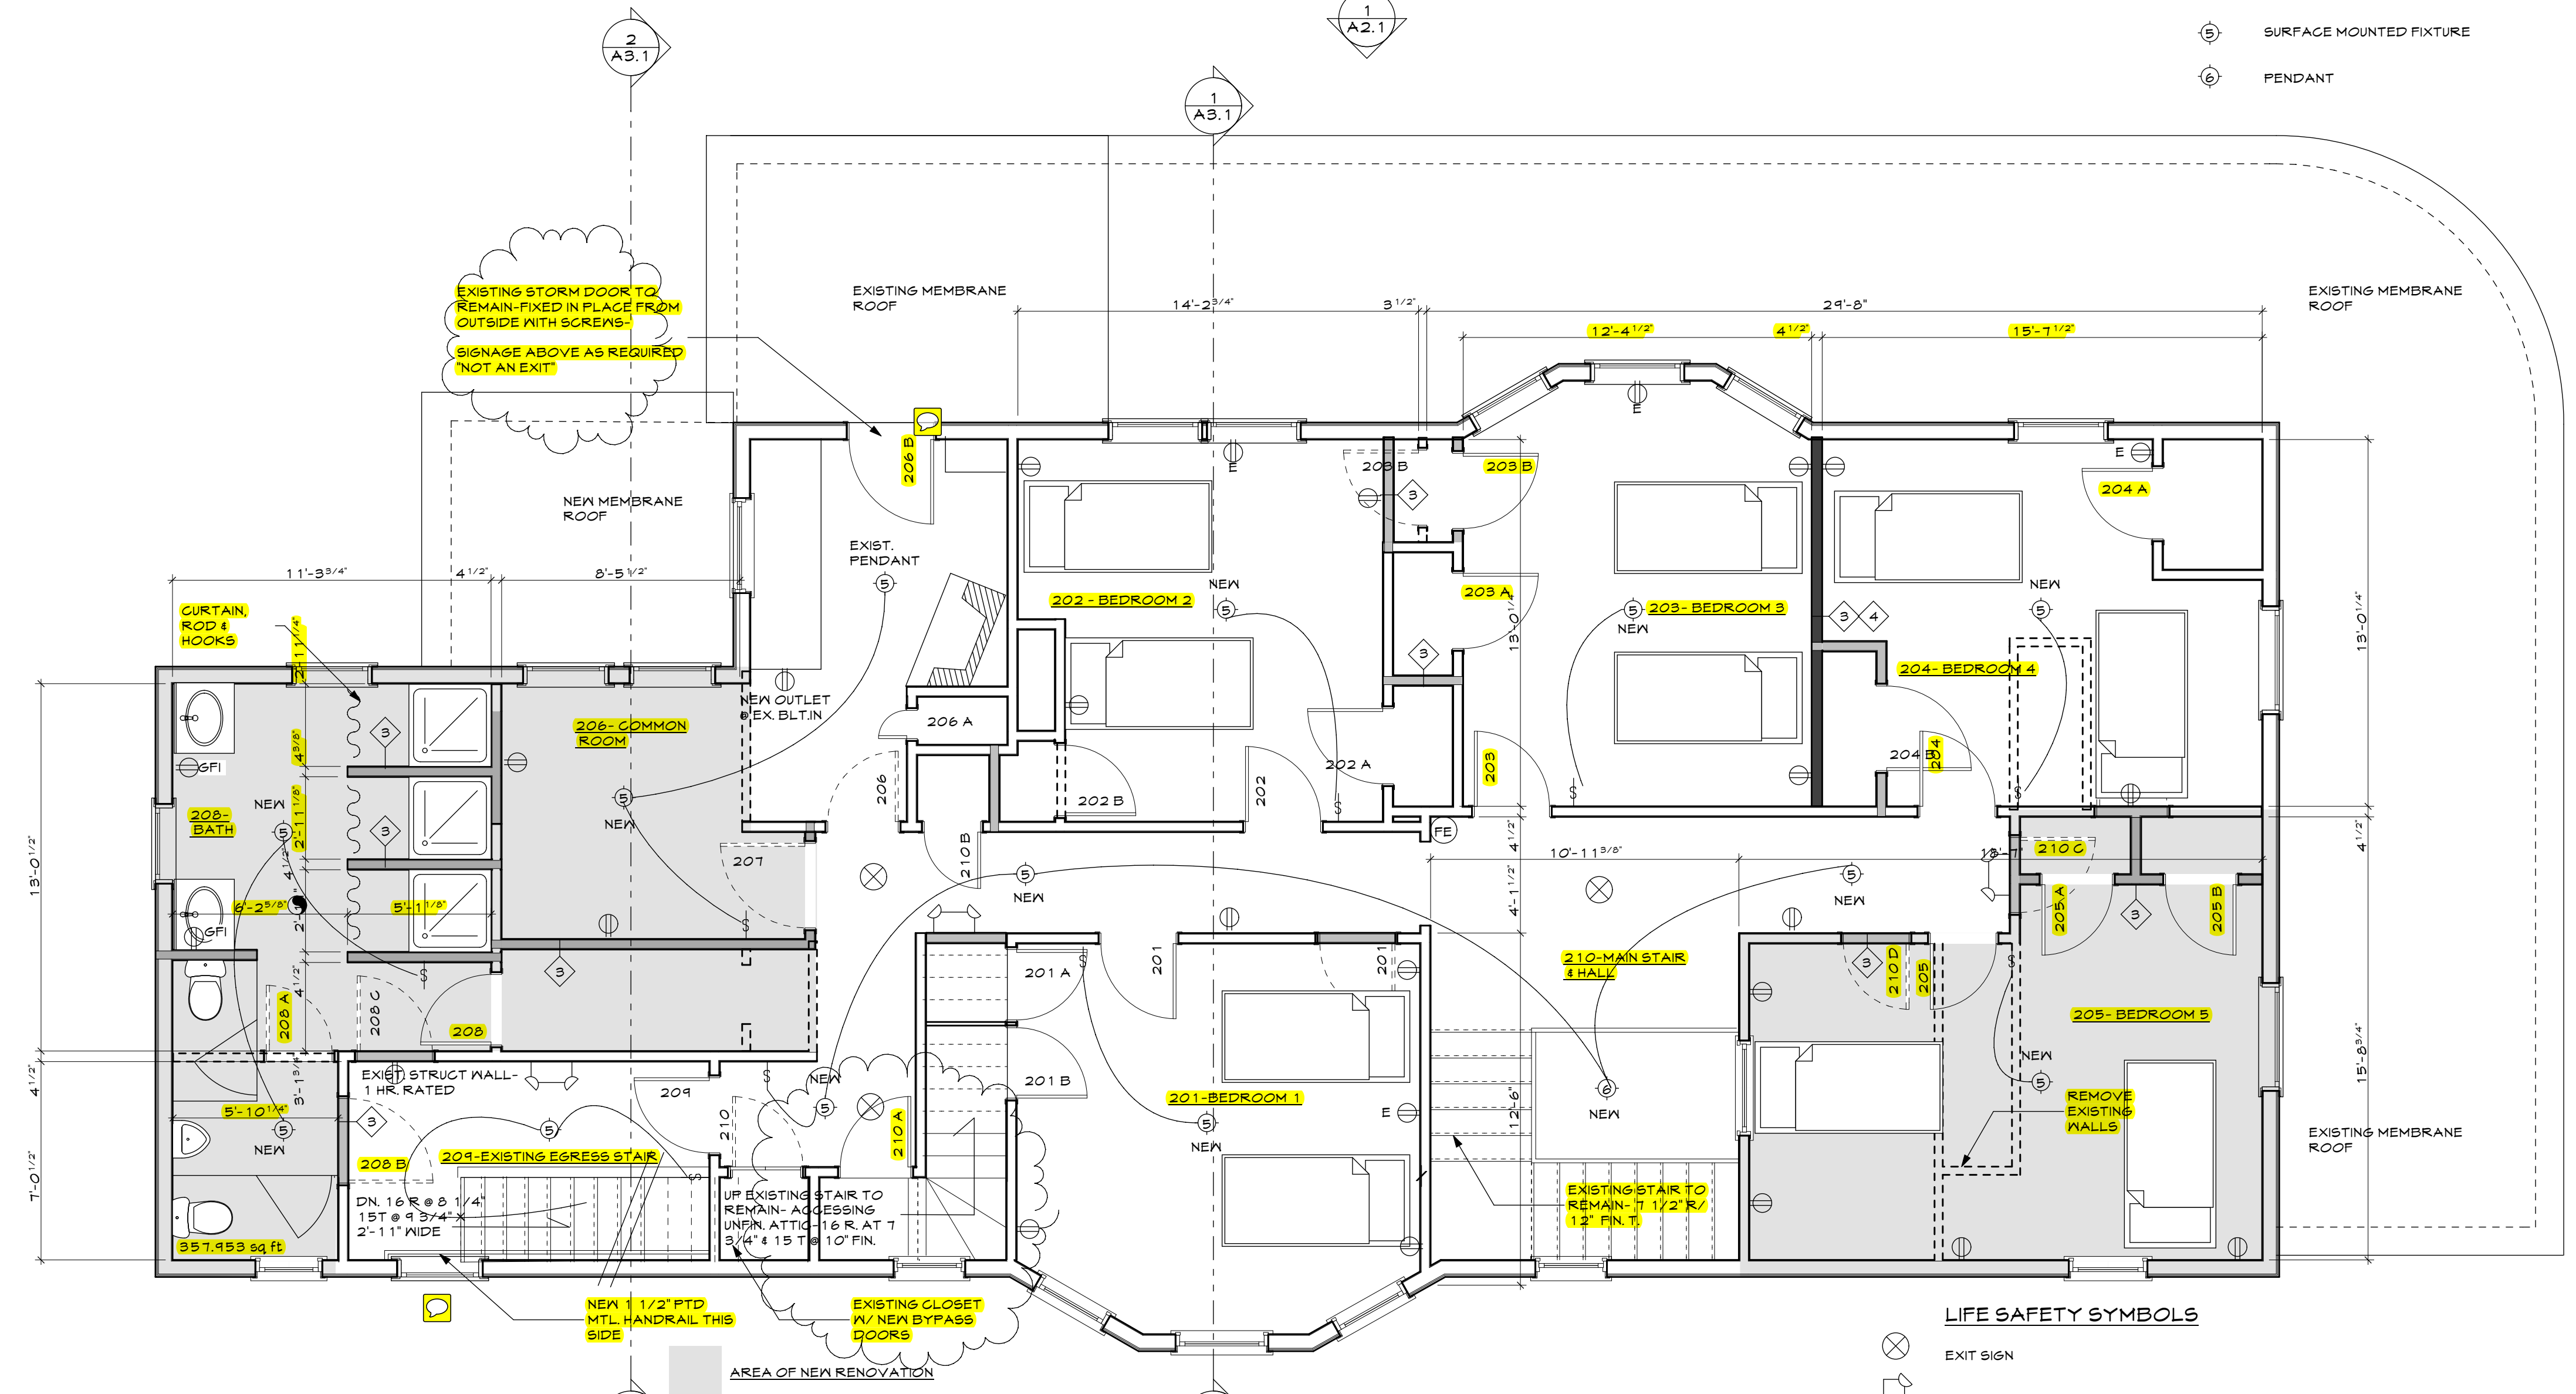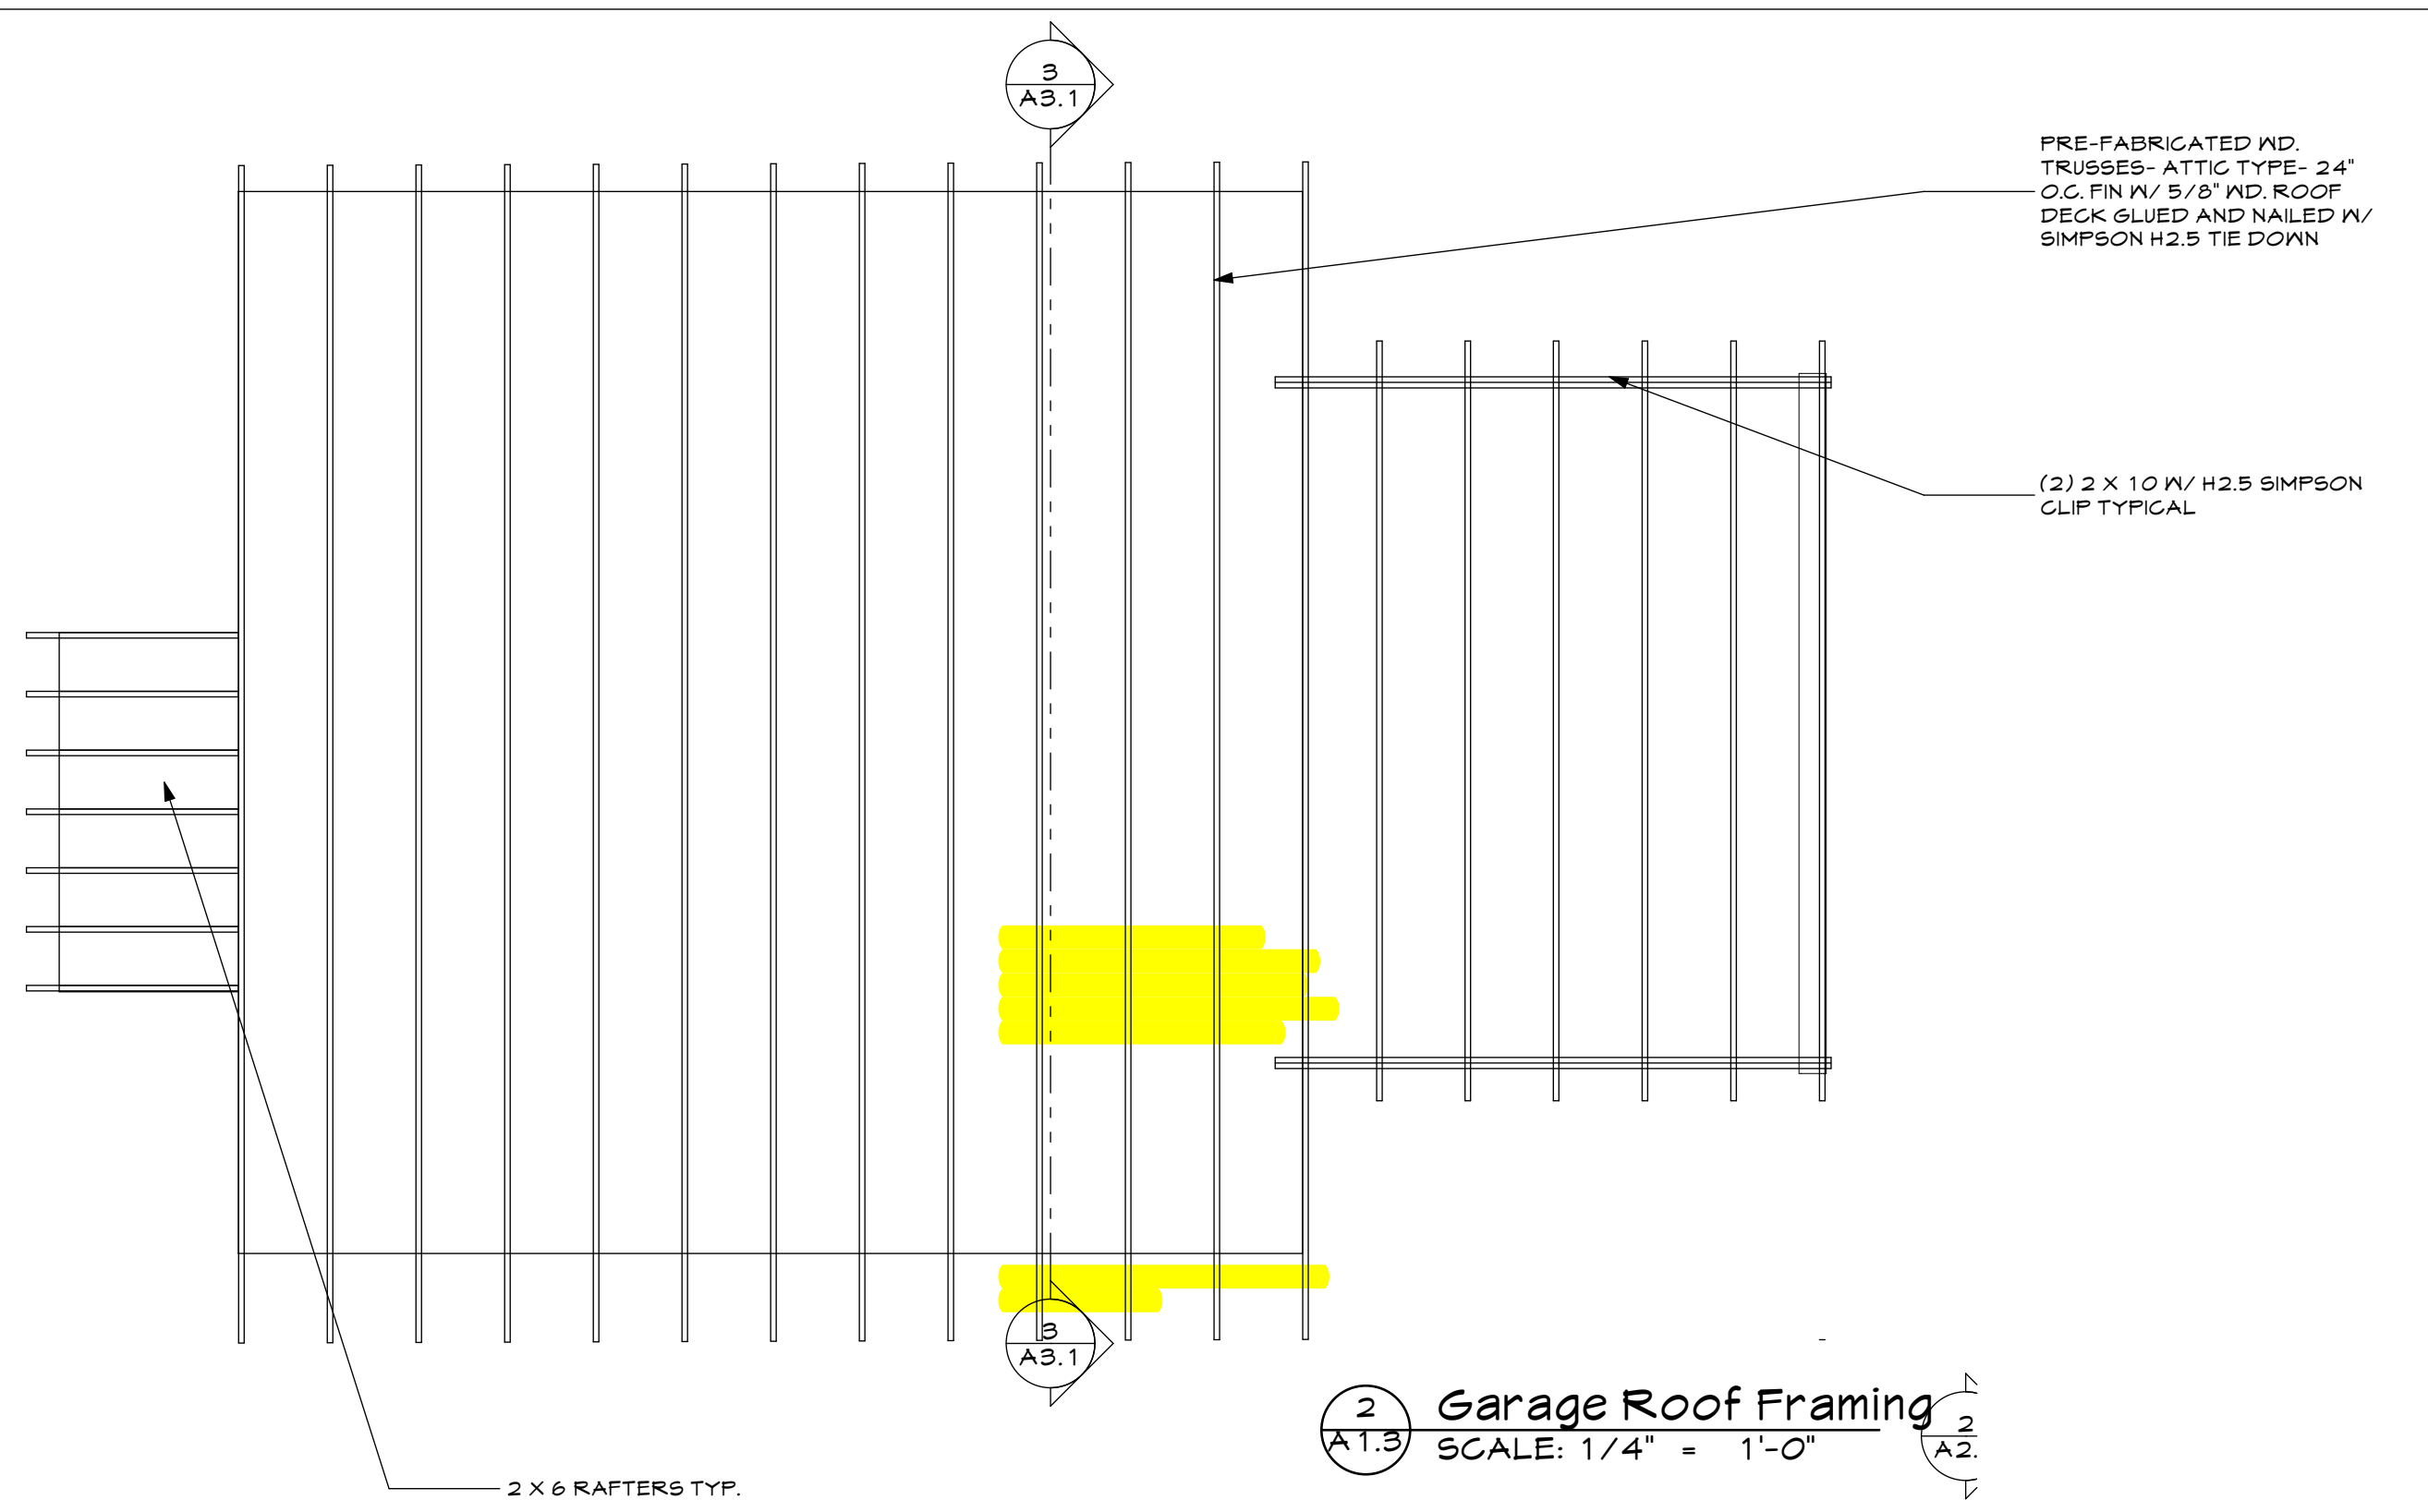

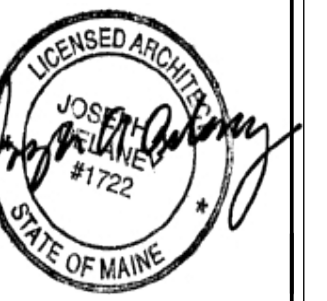

WHIPPLE —
 CALLENDER
 ARCHITECTS

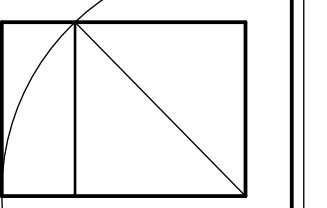

136 PLEASANT AVE.
 PORTLAND, ME 04103
 P 207.715.2616
 F 207.715.5631
 www.whipplecallender.com


| MARK | DATE | DESCRIPTION |
|------|------|-------------|
| | | |
| | | |
| | | |
| | | |

DATE: 3.7.13-REV. PERMIT
 CHECKED BY: JAD
 DRAWN BY: JAD
 JOB: 01-2013
 SHEET TITLE: THIRD FLOOR PLAN


A1.4

THIRD FLOOR GENERAL NOTES


1. REFER TO SPEC. FOR INFO REGARDING DEMOLITION, ELECTRICAL, MECHANICAL, SPRINKLER & INSUL. PROGRAM.
2. INSPECT AND REPAIR ROOF AREA IN VICINITY OR DORMERS TYPICAL.
3. INSPECT GUTTERS AND ROOF PERIMETER EDGE CONDITIONS.

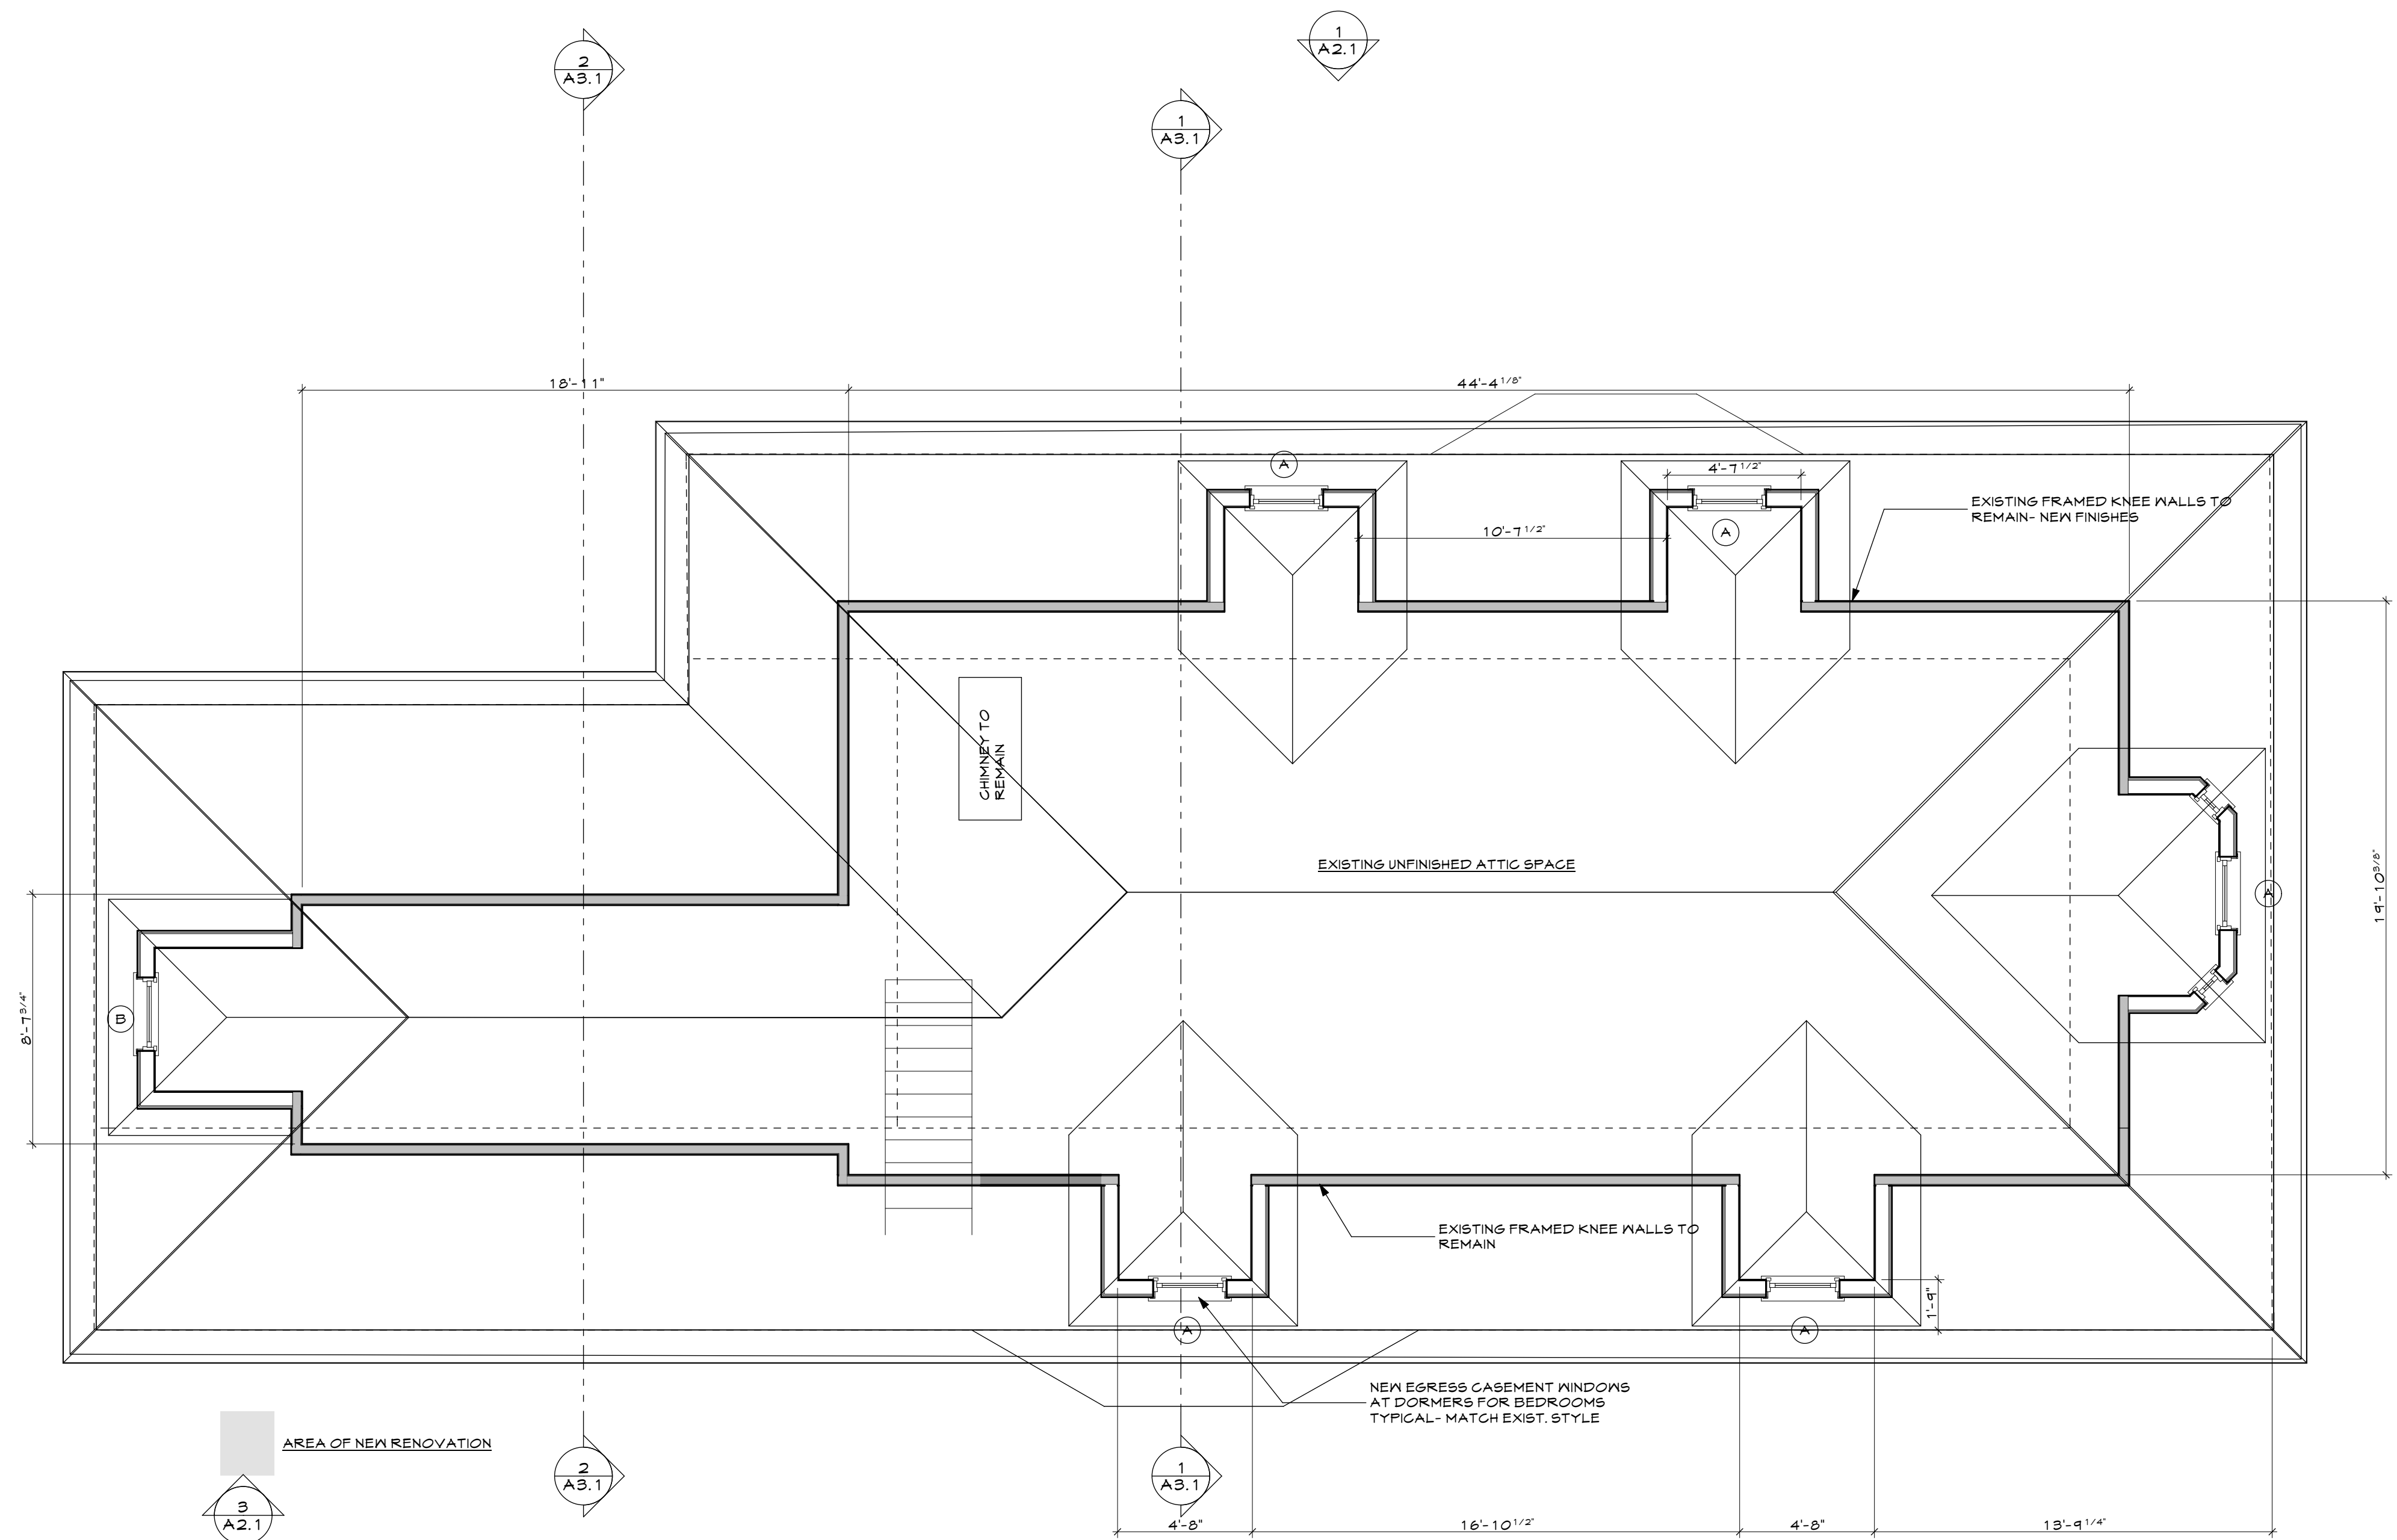

1 Third Floor Plan
A1.4 SCALE: 1/4" = 1'-0"

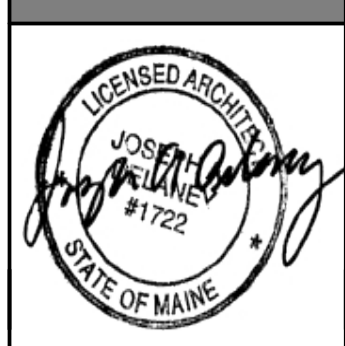


WHIPPLE —
 CALLENDER
 ARCHITECTS

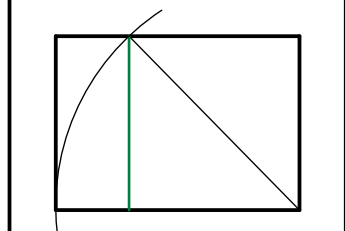


136 PLEASANT AVE.
 PORTLAND, ME 04103
 P 207.115.2616
 F 207.115.5631
 www.whipplecallender.com

| MARK | DATE | DESCRIPTION |
|------|------|-------------|
| | | |
| | | |
| | |
|--------------|---------------------|
| DATE: | 3.7.13-REV. PERMIT |
| CHECKED BY: | JAD |
| DRAWN BY: | JAD |
| JOB: | 01-2013 |
| SHEET TITLE: | EXTERIOR ELEVATIONS |

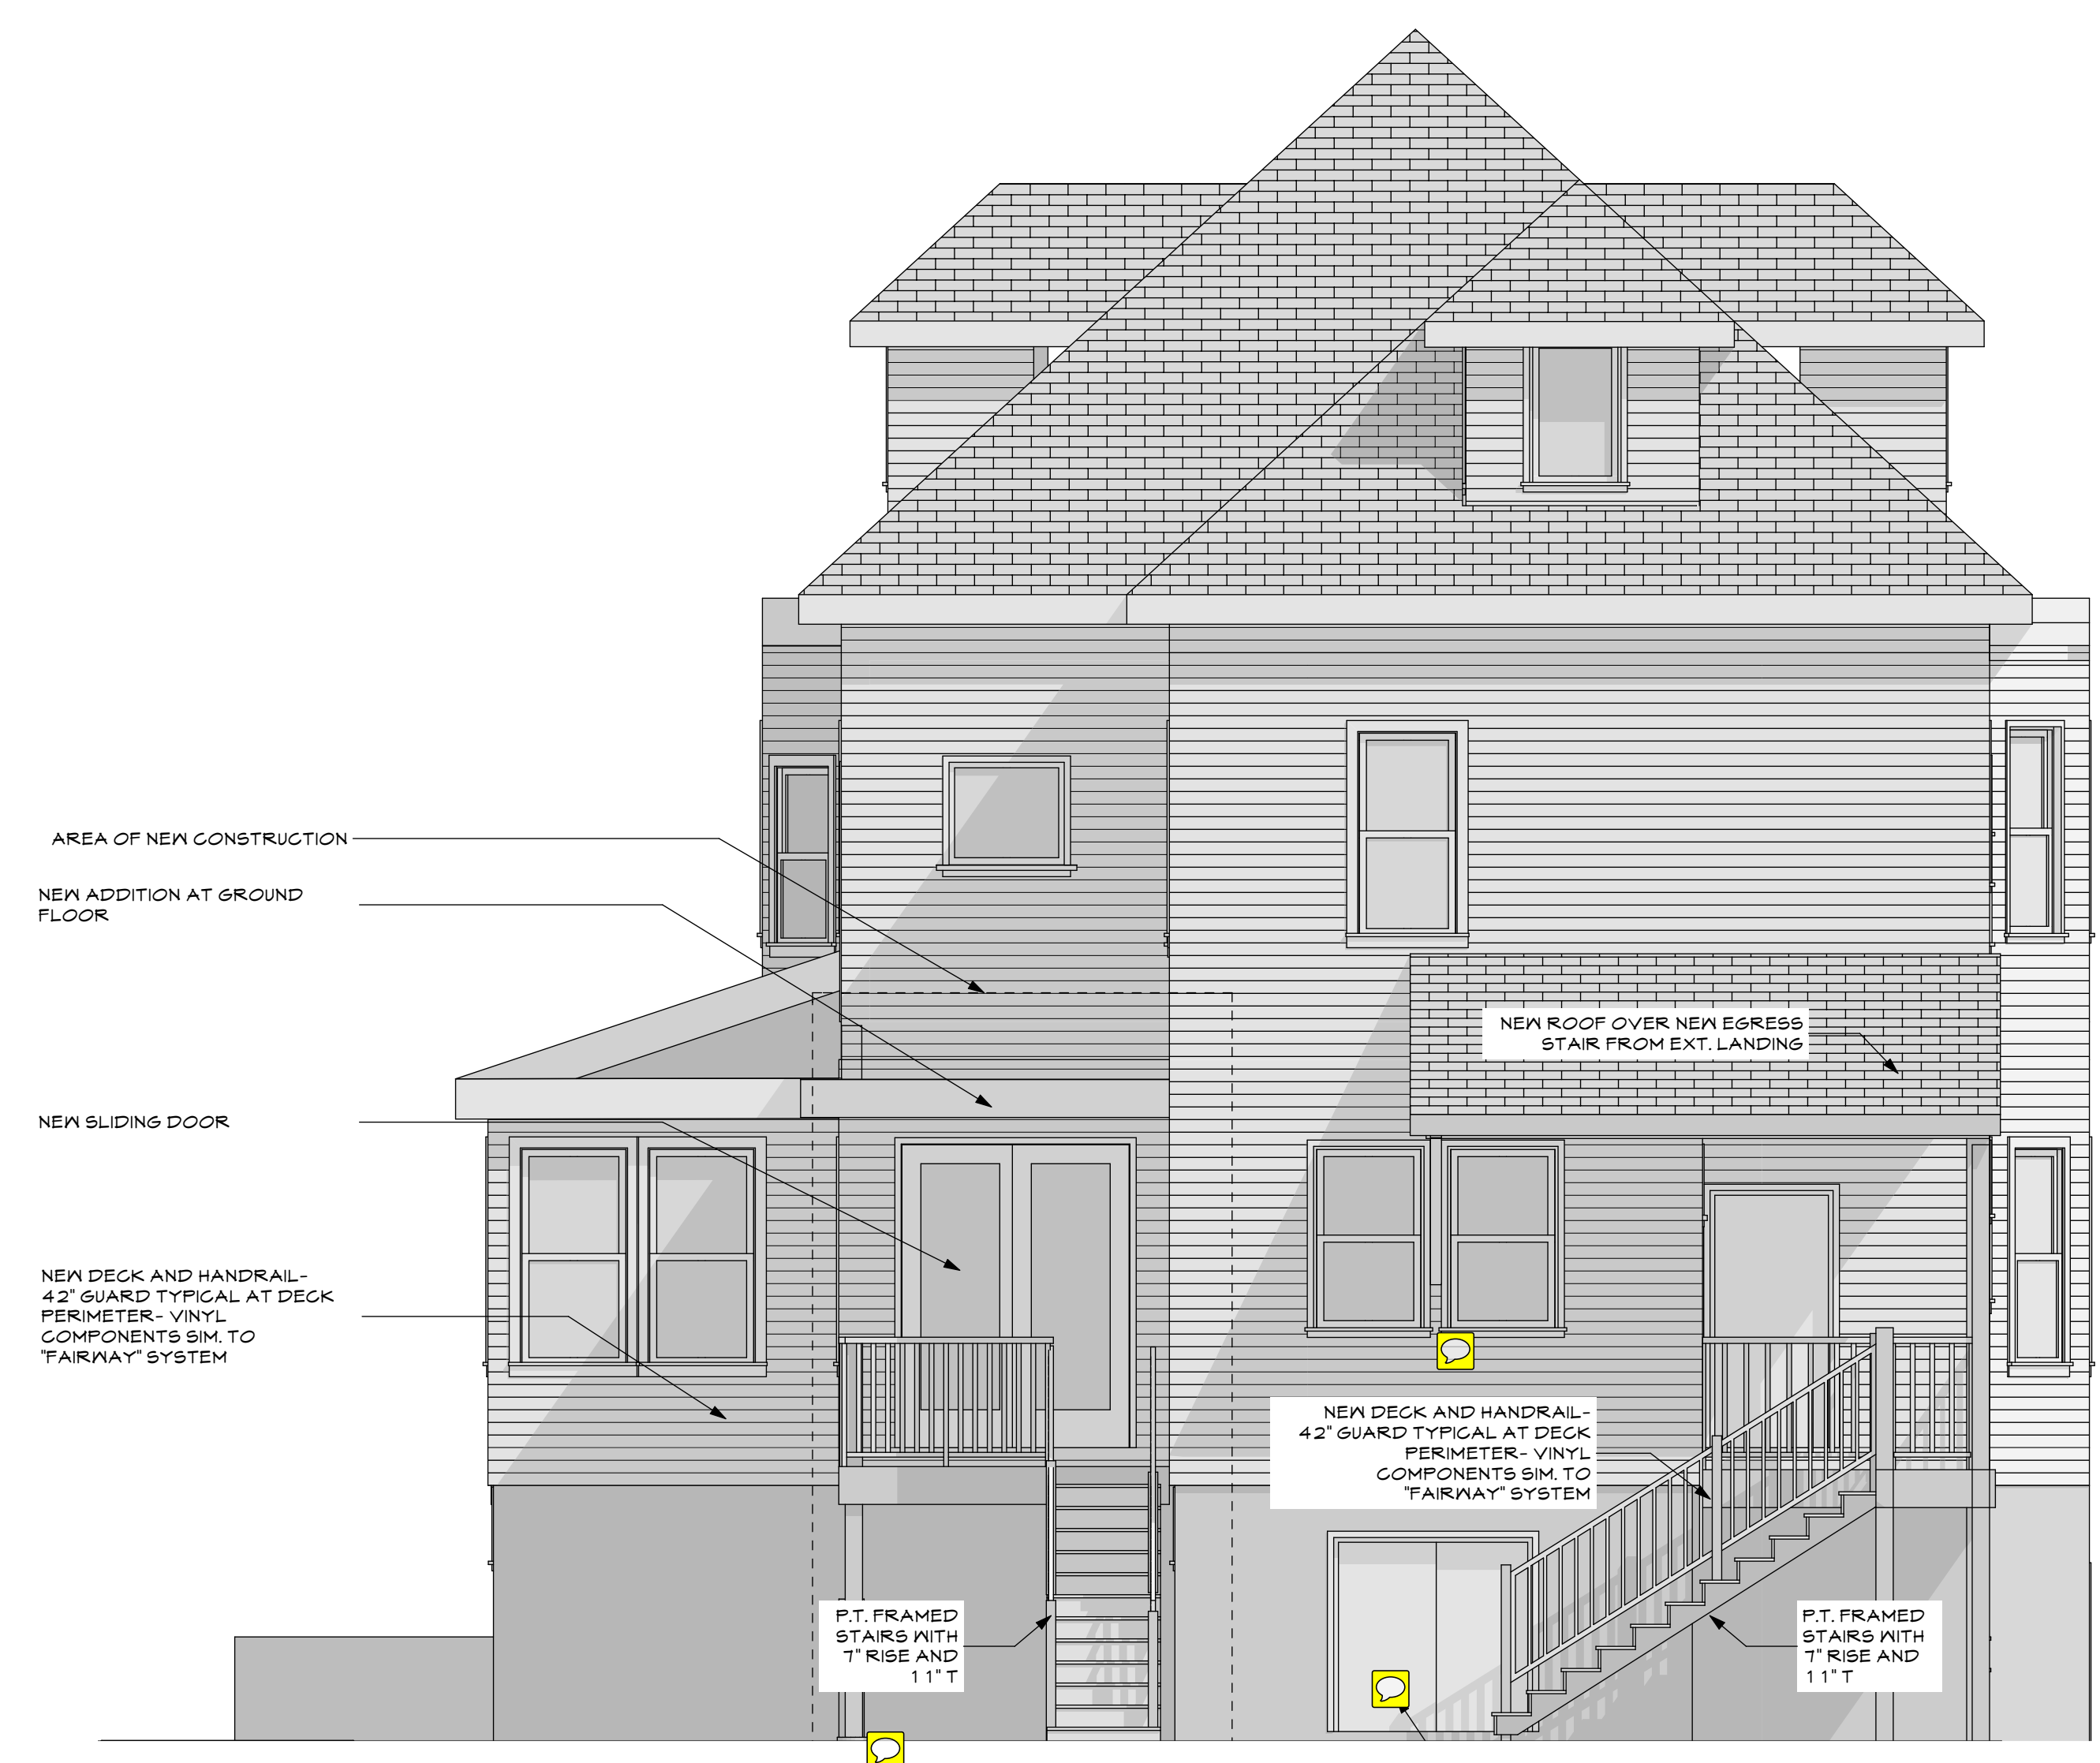


2 Sunroom Add. & Open Deck
 SCALE: 1/4" = 1'-0"

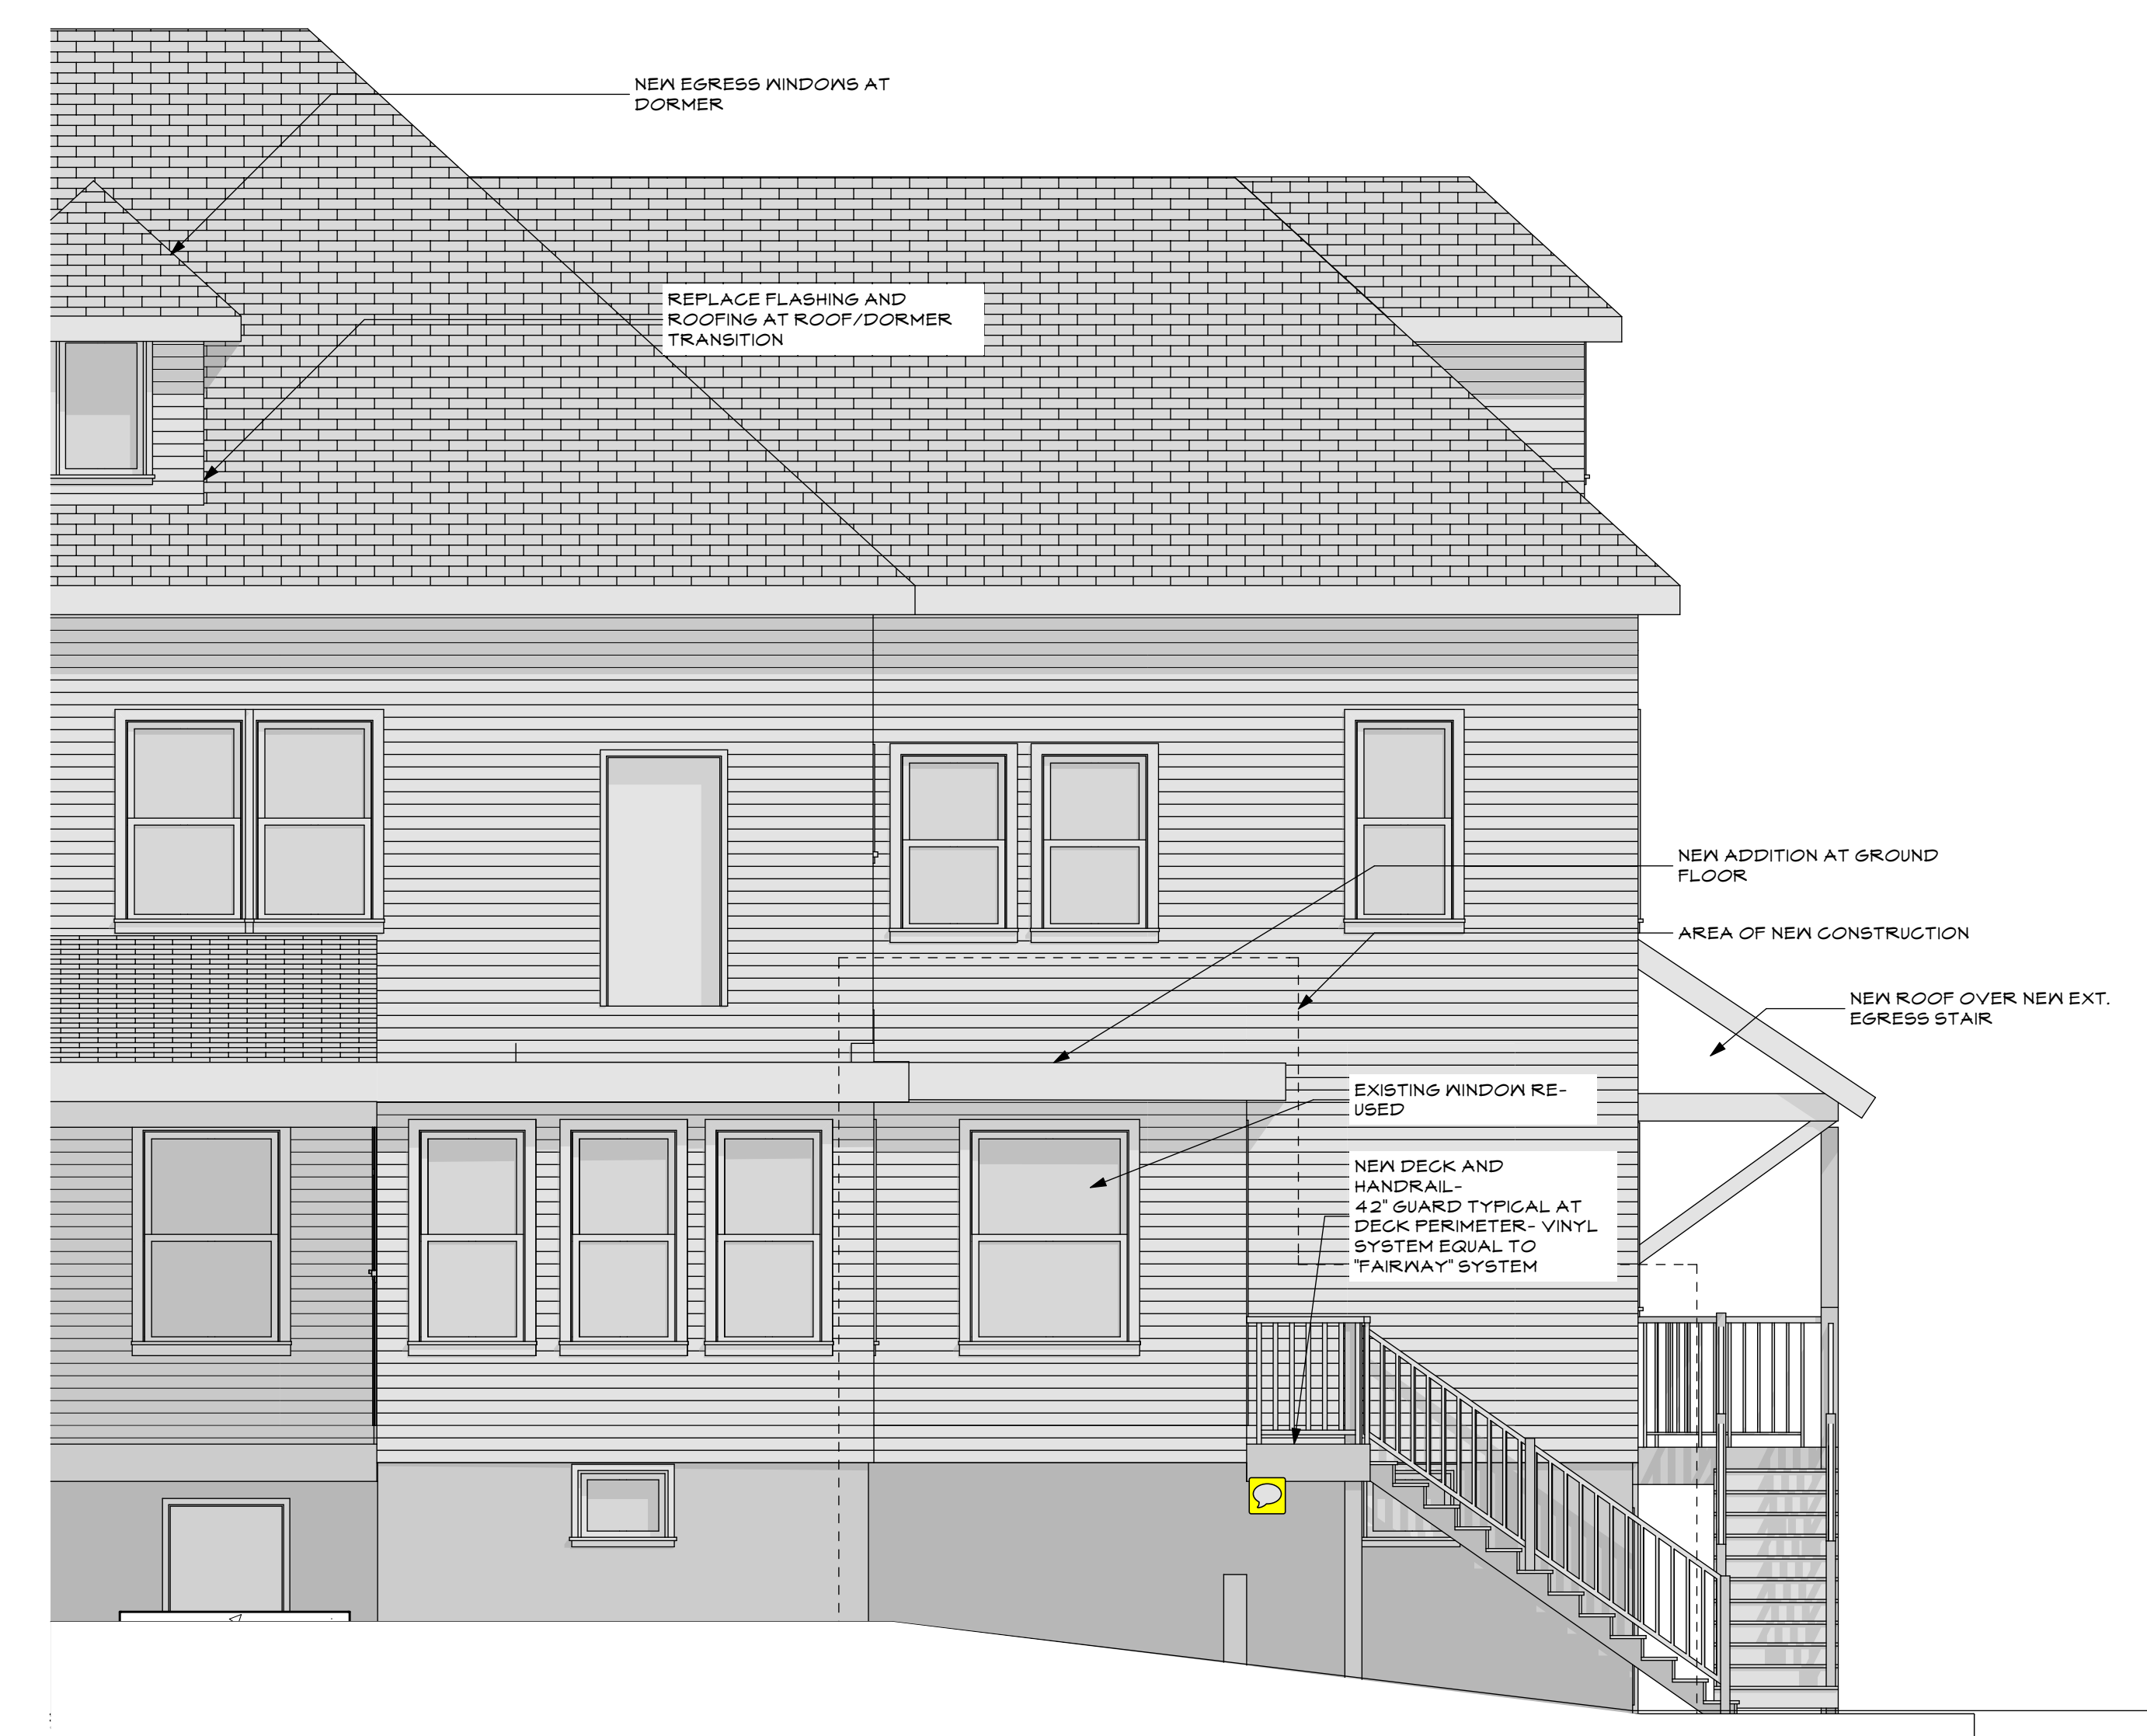

1 Sunrm. Add. & Open Deck
 SCALE: 1/4" = 1'-0"

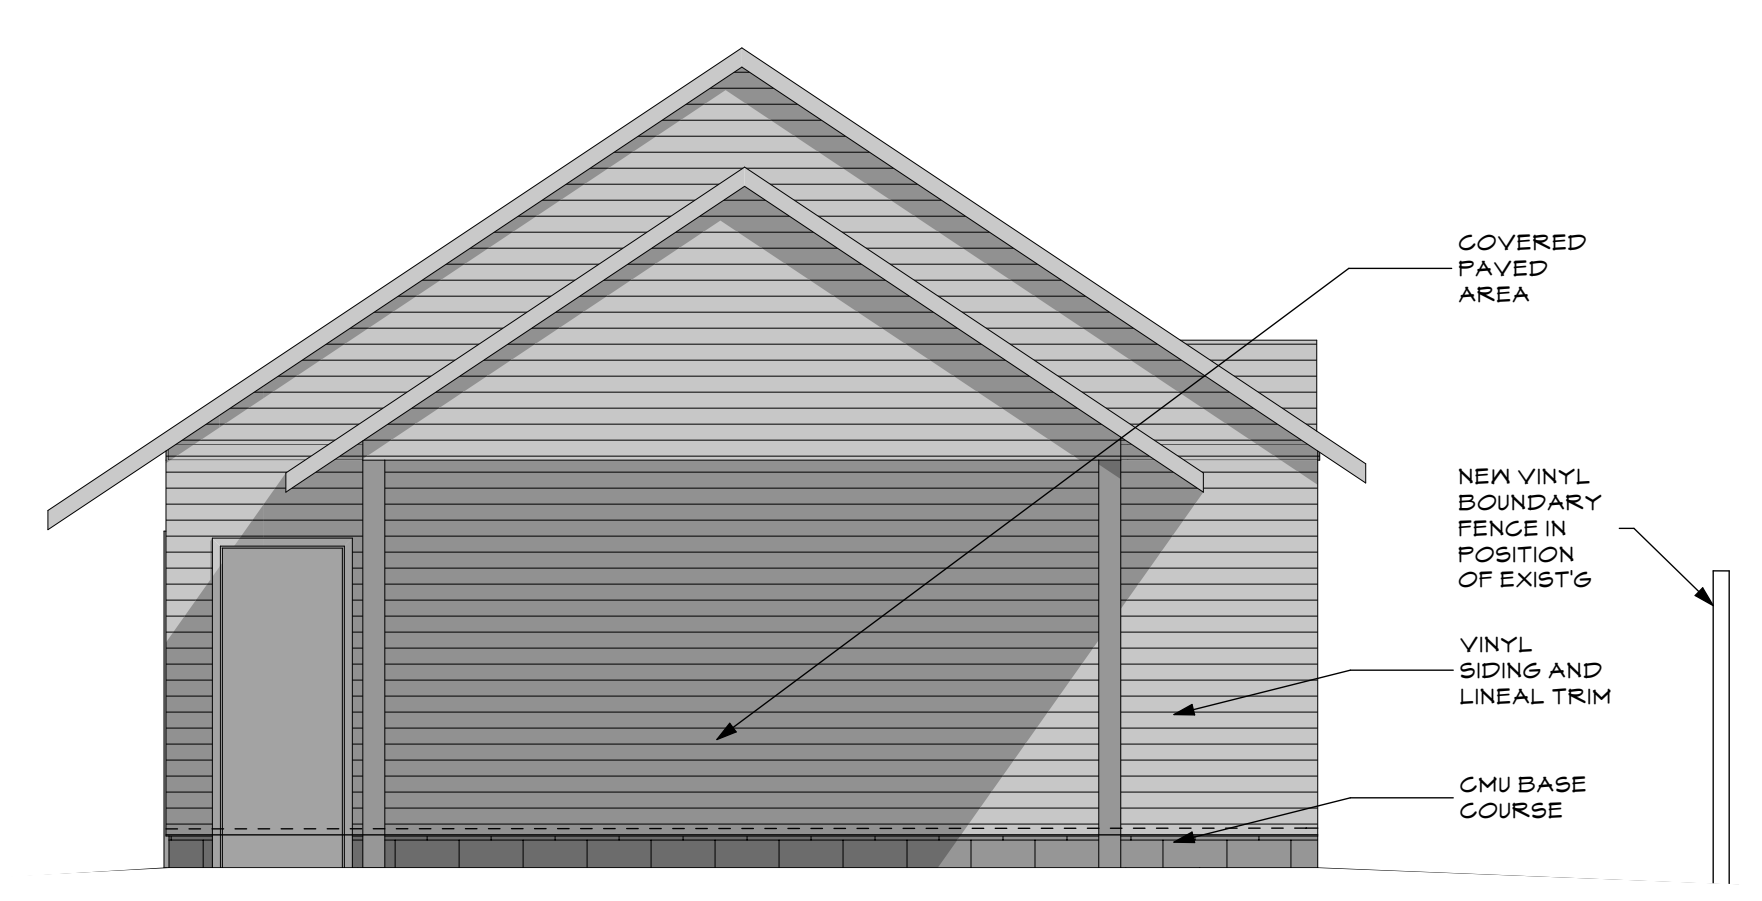

1 Sunroom Elevation
 SCALE: 1/4" = 1'-0"

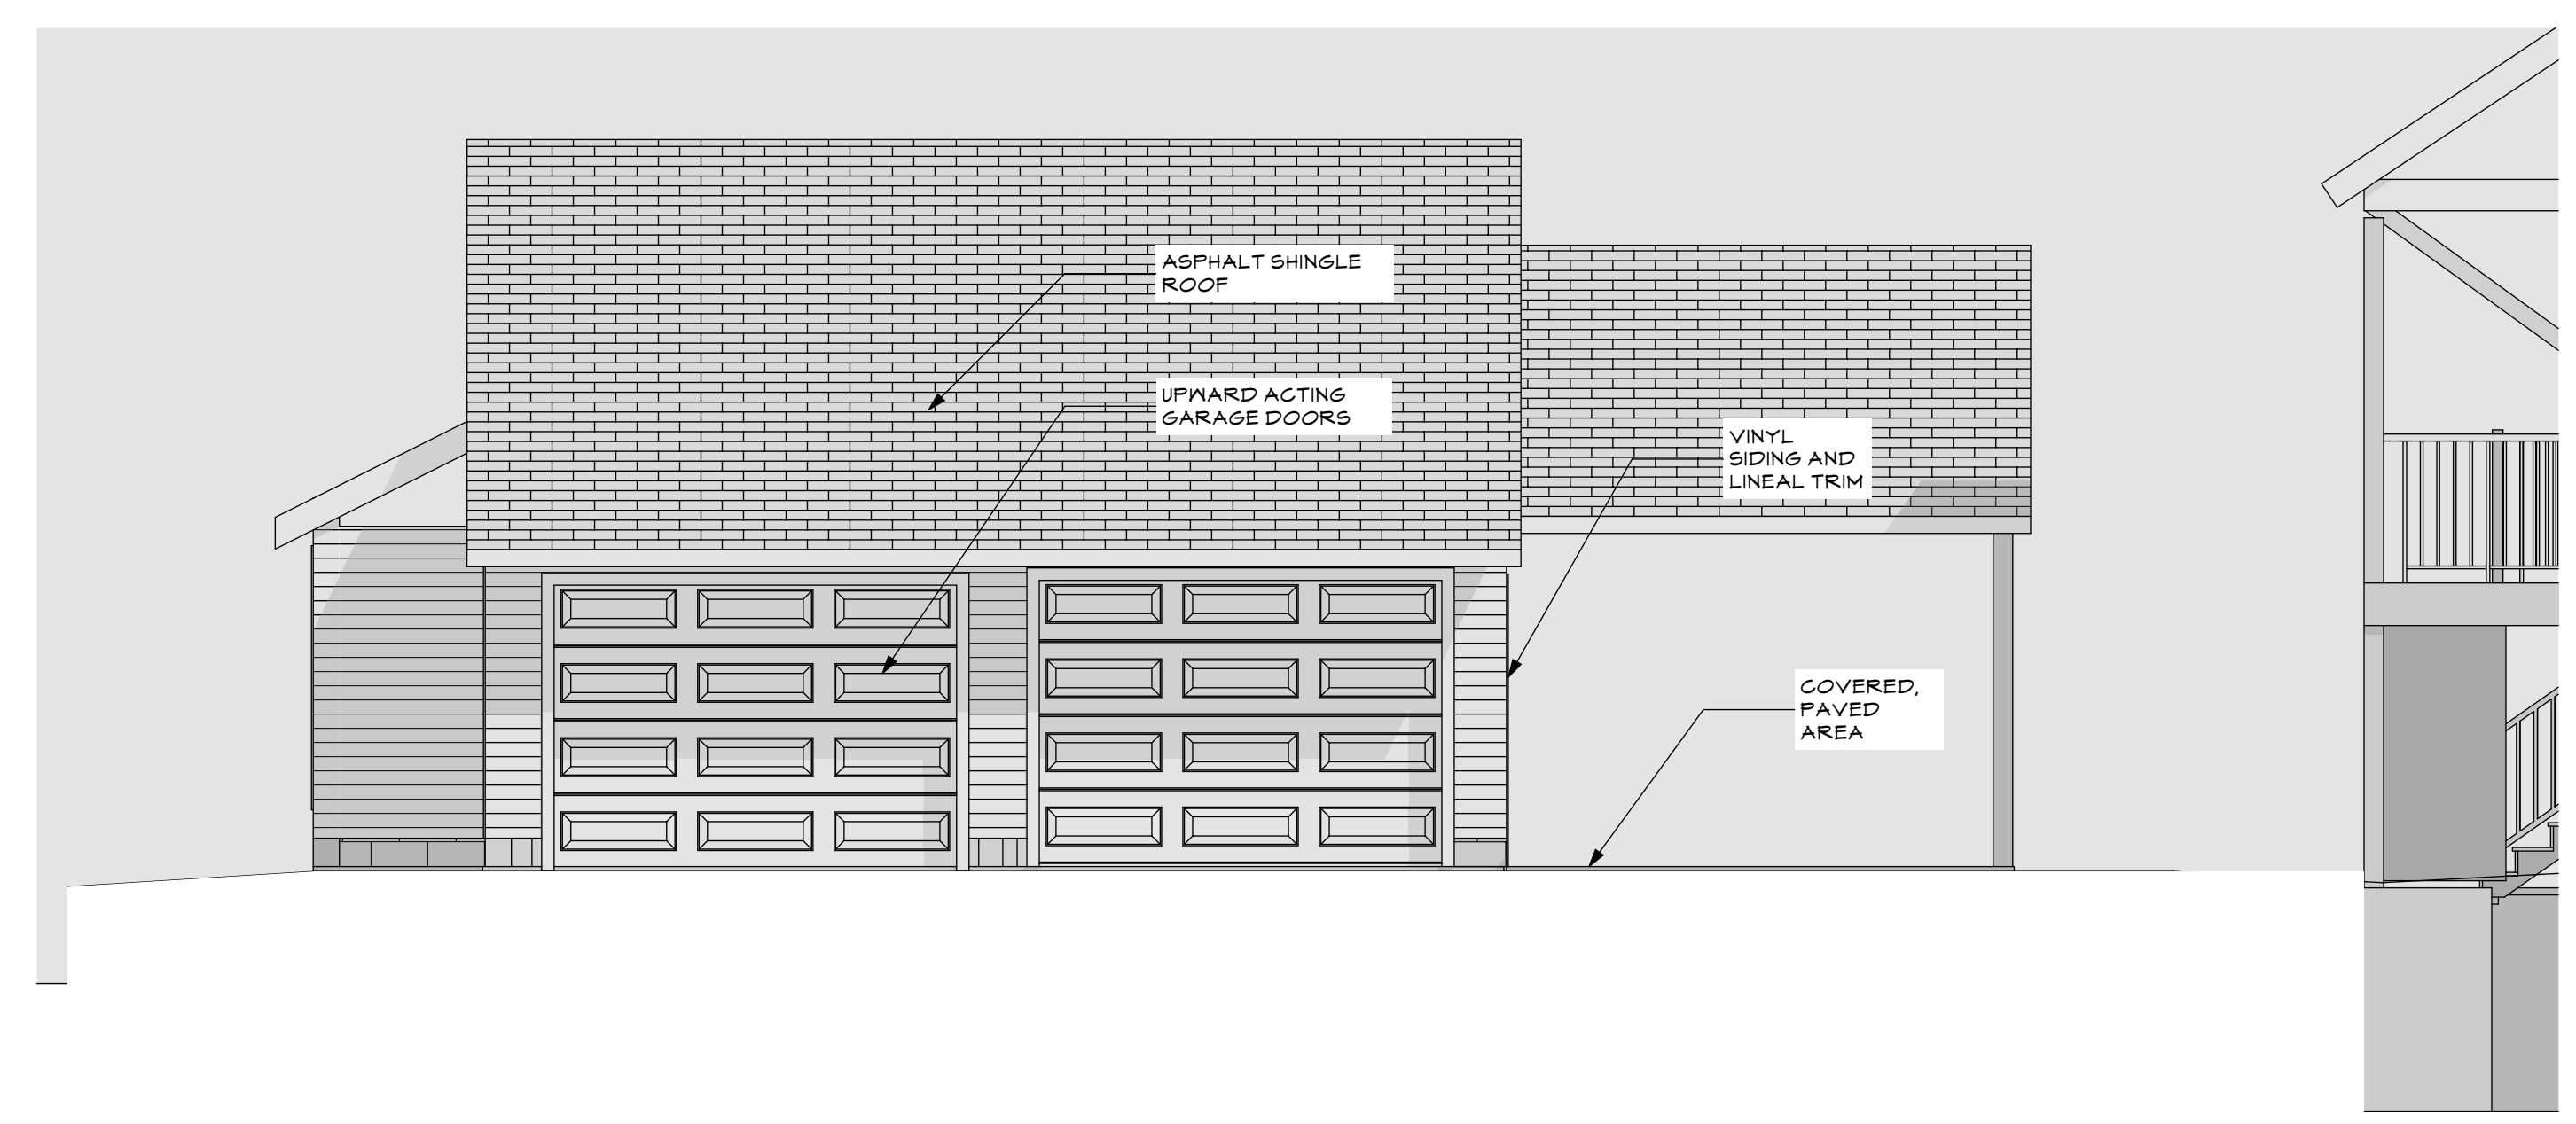


3 Garage/Screen Room
 SCALE: 1/4" = 1'-0"


THIS DRAWING IS AN INSTRUMENT OF SERVICE AND SHALL REMAIN THE PROPERTY OF WHIPPLE CALLENDER ARCHITECTS. IT SHALL NOT BE USED FOR ANY OTHER PURPOSE THAT FOR WHICH IT IS SPECIFICALLY FURNISHED.

SPRINKLER SYSTEM NOTES


1. COMPLY WITH REQUIREMENTS OF A 1BR SYSTEM
2. REFER TO BUILDING SECTION NOTES FOR MORE INFO.
3. BUDGET WITH A 4" SPRINKLER SERVICE.
4. PROVIDE A BUDGET FOR ADDITIONAL EQUIPMENT SHOULD STREET SERVICE PROVE INADEQUATE.
5. INFO. FROM PWD INDICATES AN EXISTING 6" SERVICE WITH A PRESSURE OF 54 PSI AND 978 TEST FLOW.

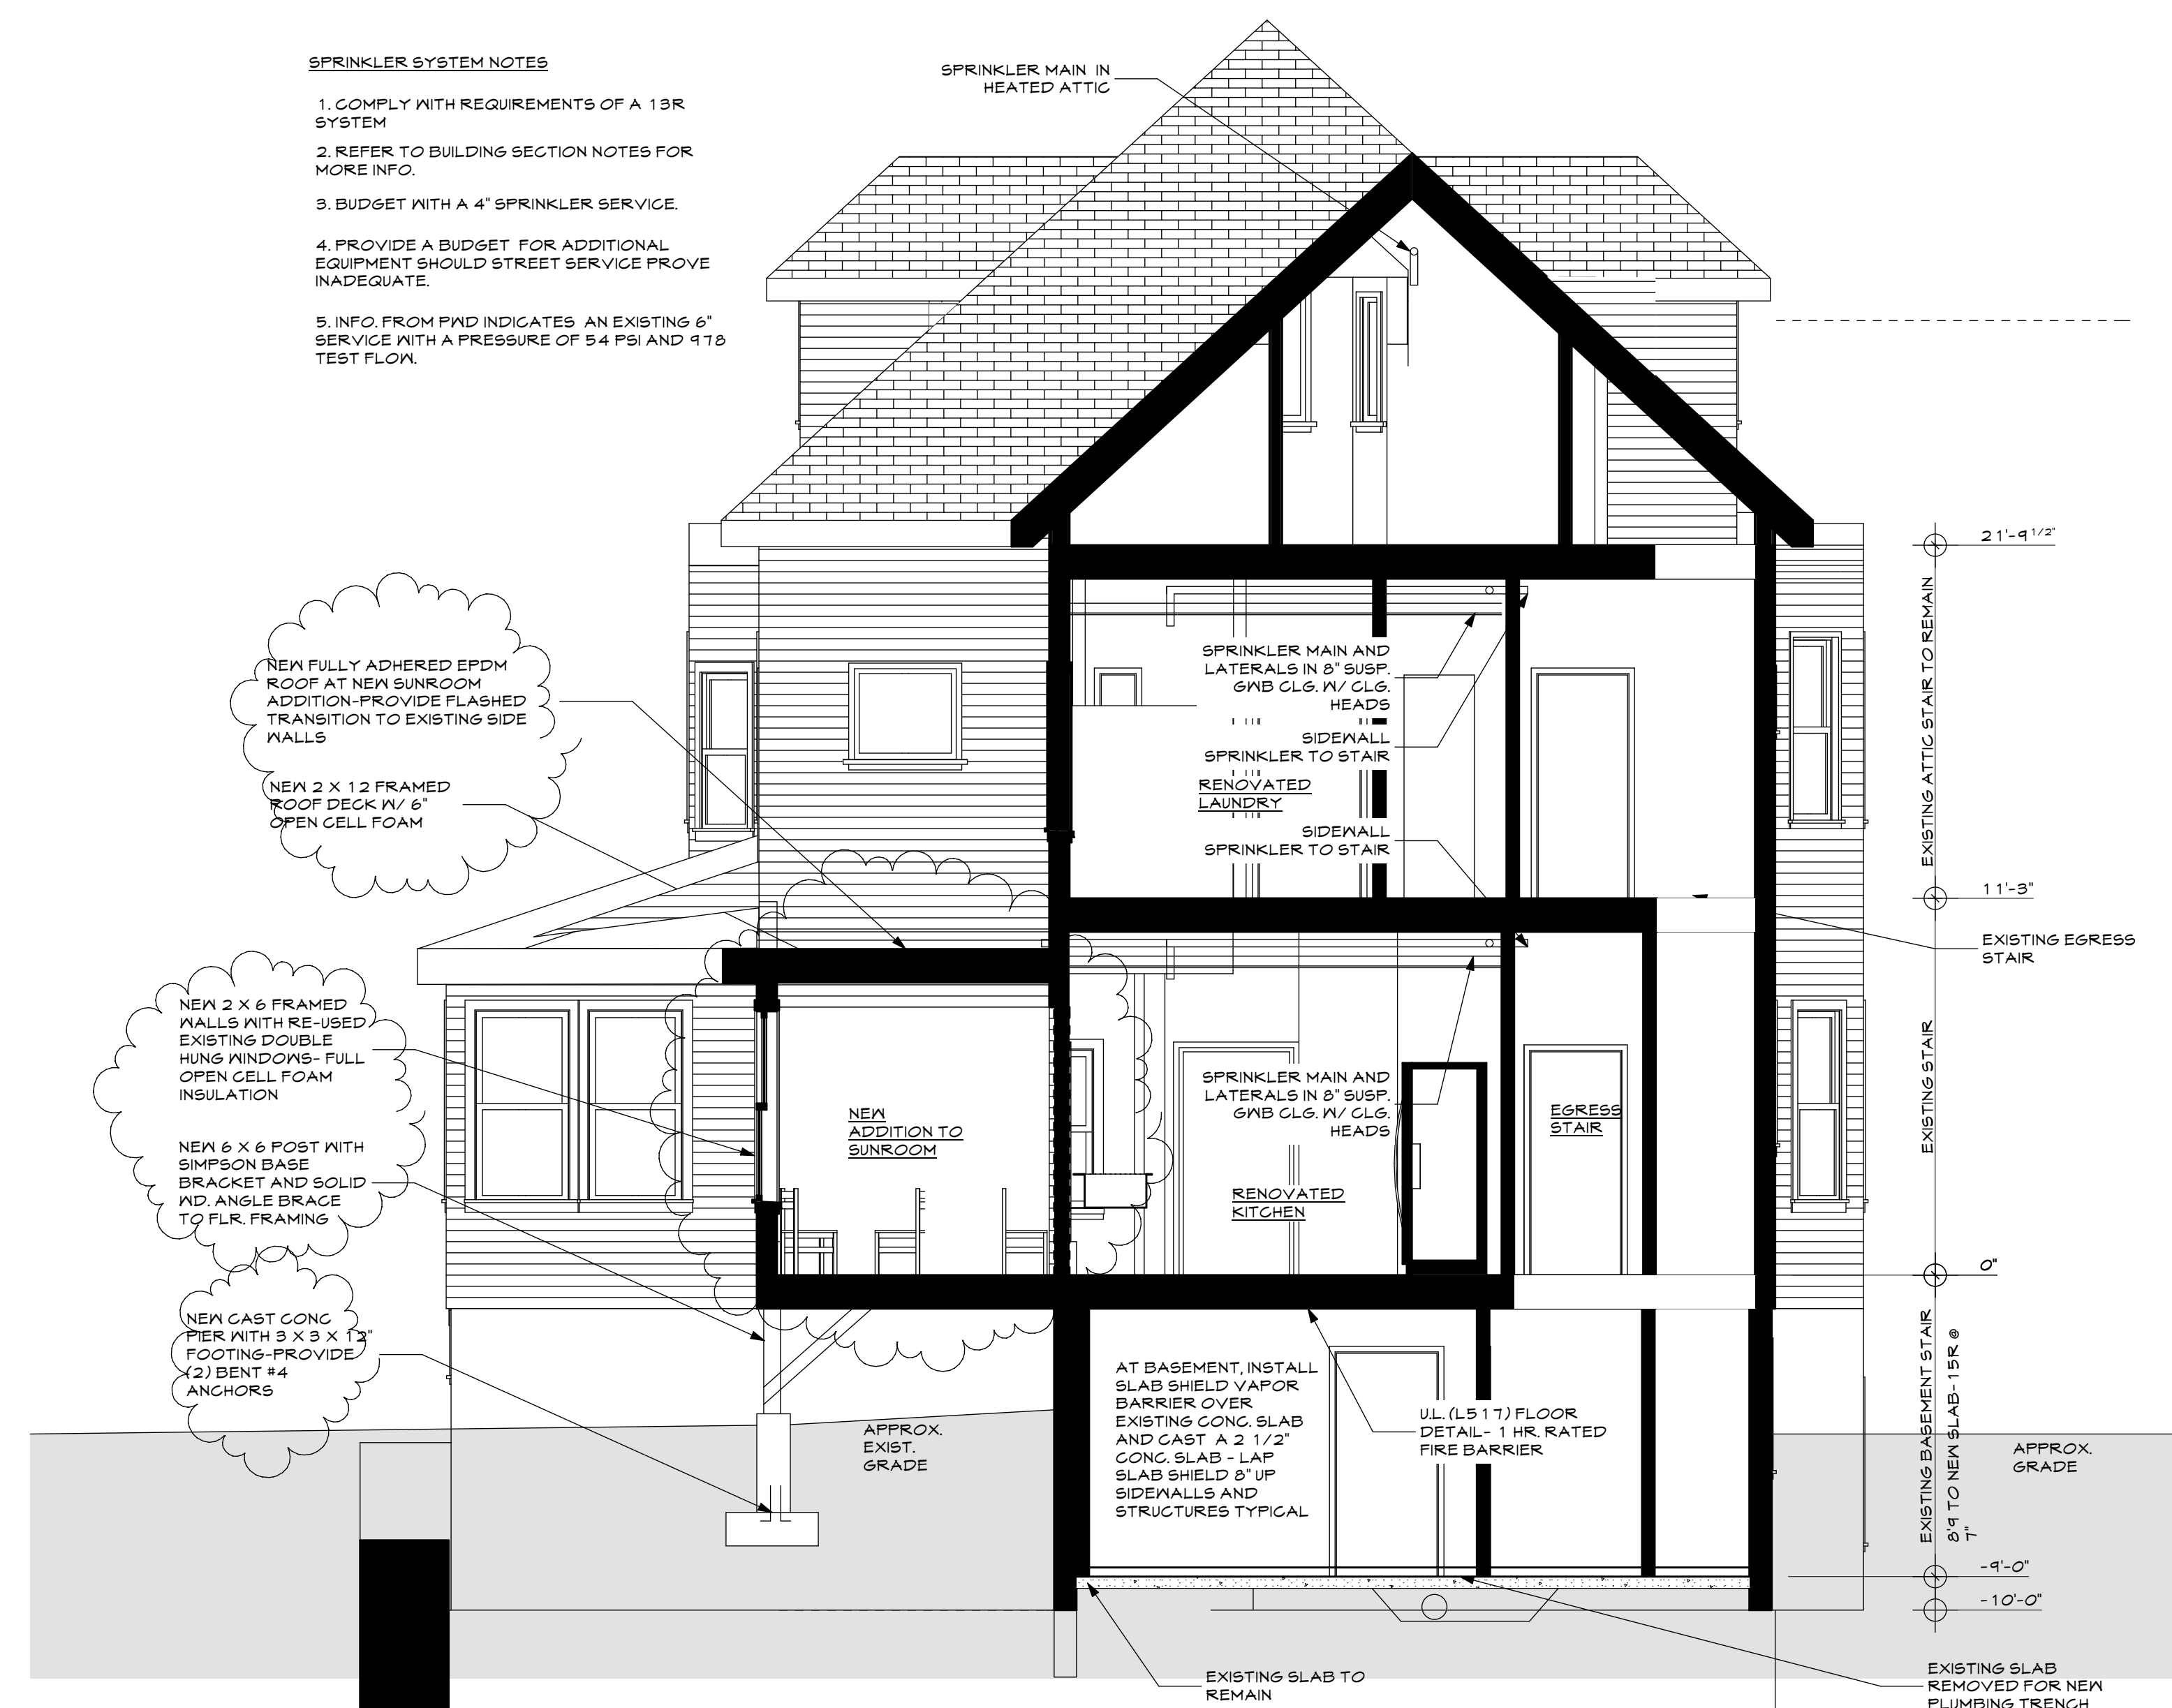

2 Building Section B
SCALE: 1/4" = 1'-0"

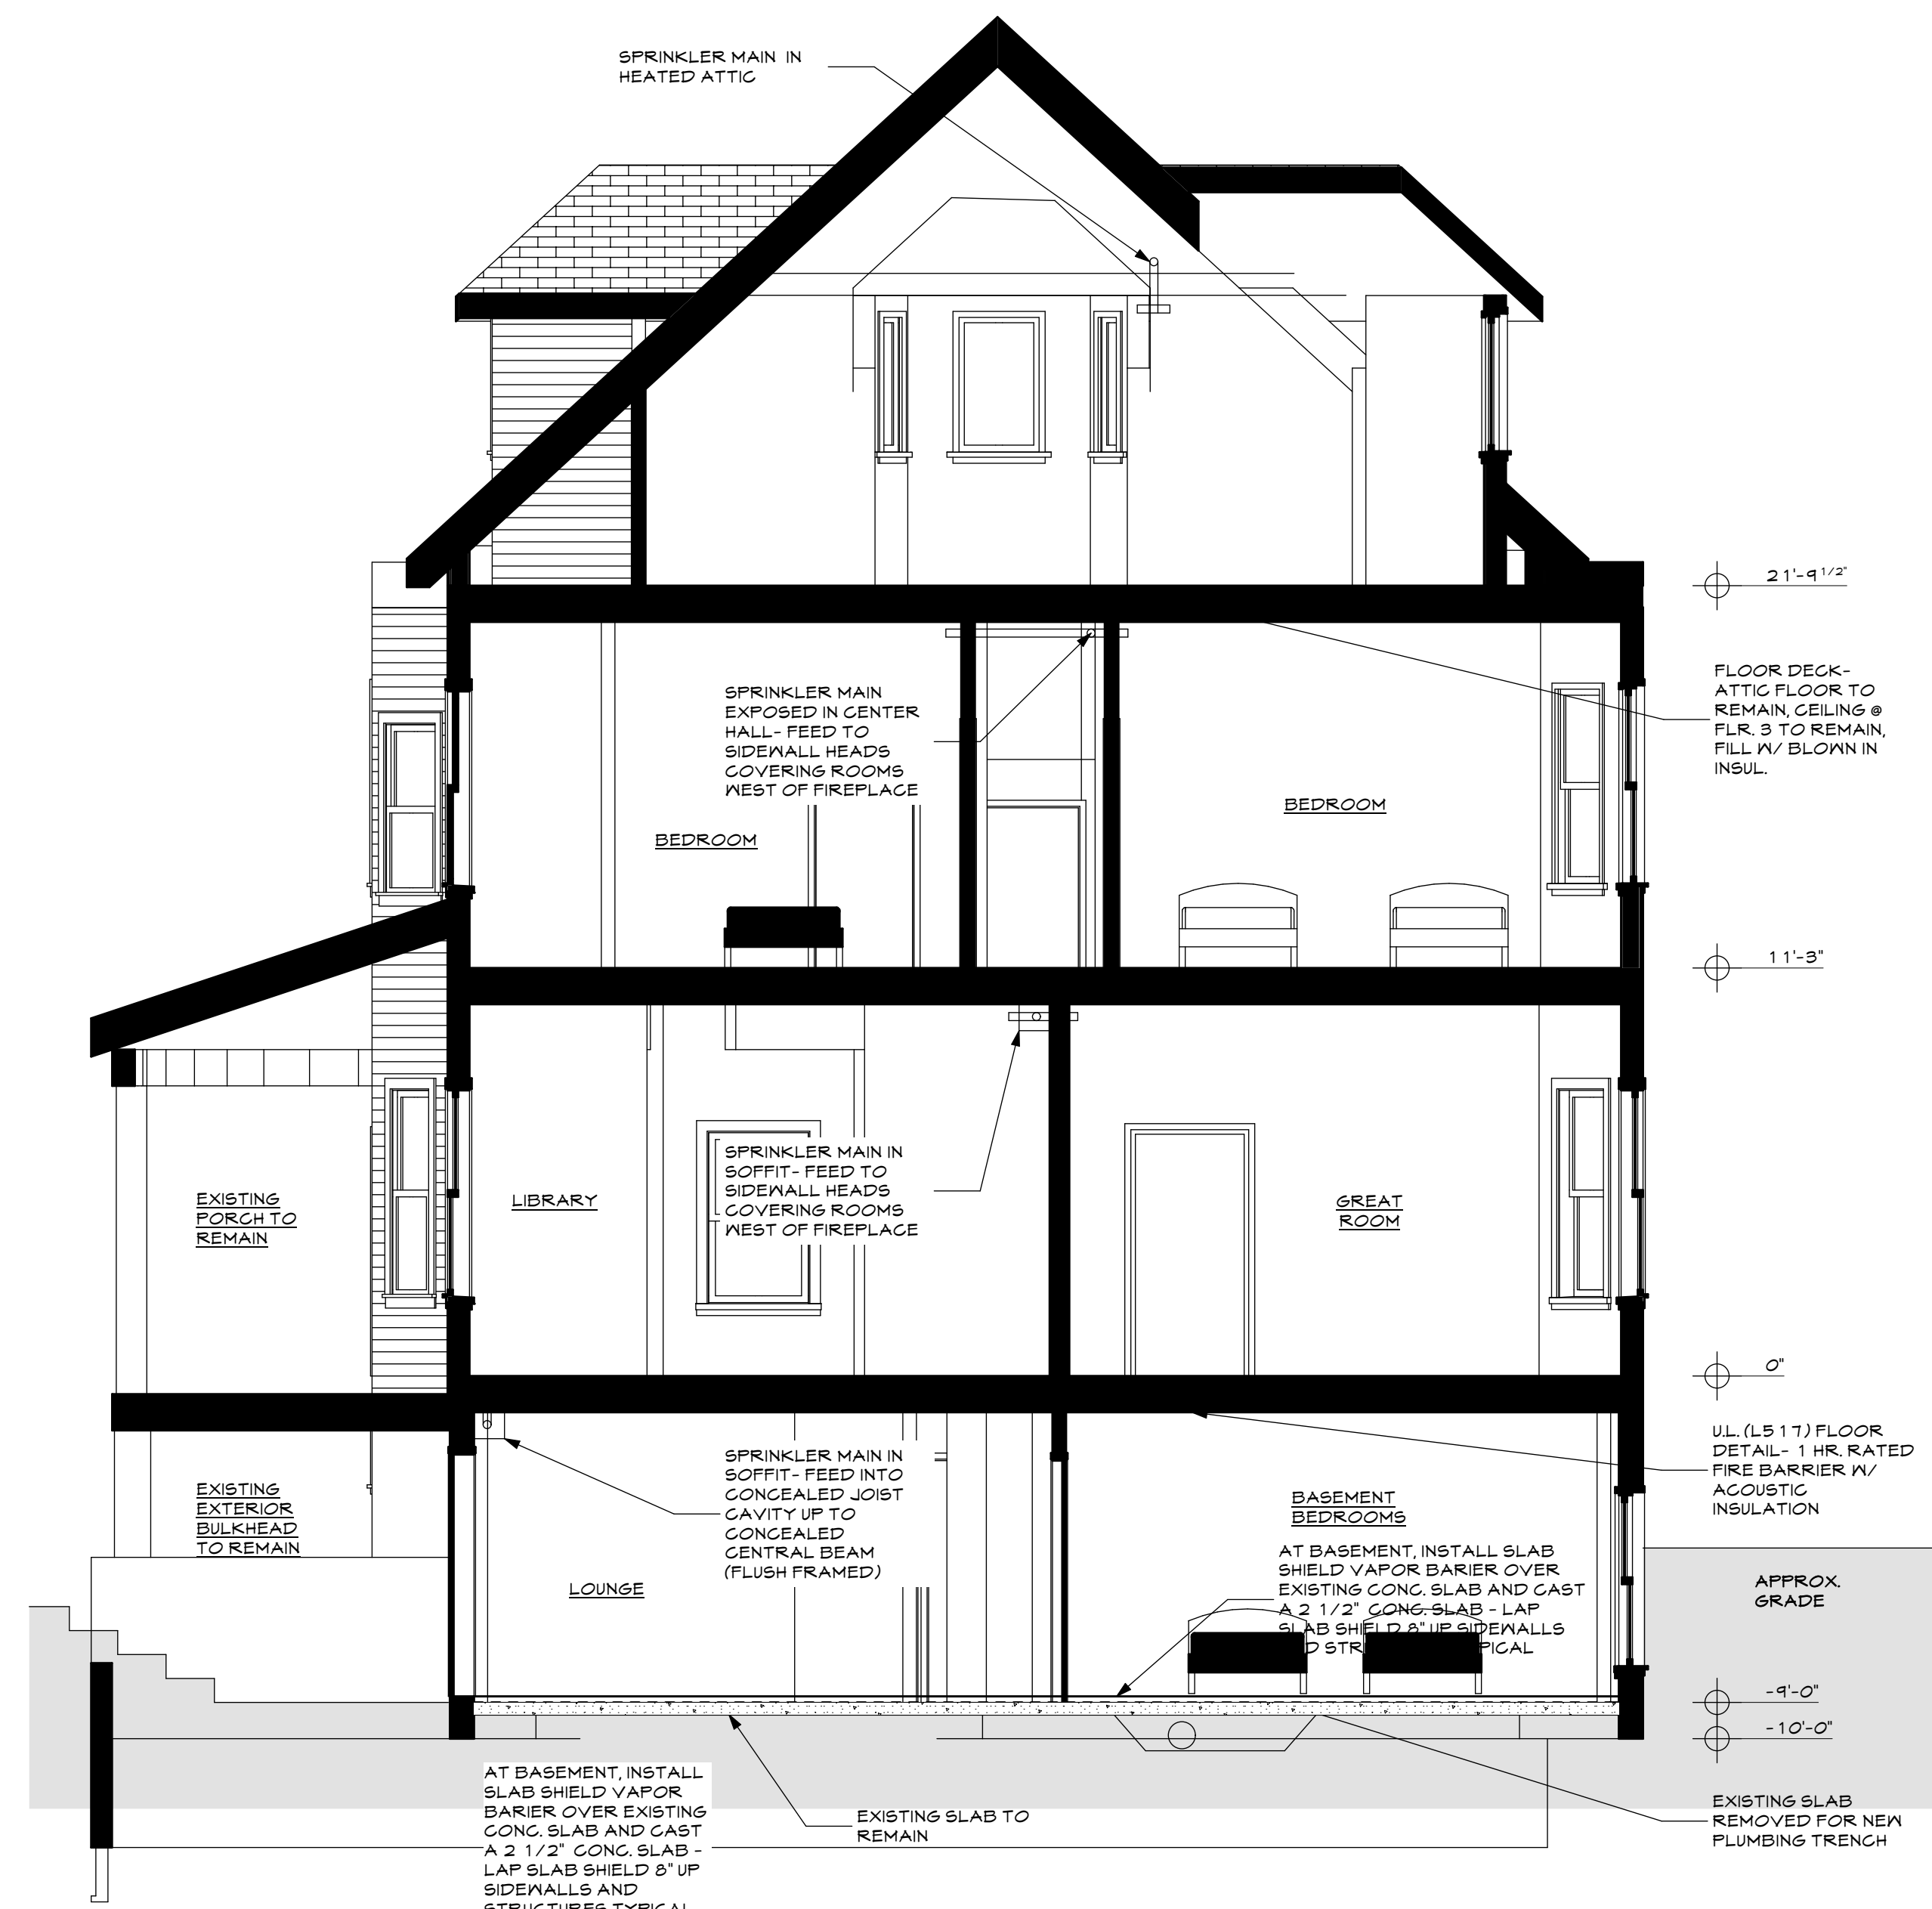


1 Building Section A
SCALE: 1/4" = 1'-0"

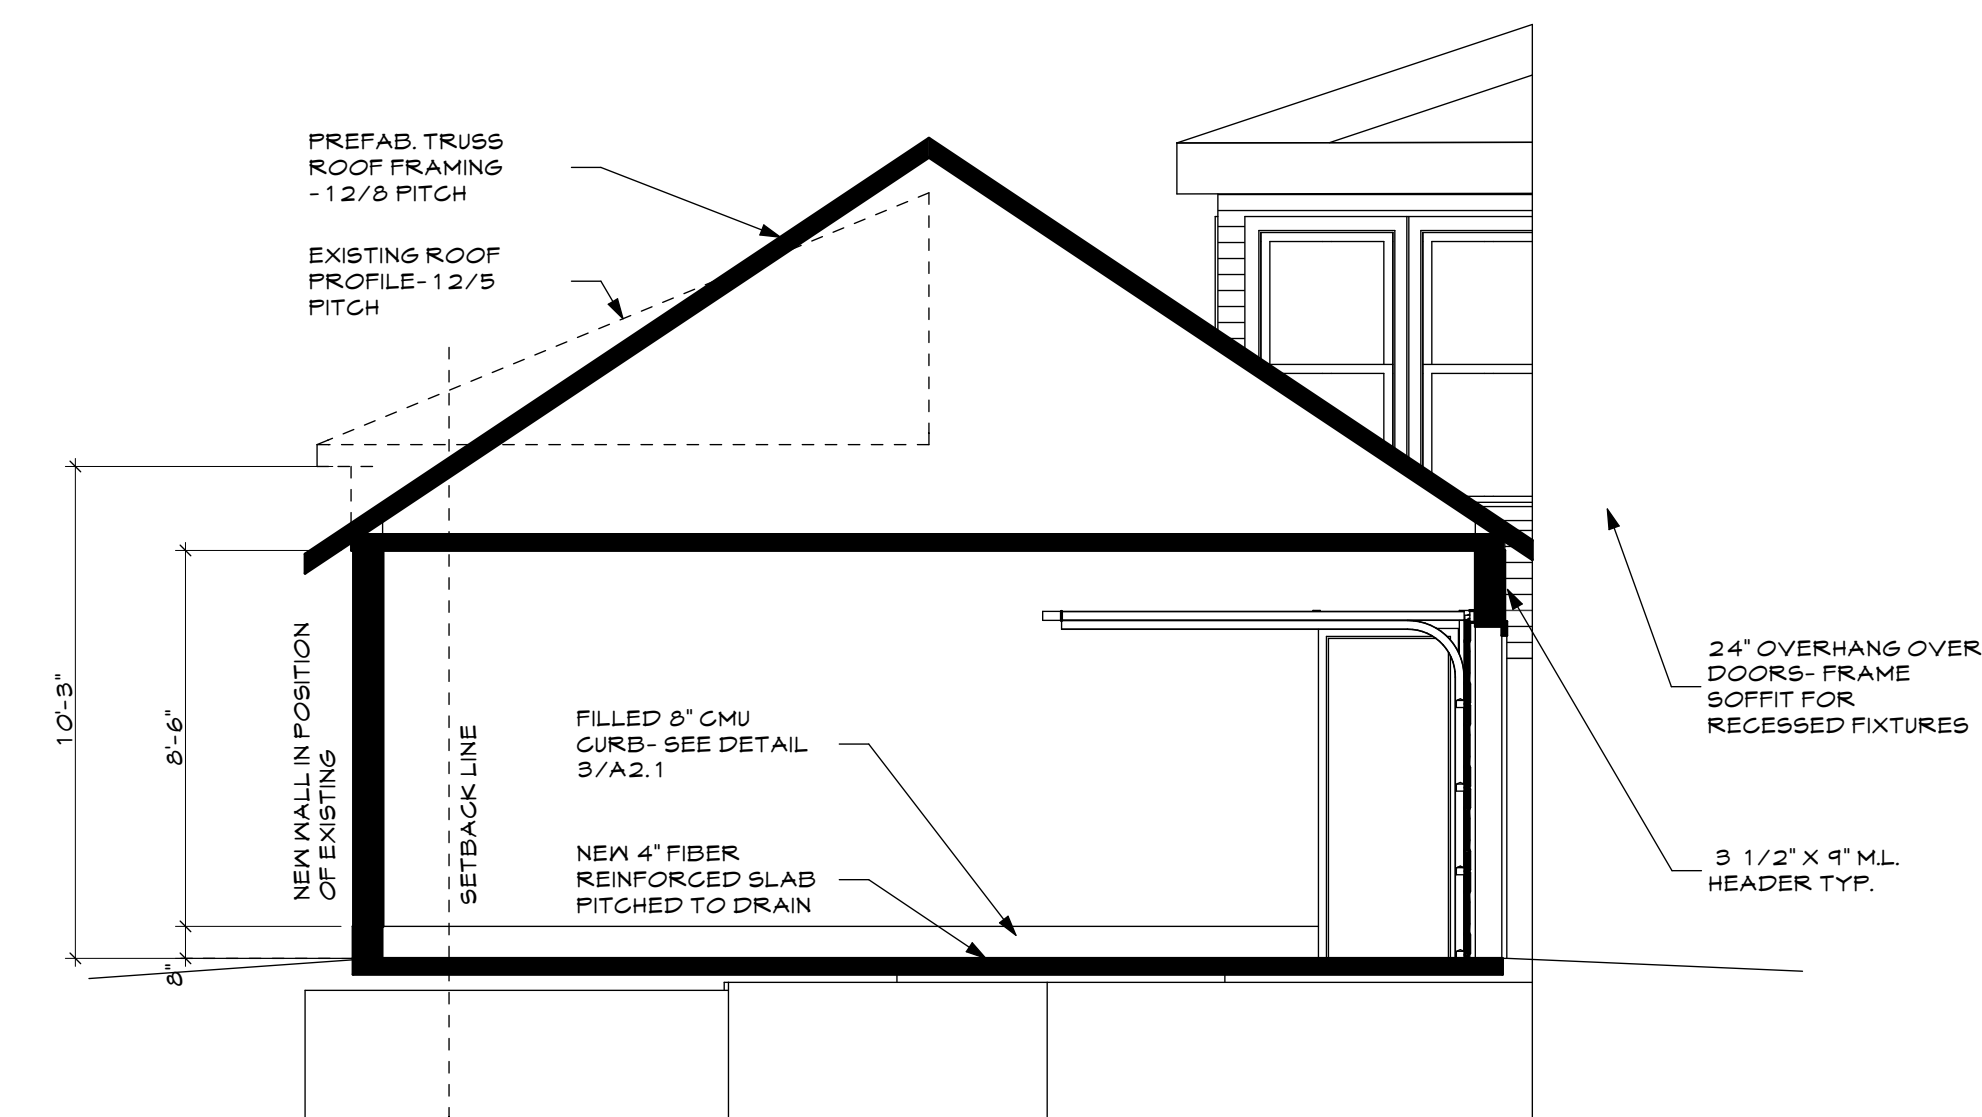


3 Building Section C
SCALE: 1/4" = 1'-0"

Plymouth House
145 Glenwood Avenue
Portland, MAINE

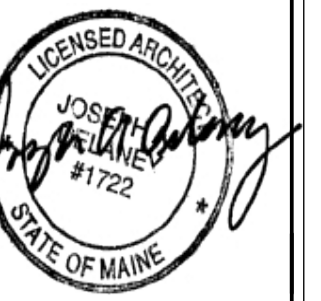

WHIPPLE - CALLENDER ARCHITECTS

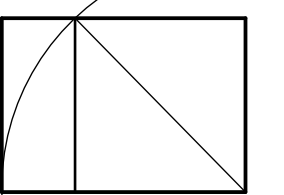


136 PLEASANT AVE.
PORTLAND, ME 04103
P 207.115.2646
F 207.115.5631
www.whipplecallender.com


| DATE | DESCRIPTION |
|------|-------------|
| | |
| | |
DATE: 3.7.13 - REV. PERMIT
CHECKED BY: JAD
DRAWN BY: JAD
JOB: 01-2013
SHEET TITLE: BLDG. SECTIONS



A3.1

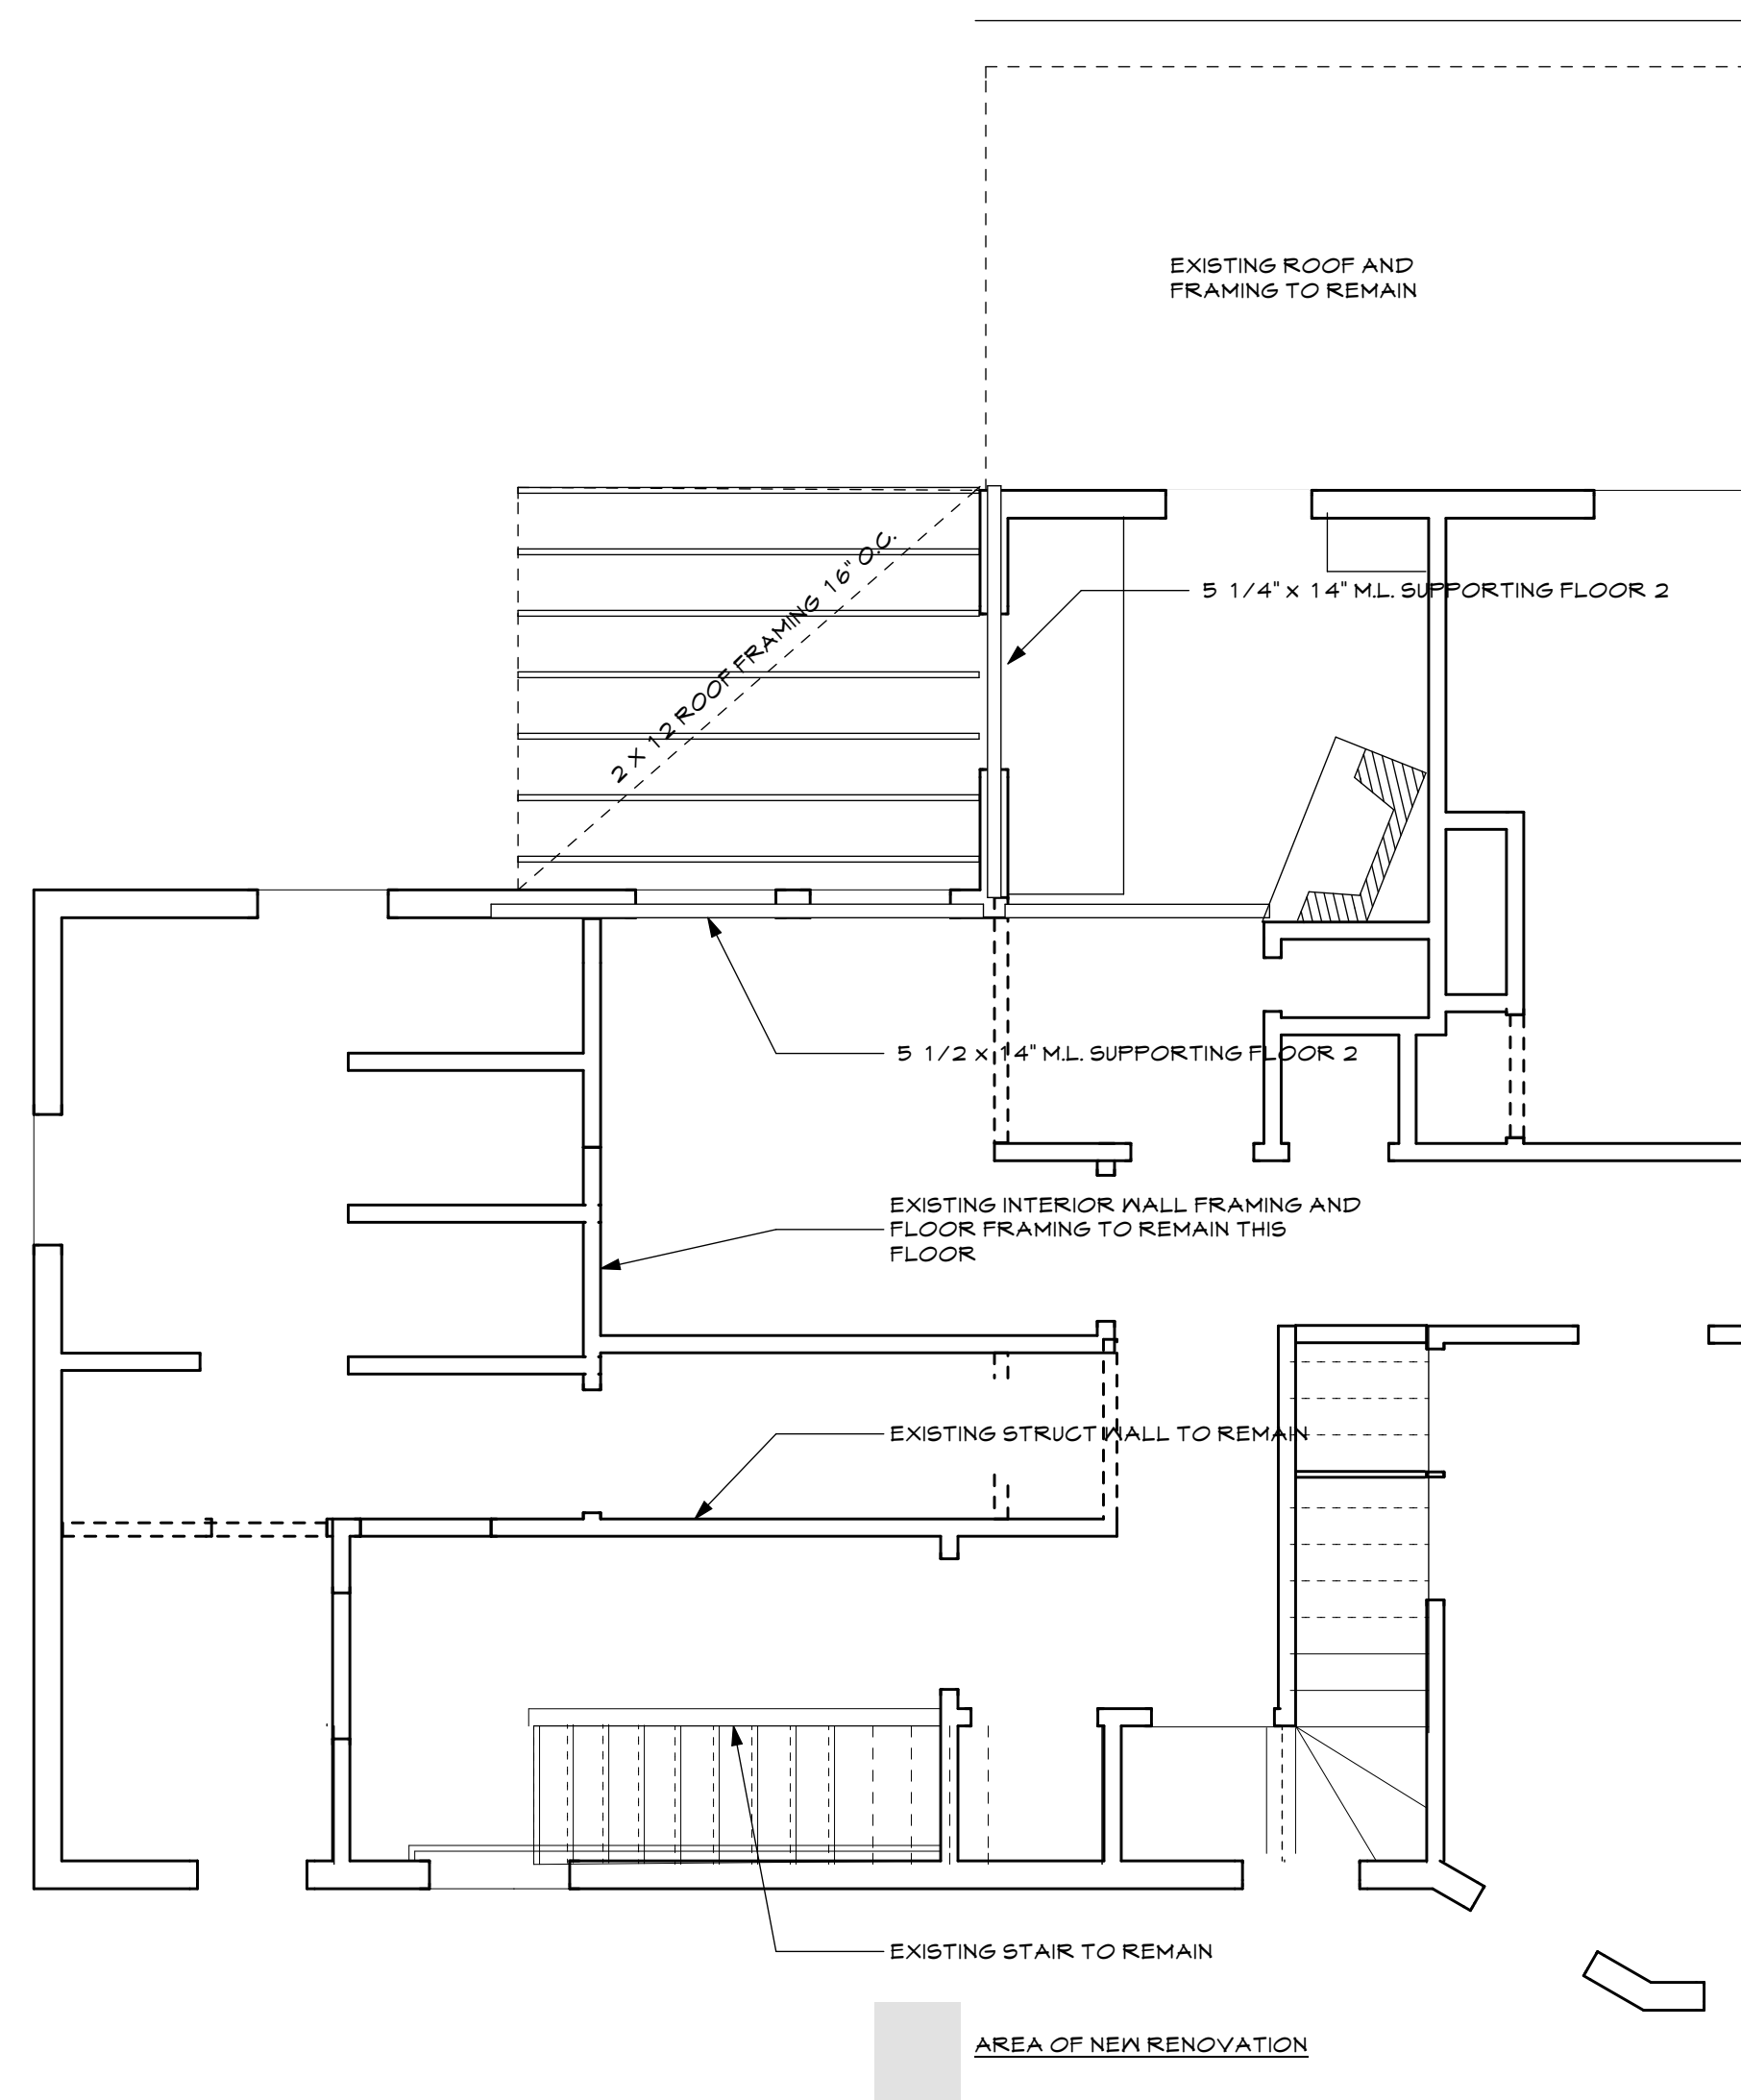

2 Second Floor Framing Plan
 A5.1 SCALE: 1/4" = 1'-0"

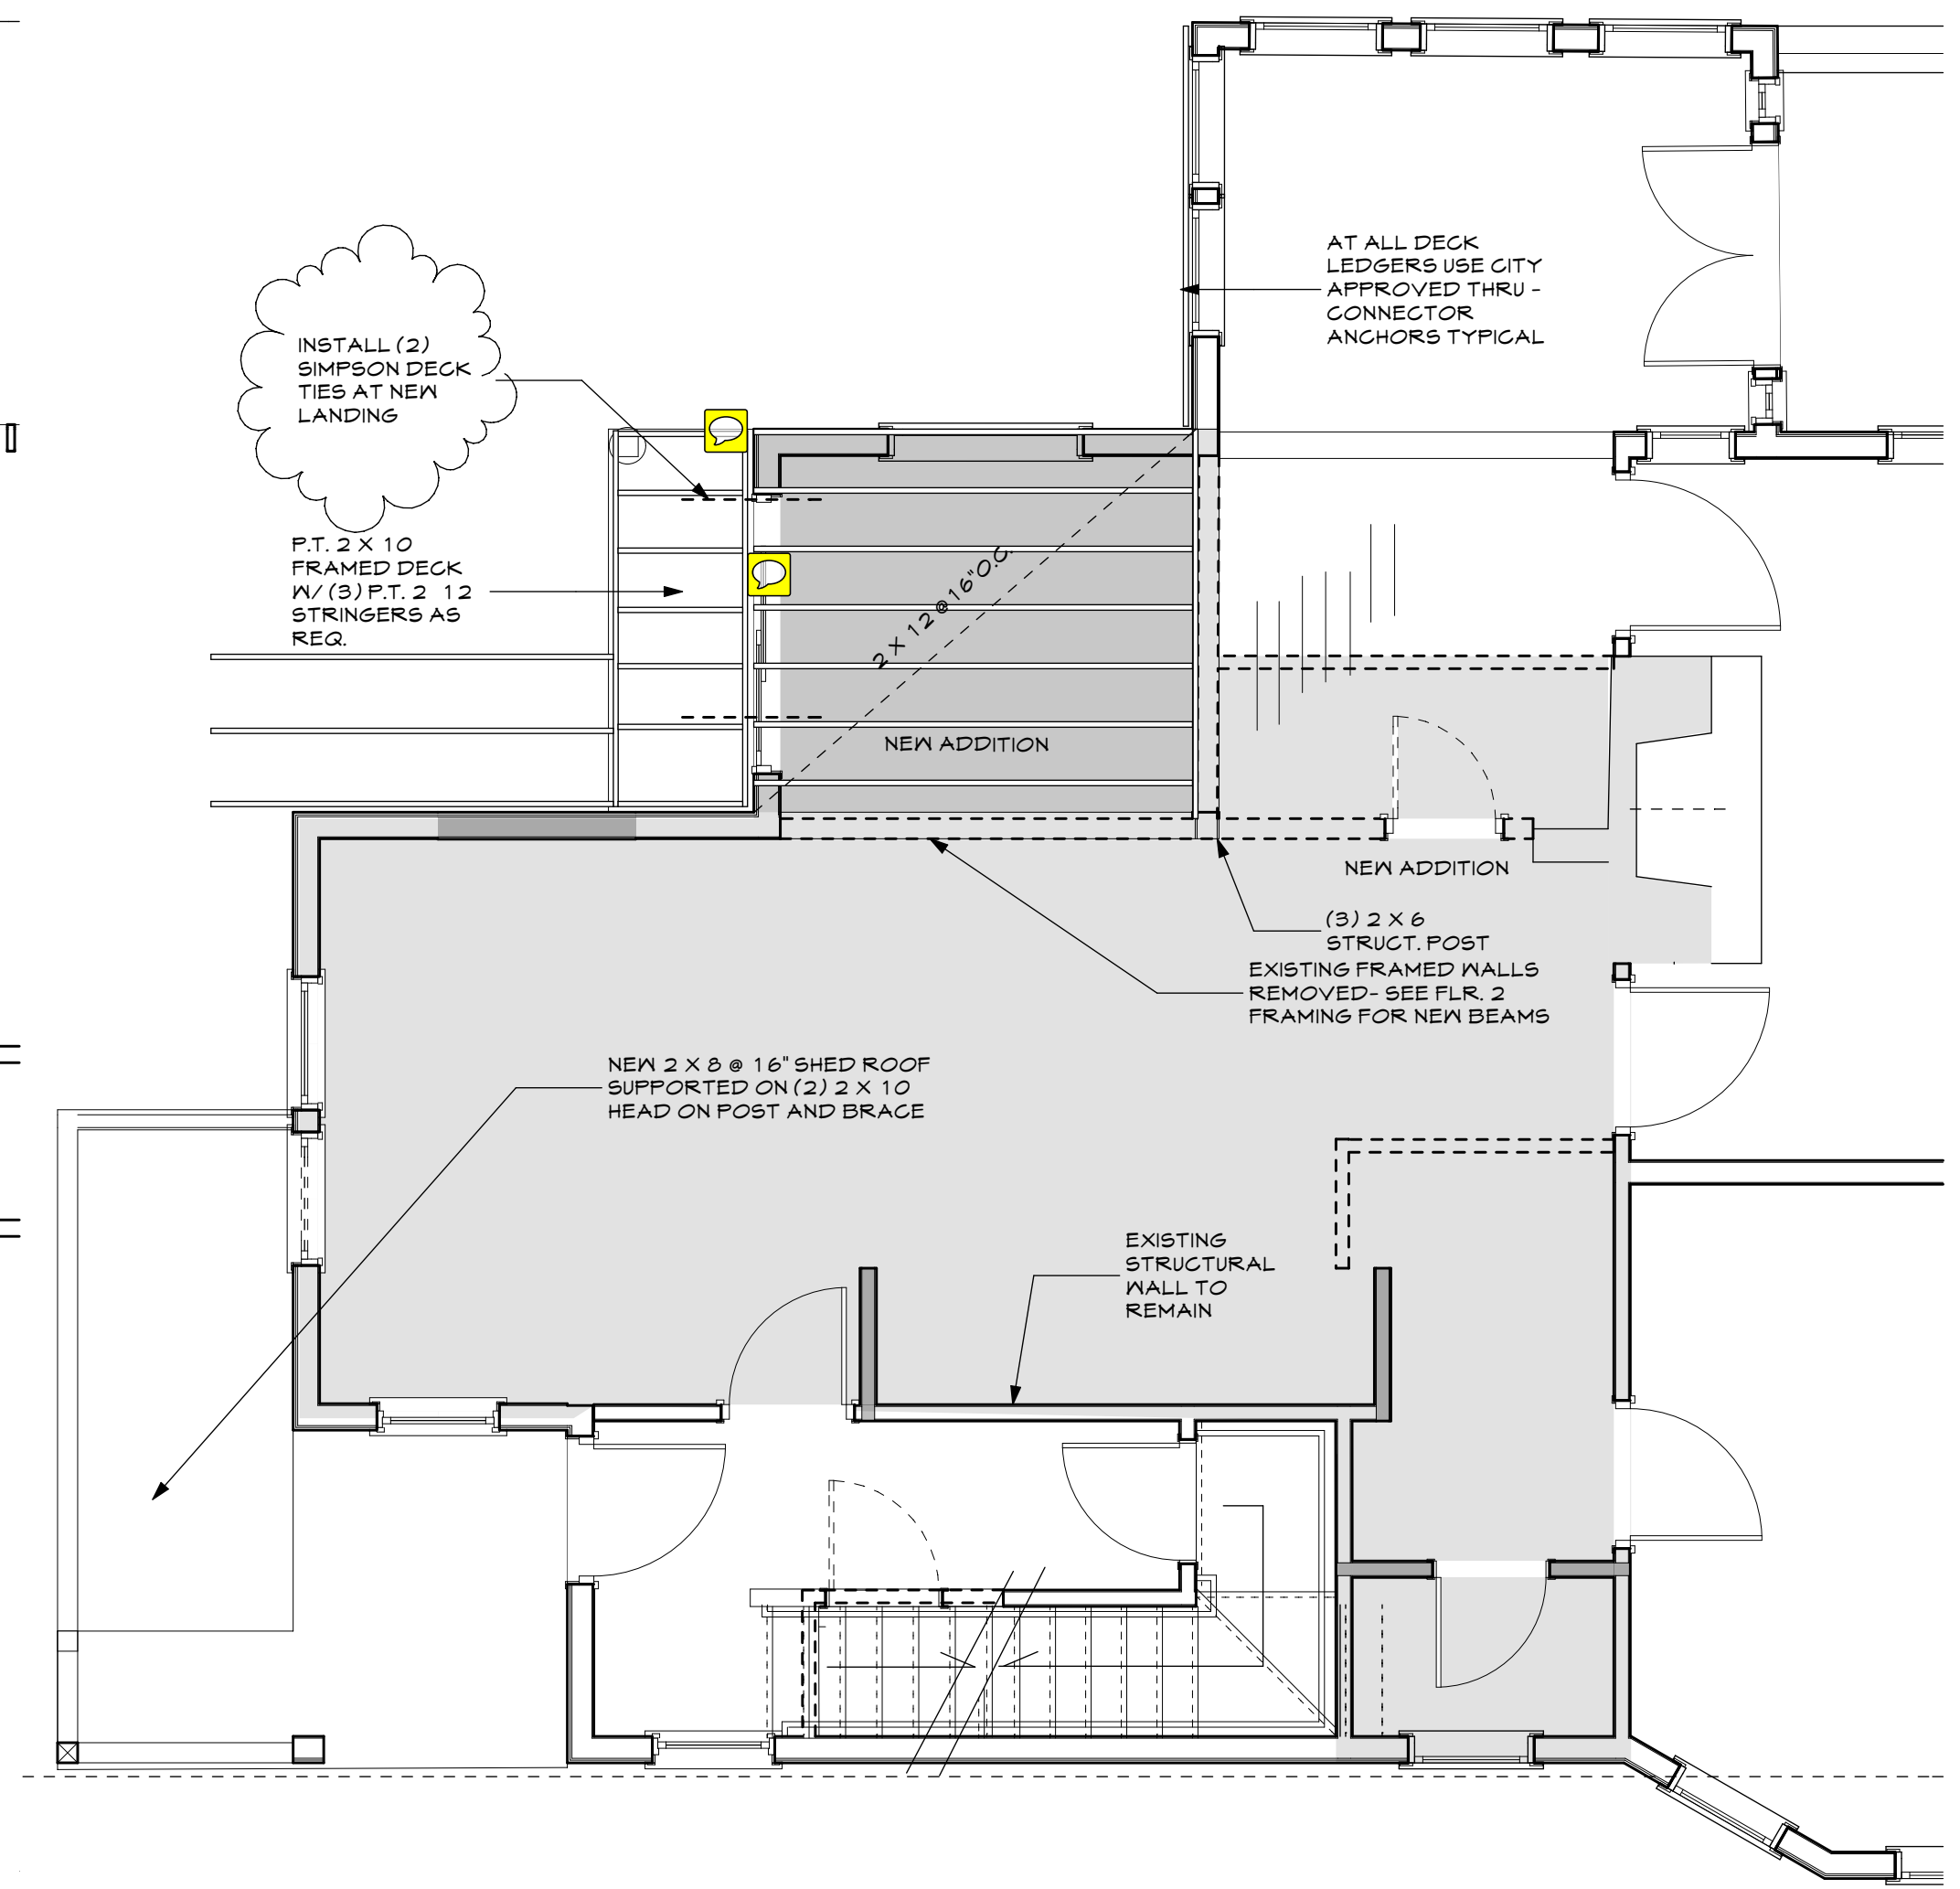

1 First Floor Framing Plan
 A5.1 SCALE: 1/4" = 1'-0"

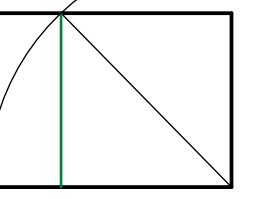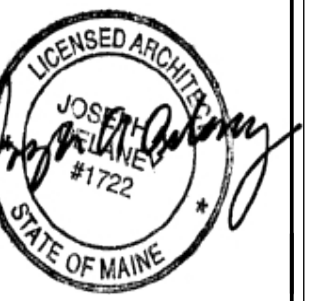


| DESCRIPTION | DATE | MARK |
|-------------|------|------|
| | | |
| | | |
| | | |
| | | |

| | |
|--------------|--------------------|
| DATE: | 3.7.13-REV. PERMIT |
| CHECKED BY: | JAD |
| DRAWN BY: | JAD |
| JOB: | 01-2013 |
| SHEET TITLE: | STRUCTURAL DETAILS |


| FINISH SCHEDULE | | | | | | |
|-----------------|--------------------------|-------------------------|-----------------------|------------------------|---|-----------------------|
| ROOM NO./NAME | FLOOR | WALLS | BASE | CEILING | NOTES/REMARKS | |
| B01-LOUNGE | CARPET TILE | PAINTED G&B | WOOD BASE | PAINTED G&B | NEW SEALED CONG. SLAB | |
| B02-MECH. | EXISTING CONG. SLAB | PAINTED FOAM INSULATION | NONE | PAINTED G&B | NEW SEALED CONG. SLAB | FIRE RATED FOAM PAINT |
| B03-OFFICE | CARPET TILE | PAINTED G&B | WOOD BASE | PAINTED G&B | NEW SEALED CONG. SLAB | |
| B04-HALL | CARPET TILE | PAINTED G&B | WOOD BASE | PAINTED G&B | NEW SEALED CONG. SLAB | |
| B05-FURNAGE | EXISTING CONG. SLAB | PAINTED FOAM INSULATION | NONE | PAINTED G&B | NEW SEALED CONG. SLAB | FIRE RATED FOAM PAINT |
| B06-BED | CARPET TILE | PAINTED G&B | WOOD BASE | PAINTED G&B | NEW SEALED CONG. SLAB | |
| B07-BATH | WELDED SEAM VINYL SHEET | PAINTED G&B | INTEGRAL COVE | PAINTED G&B | NEW SEALED CONG. SLAB | |
| B08-LAUNDRY | WELDED SEAM VINYL SHEET | FRP PANEL | INTEGRAL COVE | PAINTED G&B | NEW SEALED CONG. SLAB | |
| B09-EGRESS | WELDED SEAM VINYL SHEET | PAINTED G&B | INTEGRAL COVE | PAINTED G&B | NEW SEALED CONG. SLAB | |
| B10-LOUNGE | CARPET TILE | PAINTED G&B | WOOD BASE | PAINTED G&B | NEW SEALED CONG. SLAB | |
| 101-KITCHEN | VINYL SHEET GOODS | PAINTED G&B | WOOD BASE | PAINTED G&B | | |
| 102-SUNRM. | EXISTING WD. RE-FINISHED | EXIST. PLASTER PAINTED | EXIST. WD. REFINISHED | EXIST. PLASTER PAINTED | NEW TRIM/ G&B AT SUNROOM ADDITION | |
| 103-GREAT RM. | EXISTING WD. RE-FINISHED | EXIST. PLASTER PAINTED | EXIST. WD. REFINISHED | EXIST. PLASTER PAINTED | | |
| 104-MTG.RM. | EXISTING WD. RE-FINISHED | EXIST. PLASTER PAINTED | EXIST. WD. REFINISHED | EXIST. PLASTER PAINTED | | |
| 105-ENTRY | EXISTING WD. RE-FINISHED | EXIST. PLASTER PAINTED | EXIST. WD. REFINISHED | EXIST. PLASTER PAINTED | | |
| 106-FOYER | EXISTING WD. RE-FINISHED | EXIST. PLASTER PAINTED | EXIST. WD. REFINISHED | EXIST. PLASTER PAINTED | | |
| 107-OFFICE | EXISTING WD. RE-FINISHED | EXIST. PLASTER PAINTED | EXIST. WD. REFINISHED | EXIST. PLASTER PAINTED | | |
| 108-1/2 BATH | VINYL SHEET GOODS | EXIST. PLASTER PAINTED | EXIST. WD. REFINISHED | EXIST. PLASTER PAINTED | | |
| 109-EGRESS STR. | | EXIST. PLASTER PAINTED | EXIST. WD. REFINISHED | PAINTED G&B | VINYL STAIR TREADS | |
| 201-BED | EXISTING WD. RE-FINISHED | EXIST. PLASTER PAINTED | EXIST. WD. REFINISHED | EXIST. PLASTER PAINTED | | |
| 202-BED | EXISTING WD. RE-FINISHED | EXIST. PLASTER PAINTED | EXIST. WD. REFINISHED | EXIST. PLASTER PAINTED | | |
| 203-BED | EXISTING WD. RE-FINISHED | EXIST. PLASTER PAINTED | EXIST. WD. REFINISHED | EXIST. PLASTER PAINTED | | |
| 204-BED | EXISTING WD. RE-FINISHED | EXIST. PLASTER PAINTED | EXIST. WD. REFINISHED | EXIST. PLASTER PAINTED | | |
| 205-BED | EXISTING WD. RE-FINISHED | EXIST. PLASTER PAINTED | EXIST. WD. REFINISHED | EXIST. PLASTER PAINTED | | |
| 206-COMMON | EXISTING WD. RE-FINISHED | EXIST. PLASTER PAINTED | EXIST. WD. REFINISHED | EXIST. PLASTER PAINTED | PATCH EXISTING PLASTER AS REQ. | |
| 207-NOT USED | | | | | | |
| 208-BATH | WELDED SEAM VINYL SHEET | PAINTED G&B | INTEGRAL COVE | PAINTED G&B | SHOWER WALLS TO BE PLASTIC PANEL W/ SEALANT SEAMS | |
| 209-EGRESS STR. | EXISTING WD. RE-FINISHED | PAINTED G&B | WOOD BASE | PAINTED G&B | VINYL STAIR TREADS | |

| WINDOW SCHEDULE | | | | | | | |
|-----------------|------|--------------|-------|-------------|-----------|----------------------------|---------------|
| MARK | QTY. | MANUFACTURER | MODEL | TYPE | UNIT SIZE | SIZE (R.O.) | REMARKS |
| A | 5 | ANDERSEN | | CASEMENT | | 2'-9 1/2" X 4'-4" | EGRESS |
| B | | NOT USED | | | | | |
| C | 2 | ANDERSEN | | DOUBLE-HUNG | | 3'-0" X 5' | |
| D | | NOT USED | | | | | |
| E | 3 | ANDERSEN | | SLIDER | | 4' X 4' | EGRESS SLIDER |
| F | 1 | ANDERSEN | | SLIDER | | 4'-10" X 6' R.O. AVAILABLE | EGRESS SLIDER |

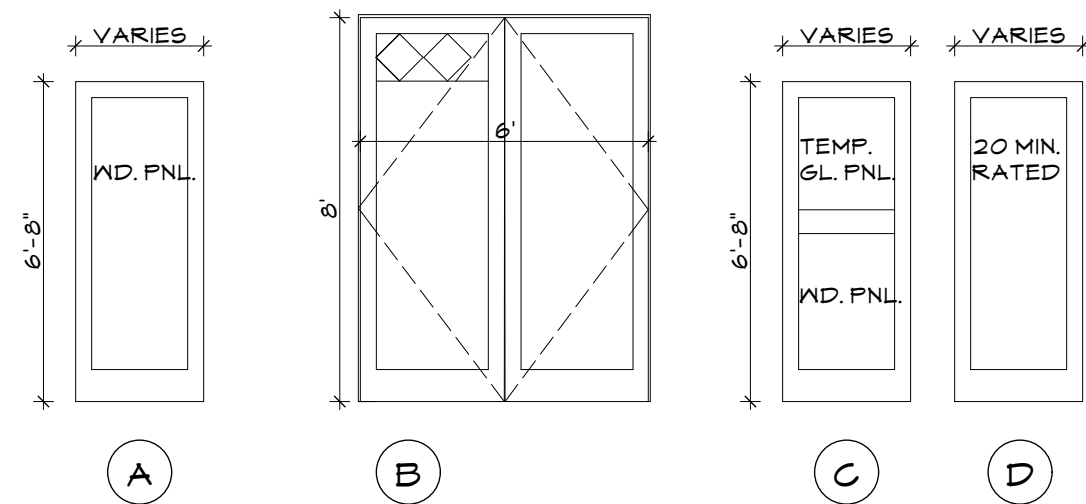


| DOOR SCHEDULE-ALL DOORS WOOD UNLESS NOTED OTHERWISE | | | | ALL NEW & EGRESS DOORS LEVER HANDLED TYPICAL | | |
|---|----------------------------|------------------------------------|-------------|--|----------------------|--|
| MARK | TYPE | LOCATION | MAKE/ MODEL | UNIT SIZE | STYLE | REMARKS |
| B01 | A | LOUNGE TO BEDROOM | | 3'-0" x 6'-8" | HINGED | |
| B01 A | A | BEDROOM TO CLOSET | | 3'-0" x 6'-8" | HINGED | |
| B01 B | A | BEDROOM TO CLOSET | | 3'-0" x 6'-8" | HINGED | |
| B02 | A | LOUNGE TO BEDROOM | | 3'-0" x 6'-8" | HINGED | |
| B02 A | A | BEDROOM TO CLOSET | | 3'-0" x 6'-8" | HINGED | |
| B02 B | A | BEDROOM TO CLOSET | | 3'-0" x 6'-8" | HINGED | |
| B03 | A | LOUNGE TO BEDROOM | | 3'-0" x 6'-8" | HINGED | |
| B03 A | A | BEDROOM TO CLOSET | | 3'-0" x 6'-8" | HINGED | |
| B03 B | A | BEDROOM TO CLOSET | | 3'-0" x 6'-8" | HINGED | |
| B04 | NOT USED | | | | | |
| B05 | D | HALL TO EGRESS | | 3'-0" x 6'-8" | | 20 MIN. RATED DOOR |
| B06 | A | HALL TO STAFF | | 3'-0" x 6'-8" | | |
| B06 A | A | STAFF TO CLOSET | | 3'-0" x 6'-8" | | |
| B07 | A | LOUNGE TO BATH | | 3'-0" x 6'-8" | | |
| B08 | A | LOUNGE TO LAUNDRY | | 3'-0" x 6'-8" | | |
| B09 | D | HALL TO EGRESS STAIR | | 3'-0" x 6'-8" | | 20 MIN. RATED DOOR |
| B10 | D | LOUNGE TO EXTERIOR | | 3'-0" x 6'-8" | | 20 MIN. RATED DOOR |
| 101 | D | EGRESS STAIR TO KITCHEN | | 3'-0" x 6'-8" | | 20 MIN. RATED DOOR |
| 101A | B | KITCHEN TO EXTERIOR | | 6'-0" x 8'-0" | SLIDING DOOR-2 PANEL | |
| 101B | REMOVED FOR SALVAGE | | | | | |
| 102 | EXISTING TO REMAIN | SUNROOM TO OUTSIDE DECK | | 2'-4" x 6'-8" | | FABRICATE NEW STORM PANEL |
| 103 | EXISTING TO REMAIN | SUNROOM TO GREATROOM | | 2'-4" x 6'-8" | | |
| 103A | EXISTING TO REMAIN | KITCHEN TO GREAT ROOM | | 4'-0" x 6'-8" | FOUR PANEL | |
| 103B | EXISTING TO REMAIN | GREATROOM TO DECK | | | IN-SWING FRENCH | FABRICATE NEW STORM PANEL |
| 104 | EXISTING TO REMAIN | MEETING ROOM TO GREAT ROOM | | 6'x 6'-10" | SLIDING POCKET DOORS | REPAIR SLIDERS |
| 104A | EXISTING TO REMAIN | MEETING ROOM TO ENTRY HALL | | 6'x 6'-10" | SLIDING POCKET DOORS | REPAIR SLIDERS |
| 105 | EXISTING TO REMAIN | OUTSIDE TO ENTRY | | 4'-0" x 7' | HINGED INSWING | |
| 106 | EXISTING TO REMAIN | ENTRY TO FOYER | | 4'-0" x 7' | HINGED INSWING | |
| 106A | EXISTING TO REMAIN | FOYER TO CLOSET | | | | |
| 106B | EXISTING TO REMAIN | FOYER TO BASEMENT | | | | POCKET DOOR HARDWARE |
| 107 | EXISTING TO REMAIN | FOYER TO LIBRARY | | 4'-0" x 6'-8" | FIXED FRENCH | |
| 107A | EXISTING TO REMAIN | LIBRARY TO PANTRY | | | | |
| 108 | A | PANTRY TO 1/2 BATH | | 2'-8" x 6'-10" | INTERIOR WOOD | |
| 109 | NEW | EXTERIOR TO EGRESS STAIR | | 3' x 6'-10" | 1/2 GLASS EXT. WOOD | NEW EXTERIOR DOOR |
| 201 | EXISTING TO REMAIN | MAIN STAIR HALL TO BEDROOM | | 2'-8" x 6'-8" | SINGLE PANEL | |
| 201A | NOT USED | | | | | |
| 201B | NOT USED | | | | | |
| 202 | EXISTING TO REMAIN | MAIN STAIR HALL TO BEDROOM | | 2'-8" x 6'-8" | SINGLE PANEL | |
| 202A | EXISTING TO REMAIN | BEDROOM TO CLOSET | | 2'-8" x 6'-8" | SINGLE PANEL | |
| 203 | EXISTING TO REMAIN | MAIN STAIR HALL TO BEDROOM | | 2'-8" x 6'-8" | SINGLE PANEL | |
| 203A | EXISTING TO REMAIN | BEDROOM TO CLOSET | | 2'-8" x 6'-8" | SINGLE PANEL | |
| 203B | SALVAGED & REUSED FROM 202 | BEDROOM TO CLOSET | | 2'-8" x 6'-8" | SINGLE PANEL | POCKET DOOR HARDWARE |
| 204 | EXISTING TO REMAIN | MAIN STAIR HALL TO BEDROOM | | 2'-8" x 6'-8" | SINGLE PANEL | |
| 204A | EXISTING TO REMAIN | BEDROOM TO CLOSET | | 2'-6" x 6'-8" | SINGLE PANEL | |
| 204B | A | BEDROOM TO CLOSET | | 3' x 6'-10" | SINGLE PANEL | |
| 205 | A | MAIN STAIR HALL TO BEDROOM | | 3' x 6'-10" | SINGLE PANEL | |
| 205A | A | BEDROOM TO CLOSET | | 3' x 6'-10" | SINGLE PANEL | |
| 205B | A | BEDROOM TO CLOSET | | 3' x 6'-10" | SINGLE PANEL | |
| 206 | REMOVED FOR SALVAGE | MAIN STAIR HALL TO COMMON ROOM | | 2'-6" x 6'-8" | SINGLE PANEL | |
| 206A | EXISTING TO REMAIN | COMMON ROOM TO CLOSET | | 12" x 6'-8" | SINGLE PANEL | |
| 206B | EXISTING TO REMAIN | COMMON ROOM TO EXTERIOR | | 3'-0" x 6'-8" | EXTERIOR GLAZED DOOR | PROVIDE/INSTALL GUARD AS NOTED |
| 207 | REMOVED FOR SALVAGE | MAIN STAIR HALL TO COMMON | | | | |
| 208 | EXISTING TO REMAIN | MAIN STAIR HALL TO BATHROOM | | 2'-8" x 6'-8" | SINGLE PANEL | |
| 208A | REMOVED FOR SALVAGE | | | 2'-6" x 6'-8" | 5 VERTICAL PANELS | |
| 208B | REMOVED FOR SALVAGE | | | | 5 VERTICAL PANELS | |
| 208C | REMOVED FOR SALVAGE | | | 2'-8" x 6'-8" | | |
| 209 | D | HALL TO EGRESS STAIR | | 3'-0" x 6'-8" | | |
| 210 | SLIDING | MAIN STAIR HALL TO CLOSET | | 2'-6" x 6'-8" | | REMOVE EXISTING SWING DOR AND INSTALL SLIDER |
| 210A | D | MAIN STAIR HALL TO ATTIC | | 2'-8" x 6'-8" | | 20 MIN. RATED DOOR |
| 210B | RELOCATED SALV. | MAIN STAIR HALL TO CLOSET | | 2'-6" x 6'-8" | | |
| 210C | REMOVE FOR SALVAGE | MAIN STAIR HALL TO FORMER BATHROOM | | | | |
| 210D | REMOVE FOR SALVAGE | MAIN STAIR HALL TO FORMER BATHROOM | | | | |

Plymouth House
 Portland, MAINE
 145 Glenwood Avenue

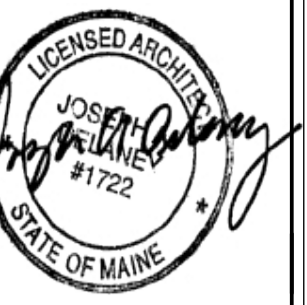

WHIPPLE — CALLENDER ARCHITECTS

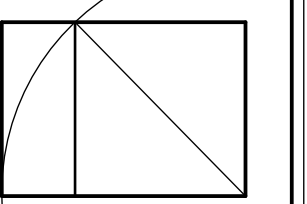


136 PLEASANT AVE.
 PORTLAND, ME 04103
 P 207.115.2646
 F 207.115.5631
 www.whipplecallender.com


| MARK | DATE | DESCRIPTION |
|------|------|-------------|
| | | |
| | | |
DATE: 3.7.13-REV. PERMIT
 CHECKED BY: JAD
 DRAWN BY: JAD
 JOB: 01-2013
 SHEET TITLE: SCHEDULES

A6.1

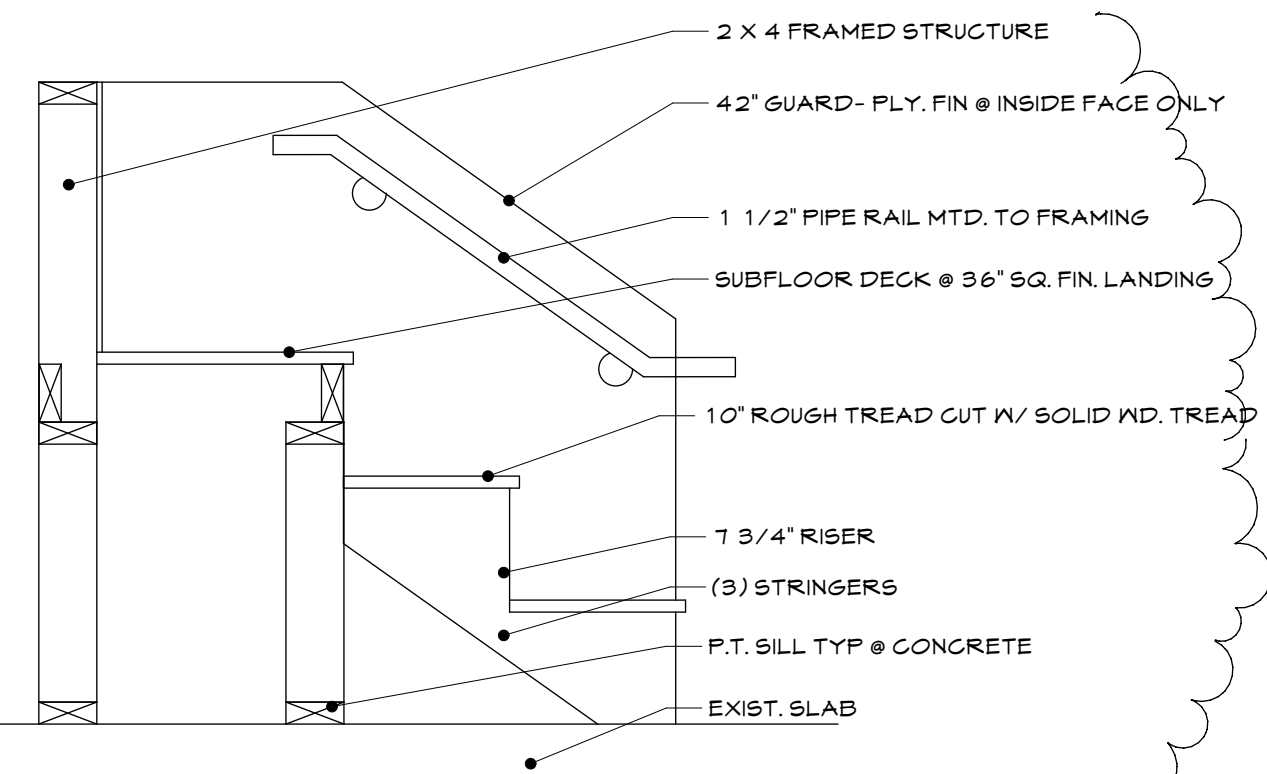


10 NEW STAIR @ FURNACE RM.

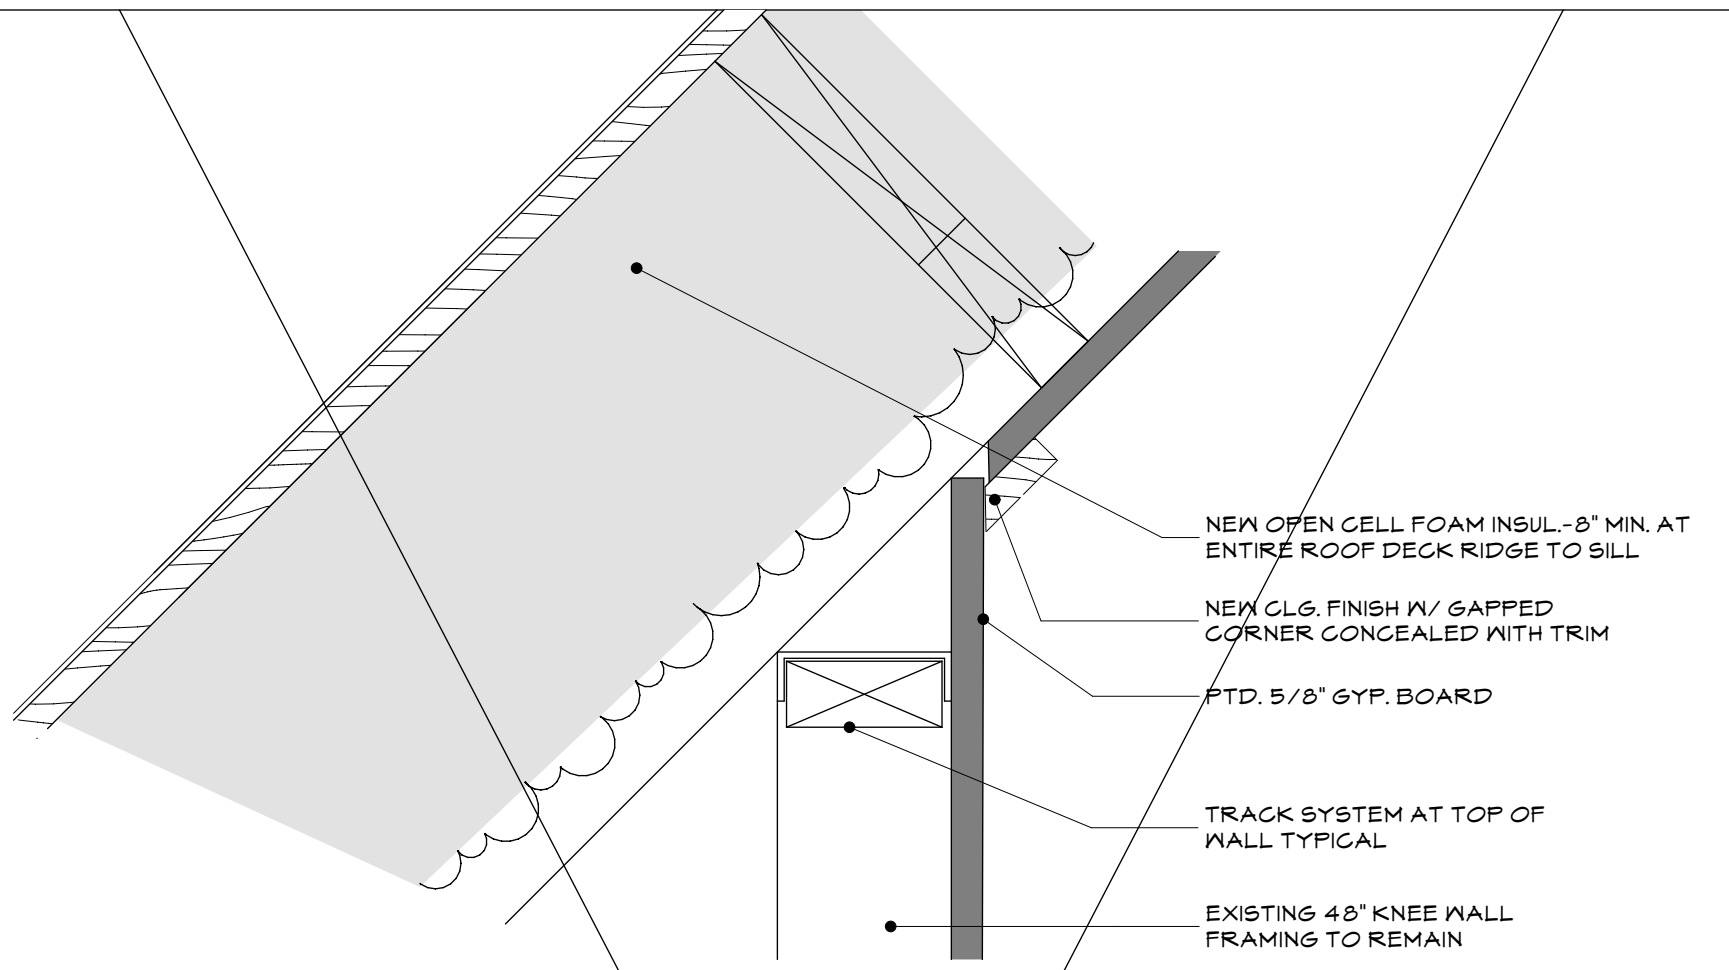


5 BASEMENT FLOOR


7 NOT USED

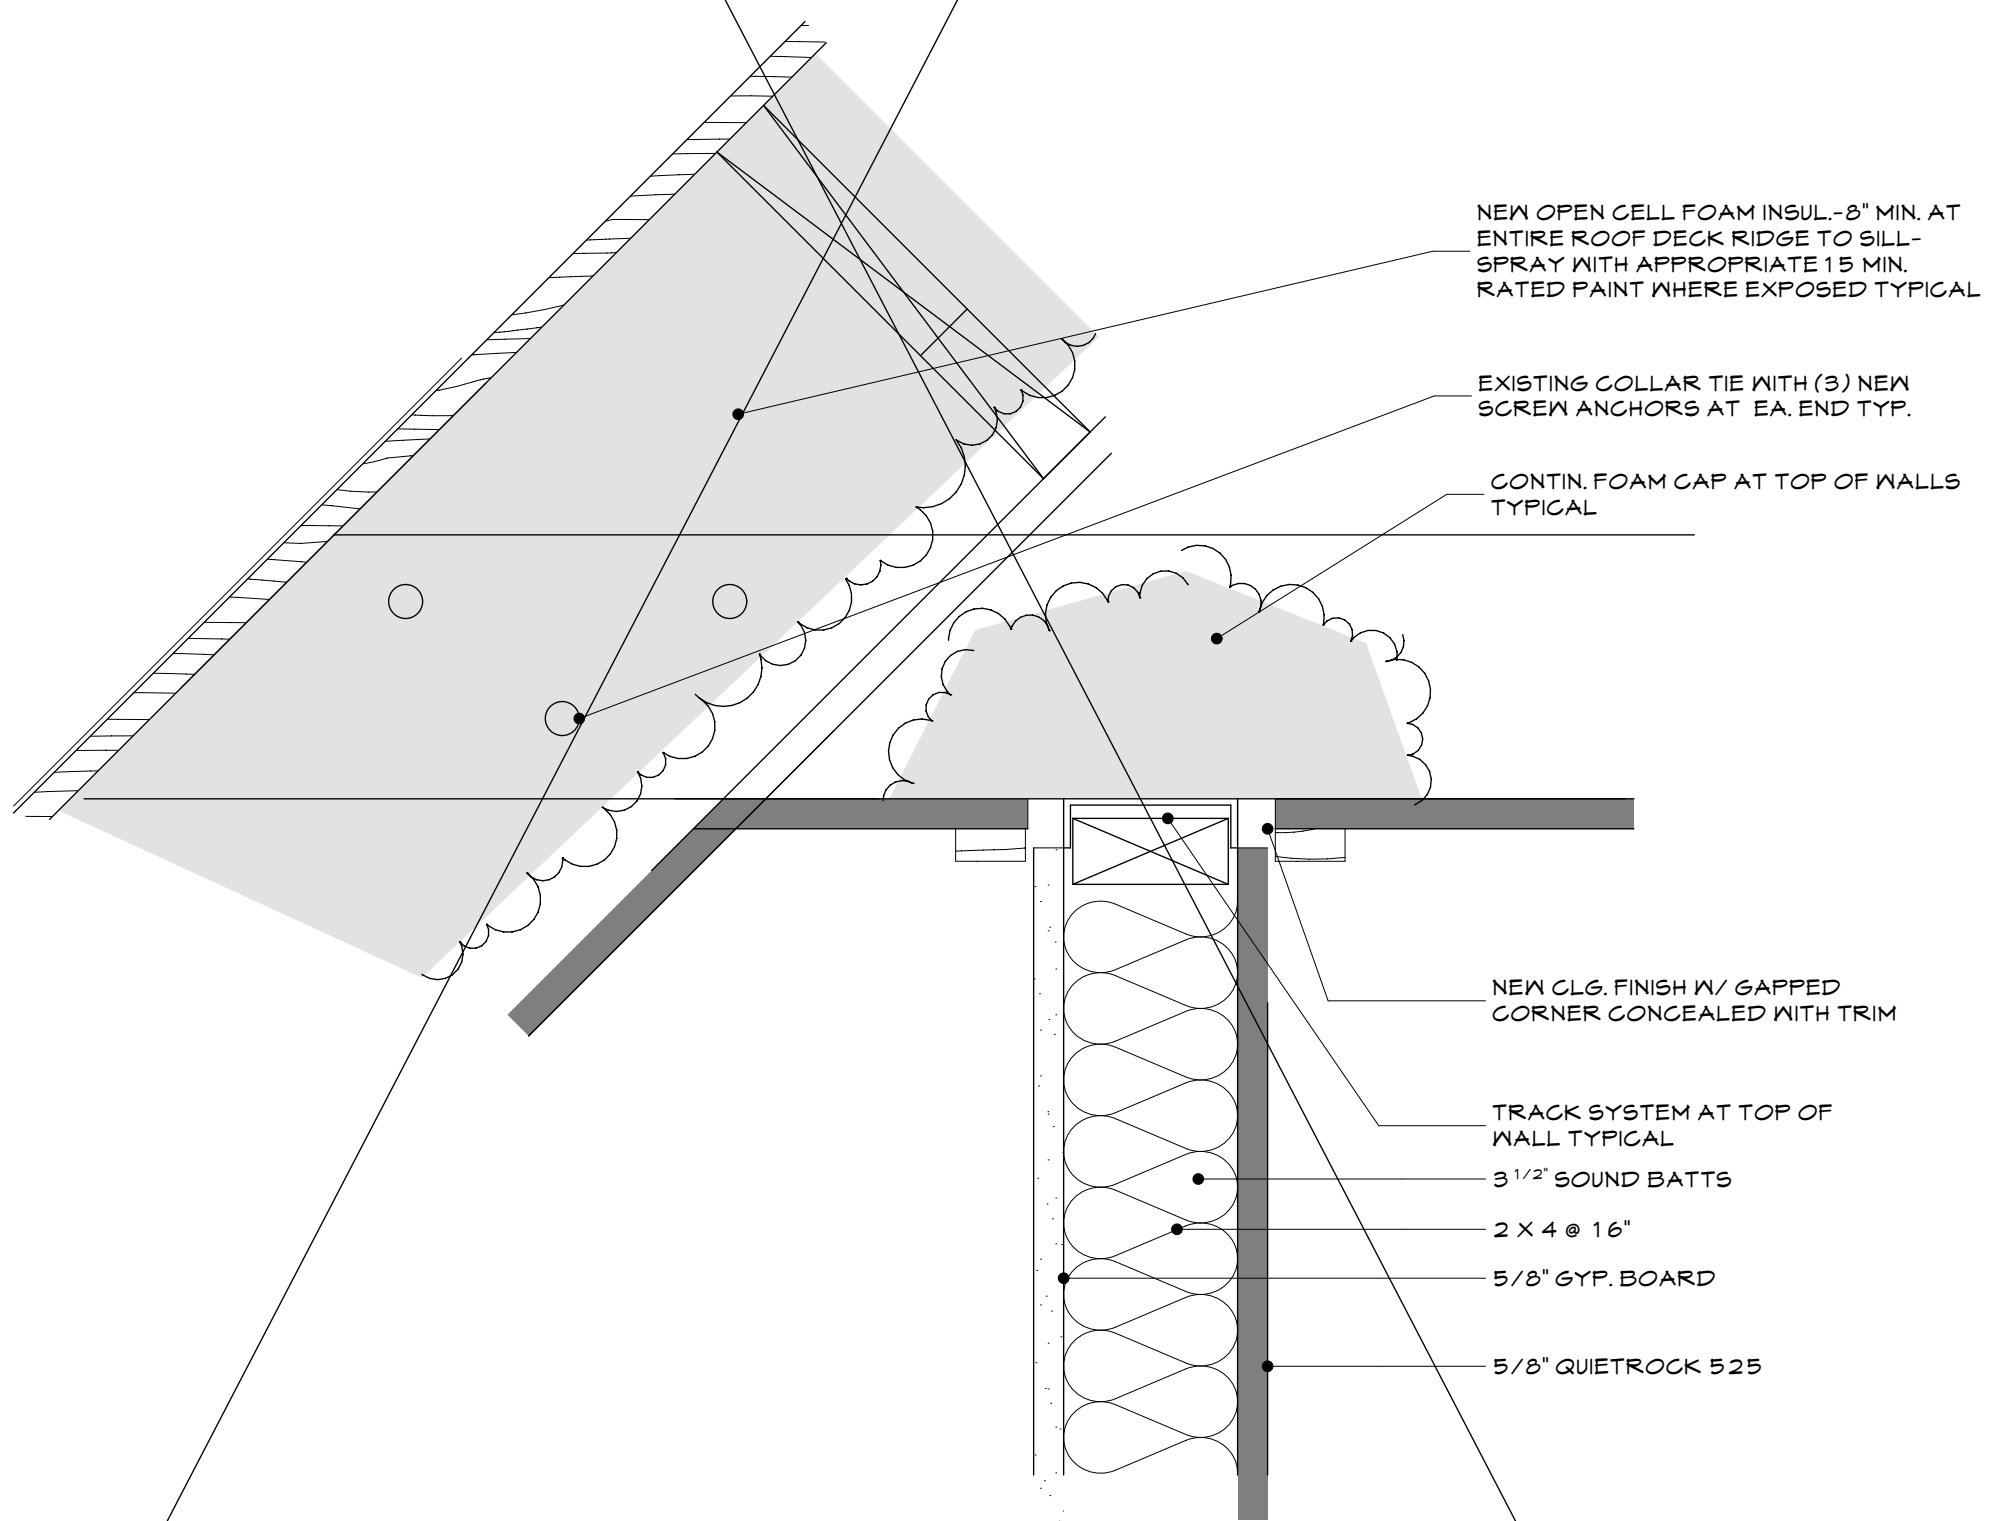


8 NEW WALL AT FLOOR THREE
QUIETROCK 525 REPLACED W/ 5/8" QUIETROCK DENSARMORPLUS 525 AT MOISTURE AREAS

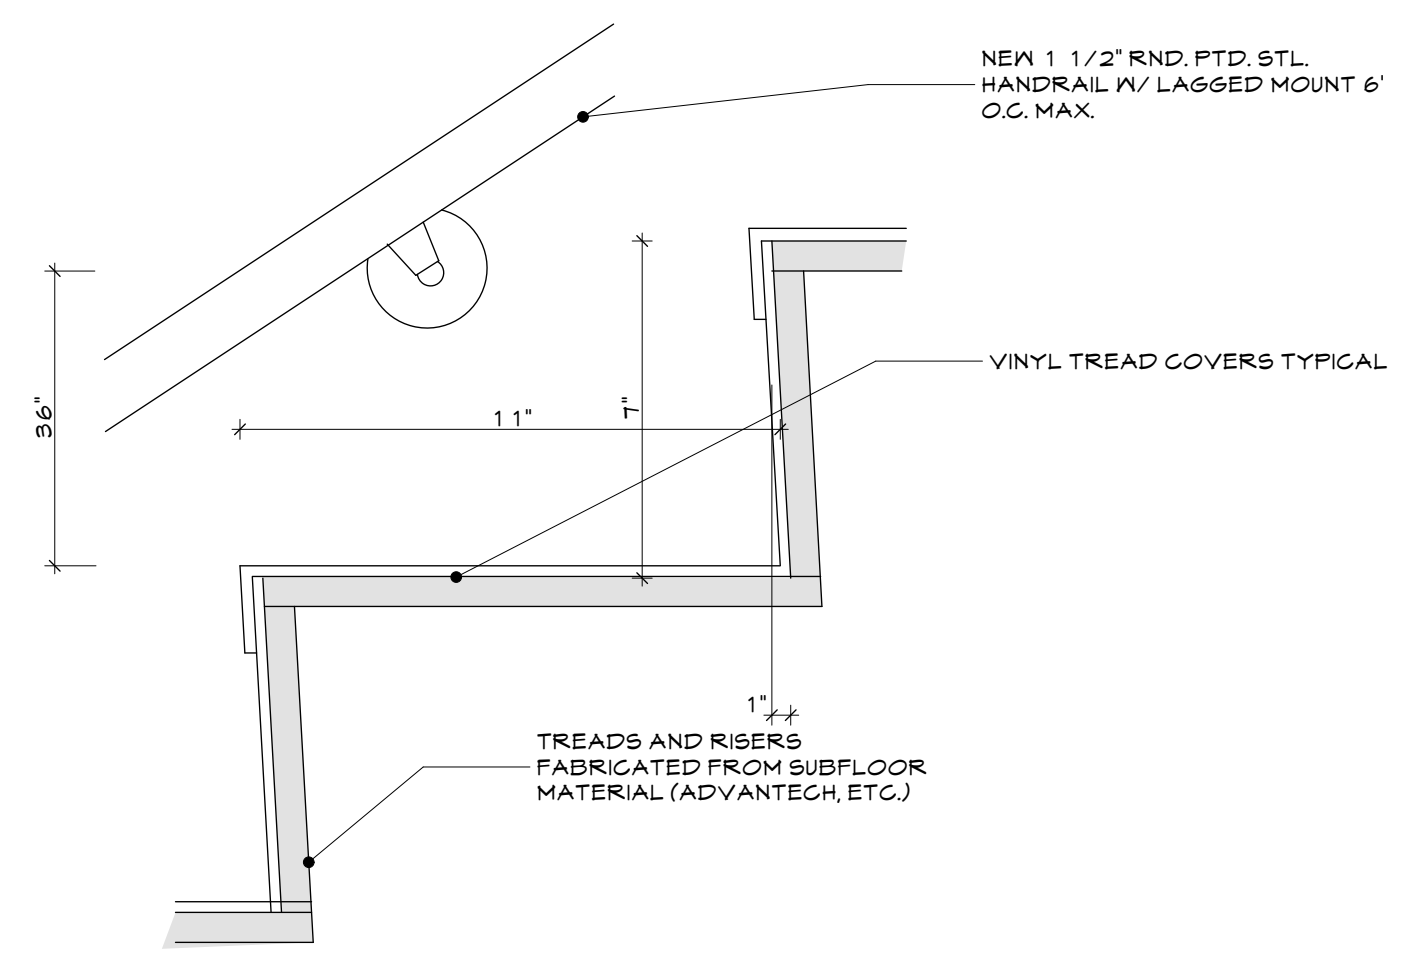

9 NEW STAIR

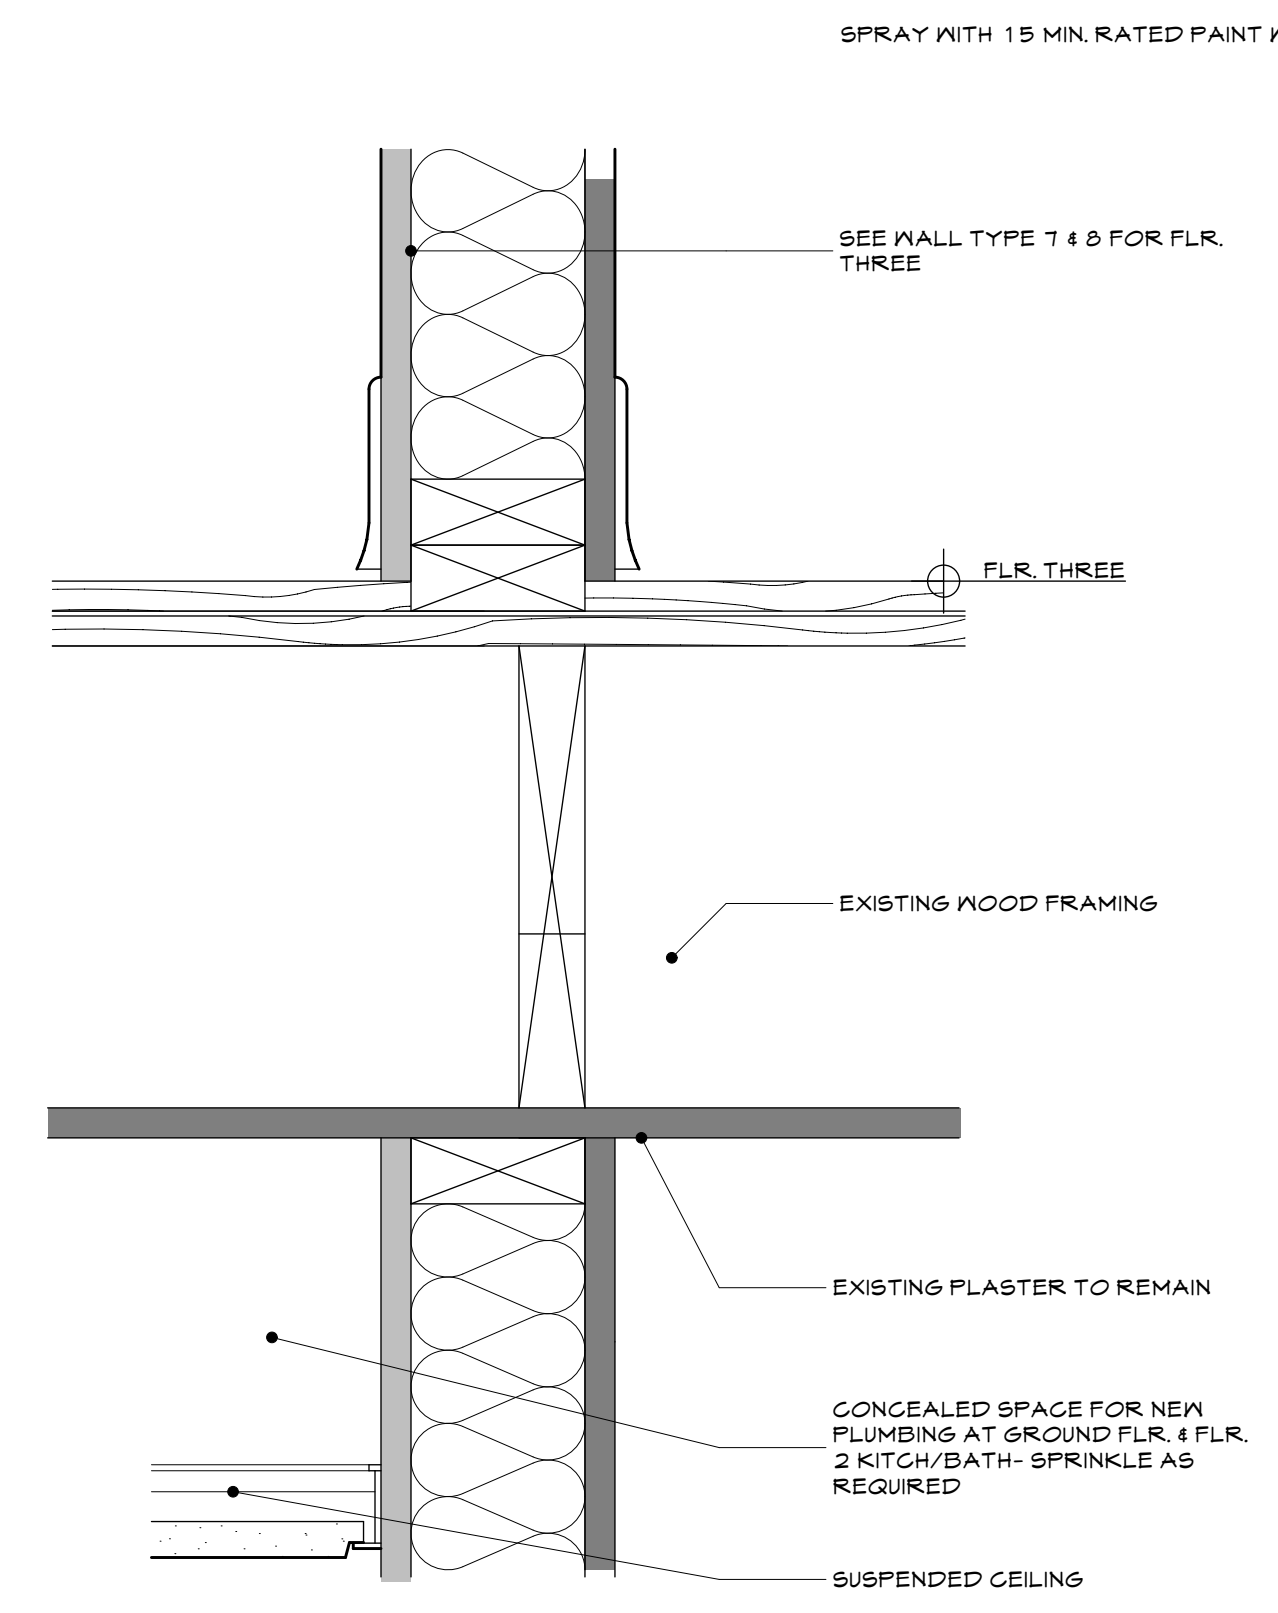


6 NEW FRAMED WALL TREATMENT
QUIETROCK 525 REPLACED W/ 5/8" QUIETROCK DENSARMORPLUS 525 AT MOISTURE AREAS

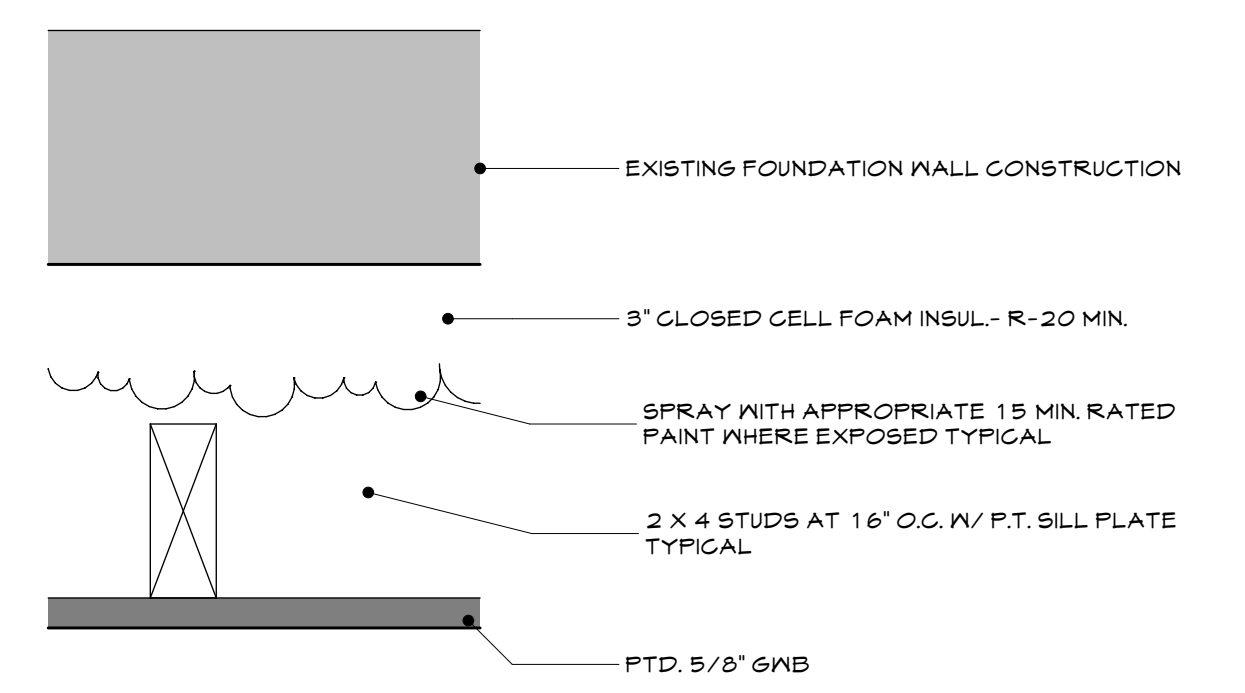


1 BASEMENT EXTERIOR WALL TREATMENT




2 BASEMENT EXTERIOR WALL TREATMENT- NO FINISH

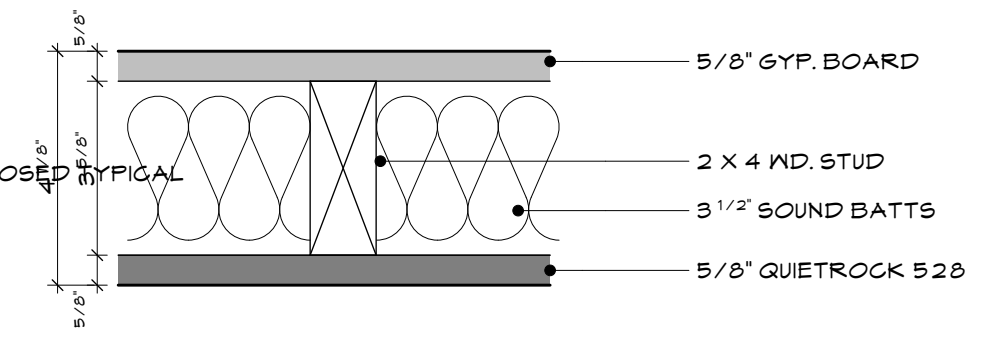

3 SOUNDDEADENING PARTITION W/ M.R. QUIETROCK
QUIETROCK 525 REPLACED W/ 5/8" QUIETROCK DENSARMORPLUS 525 AT MOISTURE AREAS

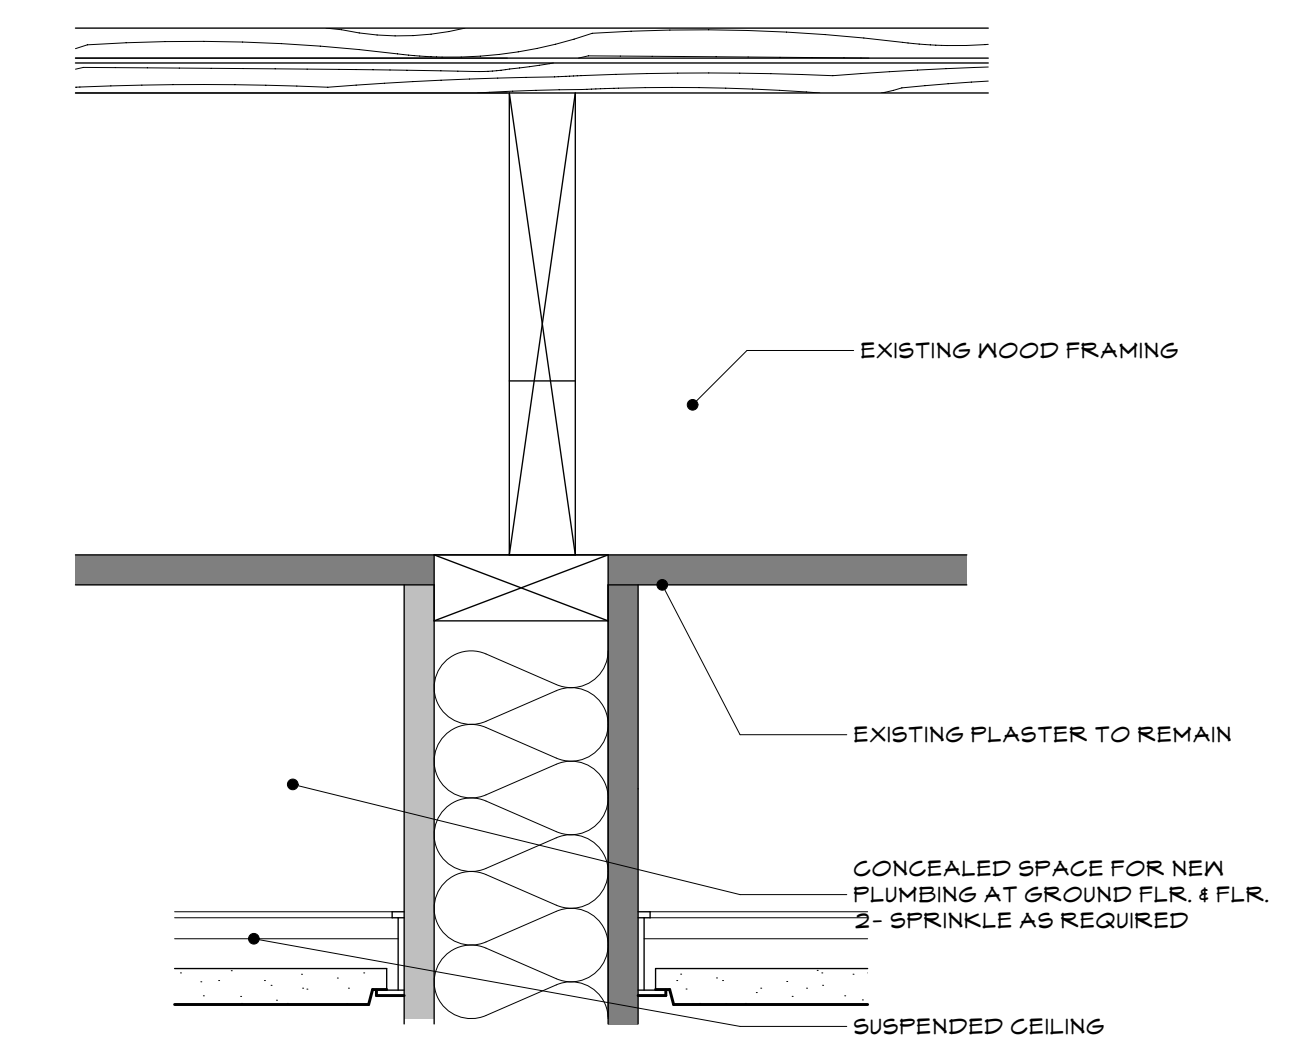

4 EXISTING WALL TREATMENT
QUIETROCK 525 REPLACED W/ 5/8" QUIETROCK DENSARMORPLUS 525 AT MOISTURE AREAS

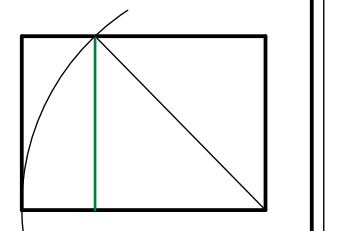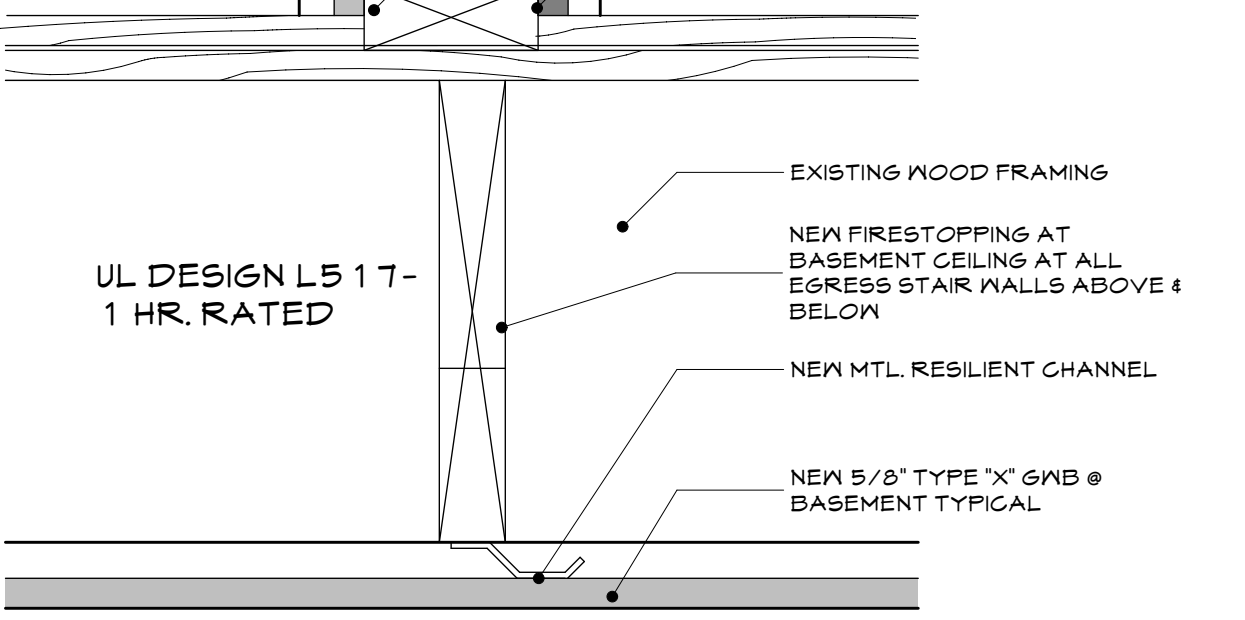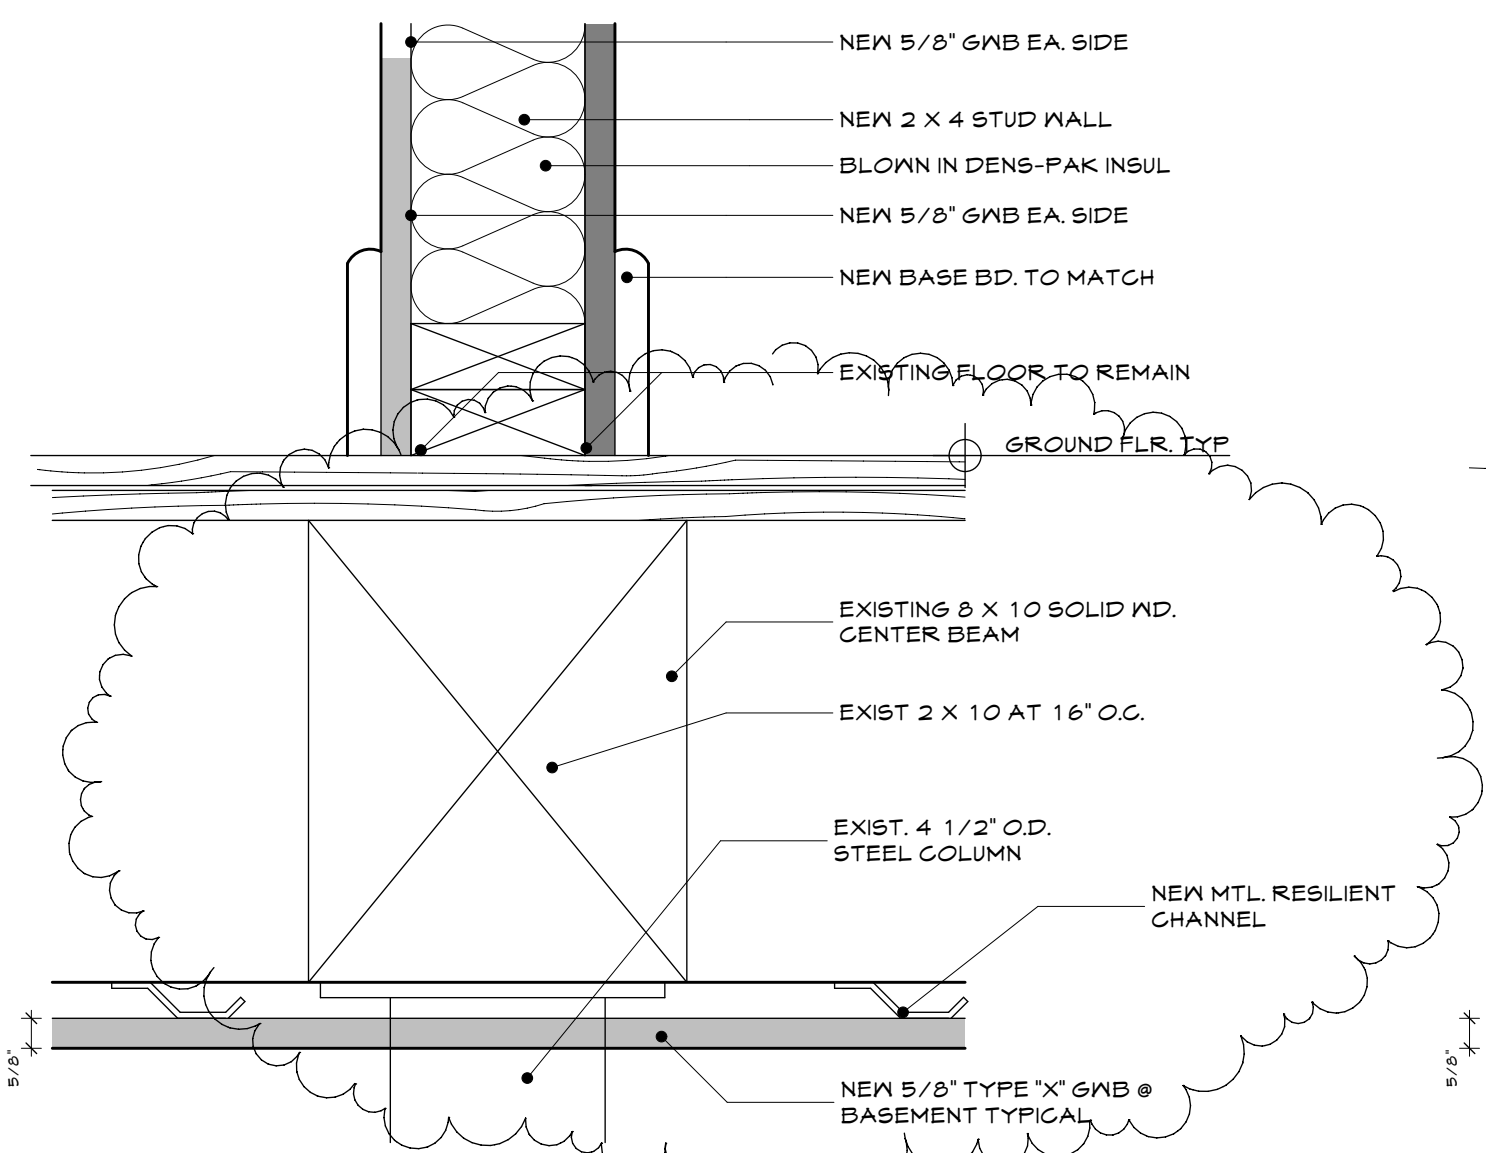

| MARK | DATE | DESCRIPTION |
|------|------|-------------|
| | | |
| | | |
| | | |
| | | |

| | |
|--------------|--------------------|
| DATE: | 3.7.13-REV. PERMIT |
| CHECKED BY: | JAD |
| DRAWN BY: | JAD |
| JOB: | 01-2013 |
| SHEET TITLE: | WALL DETAILS |