


502 DEERING CENTER
NEW MIXED USE
502 STEVENS AVE, PORTLAND ME


TITLE:
1ST FLOOR PLAN

REV	DATE	ISSUE
D		
C	07/10 2017	PLAN REVIEW REVISIONS
B	07/16 2017	CONSTRUCTION
A	06/19 2017	CONSTRUCTION


DRAWING NO:
A1.1

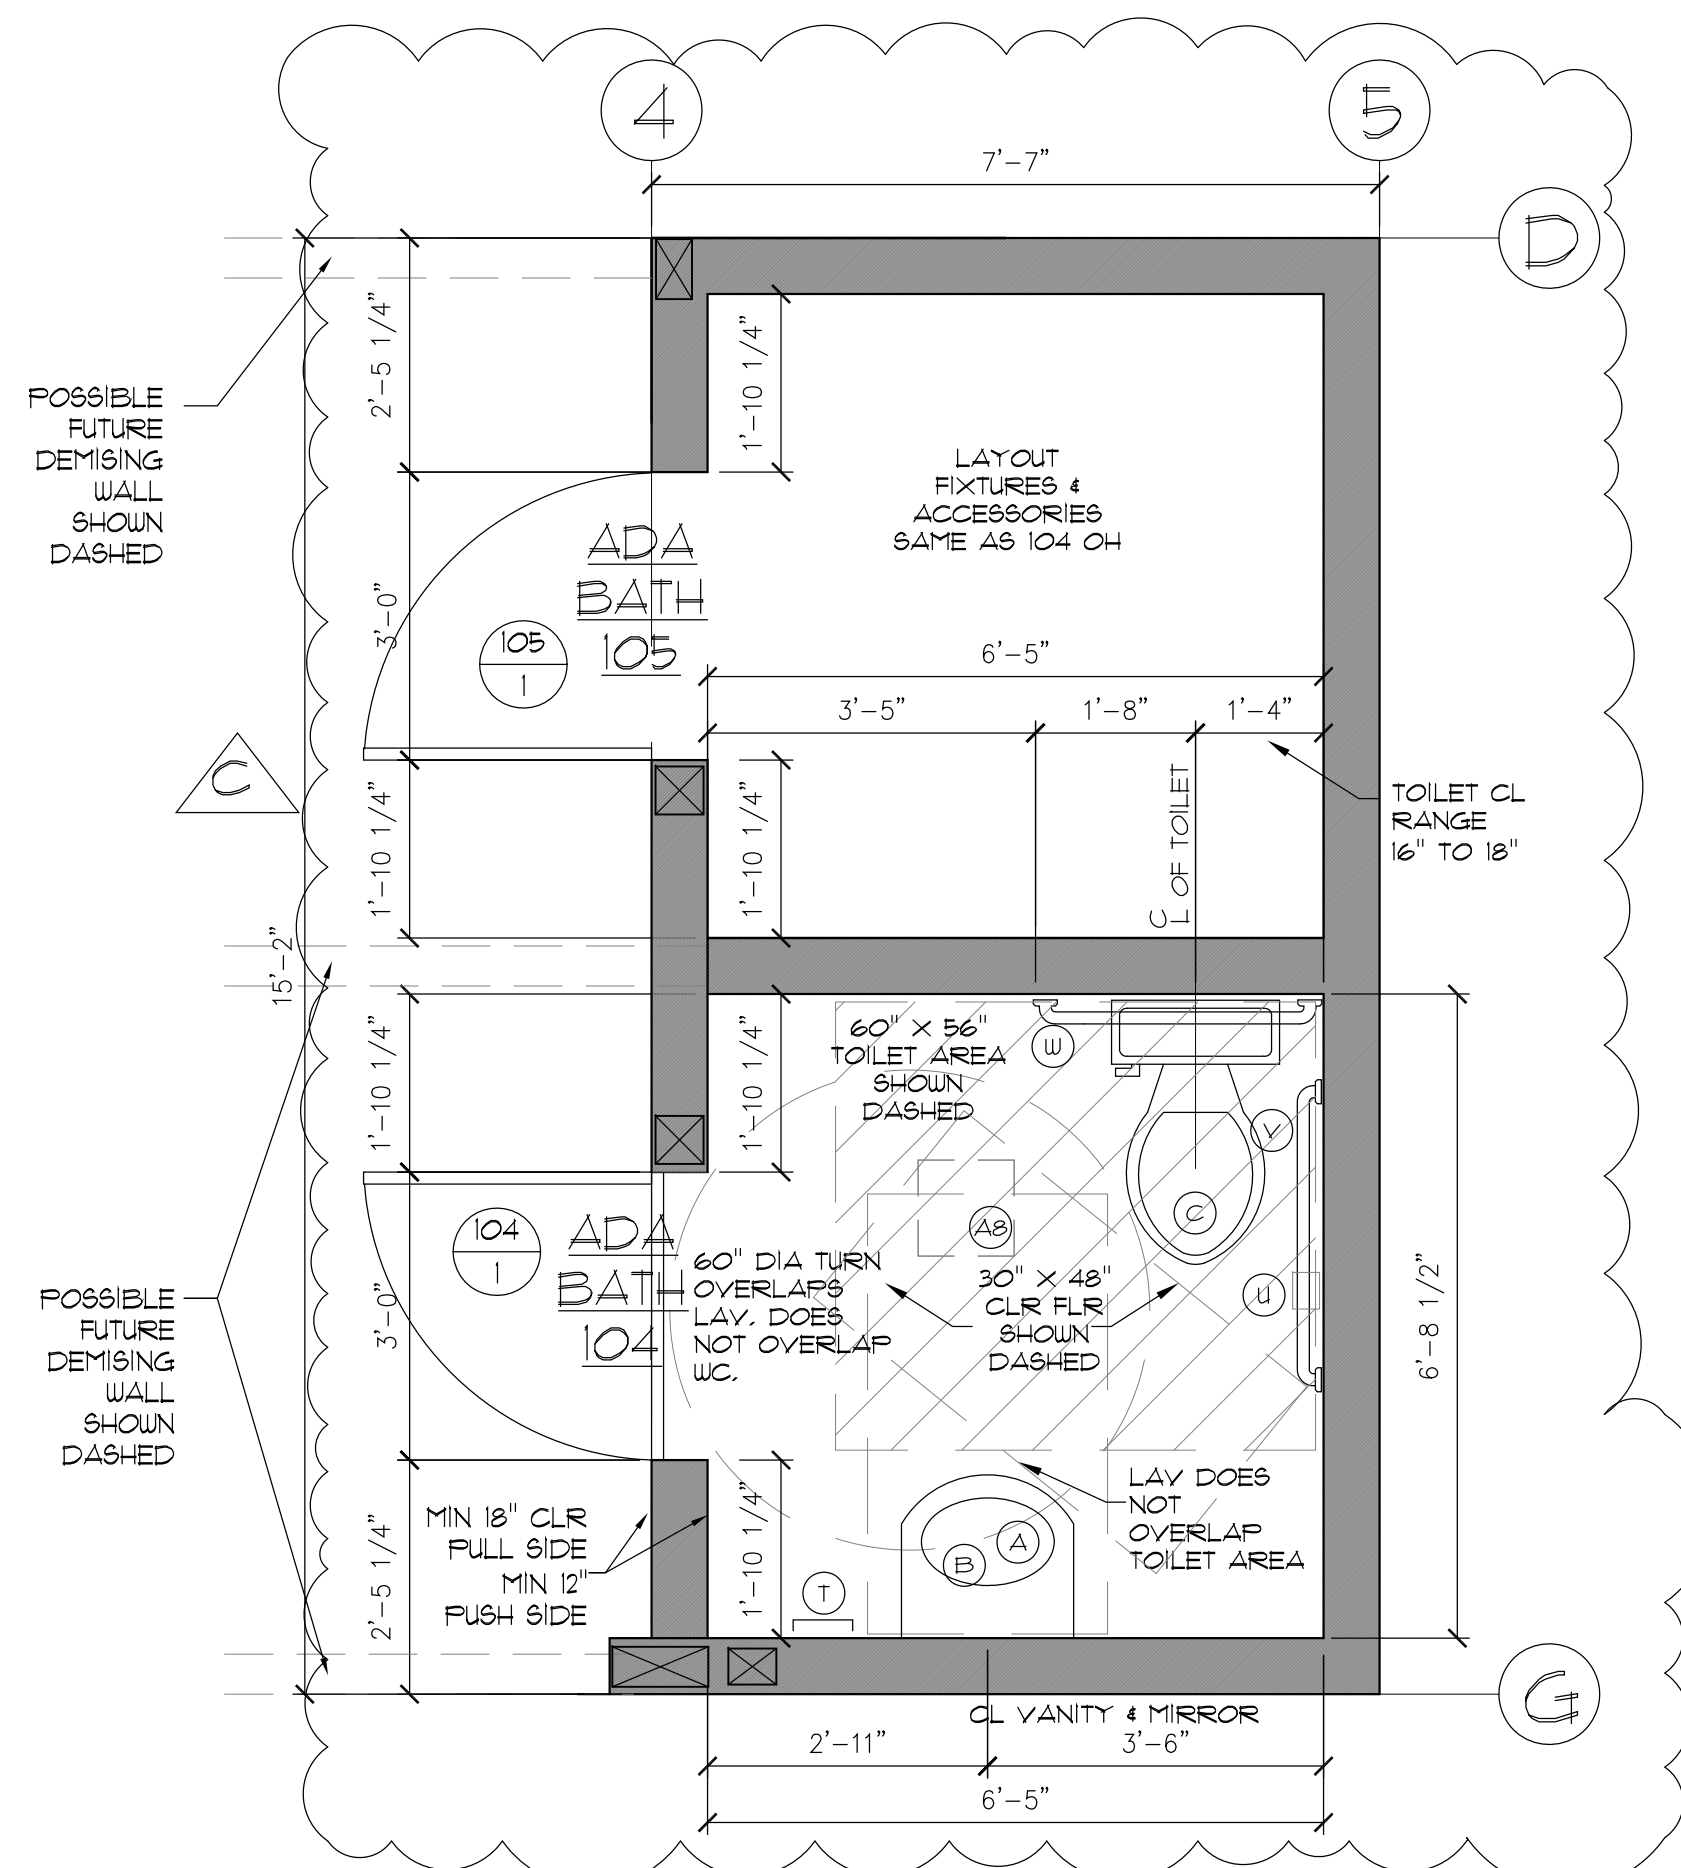


2 ENLARGED ADA BATH PLAN
SCALE = 1/2" = 1'-0"

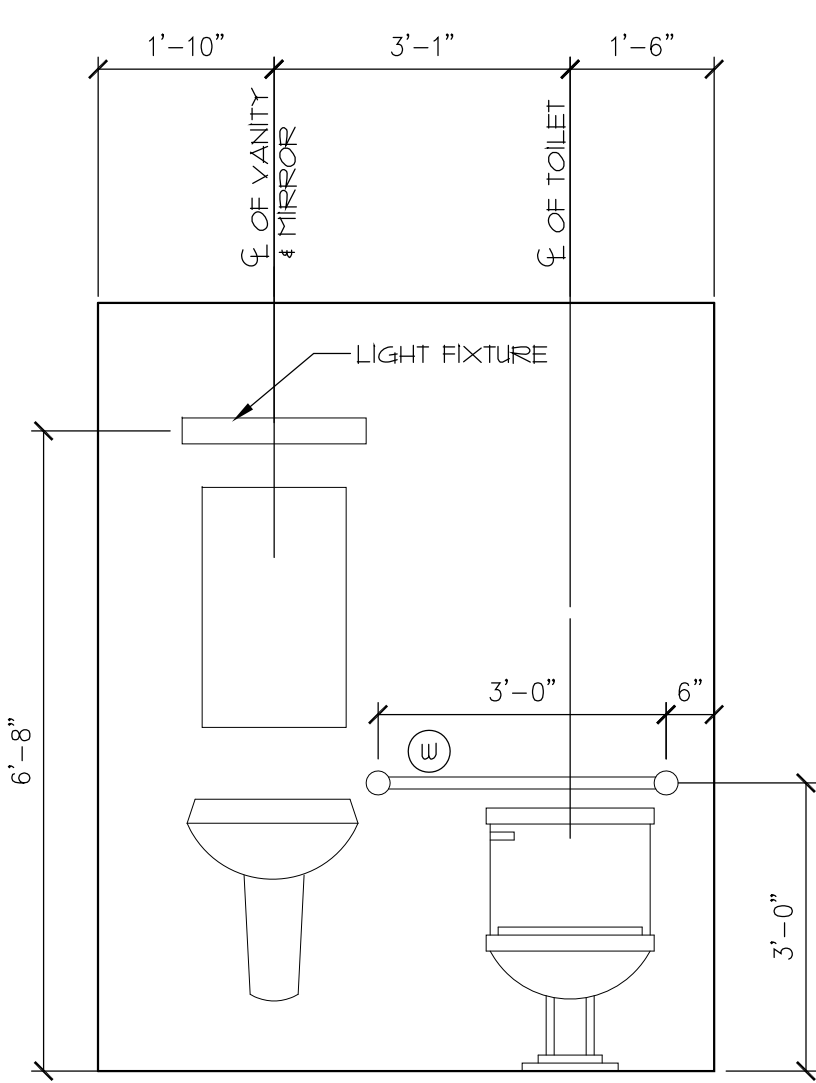


3 ADA BATH ELEVATIONS
SCALE = 1/2" = 1'-0"

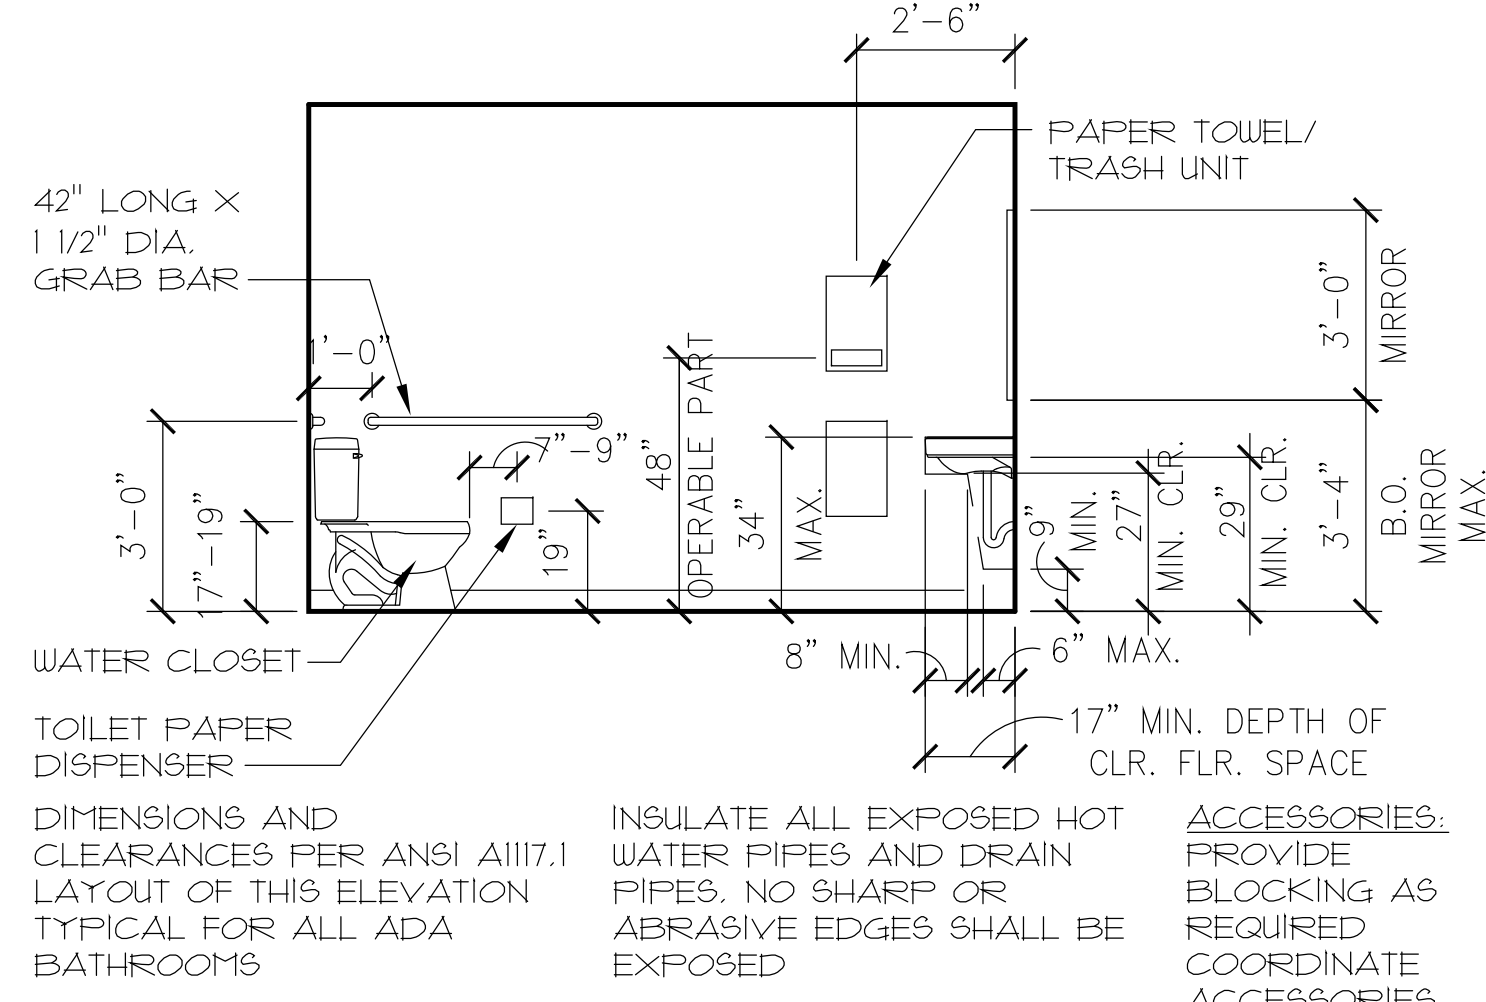


4 ADA MOUNTING
SCALE = NONE

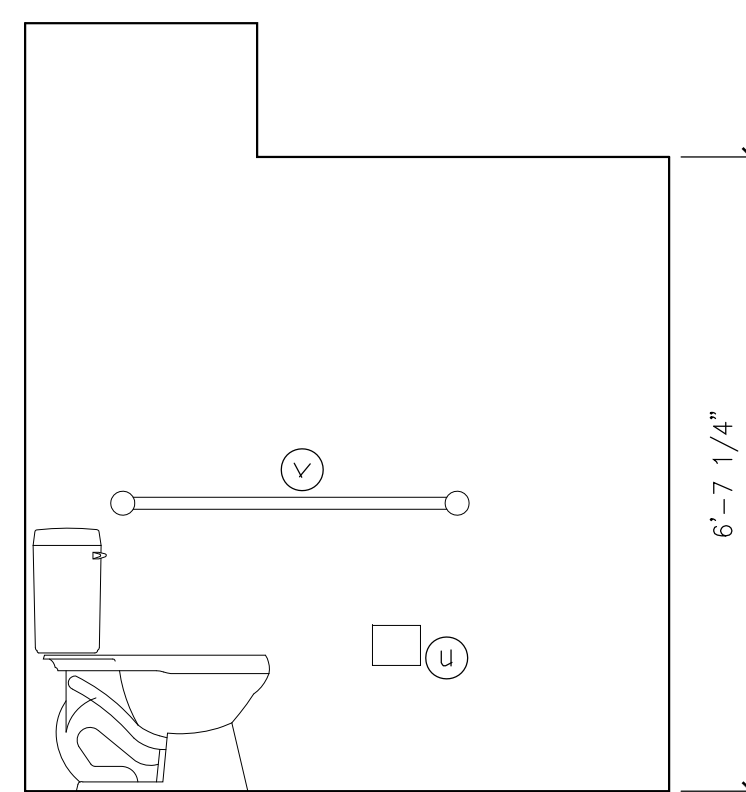


5 ADA BATH ELEV
SCALE = 1/2" = 1'-0"

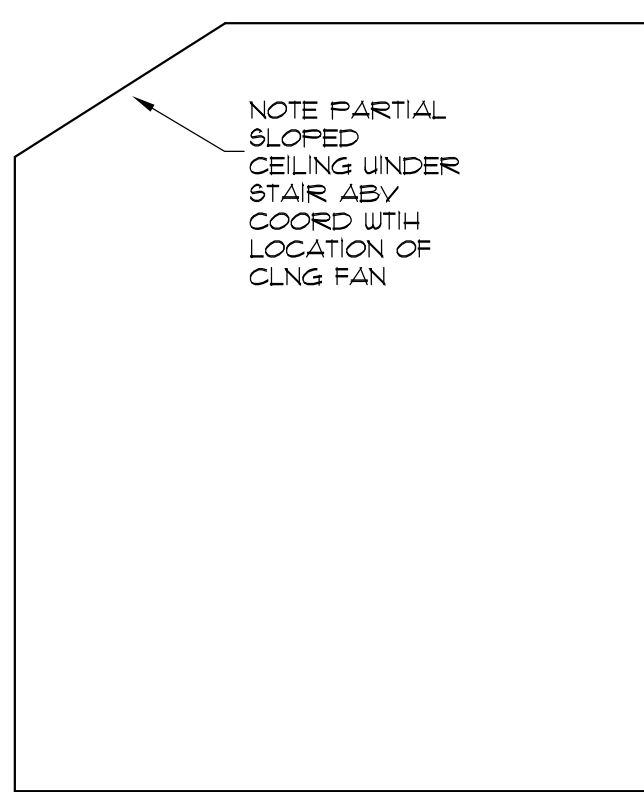

6 ADA BATH ELEV
SCALE = 1/2" = 1'-0"

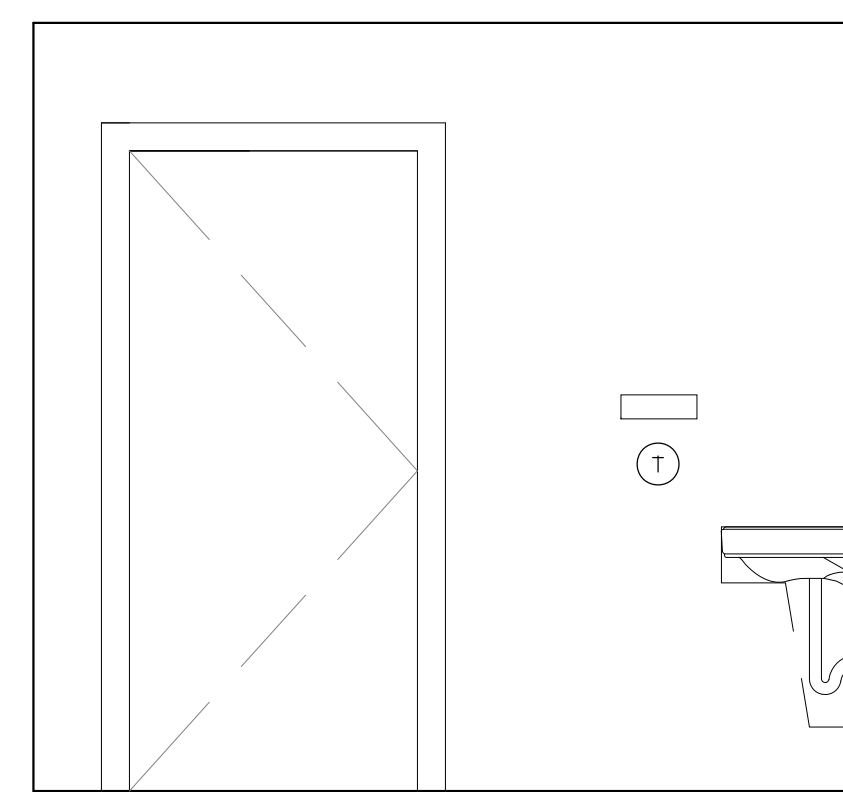

7 ADA BATH ELEV
SCALE = 1/2" = 1'-0"

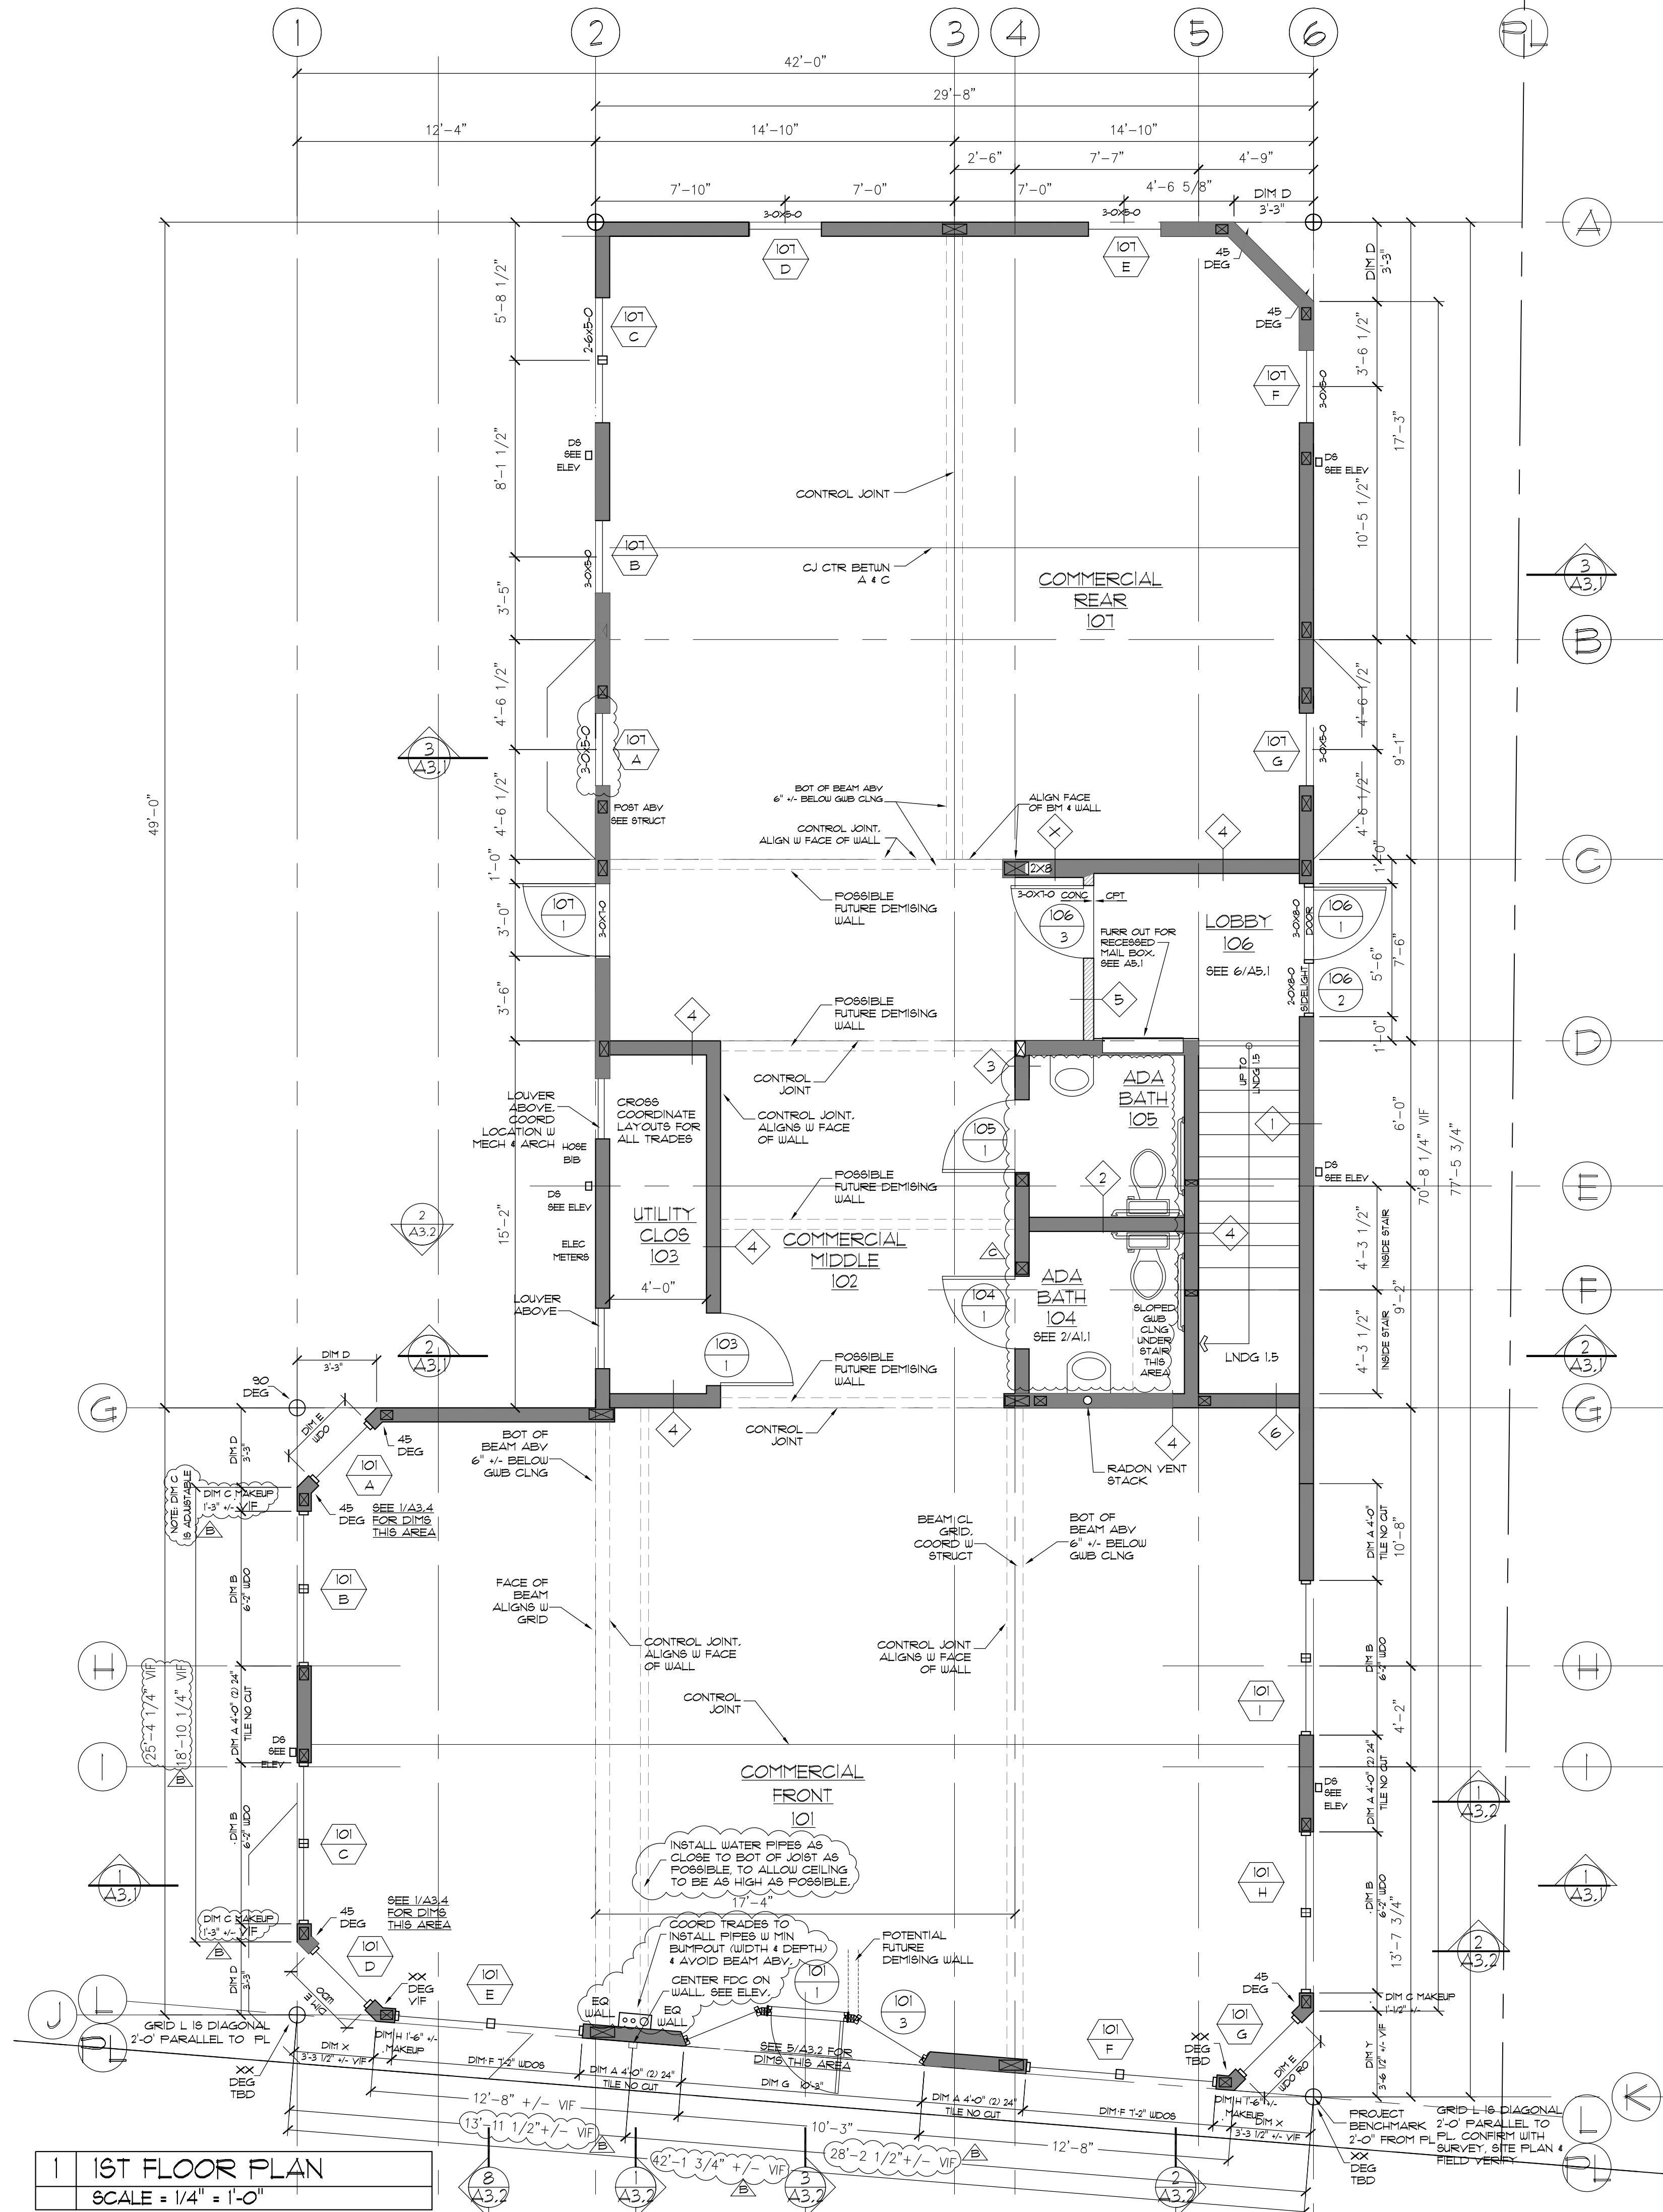

1 1ST FLOOR PLAN
SCALE = 1/4" = 1'-0"