


502 DEERING CENTER
NEW MIXED USE

502 STEVENS AVE, PORTLAND ME

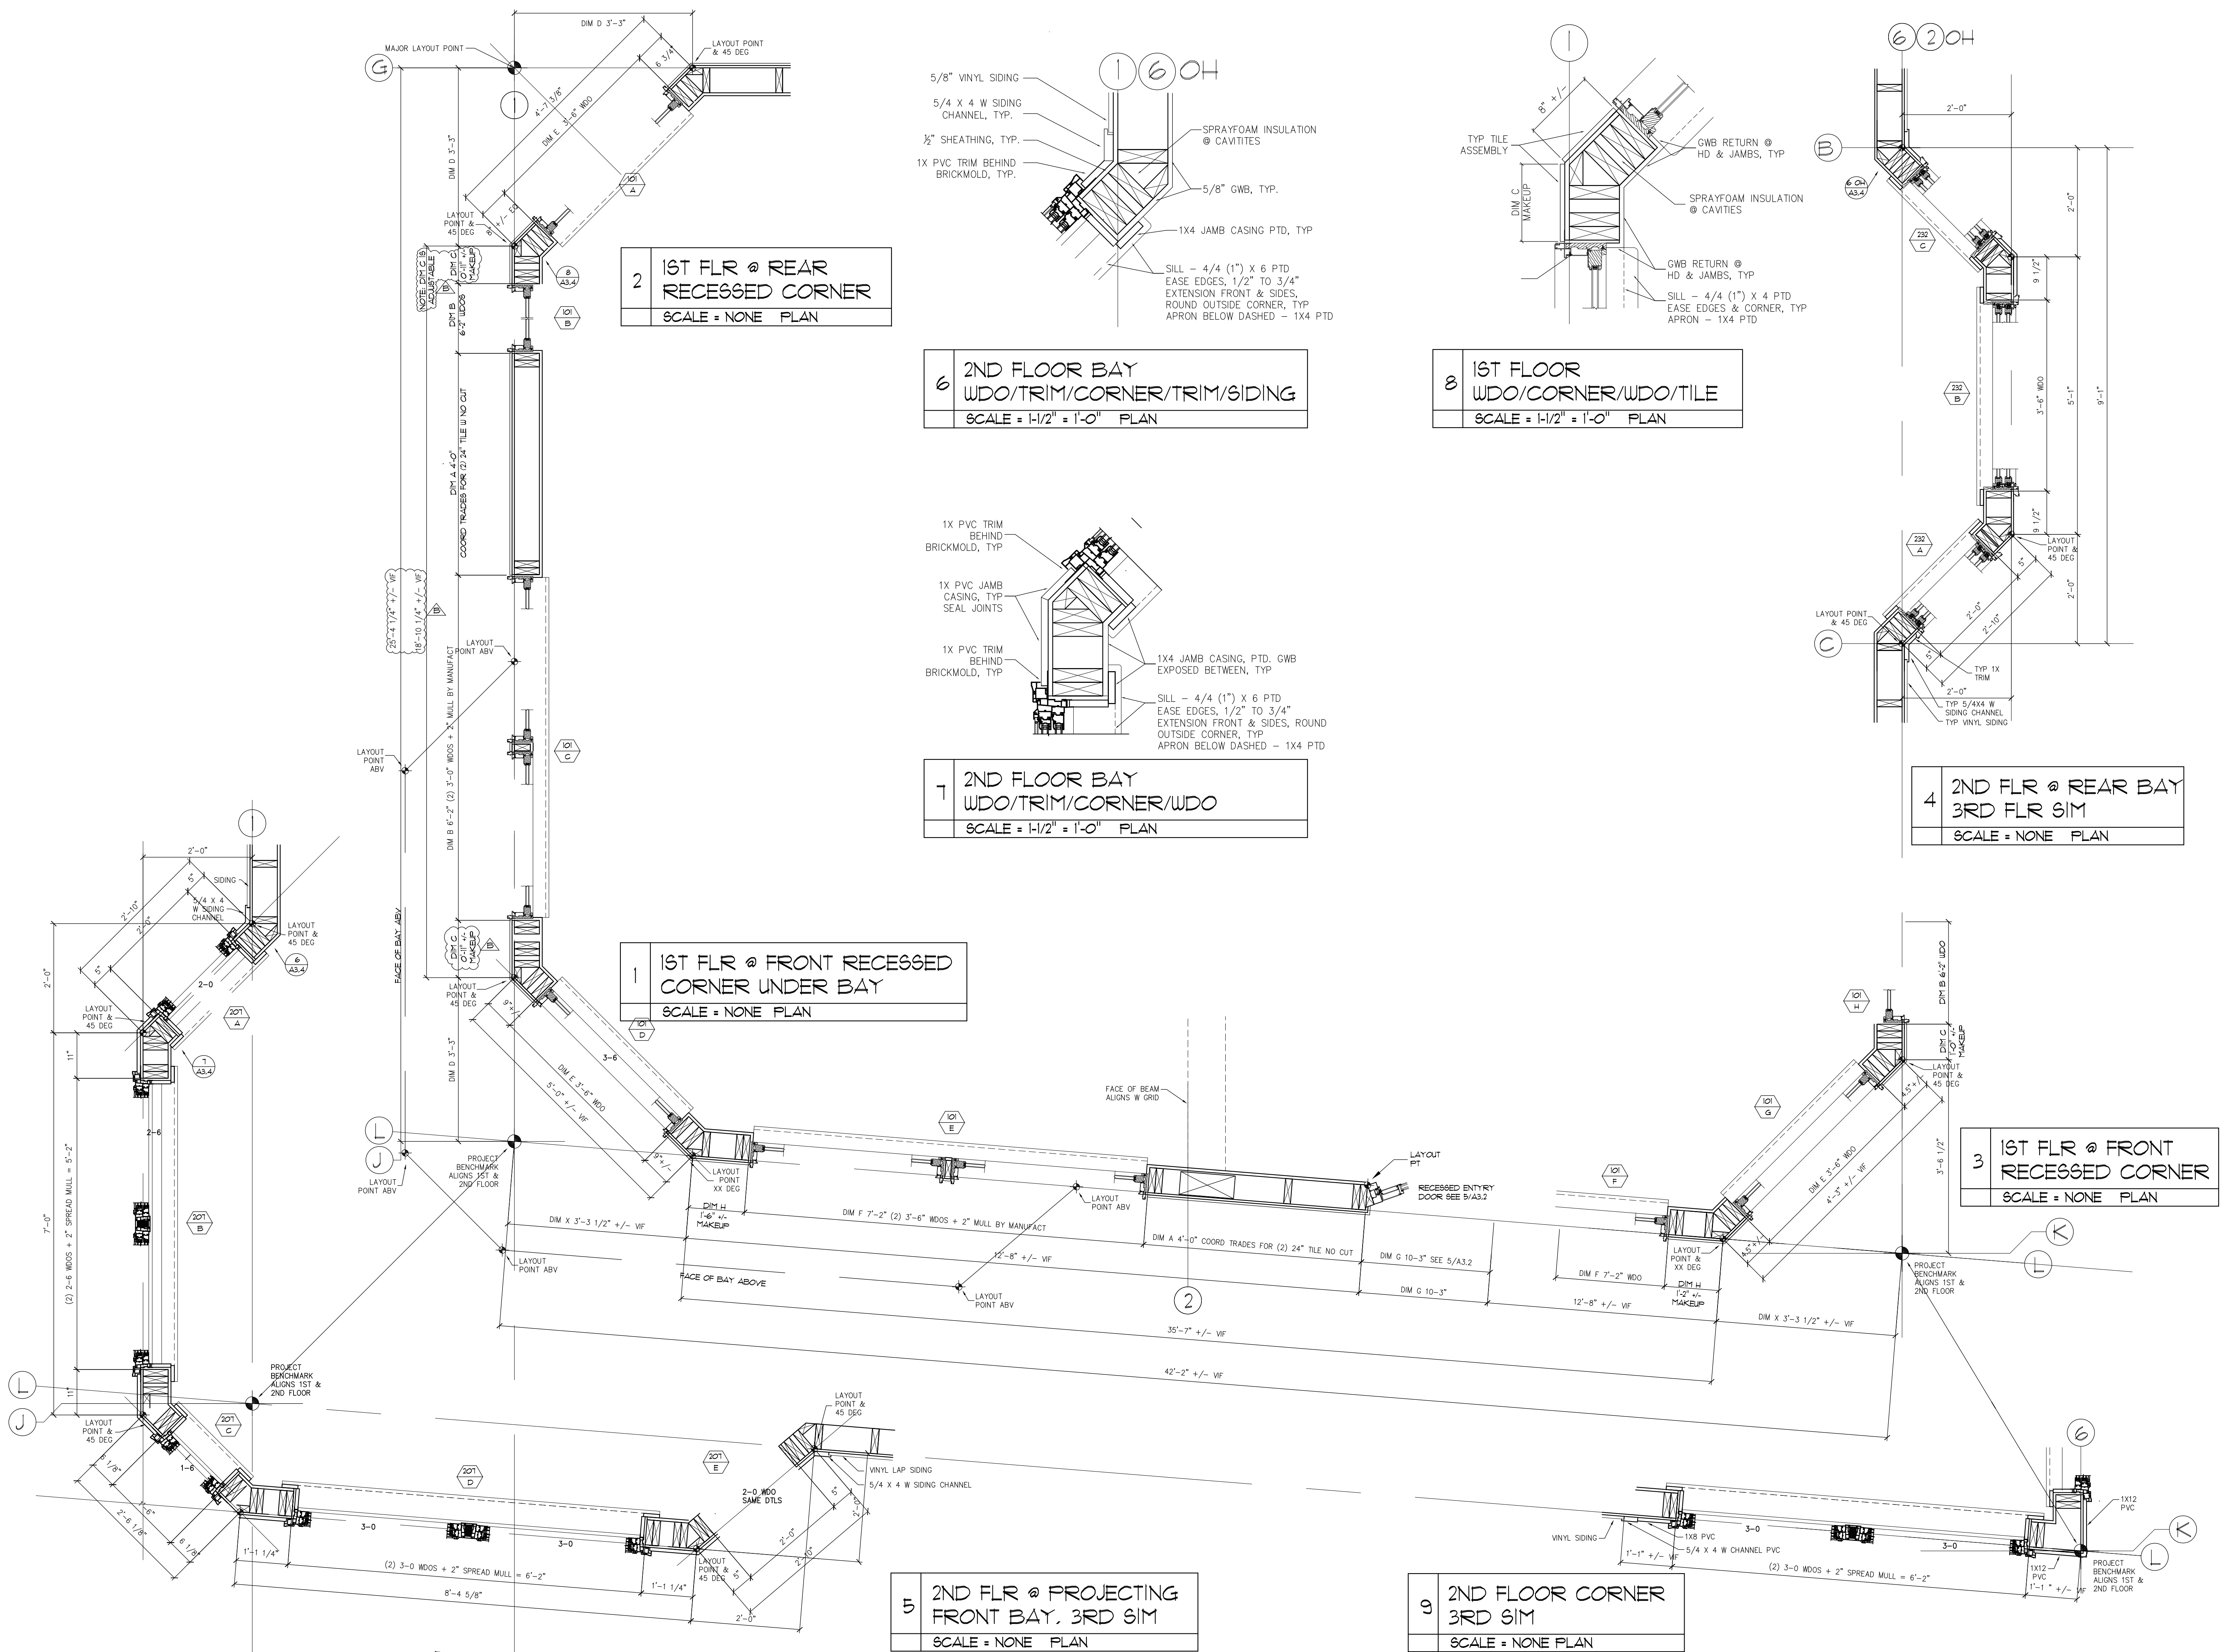

TITLE
**ENLARGDED
EXT PLAN DTLs**

REV	DATE	ISSUE
D		
C	07/10 2017	PLAN REVIEW REVISIONS
B	07/16 2017	CONSTRUCTION
A	06/19 2017	CONSTRUCTION

DRAWING NO:

A3.4