


wall #1 new windows  
A, B, J, K

Framed with 2x6's

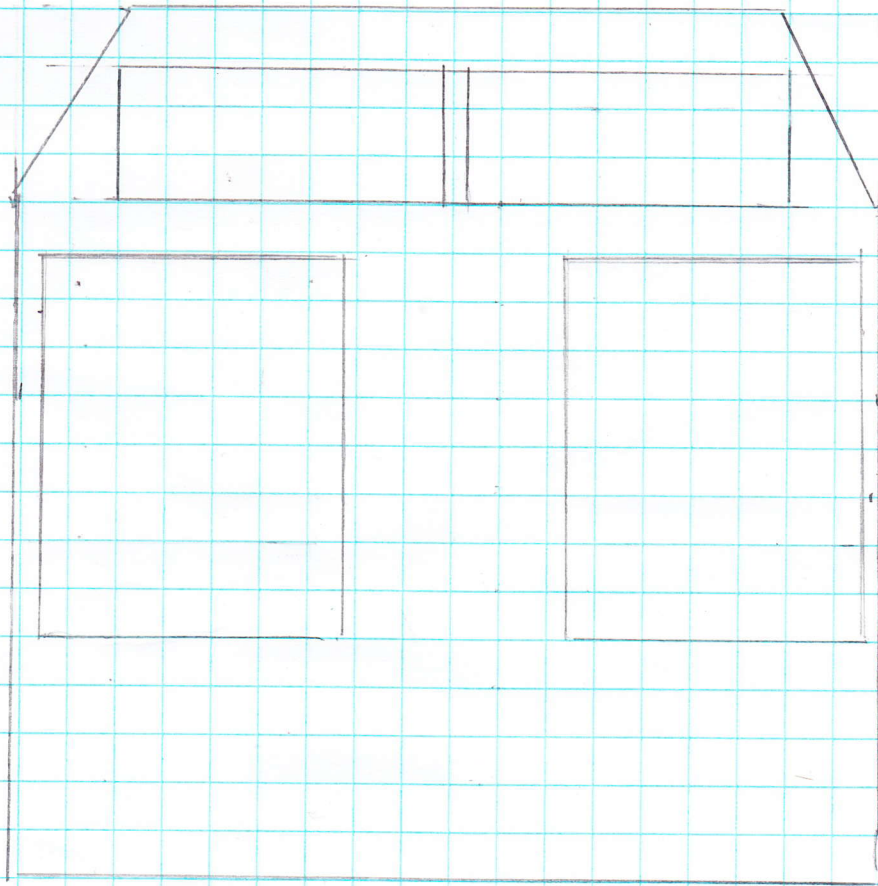

All other new windows in our home required no framing. The new windows fit into the existing 2x4 openings.