

PERMIT ISSUED

City of Portland, Maine - Building or Use Permit Application

389 Congress Street, 04101 Tel: (207) 874-8703, Fax: (207) 874-8716

Permit No: 03-0226	Issue Date: MAR 27 2003	CBL: 145 B018001
-----------------------	----------------------------	---------------------

Location of Construction: 760 Stevens Ave	Owner Name: State Of Maine	Owner Address: CITY OF PORTLAND	Phone:
Business Name:	Contractor Name: Greater Portland Landmarks	Contractor Address: 165 State Street Portland	Phone: 2077745561
Lessee/Buyer's Name	Phone:	Permit Type: Special Events	Zone: R5

Past Use: National Guard Armory	Proposed Use: Public Space	Permit Fee: \$30.00	Cost of Work: \$30.00	CEO District: 3
------------------------------------	-------------------------------	------------------------	--------------------------	--------------------

Proposed Project Description: Old House Trade Show Hosted by Greater Portland Landmarks: March 28th, 29th & 30th, 2003	FIRE DEPT: <input checked="" type="checkbox"/> Approved <input type="checkbox"/> Denied	INSPECTION: Use Group: <i>A</i> Type: <i>NA</i> <i>TEMP 3/26/03</i>
	Signature: <i>WMM</i>	Signature: <i>[Signature]</i>

Permit Taken By: gad	Date Applied For: 03/24/2003	Zoning Approval	
-------------------------	---------------------------------	------------------------	--

<p>1. This permit application does not preclude the Applicant(s) from meeting applicable State and Federal Rules.</p> <p>2. Building permits do not include plumbing, septic or electrical work.</p> <p>3. Building permits are void if work is not started within six (6) months of the date of issuance. False information may invalidate a building permit and stop all work..</p>	<p>Special Zone or Reviews</p> <p><input type="checkbox"/> Shoreland</p> <p><input type="checkbox"/> Wetland <i>use</i></p> <p><input type="checkbox"/> Flood Zone</p> <p><input type="checkbox"/> Subdivision</p> <p><input type="checkbox"/> Site Plan</p> <p>Maj <input type="checkbox"/> Minor <input type="checkbox"/> MM <input checked="" type="checkbox"/></p> <p>Date: <i>OK 3/25/03</i></p>	<p>Zoning Appeal</p> <p><input type="checkbox"/> Variance</p> <p><input type="checkbox"/> Miscellaneous</p> <p><input type="checkbox"/> Conditional Use</p> <p><input type="checkbox"/> Interpretation</p> <p><input type="checkbox"/> Approved</p> <p><input type="checkbox"/> Denied</p> <p>Date:</p>	<p>Historic Preservation</p> <p><input checked="" type="checkbox"/> Not in District or Landmark</p> <p><input type="checkbox"/> Does Not Require Review</p> <p><input type="checkbox"/> Requires Review</p> <p><input type="checkbox"/> Approved</p> <p><input type="checkbox"/> Approved w/Conditions</p> <p><input type="checkbox"/> Denied</p> <p>Date: <i>[Signature]</i></p>
---	---	---	---

CERTIFICATION

I hereby certify that I am the owner of record of the named property, or that the proposed work is authorized by the owner of record and that I have been authorized by the owner to make this application as his authorized agent and I agree to conform to all applicable laws of this jurisdiction. In addition, if a permit for work described in the application is issued, I certify that the code official's authorized representative shall have the authority to enter all areas covered by such permit at any reasonable hour to enforce the provision of the code(s) applicable to such permit.

SIGNATURE OF APPLICANT	ADDRESS	DATE	PHONE
RESPONSIBLE PERSON IN CHARGE OF WORK, TITLE		DATE	PHONE

03-0226

All Purpose Building Permit Application

If you or the property owner owes real estate or personal property taxes or user charges on any property within the City, payment arrangements must be made before permits of any kind are accepted.


Location/Address of Construction: <u>760 Stevens Ave</u>		
Total Square Footage of Proposed Structure	Square Footage of Lot	
Tax Assessor's Chart, Block & Lot Chart# <u>145</u> Block# <u>B</u> Lot# <u>018</u>	Owner: <u>State of Maine</u>	Telephone:
Lessee/Buyer's Name (if Applicable)	Applicant name, address & telephone:	Cost Of Work: \$ _____ Fee: \$ <u>30.00</u>
Current use: <u>National Guard Armory</u>		
If the location is currently vacant, what was prior use: _____		
Approximately how long has it been vacant: _____		
Proposed use: <u>Public Gathering March 28-30, 2003</u>		
Project description: <u>Greater Portland Landmarks Old House Trade Show</u>		
Contractor's name, address & telephone:		
Who should we contact when the permit is ready: <u>Cason Farrally - Planner</u>		
Mailing address: <u>165 State Street Portland ME 04101</u>		
We will contact you by phone when the permit is ready. You must come in and pick up the permit and review the requirements before starting any work, with a Plan Reviewer. A stop work order will be issued and a \$100.00 fee if any work starts before the permit is picked up. PHONE: <u>774-5561 x102</u>		

IF THE REQUIRED INFORMATION IS NOT INCLUDED IN THE SUBMISSIONS THE PERMIT WILL BE AUTOMATICALLY DENIED AT THE DISCRETION OF THE BUILDING/PLANNING DEPARTMENT, WE MAY REQUIRE ADDITIONAL INFORMATION IN ORDER TO APPROVE THIS PERMIT.

I hereby certify that I am the Owner of record of the named property, or that the owner of record authorizes the proposed work and that I have been authorized by the owner to make this application as his/her authorized agent. I agree to conform to all applicable laws of this jurisdiction. In addition, if a permit for work described in this application is issued, I certify that the Code Official's authorized representative shall have the authority to enter all areas covered by this permit at any reasonable hour to enforce the provisions of the codes applicable to this permit.

Signature of applicant: 	Date: <u>3/24/13</u>
---	----------------------

This is NOT a permit, you may not commence ANY work until the permit is issued. If you are in a Historic District you may be subject to additional permitting and fees with the Planning Department on the 4th floor of City Hall

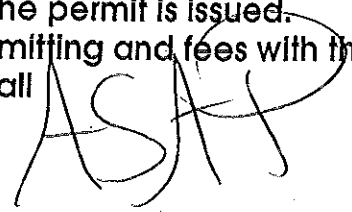

Entrance

EXIT

Vendors

Vendors

DRILL FLOOR

Vendors

EXIT

Kitchen

STORAGE BAYS

EXIT


SHEET B

STEVENS AVE ARMORY ME
1ST FLOOR PLAN 1140

MAINE ARMY NATIONAL GUARD
DATE 9 JAN 84
SCALE 1/2" = 1'-0"

DIRECTORATE FACILITIES ENGINEERING
FACILITIES MAP

ENCLOSURE #3

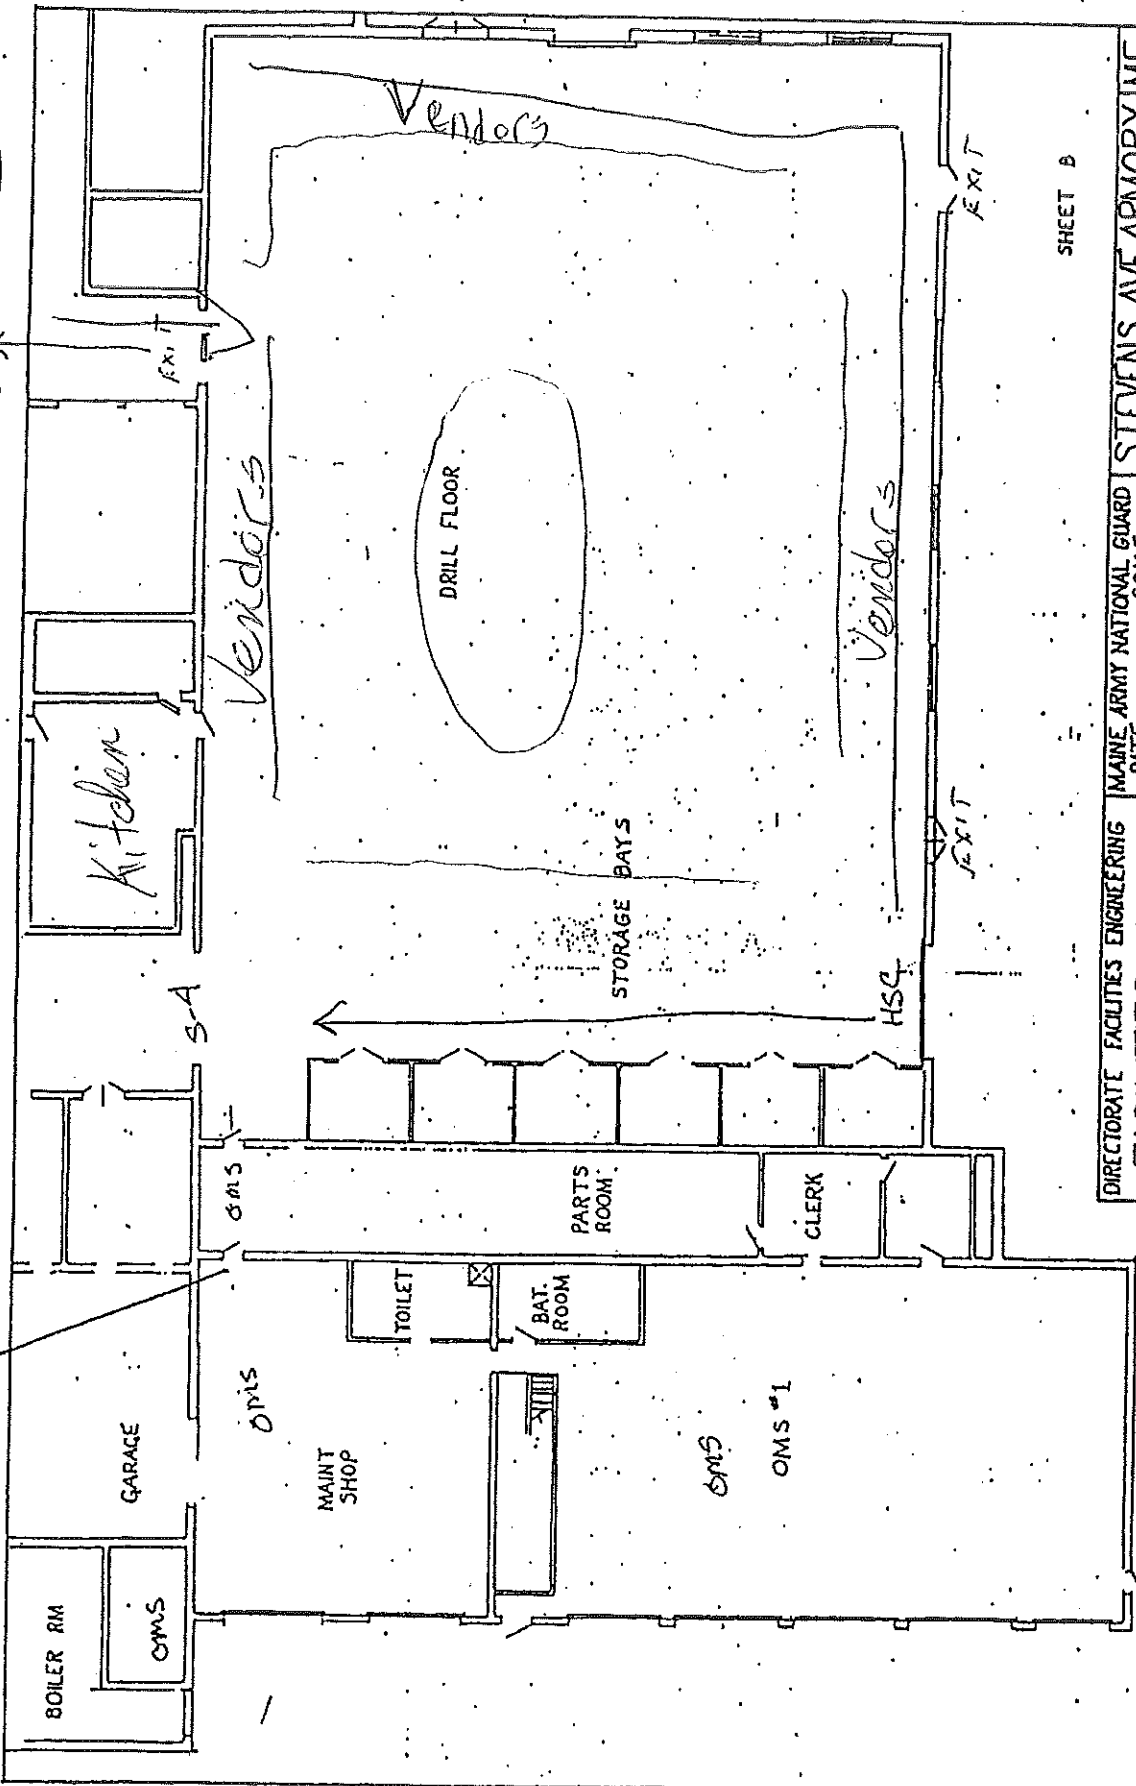

Problem with stairs side

BOILER RM

Oms

GARAGE

MAINT SHOP

TOILET

BAT. ROOM

PARTS ROOM

CLERK

Oms

Oms #1

HSC

S-A

Oms

DATE	9/85	UPDATE
BY		
CHKD		
APPD		