

DISPLAY THIS CARD ON PRINCIPAL FRONTAGE OF WORK CITY OF PORTLAND

BUILDING DEPARTMENT

PERMIT

Permit Number: 031360

Please Read Application And Notes, If Any, Attached

This is to certify that Timm Real Estate Llc /E.J. Construction
has permission to Amendment to permit #03-1000 add skid pad
AT 298 Canco Rd City of Portland 153 A017001

provided that the person or persons, firm or corporation accepting this permit shall comply with all of the provisions of the Statutes of the State and of the Ordinances of the City of Portland regulating the construction, maintenance and use of buildings and structures, and of the application on file in this department.

Apply to Public Works for street line and grade if nature of work requires such information.

Notification of inspection must be given and work on permit must be completed before this building or part thereof is leased or occupied. **48 HOUR NOTICE IS REQUIRED.**

A certificate of occupancy must be procured by owner before this building or part thereof is occupied.

OTHER REQUIRED APPROVALS

Fire Dept. [Signature]
Health Dept. _____
Appeal Board _____
Other _____
Department Name _____

[Signature]
Director - Building & Inspection Services

PENALTY FOR REMOVING THIS CARD

City of Portland, Maine - Building or Use Permit Application
 389 Congress Street, 04101 Tel: (207) 874-8703, Fax: (207) 874-8716

Permit No: 03-1360	Issue Date:	CBL: 153 A017001
-----------------------	-------------	---------------------

Location of Construction: 298 Canco Rd	Owner Name: Timm Real Estate Llc	Owner Address: 26 Piper Rd	Phone:
Business Name:	Contractor Name: E.J. Construction	Contractor Address: 10A Beach Street Portland	Phone 2077730776
Lessee/Buyer's Name	Phone:	Permit Type: Amendment to Commercial	Zone: 1M

Past Use: Commercial office space/ vacant, prior use vet's office	Proposed Use: Office space for DEP: Amendment to permit #03-1037, add skylight	Permit Fee: \$30.00	Cost of Work: \$1,000.00	CEO District: 2
Proposed Project Description: Amendment to permit #03-1037, add skylight		FIRE DEPT: <input checked="" type="checkbox"/> Approved <input type="checkbox"/> Denied	INSPECTION: Use Group: B Type: WA 11/19/03 Signature: [Signature]	
		Signature: [Signature]	Signature: [Signature]	
PEDESTRIAN ACTIVITIES DISTRICT (P.A.D.)				
Action: <input type="checkbox"/> Approved <input type="checkbox"/> Approved w/Conditions <input type="checkbox"/> Denied				
Signature: _____ Date: _____				


Permit Taken By: kwd	Date Applied For: 10/30/2003	Zoning Approval		
1. This permit application does not preclude the Applicant(s) from meeting applicable State and Federal Rules. 2. Building permits do not include plumbing, septic or electrical work. 3. Building permits are void if work is not started within six (6) months of the date of issuance. False information may invalidate a building permit and stop all work..	Special Zone or Reviews <input type="checkbox"/> Shoreland <input type="checkbox"/> Wetland <input type="checkbox"/> Flood Zone <input type="checkbox"/> Subdivision <input type="checkbox"/> Site Plan Maj <input type="checkbox"/> Minor <input type="checkbox"/> MM <input checked="" type="checkbox"/> Date: [Signature] 11/13/03	Zoning Appeal <input type="checkbox"/> Variance <input type="checkbox"/> Miscellaneous <input type="checkbox"/> Conditional Use <input type="checkbox"/> Interpretation <input type="checkbox"/> Approved <input type="checkbox"/> Denied Date: _____	Historic Preservation <input checked="" type="checkbox"/> Not in District or Landmark <input type="checkbox"/> Does Not Require Review <input type="checkbox"/> Requires Review <input type="checkbox"/> Approved <input type="checkbox"/> Approved w/Conditions <input type="checkbox"/> Denied Date: [Signature]	

CERTIFICATION

I hereby certify that I am the owner of record of the named property, or that the proposed work is authorized by the owner of record and that I have been authorized by the owner to make this application as his authorized agent and I agree to conform to all applicable laws of this jurisdiction. In addition, if a permit for work described in the application is issued, I certify that the code official's authorized representative shall have the authority to enter all areas covered by such permit at any reasonable hour to enforce the provision of the code(s) applicable to such permit.

 SIGNATURE OF APPLICANT ADDRESS DATE PHONE

 RESPONSIBLE PERSON IN CHARGE OF WORK, TITLE DATE PHONE

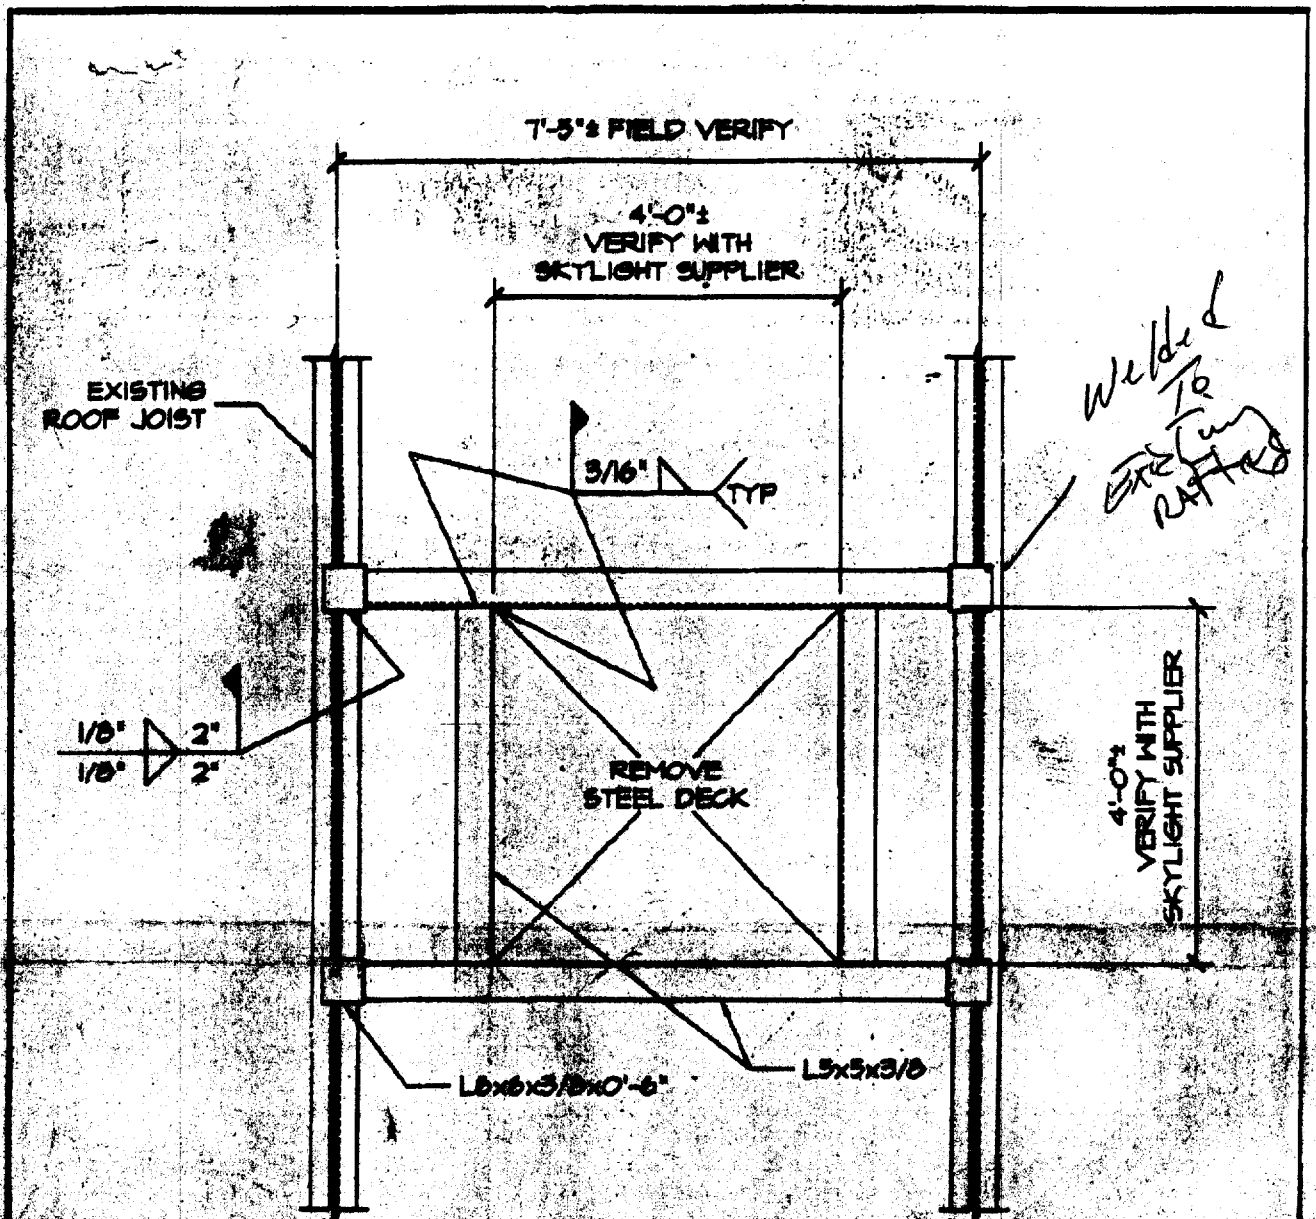

Robbins
5/27/04
415-4822

SKYLIGHT SUPPORT FRAME PLAN


1/2"=1'-0"

RELOCATE EXISTING HORIZONTAL BRIDGINGS INTERRUPTED BY SKYLIGHT TO CLOSEST PANEL POINT.

DEPT. OF BUILDING INSPECTION
 CITY OF PORTLAND, ME
RECEIVE
 OCT 29 2003

date	revision number
10/15/03	

DEP
 312 CANCO ROAD
 PORTLAND, ME

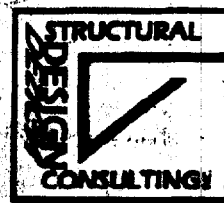


SK1

FOR: E J CONSTRUCTION

03-1360

All Purpose Building Permit Application

If you or the property owner owes real estate or personal property taxes or user charges on any property within the City, payment arrangements must be made before permits of any kind are accepted.

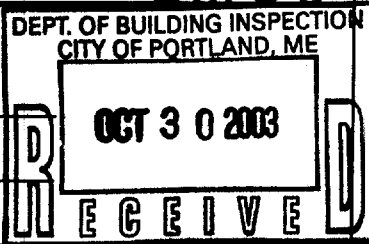Location/Address of Construction: <u>298/ 312 Guelo Rd. Portland, Me.</u>		
Total Square Footage of Proposed Structure <u>Skylite</u>	Square Footage of Lot	
Tax Assessor's Chart, Block & Lot Chart# <u>153</u> Block# <u>A</u> Lot# <u>017</u>	Owner: <u>Dary Timm</u>	Telephone:
Lessee/Buyer's Name (If Applicable)	Applicant name, address & telephone: <u>Robbie Jeffrey</u> <u>E.J. Construction</u> <u>10A Beach St. Port. Me.</u> <u>415-4822</u>	Cost Of Work: \$ <u>1,000</u> Fee: \$ <u>30.00</u>
Current use: <u>VACANT</u>	DEPT. OF BUILDING INSPECTION CITY OF PORTLAND, ME 	
If the location is currently vacant, what was prior use: <u>DMV</u>		
Approximately how long has it been vacant: <u>3 mo's</u>		
Proposed use: <u>DEP</u>	Project description: <u>Remove doors to permit # 031037</u>	
Contractor's name, address & telephone: <u>adding skylight</u>		
Who should we contact when the permit is ready: <u>Robbie Jeffrey</u> <u>E.J. Construction</u>		
Mailing address: <u>10A Beach St.</u> <u>Portland Me. 04101</u>		
We will contact you by phone when the permit is ready. You must come in and pick up the permit and review the requirements before starting any work, with a Plan Reviewer. A stop work order will be issued and a \$100.00 fee if any work starts before the permit is picked up. PHONE: <u>415-4822</u>		

IF THE REQUIRED INFORMATION IS NOT INCLUDED IN THE SUBMISSIONS THE PERMIT WILL BE AUTOMATICALLY DENIED AT THE DISCRETION OF THE BUILDING/PLANNING DEPARTMENT, WE MAY REQUIRE ADDITIONAL INFORMATION IN ORDER TO APPROVE THIS PERMIT.

I hereby certify that I am the Owner of record of the named property, or that the owner of record authorizes the proposed work and that I have been authorized by the owner to make this application as his/her authorized agent. I agree to conform to all applicable laws of this jurisdiction. In addition, if a permit for work described in this application is issued, I certify that the Code Official's authorized representative shall have the authority to enter all areas covered by this permit at any reasonable hour to enforce the provisions of the codes applicable to this permit.

Signature of applicant: <u>Robbie Jeffrey</u>	Date: <u>10/30/03</u>
---	-----------------------

This is NOT a permit, you may not commence ANY work until the permit is issued. If you are in a Historic District you may be subject to additional permitting and fees with the Planning Department on the 4th floor of City Hall