


9/2/69

These plans (sheets) and the specifications accompanying the same, covering construction work on 38-70 Front St. have been designed and drawn up by the undersigned according to the latest rules of engineering practice and to comply with the allowable working stresses, floor loads, etc. required by the Building Code of the City of Portland.

(Signature) *[Handwritten Signature]*
 by: *[Handwritten Name]*

This statement is to be signed by the individual responsible for the design, and he should indicate in the blank provided the particular work to which the statement applies.

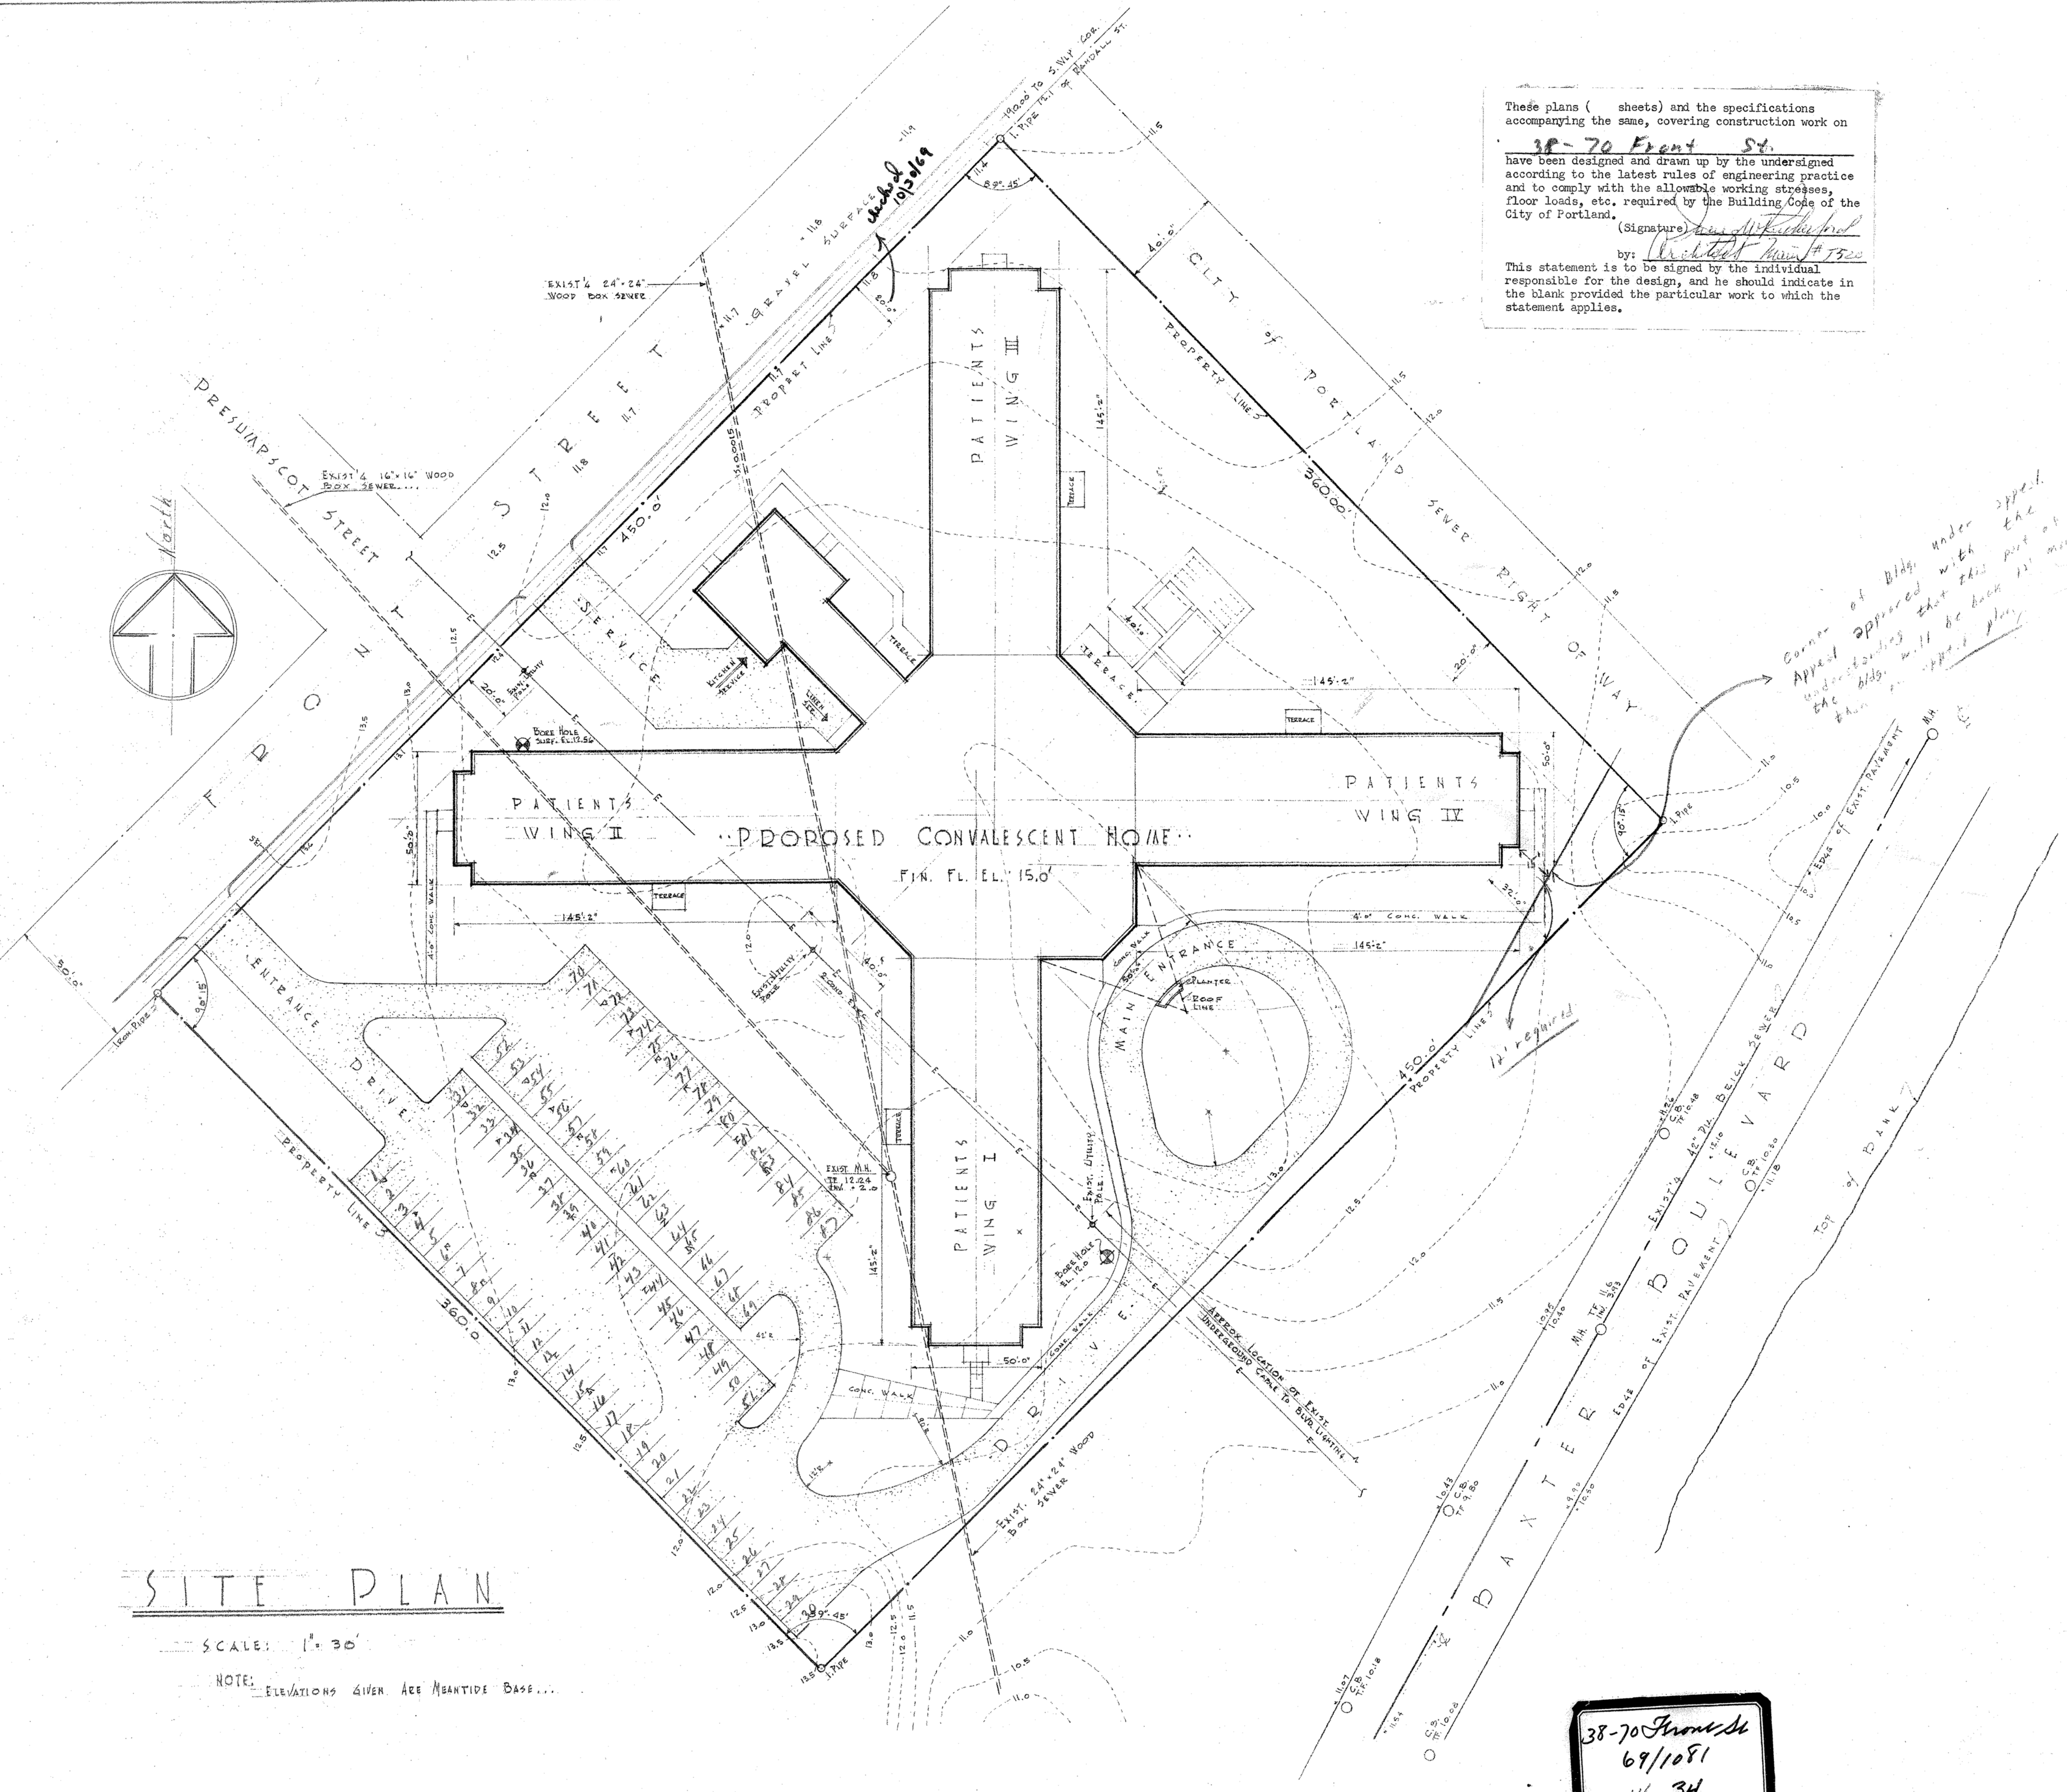

Corner of Bldg. under appeal. Appeal approved with the condition that the Bldg. will be built in accordance with the appeal plan.

SITE PLAN

SCALE: 1" = 30'
 NOTE: ELEVATIONS GIVEN ARE MEANTIDE BASE...

~~WORKING PLAN~~
 DATE REC'D.:
~~WORKING PLAN~~
 DATE REC'D.:

38-70 Front St.
 69/1081
 14-34

CONVALESCENT HOME
 PORTLAND - MAINE

FVF
 8-27-69

9-8
 69-12

SITE PLAN