

6 Meetinghouse Lane, West Bath, Maine 04530
 JAMES HOARE, Architectural Designer
 Phone (207) 344-6257

REVISIONS



CIAMPI RESIDENCE
 32 1/2 STEVENS AVE
 PORTLAND, MAINE

DRAWINGS THIS SHEET
CROSS SECTION

DATE	
Number	
Drawn By	
Checked By	

AB-3

REPRODUCTION OR REUSE OF THIS DOCUMENT WITHOUT WRITTEN PERMISSION FROM JAMES HOARE IS STRICTLY PROHIBITED.

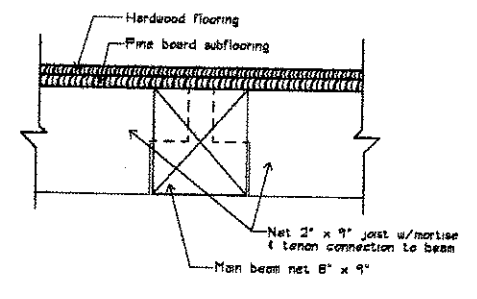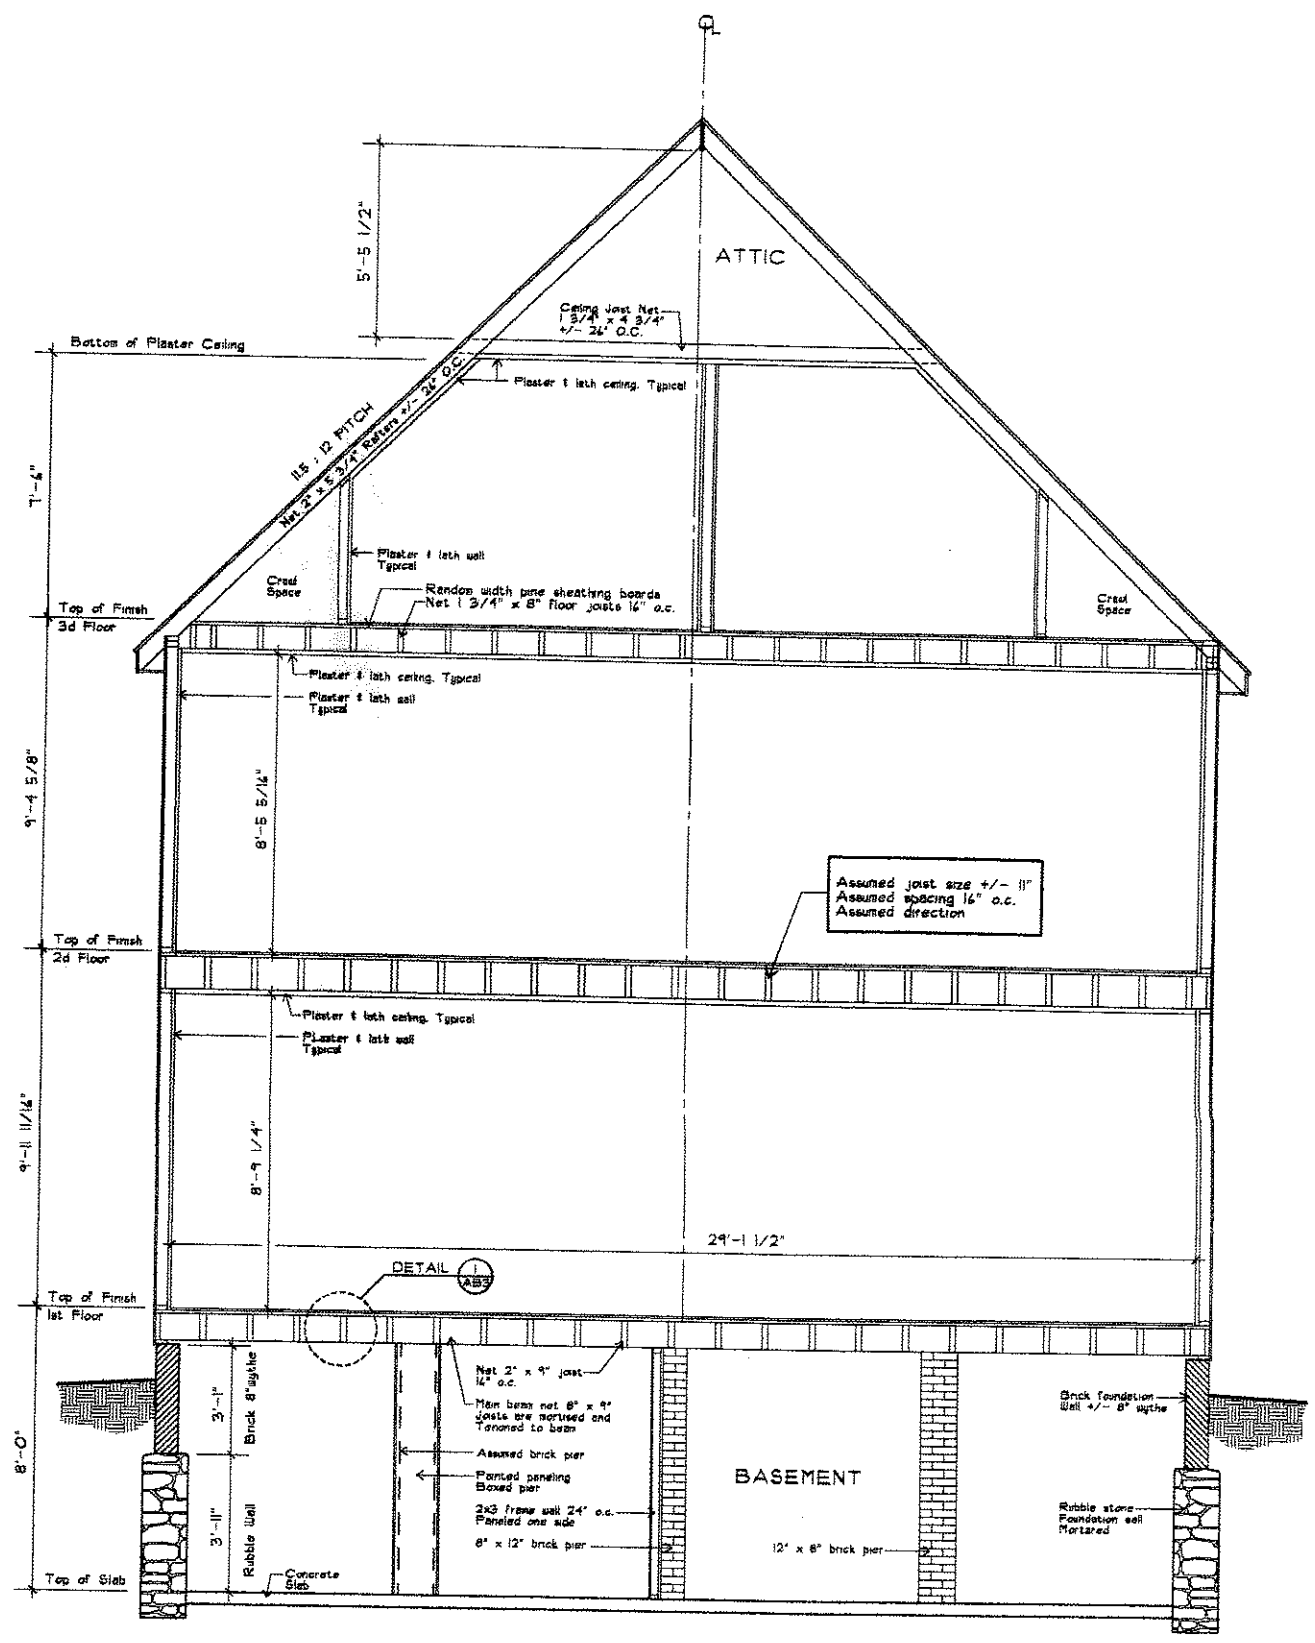

DETAIL 1
 AB-3

CROSS SECTION
 AS-BUILT 3/8"-1'-0"