



STEVENS SIDEWALK

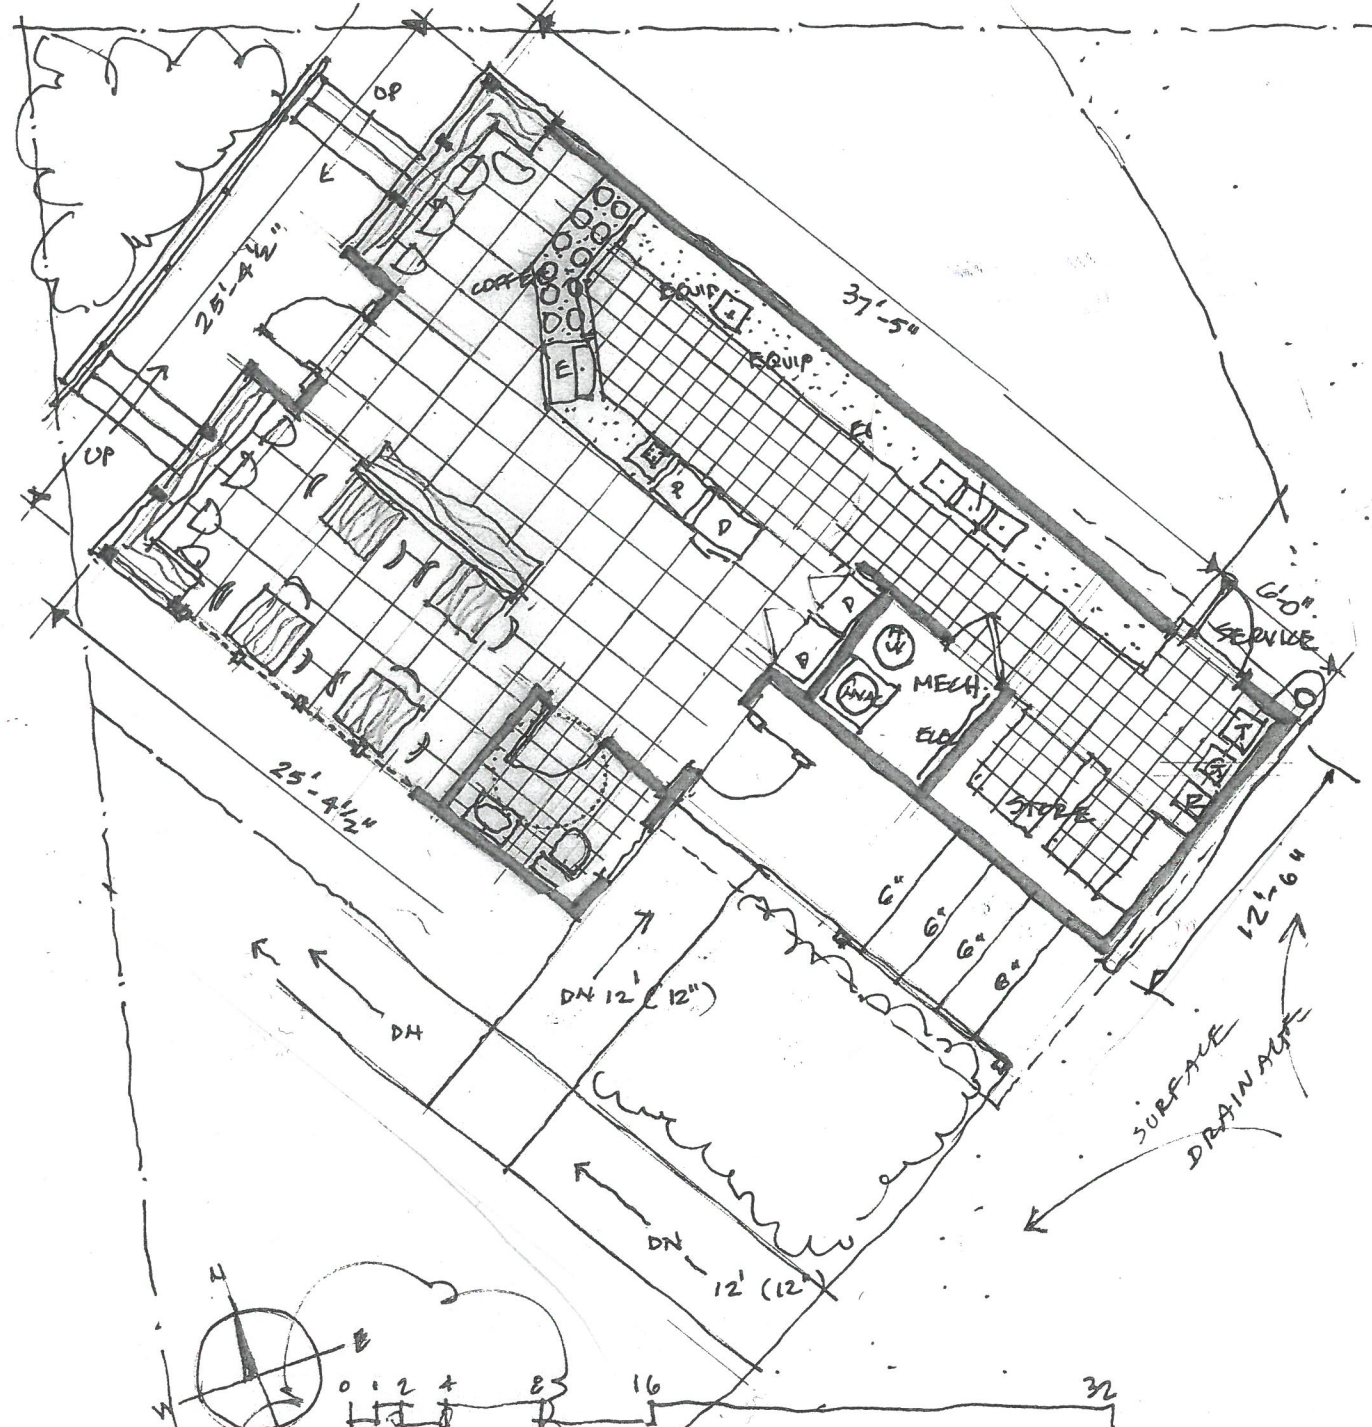

CROOKED MILE CONCEPT FLOOR PLAN
 1" = 2'-0"
 EXISTING FOOTPRINT 11.30.2017
 W/ ADDED 6'x12'-6" SERVICE 01.10.2018

BRIGHTON SIDEWALK

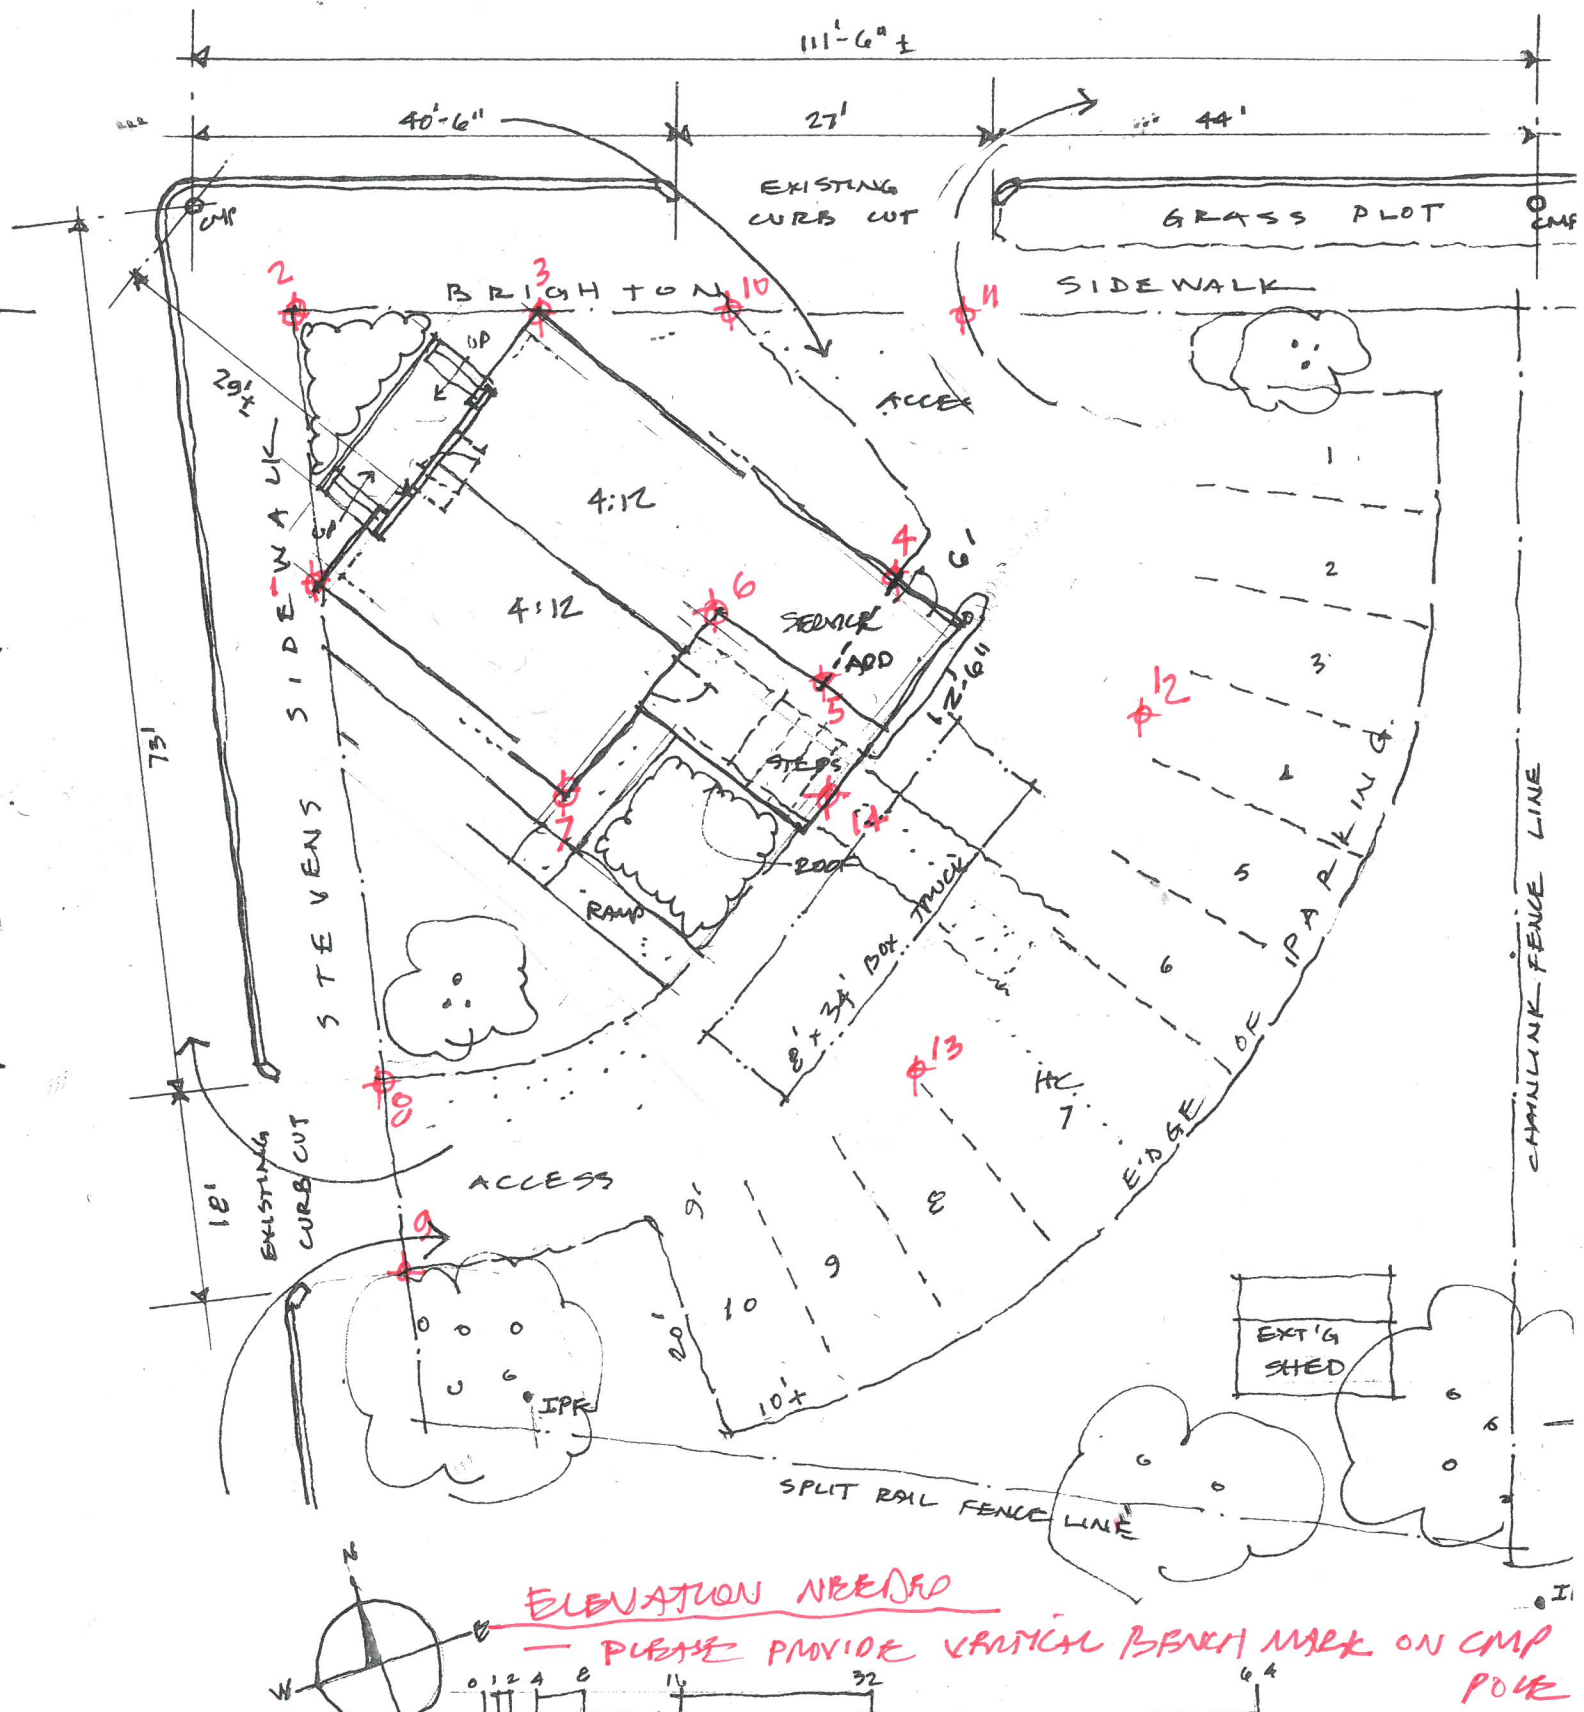

ELEVATION NEEDED
 — PLEASE PROVIDE VERTICAL BENCH MARK ON CMP POLE

CROOKED MILE SITE PLAN CONCEPT 11.30.2017
 1" = 16'-0" EXISTING FOOTPRINT EXISTING CURB CUTS
 - BASED ON APPROXIMATE FIELD DIMENSIONS -
 W/ ADDED 6'x12'-6" SERVICE 01.10.2018