


DOOR SCHEDULE	MARK	DOOR	DOOR	REMARKS
		WIDTH	HEIGHT	
FIRST FLOOR				
1	PR.	3'-0"	7'-0"	ENTRY DOOR
2	PR.	2'-0"	6'-8"	CLOSET
3	PR.	3'-0"	6'-8"	ENTRY DOOR
4	PR.	2'-4"	6'-8"	BATHROOM
5	PR.	3'-0"	6'-8"	BATHROOM
6	PR.	2'-4"	6'-8"	KITCHEN
7	PR.	2'-4"	6'-8"	ENTRY
8	PR.	2'-4"	6'-8"	STUDY
9	PR.	3'-0"	6'-8"	ENTRY DOOR
10	PR.	2'-4"	6'-8"	CLOSET
11	PR.	2'-4"	6'-8"	CLOSET
12	PR.	3'-0"	6'-8"	TO GARAGE - 20 MIN. RATED
13	PR.	2'-4"	6'-8"	BATHROOM
14	PR.	3'-0"	6'-8"	CLOSET - SLIDER
15	PR.	3'-0"	6'-8"	ENTRY
16	PR.	3'-0"	6'-8"	ENTRY
17	PR.	2'-0"	6'-8"	ENTRY
18	PR.	2'-0"	6'-8"	CLOSET
19	PR.	3'-0"	7'-0"	ENTRY
20	PR.	2'-8"	6'-8"	TV ROOM - 20 MIN. RATED DOOR
21	PR.	2'-4"	6'-8"	CLOSET
22	PR.	2'-8"	6'-8"	BEDROOM
23	PR.	2'-4"	6'-8"	CLOSET
24	PR.	2'-8"	6'-8"	BEDROOM
25	PR.	3'-0"	6'-8"	CLOSET
26	PR.	2'-4"	6'-8"	SLIDER - DECK
27	PR.	2'-4"	6'-8"	BATHROOM
28	PR.	2'-0"	6'-8"	BATHROOM
29	PR.	2'-0"	6'-8"	BATHROOM
30	PR.	2'-8"	6'-8"	BEDROOM
31	PR.	2'-8"	6'-8"	BEDROOM
32	PR.	2'-8"	6'-8"	BEDROOM
33	PR.	2'-8"	6'-8"	BEDROOM
34	PR.	3'-0"	6'-8"	HALLWAY
35	PR.	2'-8"	6'-8"	BATHROOM
36	PR.	2'-8"	6'-8"	BATHROOM
37	PR.	2'-8"	6'-8"	BEDROOM
38	PR.	2'-0"	6'-8"	CLOSET - SLIDER
39	PR.	2'-8"	6'-8"	BEDROOM
40	PR.	2'-0"	6'-8"	CLOSET - SLIDER
41	PR.	2'-8"	6'-8"	BEDROOM
42	PR.	2'-8"	6'-8"	CLOSET
43	PR.	2'-0"	6'-8"	BATHROOM
44	PR.	2'-8"	6'-8"	BATHROOM
45	PR.	2'-8"	6'-8"	BEDROOM
46	PR.	2'-8"	6'-8"	BEDROOM
47	PR.	2'-8"	6'-8"	CLOSET - SLIDER
48	PR.	2'-4"	6'-8"	BATHROOM
49	PR.	2'-4"	6'-8"	BATHROOM
50	PR.	3'-0"	6'-8"	STORAGE AREA
51	PR.	3'-0"	6'-8"	STORAGE AREA
52	PR.	2'-4"	6'-8"	BATHROOM
53	PR.	2'-4"	6'-8"	CLOSET
54	PR.	2'-4"	6'-8"	BATHROOM
55	PR.	2'-8"	6'-8"	BEDROOM
56	PR.	2'-8"	6'-8"	CLOSET - SLIDER
57	PR.	2'-8"	6'-8"	BEDROOM
58	PR.	2'-8"	6'-8"	CLOSET - SLIDER
59	PR.	2'-8"	6'-8"	BEDROOM
60	PR.	2'-4"	6'-8"	CLOSET - SLIDER
61	PR.	3'-0"	6'-8"	DANE ROOM

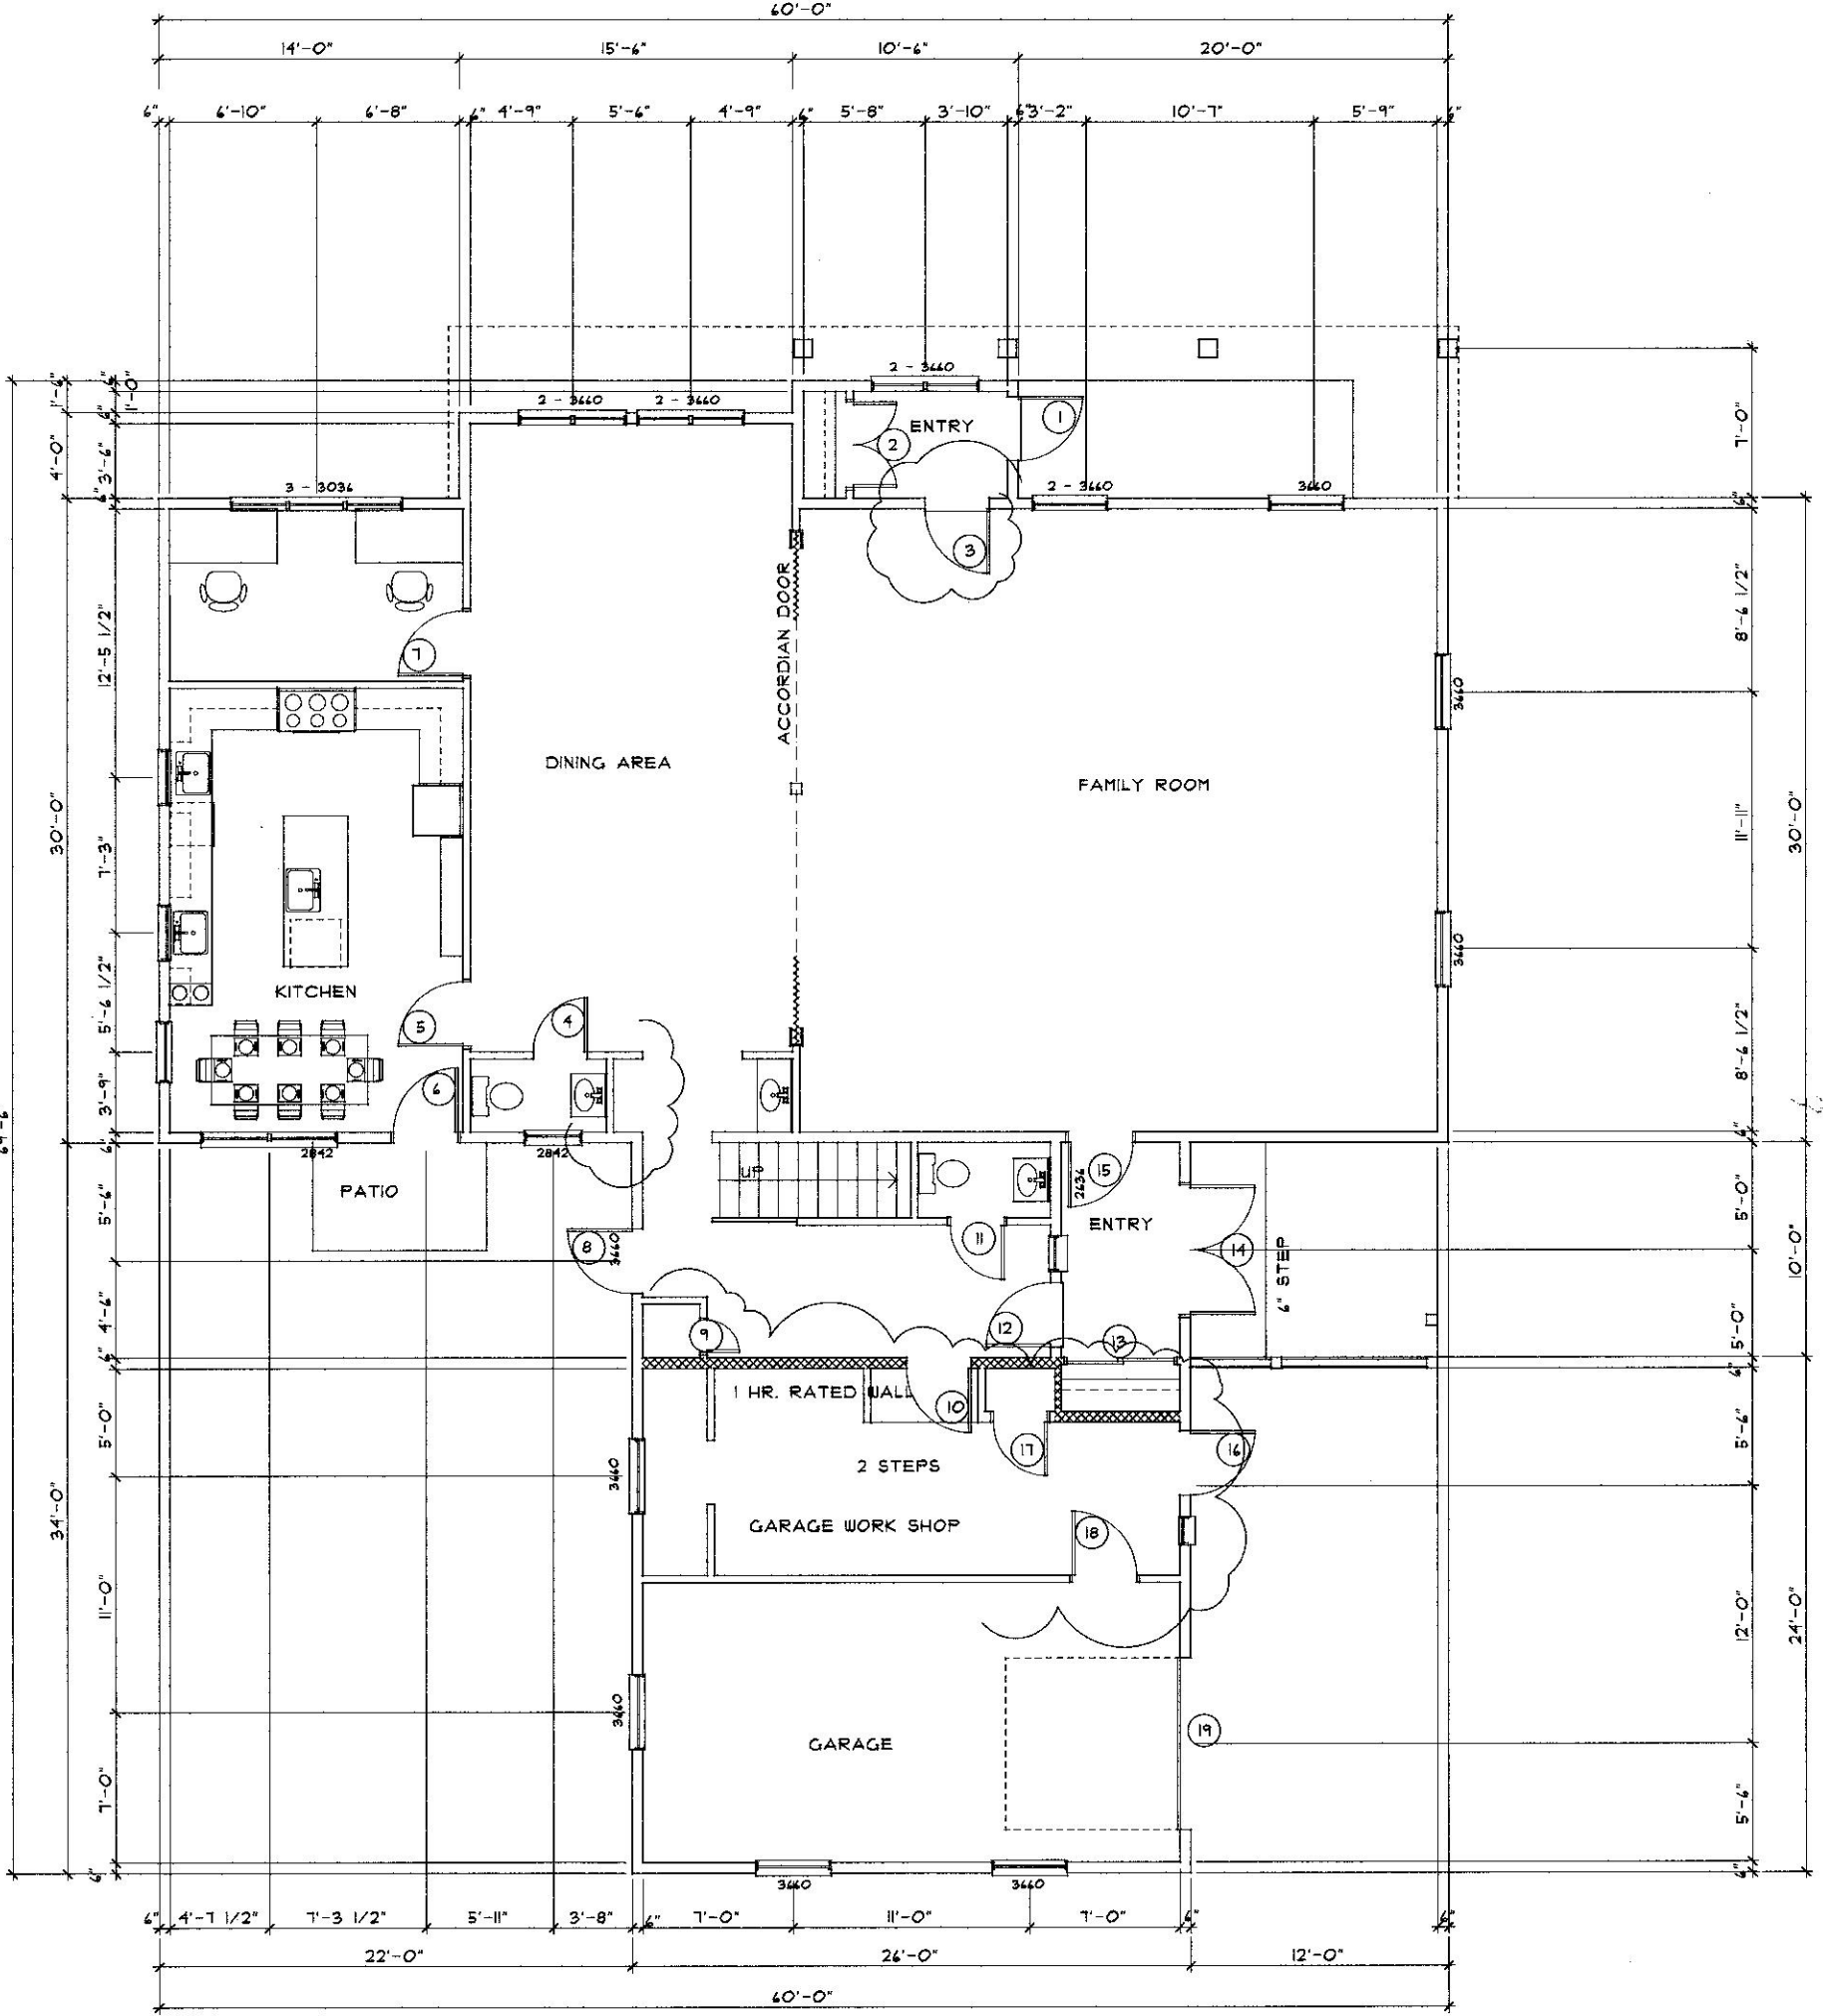

FIRST FLOOR PLAN
SCALE: 1/4" = 1'-0"

OF SHEETS A-2	ARCHITECT Gleason Architects P.O. BOX 596 STRATHAM, NEW HAMPSHIRE 03885 603 772-7370 FAX. NO. 603 772-6044	NEW RESIDENCE 11 POMEROY STREET PORTLAND, MAINE	<table border="1"> <thead> <tr> <th>NO.</th> <th>DESCRIPTION OF REVISION</th> <th>DATE</th> </tr> </thead> <tbody> <tr> <td>1</td> <td>CHANGED FLOOR PLAN</td> <td>10/25/13</td> </tr> <tr> <td>2</td> <td>REVISED PERMIT SET</td> <td>06/09/14</td> </tr> <tr> <td>3</td> <td>AS BUILT - CHANGES</td> <td>02/23/15</td> </tr> </tbody> </table>	NO.	DESCRIPTION OF REVISION	DATE	1	CHANGED FLOOR PLAN	10/25/13	2	REVISED PERMIT SET	06/09/14	3	AS BUILT - CHANGES	02/23/15
	NO.	DESCRIPTION OF REVISION	DATE												
1	CHANGED FLOOR PLAN	10/25/13													
2	REVISED PERMIT SET	06/09/14													
3	AS BUILT - CHANGES	02/23/15													
ENGINEER DATE: 04/15/12 PROJECT NO. 201207 SHEET NO.															