


DOOR SCHEDULE	MARK	DOOR	DOOR	REMARKS
		WIDTH	HEIGHT	
FIRST FLOOR				
1	PR	3'-0"	7'-0"	ENTRY DOOR
2	PR	2'-0"	6'-8"	CLOSET DOOR
3	PR	2'-0"	6'-8"	ENTRY DOOR
4	PR	2'-0"	6'-8"	BATHROOM
5	PR	2'-0"	6'-8"	BATHROOM
6	PR	2'-0"	6'-8"	KITCHEN
7	PR	2'-0"	6'-8"	ENTRY
8	PR	2'-0"	6'-8"	ENTRY DOOR
9	PR	2'-0"	6'-8"	CLOSET
10	PR	2'-0"	6'-8"	CLOSET - 20 MIN. RATED
11	PR	2'-0"	6'-8"	BATHROOM
12	PR	2'-0"	6'-8"	BATHROOM
13	PR	2'-0"	6'-8"	CLOSET - SLIDER
14	PR	2'-0"	6'-8"	ENTRY
15	PR	2'-0"	6'-8"	ENTRY
16	PR	2'-0"	6'-8"	CLOSET
17	PR	2'-0"	6'-8"	ENTRY
18	PR	2'-0"	6'-8"	ENTRY
19	PR	2'-0"	6'-8"	OVERHEAD DOOR
SECOND FLOOR				
20	PR	2'-8"	6'-8"	TV ROOM - 20 MIN. RATED DOOR
21	PR	2'-4"	6'-8"	CLOSET
22	PR	2'-4"	6'-8"	BEDROOM
23	PR	2'-4"	6'-8"	CLOSET
24	PR	2'-4"	6'-8"	BEDROOM
25	PR	2'-4"	6'-8"	CLOSET
26	PR	2'-4"	6'-8"	SLIDER - DECK
27	PR	2'-4"	6'-8"	BATHROOM
28	PR	2'-4"	6'-8"	BATHROOM
29	PR	2'-4"	6'-8"	BATHROOM
30	PR	2'-4"	6'-8"	BATHROOM
31	PR	2'-4"	6'-8"	CLOSET - SLIDER
32	PR	2'-4"	6'-8"	BATHROOM
33	PR	2'-4"	6'-8"	BEDROOM
34	PR	2'-4"	6'-8"	CLOSET - SLIDER
35	PR	2'-4"	6'-8"	HALLWAY
36	PR	2'-4"	6'-8"	BATHROOM
37	PR	2'-4"	6'-8"	BEDROOM
38	PR	2'-4"	6'-8"	CLOSET - SLIDER
39	PR	2'-4"	6'-8"	BEDROOM
40	PR	2'-4"	6'-8"	CLOSET - SLIDER
41	PR	2'-4"	6'-8"	CLOSET
42	PR	2'-4"	6'-8"	BEDROOM
43	PR	2'-4"	6'-8"	BATHROOM
44	PR	2'-4"	6'-8"	BATHROOM
45	PR	2'-4"	6'-8"	BATHROOM
46	PR	2'-4"	6'-8"	CLOSET - SLIDER
47	PR	2'-4"	6'-8"	BEDROOM
48	PR	2'-4"	6'-8"	CLOSET - SLIDER
49	PR	2'-4"	6'-8"	BEDROOM
50	PR	2'-4"	6'-8"	CLOSET - SLIDER
51	PR	2'-4"	6'-8"	BEDROOM
52	PR	2'-4"	6'-8"	CLOSET - SLIDER
53	PR	2'-4"	6'-8"	BEDROOM
54	PR	2'-4"	6'-8"	CLOSET - SLIDER
55	PR	2'-4"	6'-8"	BEDROOM
56	PR	2'-4"	6'-8"	CLOSET - SLIDER
57	PR	2'-4"	6'-8"	BEDROOM
58	PR	2'-4"	6'-8"	CLOSET - SLIDER
59	PR	2'-4"	6'-8"	BEDROOM
60	PR	2'-4"	6'-8"	CLOSET - SLIDER
61	PR	2'-4"	6'-8"	LAUNDRY
THIRD FLOOR				
62	PR	2'-4"	6'-8"	STORAGE AREA
63	PR	2'-4"	6'-8"	STORAGE AREA
64	PR	2'-4"	6'-8"	BATHROOM
65	PR	2'-4"	6'-8"	CLOSET
66	PR	2'-4"	6'-8"	BATHROOM
67	PR	2'-4"	6'-8"	BATHROOM
68	PR	2'-4"	6'-8"	BATHROOM
69	PR	2'-4"	6'-8"	BATHROOM
70	PR	2'-4"	6'-8"	BATHROOM
71	PR	2'-4"	6'-8"	CLOSET - SLIDER
72	PR	2'-4"	6'-8"	BATHROOM
73	PR	2'-4"	6'-8"	BATHROOM
74	PR	2'-4"	6'-8"	CLOSET - SLIDER
75	PR	2'-4"	6'-8"	BATHROOM
76	PR	2'-4"	6'-8"	BATHROOM
77	PR	2'-4"	6'-8"	CLOSET - SLIDER
78	PR	2'-4"	6'-8"	BATHROOM
79	PR	2'-4"	6'-8"	BATHROOM
80	PR	2'-4"	6'-8"	CLOSET - SLIDER
81	PR	2'-4"	6'-8"	BATHROOM
82	PR	2'-4"	6'-8"	BATHROOM
83	PR	2'-4"	6'-8"	CLOSET - SLIDER
84	PR	2'-4"	6'-8"	BATHROOM
85	PR	2'-4"	6'-8"	BATHROOM
86	PR	2'-4"	6'-8"	CLOSET - SLIDER
87	PR	2'-4"	6'-8"	BATHROOM
88	PR	2'-4"	6'-8"	BATHROOM
89	PR	2'-4"	6'-8"	CLOSET - SLIDER
90	PR	2'-4"	6'-8"	BATHROOM
91	PR	2'-4"	6'-8"	BATHROOM
92	PR	2'-4"	6'-8"	CLOSET - SLIDER
93	PR	2'-4"	6'-8"	BATHROOM
94	PR	2'-4"	6'-8"	BATHROOM
95	PR	2'-4"	6'-8"	CLOSET - SLIDER
96	PR	2'-4"	6'-8"	BATHROOM
97	PR	2'-4"	6'-8"	BATHROOM
98	PR	2'-4"	6'-8"	CLOSET - SLIDER
99	PR	2'-4"	6'-8"	BATHROOM
100	PR	2'-4"	6'-8"	BATHROOM

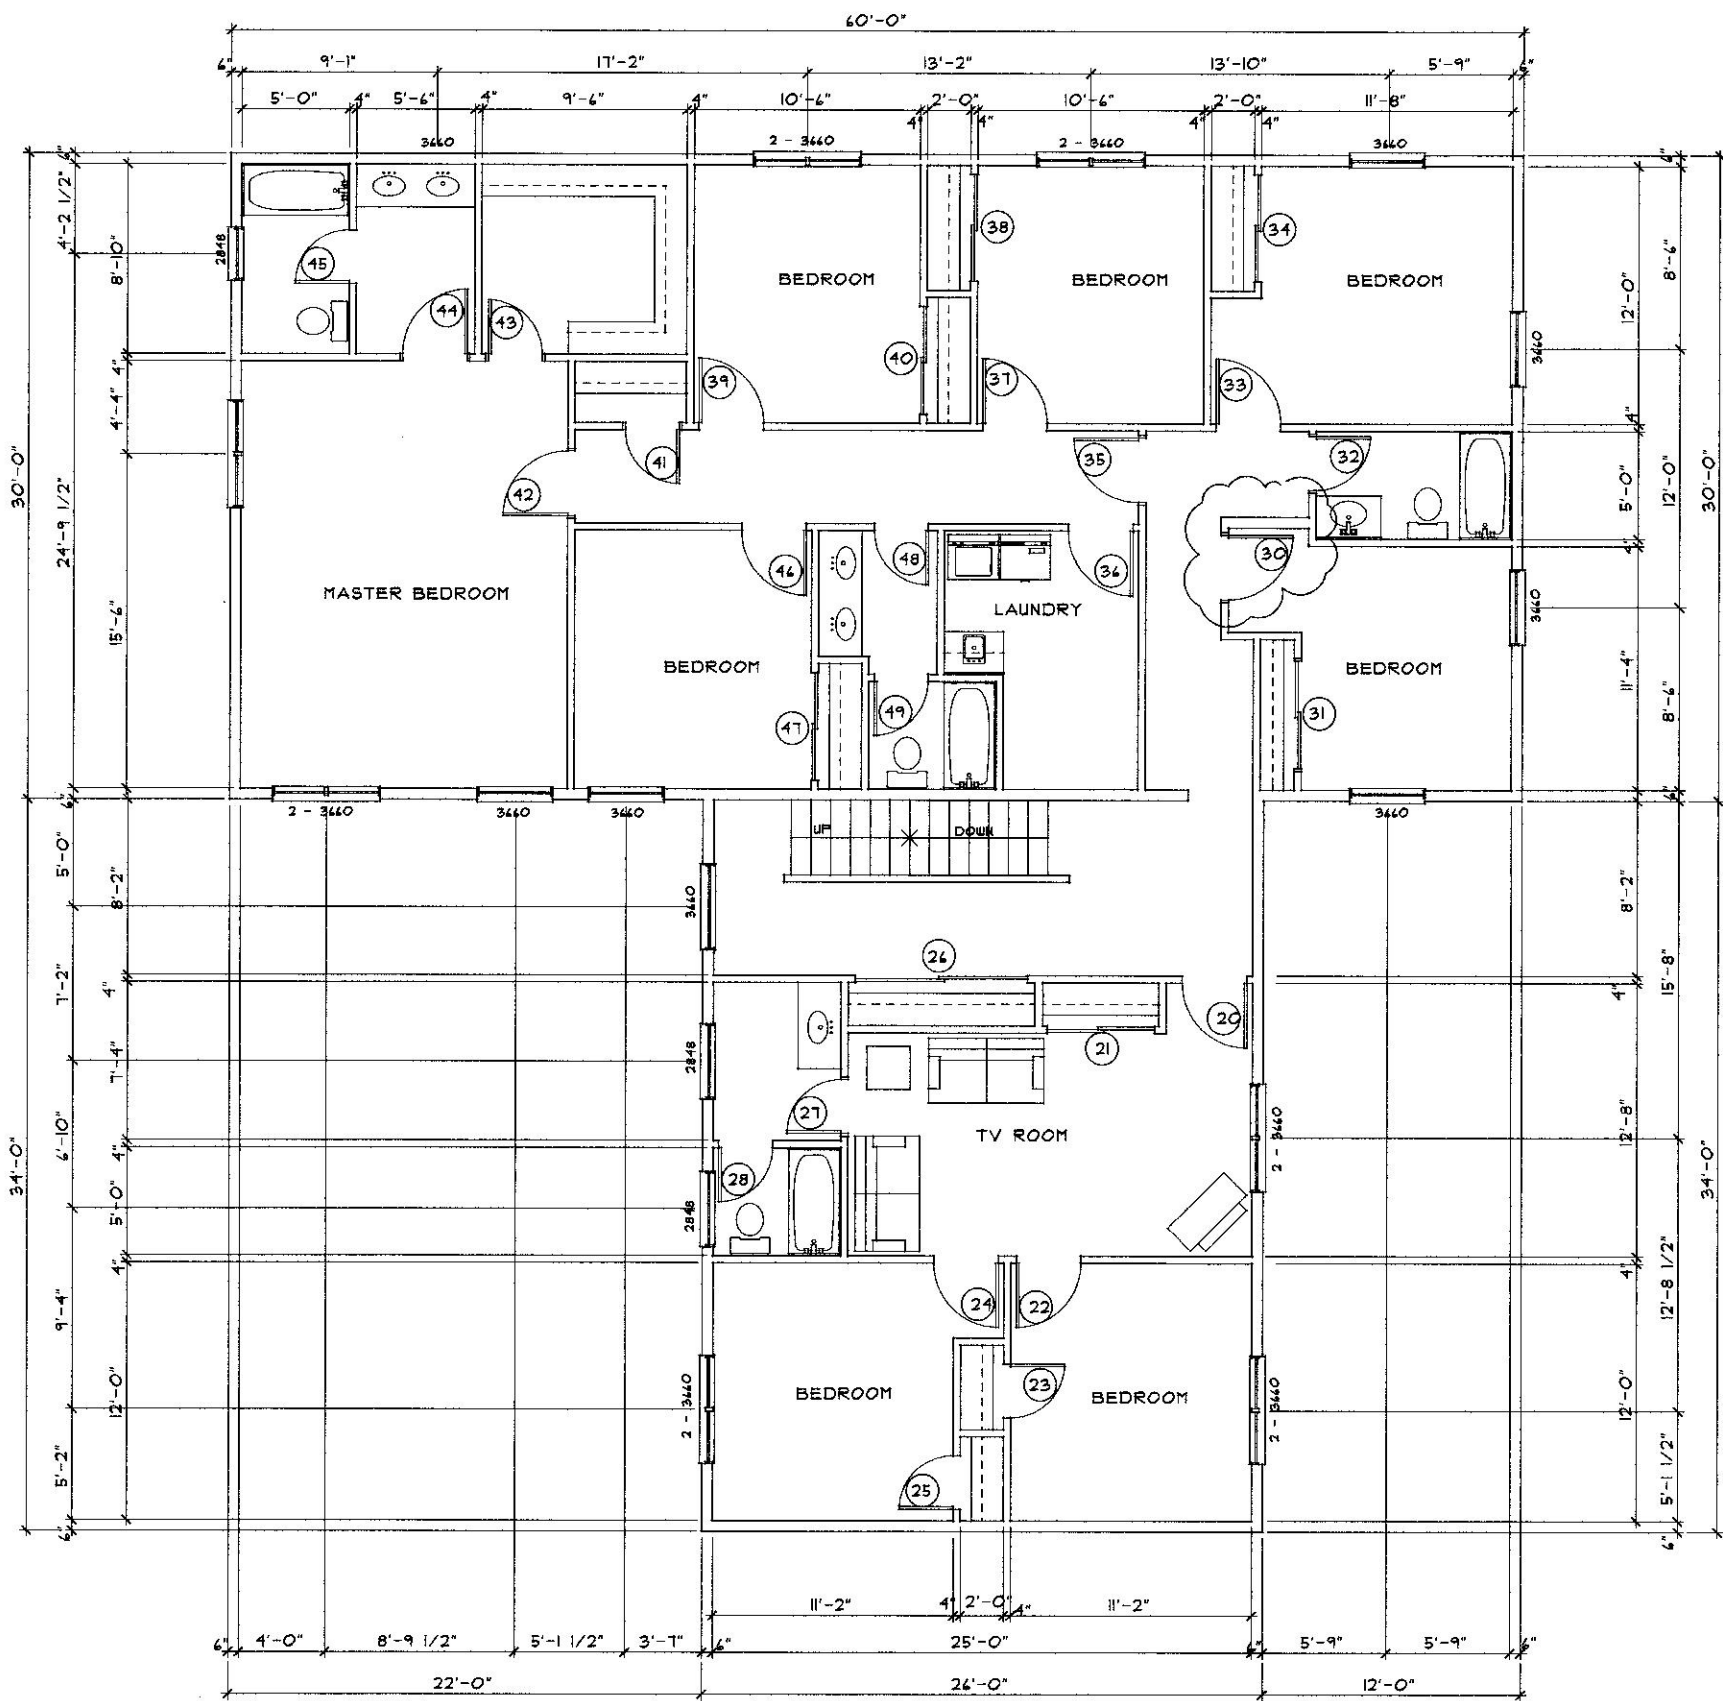

SECOND FLOOR PLAN

SCALE: 1/4" = 1'-0"

OF SHEETS A-3	ARCHITECT	Gleason Architects P.O. BOX 596 STRATHAM, NEW HAMPSHIRE 03885 603 772-7370 FAX. NO. 603 772-6044	NEW RESIDENCE 11 POMEROY STREET PORTLAND, MAINE	NO.	DESCRIPTION OF REVISION	DATE
	ENGINEER			1	CHANGED FLOOR PLAN	10/25/13
	DATE: 04/15/12			2	REVISED PERMIT SET	06/09/14
PROJECT NO. 201207	SHEET NO.		3	AS BUILT - CHANGES	02/23/15	