


DOOR SCHEDULE	MARK	DOOR	DOOR	REMARKS
		WIDTH	HEIGHT	
<b>FIRST FLOOR</b>				
1.	PR.	3'-0"	7'-0"	ENTRY DOOR
2.	PR.	3'-0"	6'-8"	CLOSET
3.	PR.	3'-0"	6'-8"	ENTRY DOOR
4.	PR.	3'-0"	6'-8"	BATHROOM
5.	PR.	3'-0"	6'-8"	KITCHEN
6.	PR.	2'-4"	6'-8"	ENTRY
7.	PR.	2'-4"	6'-8"	STUDY
8.	PR.	3'-0"	6'-8"	ENTRY DOOR
9.	PR.	2'-4"	6'-8"	CLOSET
10.	PR.	3'-0"	6'-8"	TO GARAGE - 20 MIN. RATED
11.	PR.	2'-4"	6'-8"	BATHROOM
12.	PR.	3'-0"	6'-8"	ENTRY
13.	PR.	2'-4"	6'-8"	CLOSET - SLIDER
14.	PR.	3'-0"	6'-8"	ENTRY
15.	PR.	3'-0"	6'-8"	ENTRY
16.	PR.	3'-0"	6'-8"	ENTRY
17.	PR.	2'-0"	6'-8"	CLOSET
18.	PR.	3'-0"	7'-0"	ENTRY
19.	PR.	8'-0"	8'-0"	OVERHEAD DOOR
<b>SECOND FLOOR</b>				
20.	PR.	2'-8"	6'-8"	TV ROOM - 20 MIN. RATED DOOR
21.	PR.	2'-4"	6'-8"	CLOSET
22.	PR.	2'-8"	6'-8"	BEDROOM
23.	PR.	2'-4"	6'-8"	CLOSET
24.	PR.	2'-8"	6'-8"	BEDROOM
25.	PR.	3'-0"	6'-8"	CLOSET
26.	PR.	2'-4"	6'-8"	SLIDER - DECK
27.	PR.	2'-4"	6'-8"	BATHROOM
28.	PR.	2'-0"	6'-8"	BATHROOM
29.	PR.	2'-4"	6'-8"	BATHROOM
30.	PR.	2'-8"	6'-8"	BEDROOM
31.	PR.	2'-4"	6'-8"	CLOSET - SLIDER
32.	PR.	2'-4"	6'-8"	BATHROOM
33.	PR.	1'-8"	6'-8"	BEDROOM
34.	PR.	1'-8"	6'-8"	CLOSET - SLIDER
35.	PR.	3'-0"	6'-8"	HALLWAY
36.	PR.	2'-8"	6'-8"	BATHROOM
37.	PR.	2'-0"	6'-8"	BEDROOM
38.	PR.	2'-0"	6'-8"	CLOSET - SLIDER
39.	PR.	2'-8"	6'-8"	BEDROOM
40.	PR.	2'-0"	6'-8"	CLOSET - SLIDER
41.	PR.	2'-8"	6'-8"	BEDROOM
42.	PR.	2'-0"	6'-8"	CLOSET
43.	PR.	2'-0"	6'-8"	BEDROOM
44.	PR.	2'-8"	6'-8"	BATHROOM
45.	PR.	2'-8"	6'-8"	BATHROOM
46.	PR.	2'-8"	6'-8"	BATHROOM
47.	PR.	2'-4"	6'-8"	CLOSET - SLIDER
48.	PR.	2'-4"	6'-8"	BATHROOM
49.	PR.	2'-4"	6'-8"	BATHROOM
<b>THIRD FLOOR</b>				
50.	PR.	3'-0"	6'-8"	STORAGE AREA
51.	PR.	3'-0"	6'-8"	STORAGE AREA
52.	PR.	2'-4"	6'-8"	BATHROOM
53.	PR.	2'-4"	6'-8"	CLOSET
54.	PR.	2'-4"	6'-8"	BATHROOM
55.	PR.	2'-8"	6'-8"	BEDROOM
56.	PR.	2'-8"	6'-8"	BEDROOM
57.	PR.	2'-4"	6'-8"	CLOSET - SLIDER
58.	PR.	2'-4"	6'-8"	BEDROOM
59.	PR.	2'-4"	6'-8"	BEDROOM
60.	PR.	2'-4"	6'-8"	BEDROOM
61.	PR.	3'-0"	6'-8"	GAME ROOM

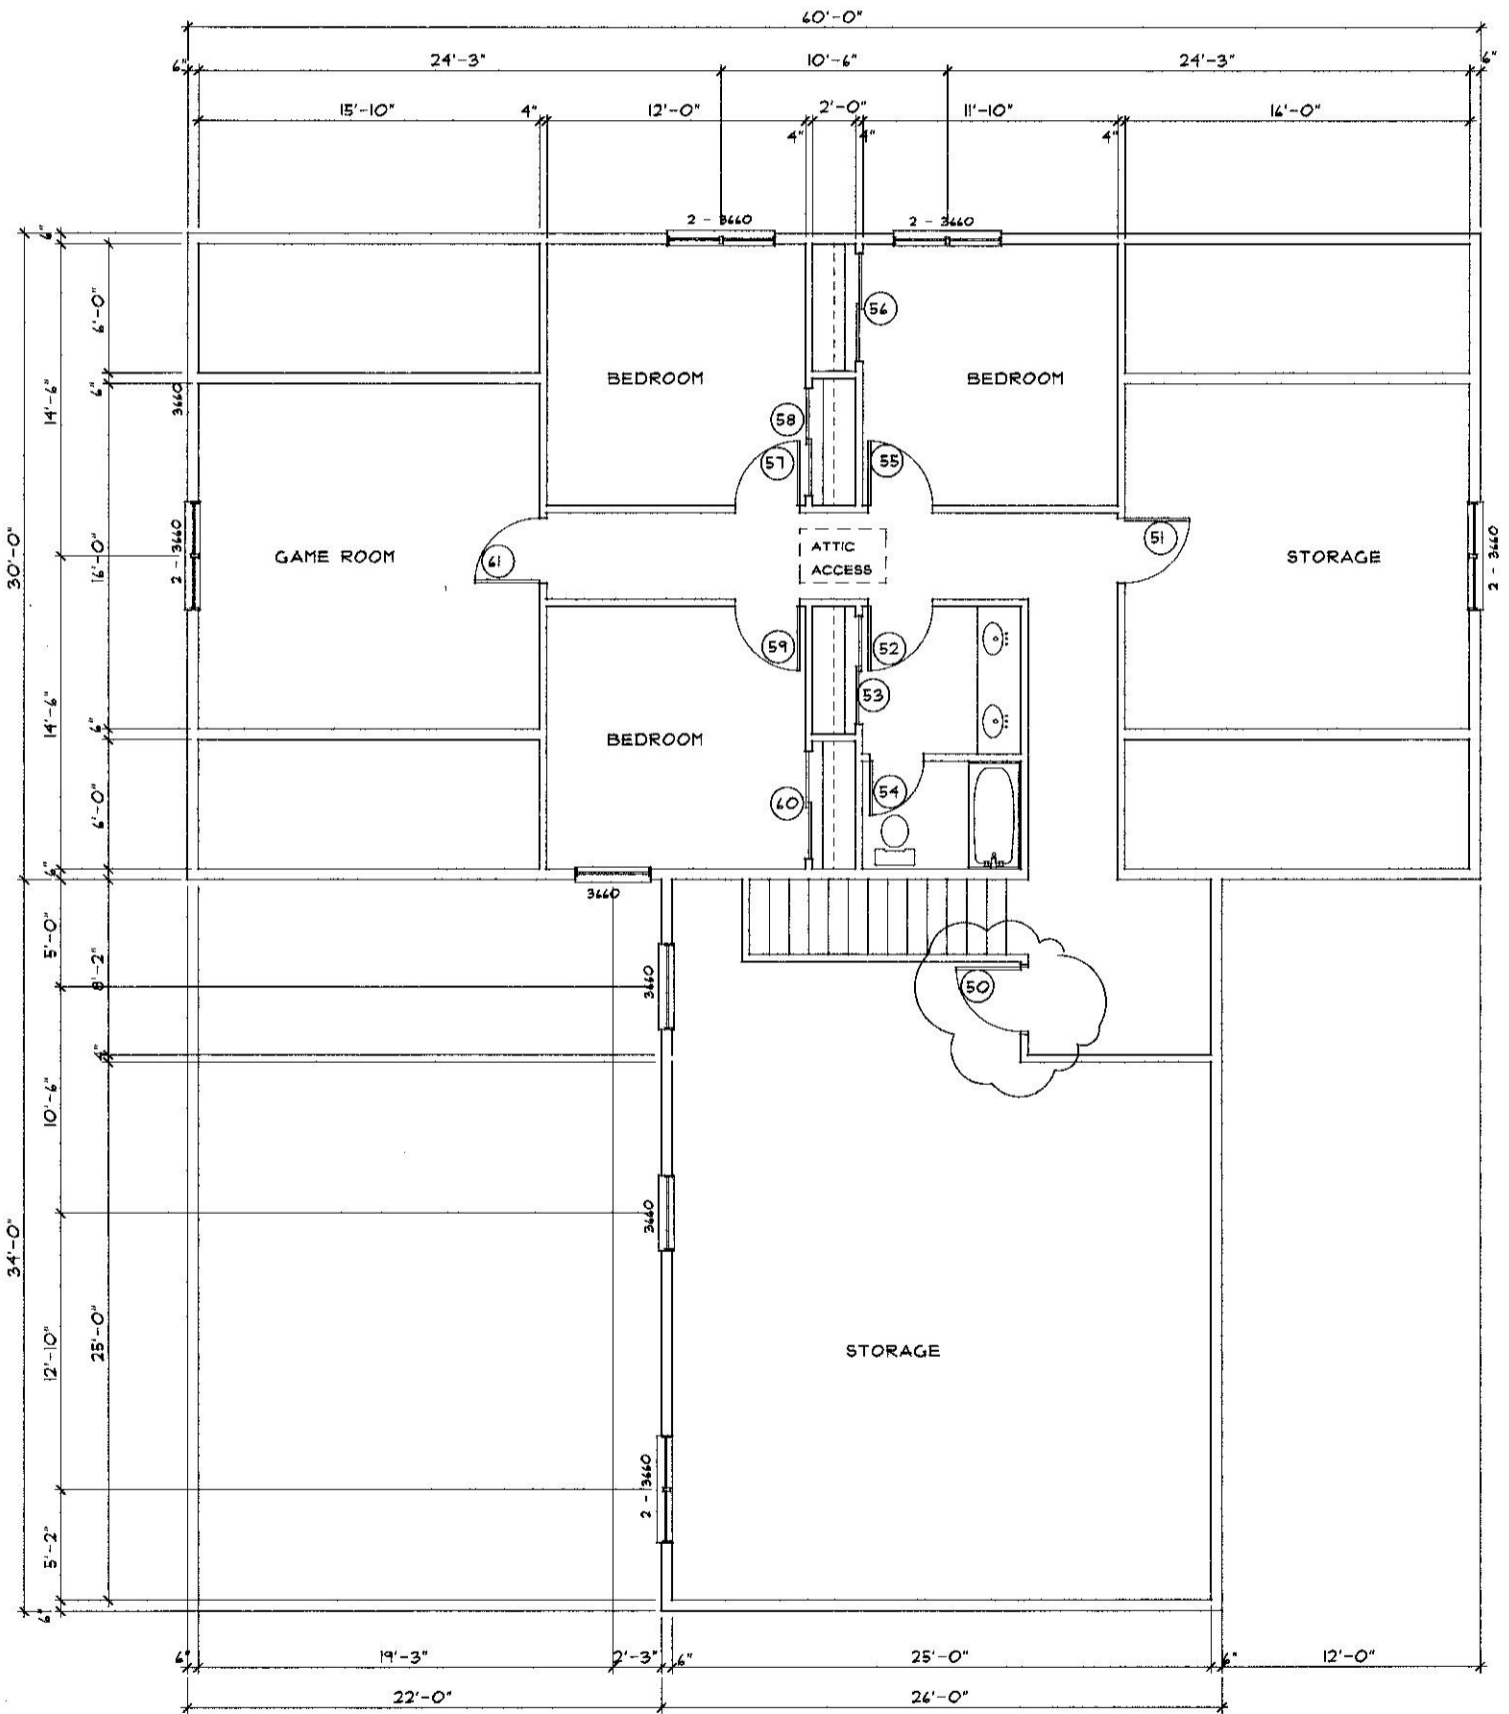

THIRD FLOOR PLAN

SCALE: 1/4" = 1'-0"

OF SHEETS	A-4	ARCHITECT	<b>Gleason Architects</b> P.O. BOX 596 STRATHAM, NEW HAMPSHIRE 03885 603 772-7370 FAX. NO. 603 772-6044	<b>NEW RESIDENCE</b>  11 POMEROY STREET PORTLAND, MAINE	NO.	DESCRIPTION OF REVISION	DATE
					1	CHANGED FLOOR PLAN	10/25/13
					2	REVISED PERMIT SET	06/09/14
					3	AS BUILT - CHANGES	02/23/15