



WALL TYPE B.1 - SECTION 1

SCALE: 3/8" = 1'-0" A09.30

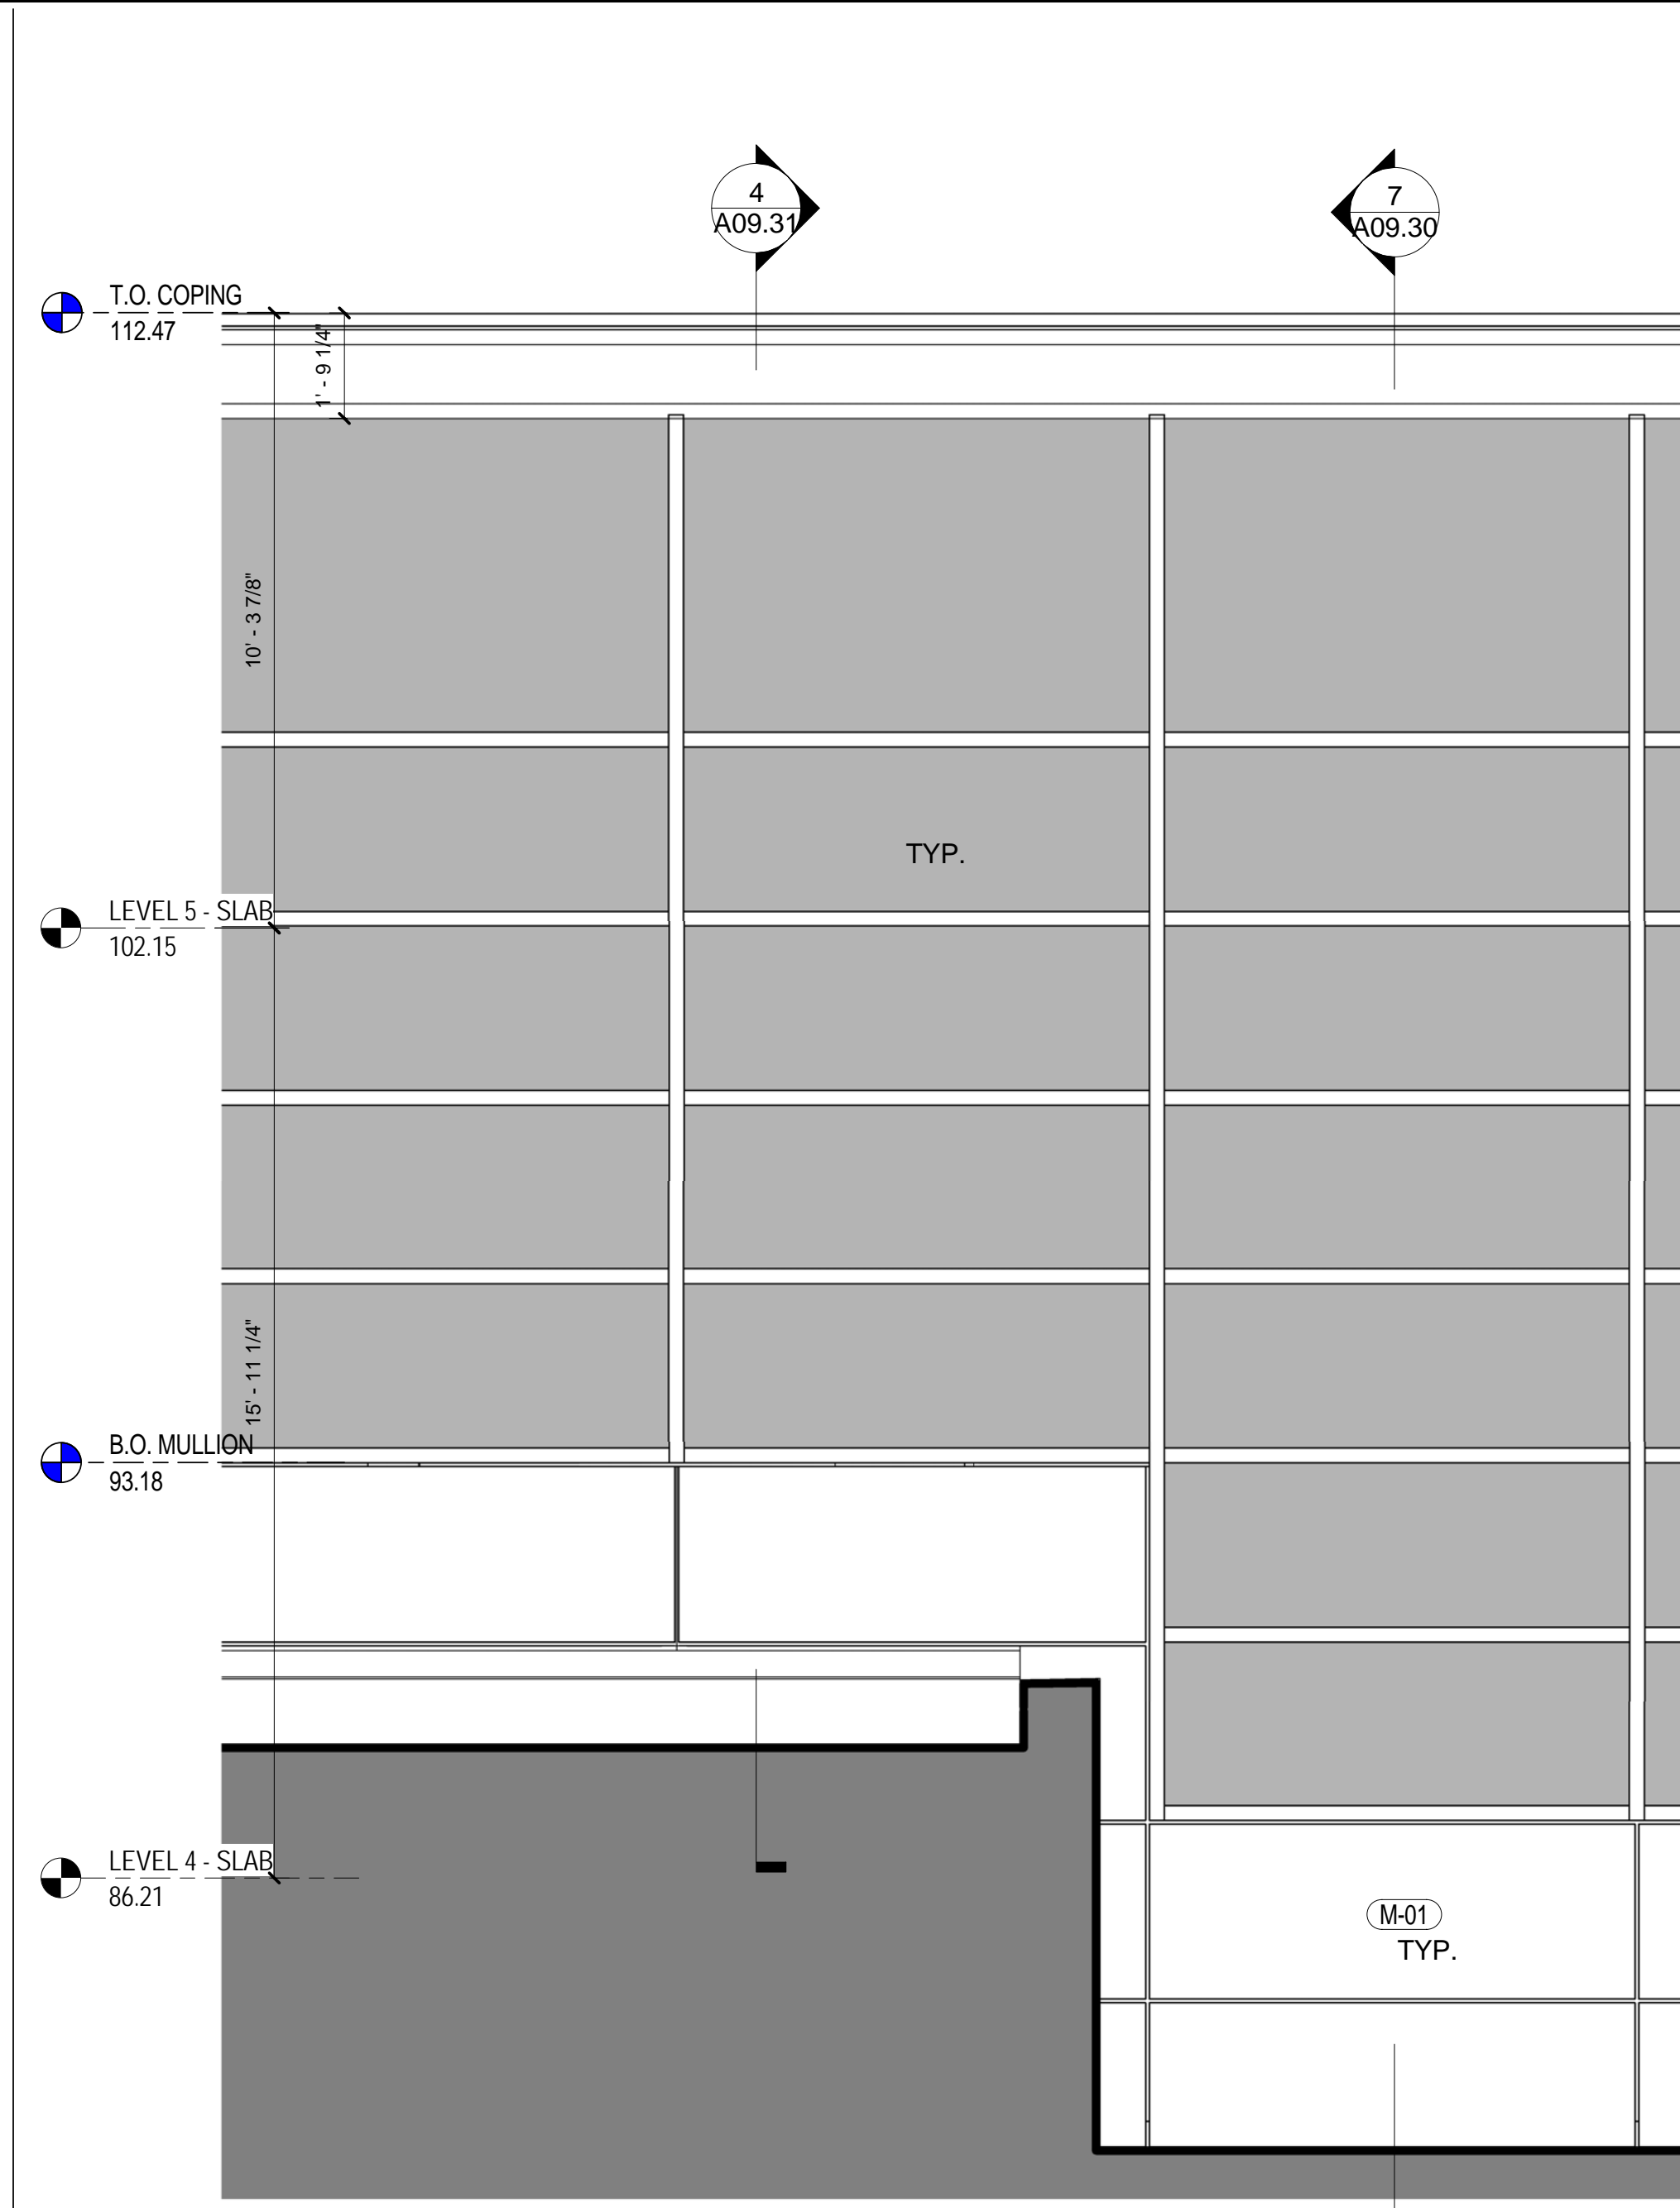


WALL TYPE B.1 - ELEVATION

SCALE: 3/8" = 1'-0" A09.02

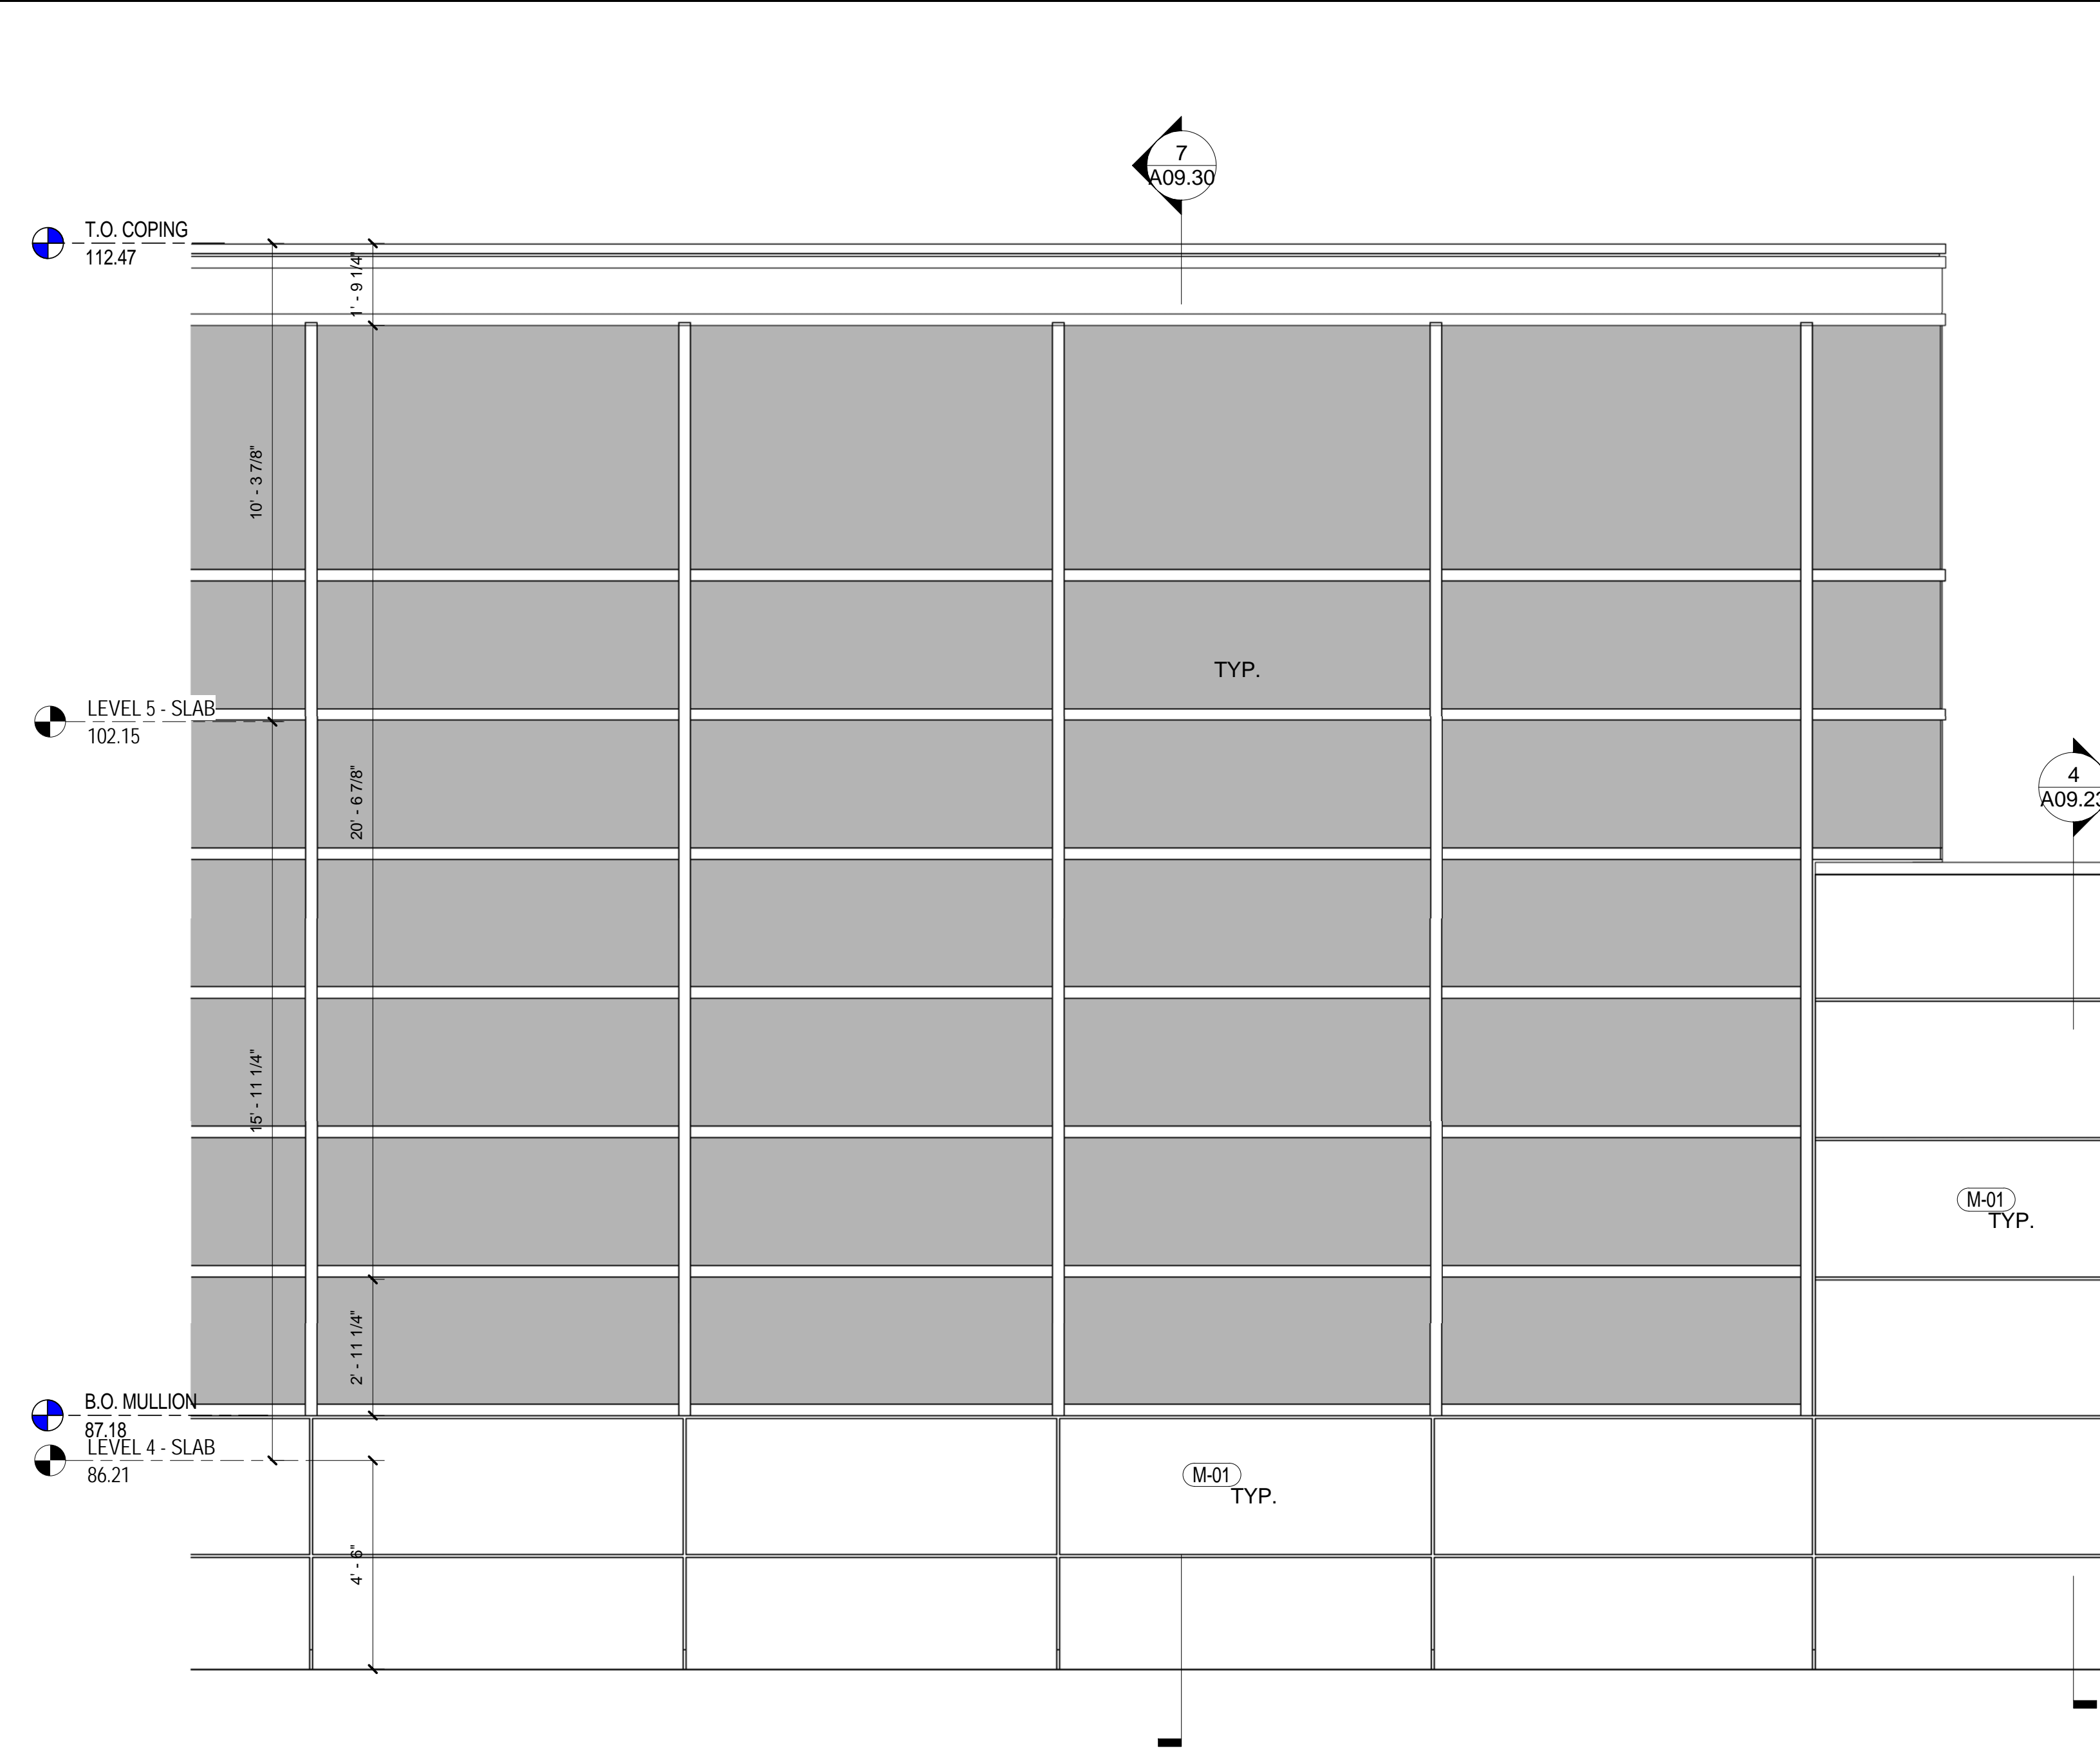


WALL TYPE B - ELEVATION

SCALE: 3/8" = 1'-0" A09.02

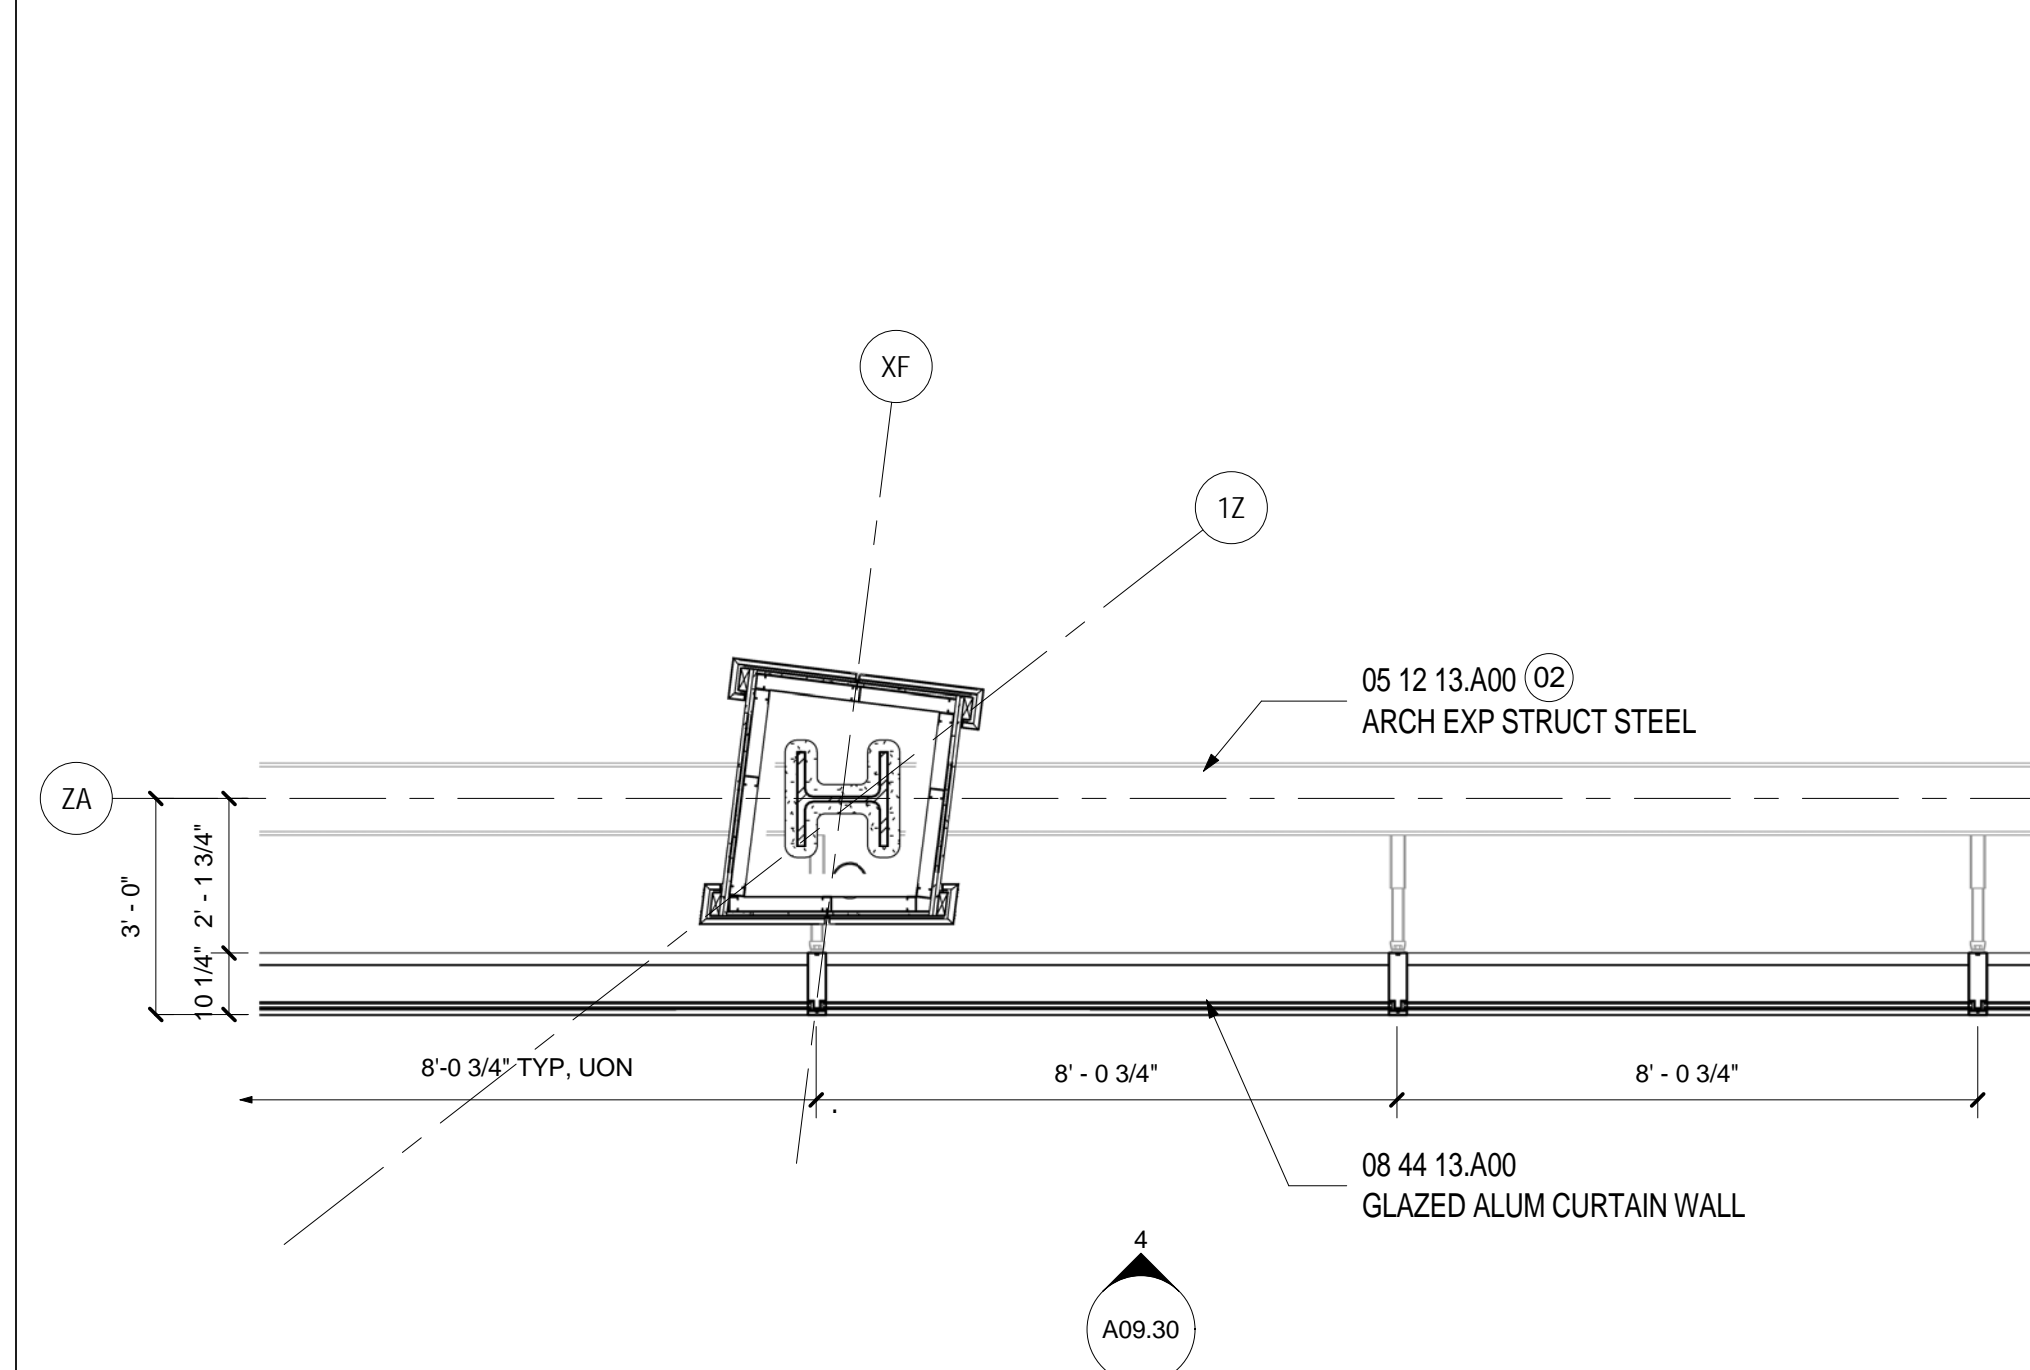


WALL TYPE B.1 - PLAN LEVEL 5

SCALE: 3/8" = 1'-0" A02.05.04

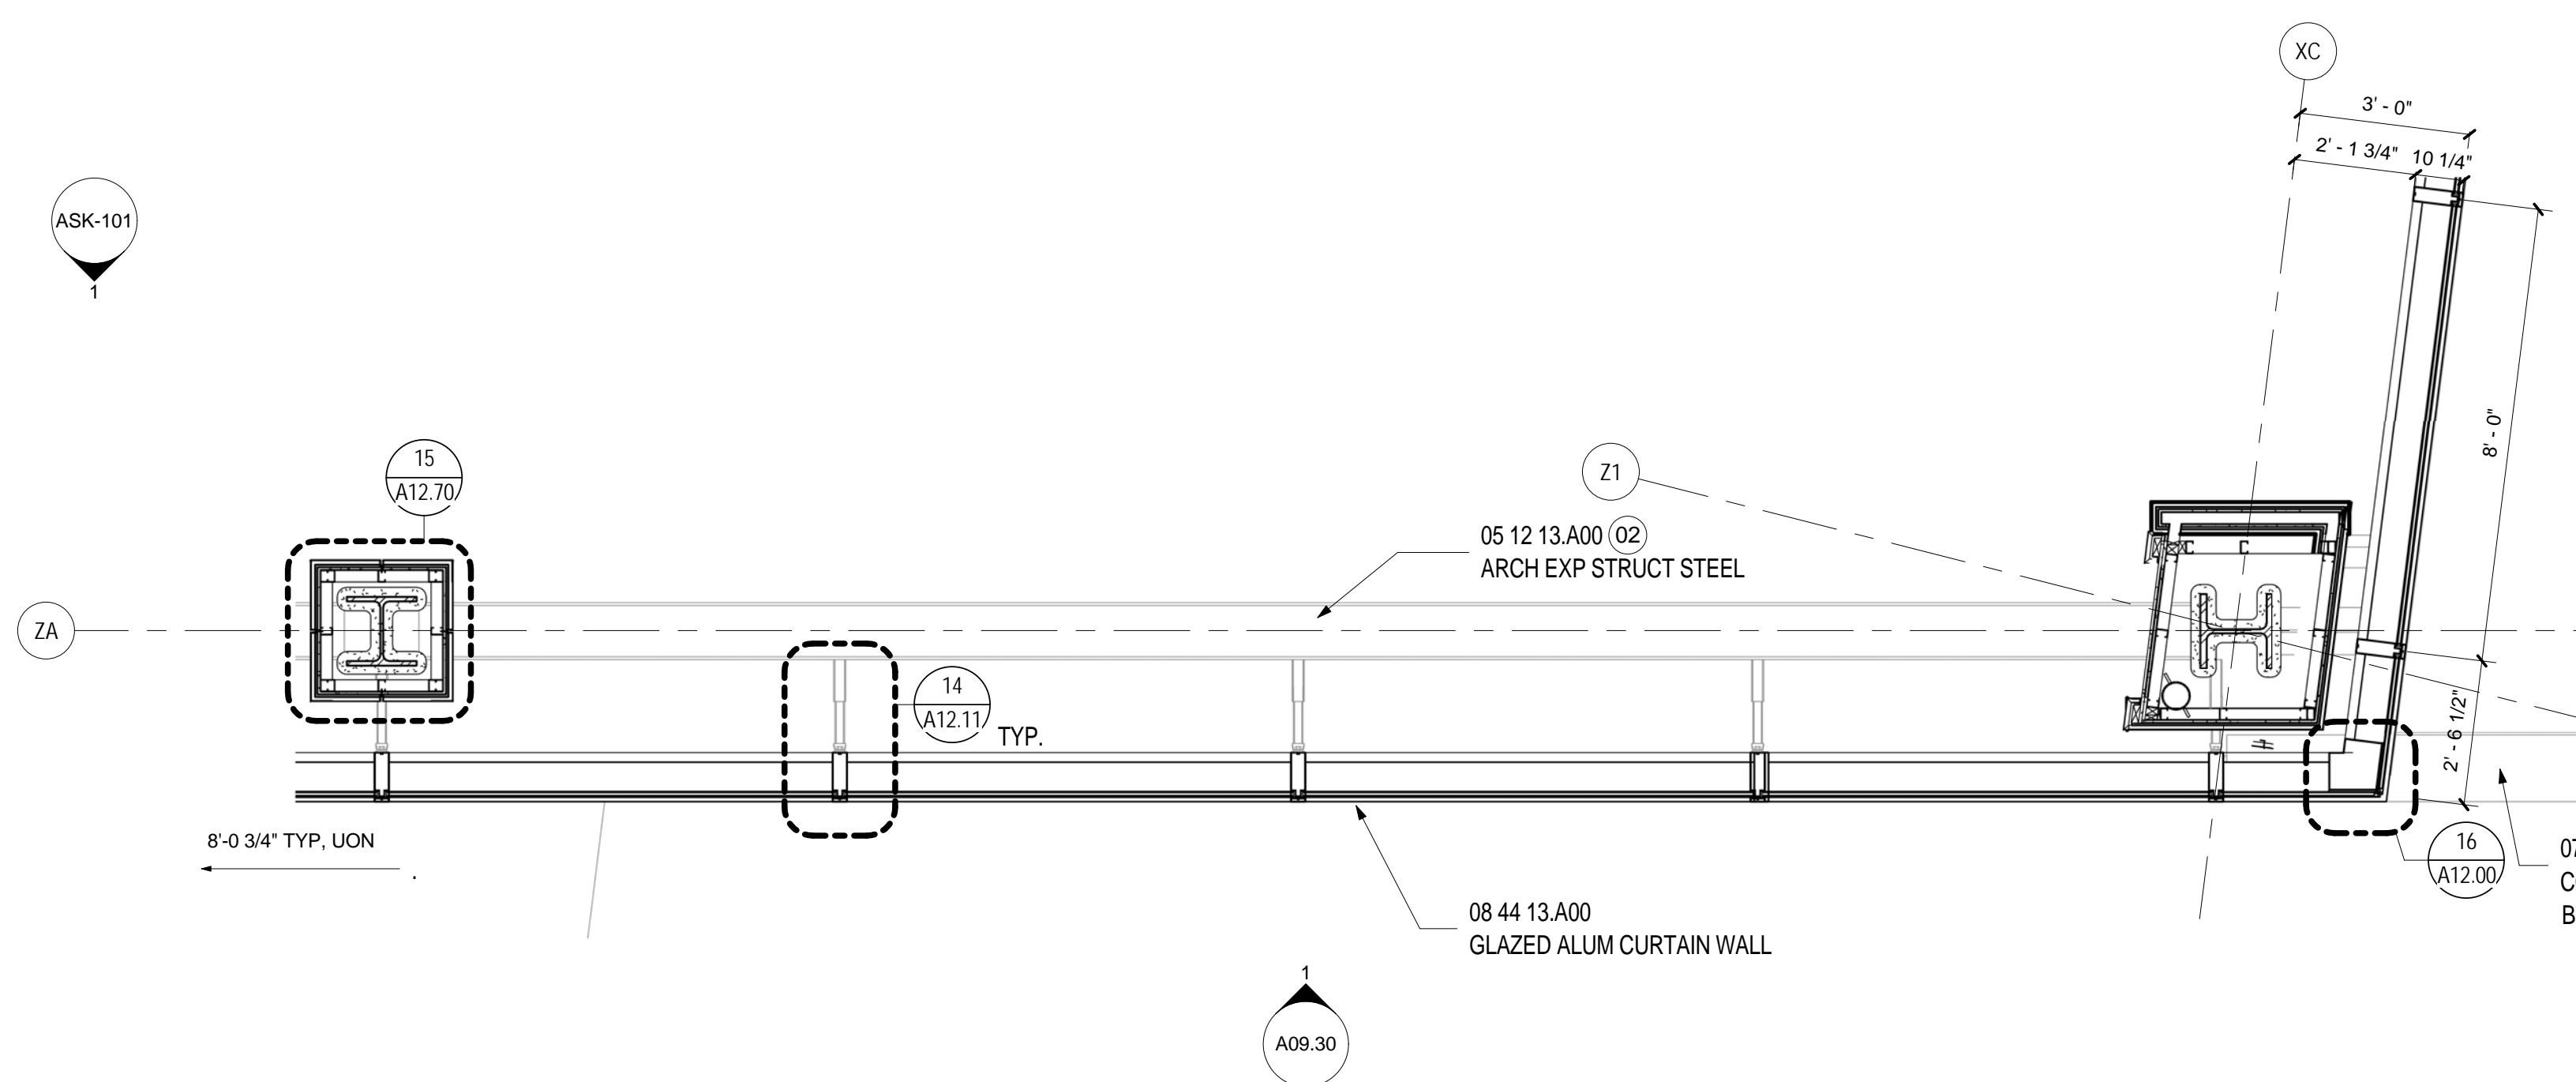


WALL TYPE B - PLAN LEVEL 5

SCALE: 3/8" = 1'-0" A02.05.04

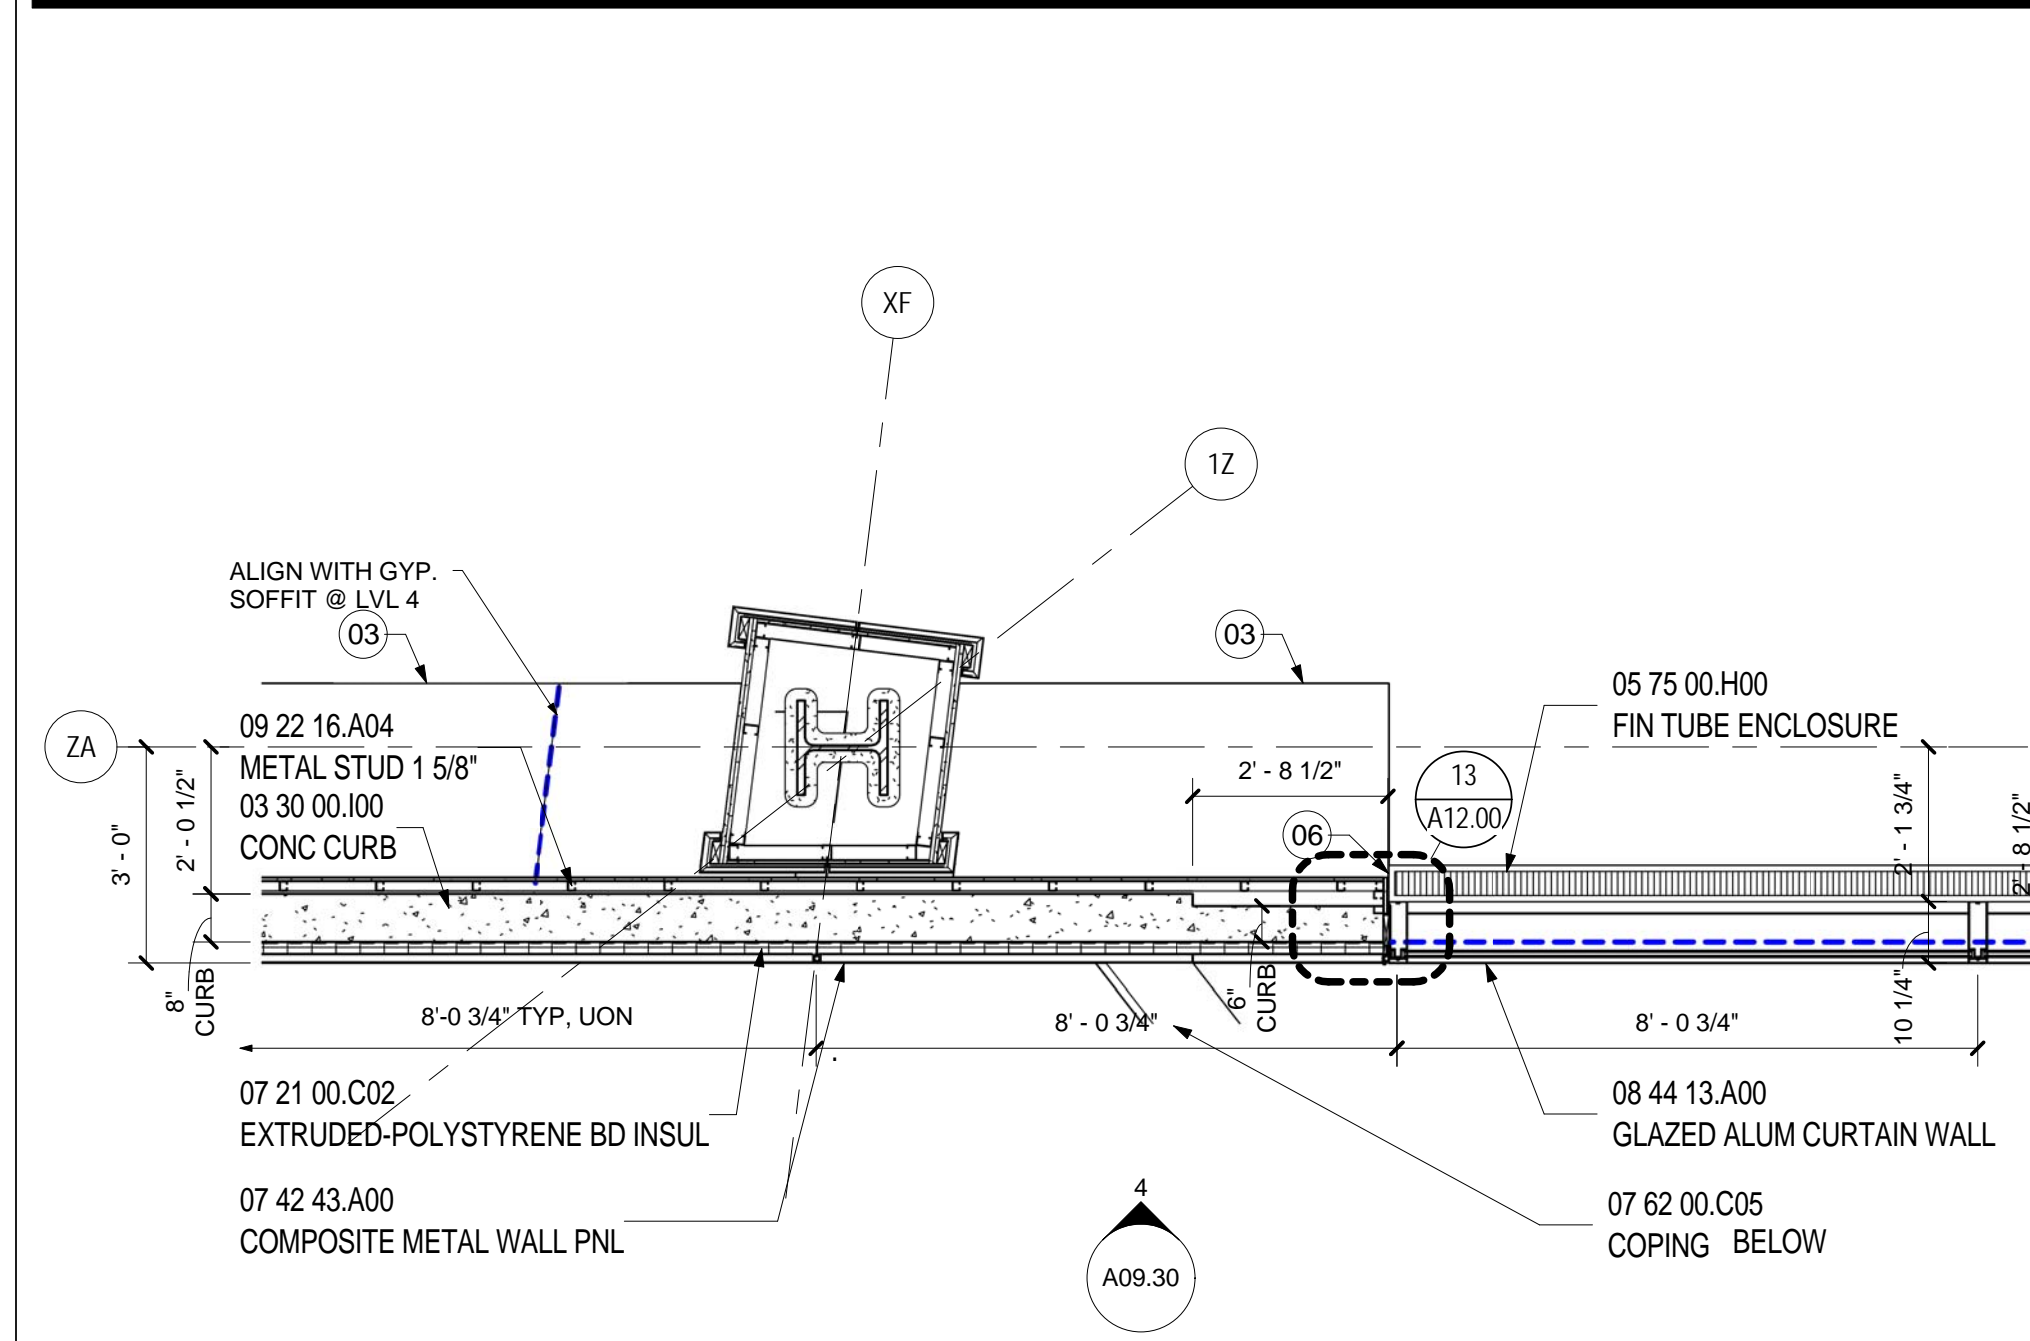

WALL TYPE B.1 - PLAN LEVEL 4

SCALE: 3/8" = 1'-0" A02.04.04

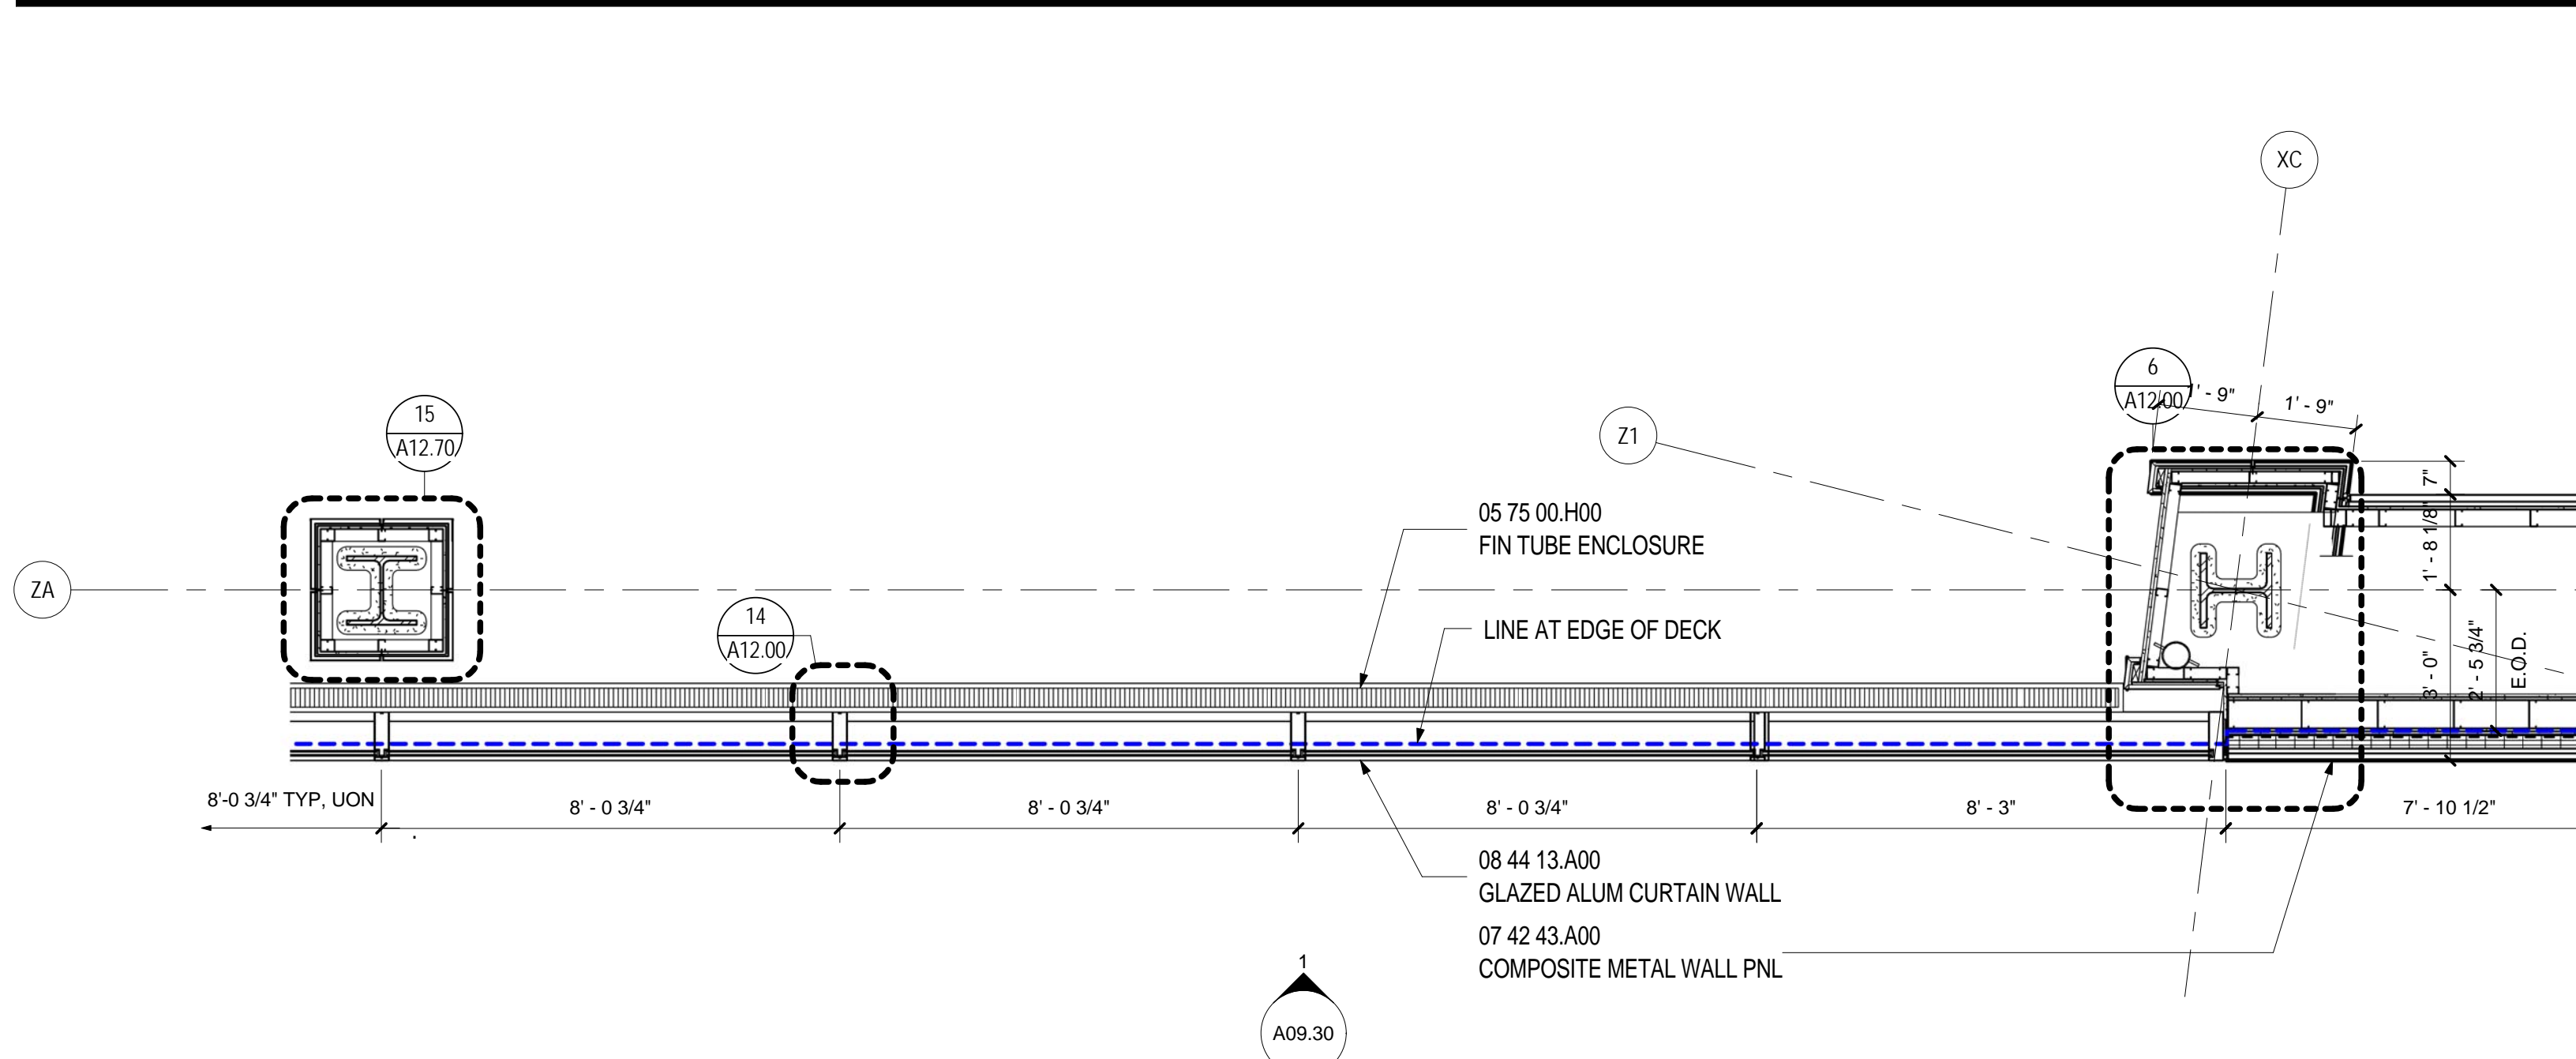

WALL TYPE B - PLAN LEVEL 4

SCALE: 3/8" = 1'-0" A02.04.04

SHEET NOTES

- 01 EXTRUDED ALUMINUM EXTENSION CAPPED MULLION
- 02 EXPOSED STEEL TO RECEIVE INTUMESCENT FIRE-RESISTANT COATING & FINISHES AS SCHEDULED
- 03 LINE OF GYPSUM BOARD EDGE BELOW
- 04 SCHEDULED LIGHT FIXTURE.
- 05 PROVIDE END CAP AT MULLION EXTENSION
- 06 CAP END OF FIN TUBE ENCLOSURE.

GENERAL NOTES


A RE: FINISH SCHEDULE & PROJECT MANUAL FOR MULLION FINISH ASSOCIATED W/ GLAZING UNIT.

Portland International Jetport
1001 Westbrook Street
Portland, Maine 04102

Gensler
2020 K Street, Northwest
Suite 200
Washington DC 20006
Telephone 202.721.5200
Facsimile 202.872.8587

Date	Description
12/03/08	75% CONSTRUCTION DOCUMENTS
01/23/09	95% CONSTRUCTION DOCUMENTS
10/26/09	ISSUED FOR PERMIT
11/12/09	ADDENDUM #2
145 09/01/11	ISSUED FOR CONSTRUCTION

Seal/Signature

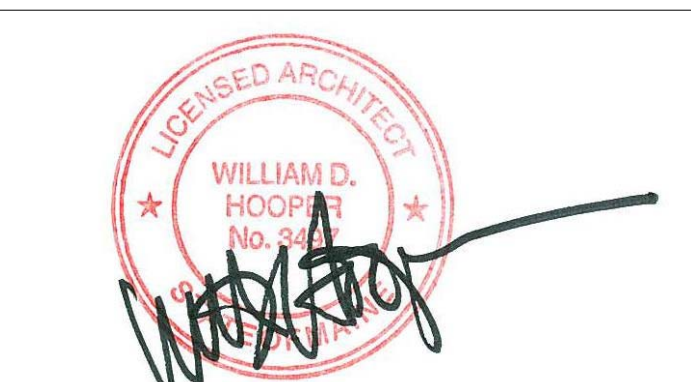

Project Name
PWM Terminal Enhancement

Project Number
09.6395.000

Description
WALL TYPE B

Scale
As indicated

A09.30

© 2009 Gensler