


Project	PWM Terminal Enhancement
Description	CBRA Room ETD Revised Location
Prepared by	BNP ASSOCIATES
Scale	1/4" = 1'-0"

Project Number	09.6395.000
Issue/Rev	Bulletin 109/122
Date	06/06/11

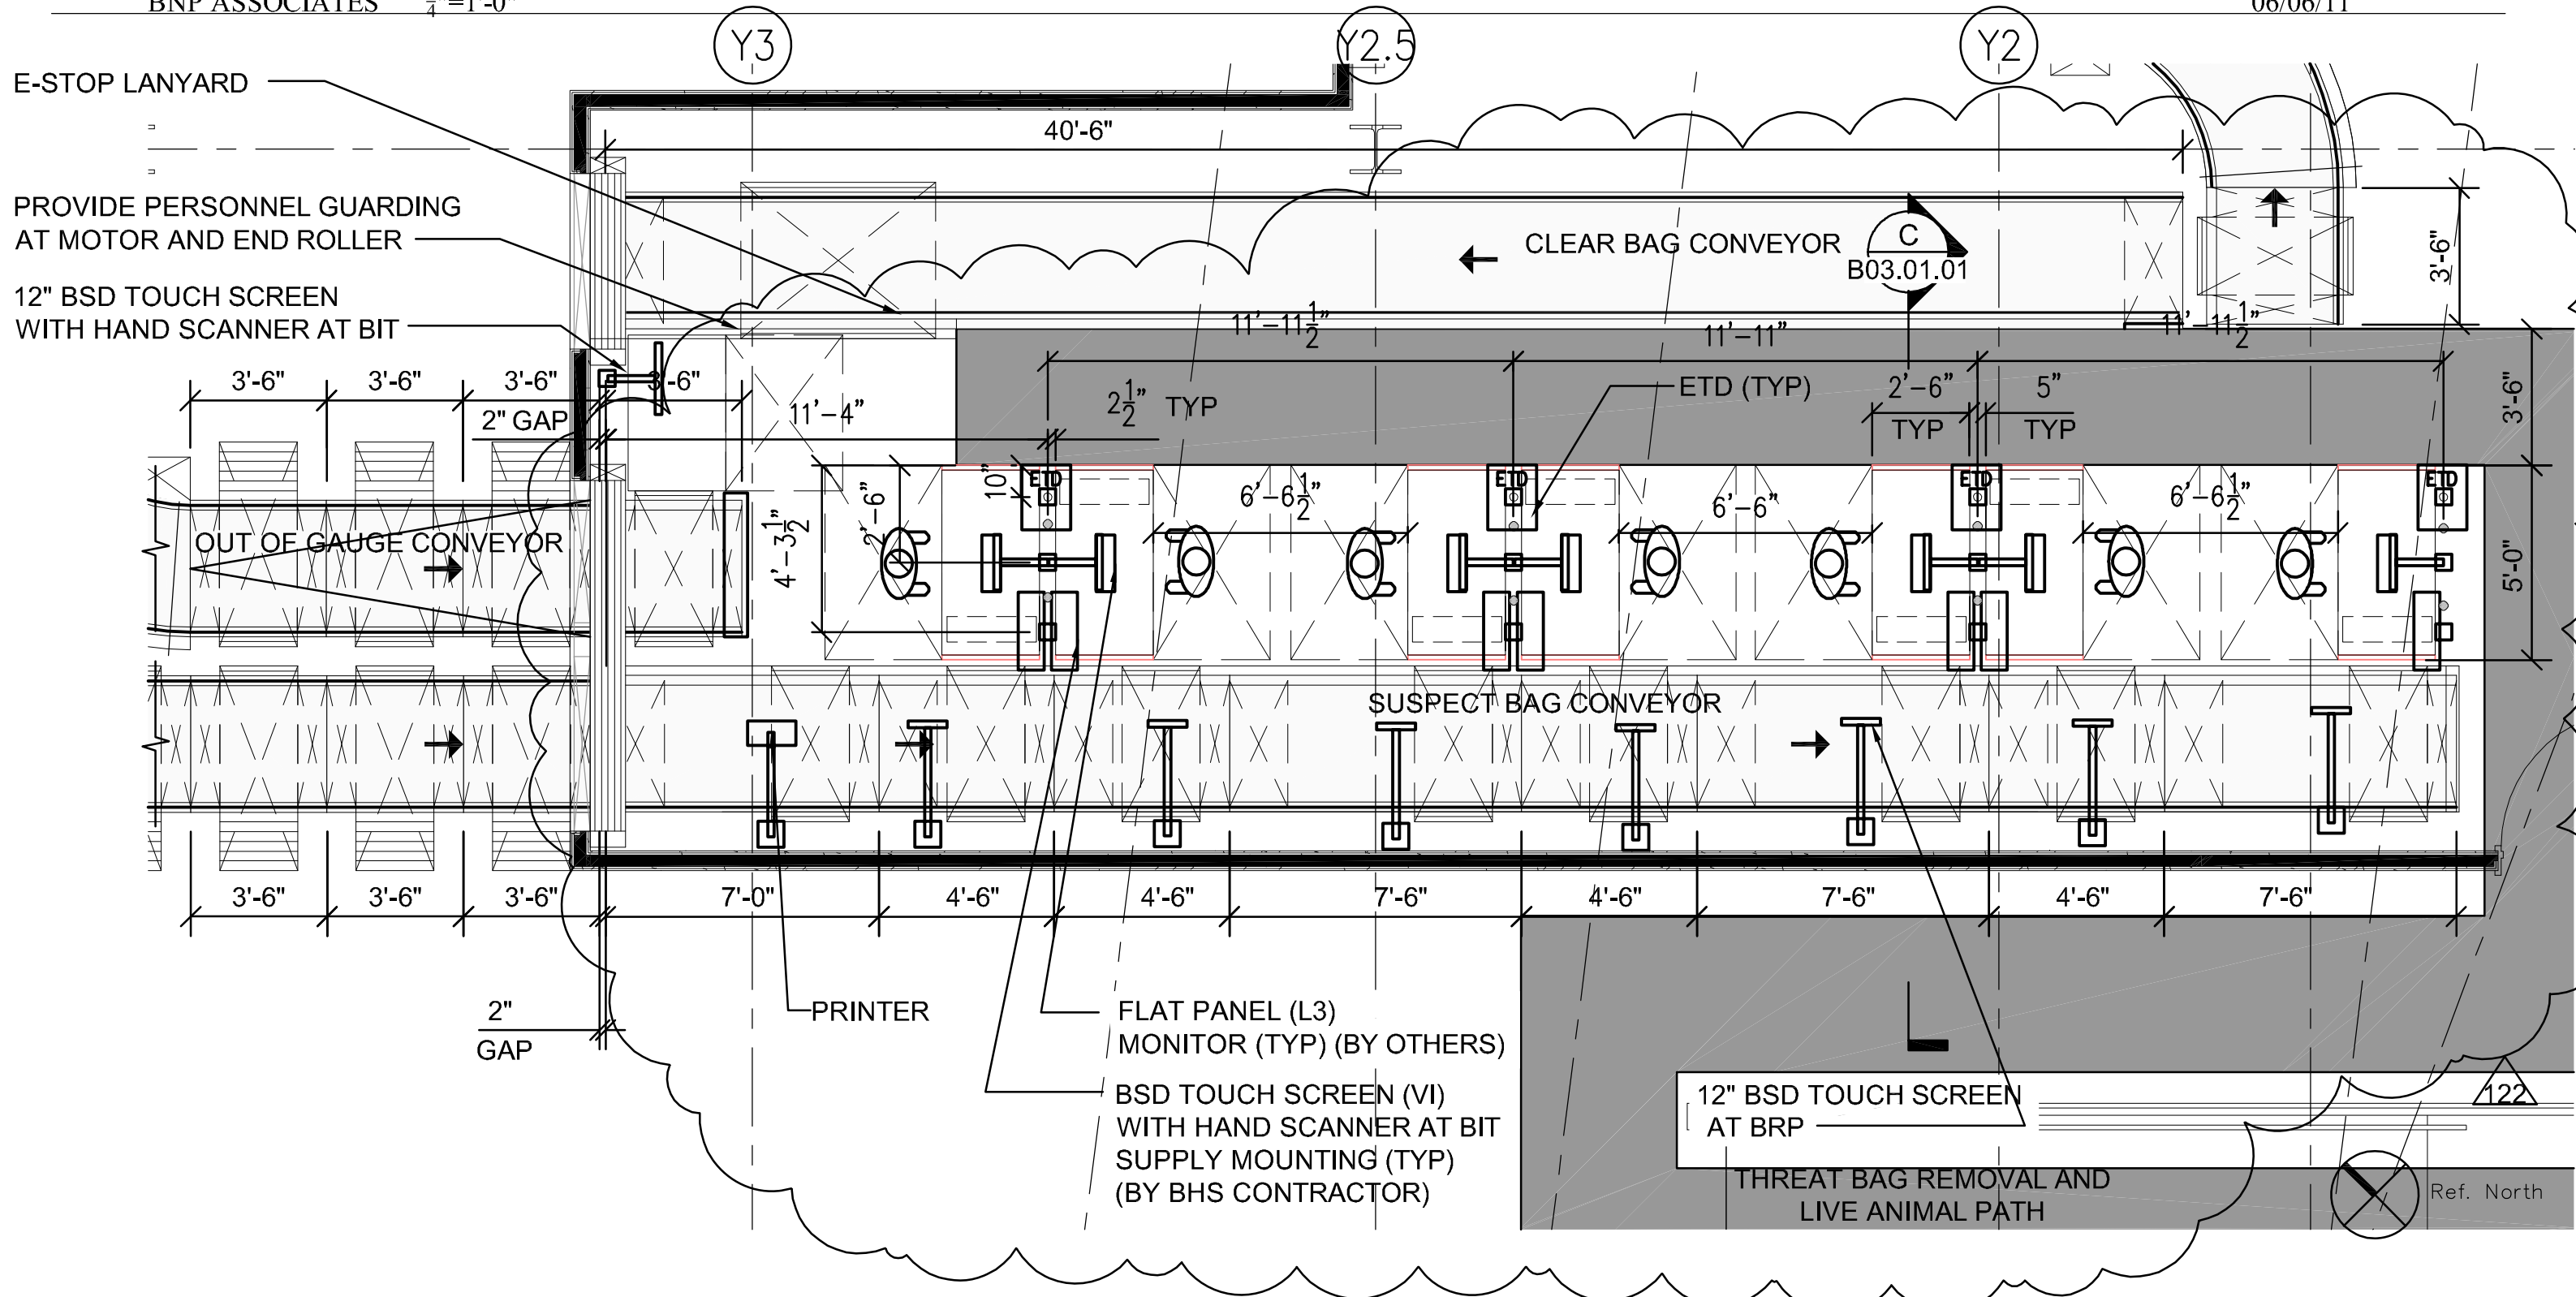

1 CBRA-OVERSIZED CBRA - OSR AND BHS CONTROL ROOM
 B02.01.05 1/4" = 1'-0"