

**SHEET NOTES**

- 01 CONTRACTOR SHALL BRING CIRCUIT TO VENDOR SUPPLIED CONTROL CABINET FOR CONTROL OF EXTERIOR ILLUMINATED SIGN. PLEASE COORDINATE ANY CONDUIT RUNS FROM CONTROLLER TO SIGN WITH VENDOR.
- 02 INSTALL ARCHITECTURAL FLOODLIGHT SURFACE MOUNTED TO TOP OF STEEL APPROX. 13' AFF. ALL SURFACE RACEWAY, BACKBOXES, SUPPORTS, ETC. SHALL BE ROUTED ALONG TOP CENTER OF STEEL FOR CONCEALMENT FROM VIEW BELOW. FIELD AIM AND ADJUST FIXTURE TO ILLUMINATE AIRPLANE FEATURE ONLY. CONNECT TO LIGHTING BRANCH CIRCUIT AS INDICATED VIA RELAY 4A-18. COORDINATE INSTALLATION WITH ARCHITECT.
- 03 INSTALL ARCHITECTURAL FLOODLIGHT SURFACE MOUNTED TO SIDE OF LAMINATE WOOD BEAM APPROX. 27' AFF. INSTALL ON SIDE OF BEAM SIMILAR TO TYPE FA FIXTURES. INSTALL NEW PAINTED CONDUIT ADJACENT TO OTHER CONDUIT SURFACE MOUNTED TO BEAM. FIELD AIM AND ADJUST FIXTURE TO ILLUMINATE AIRPLANE FEATURE ONLY. CONNECT TO LIGHTING BRANCH CIRCUIT AS INDICATED VIA RELAY 4A-18. COORDINATE INSTALLATION WITH ARCHITECT.
- 04 REMOVE TYPE FA FIXTURES AND RETURN TO OWNER AS BOXED ATTIC STOCK. REMOVE CONDUIT AND WIRE BACK TO NEAREST FIXTURE TO REMAIN.

**Portland International Jetport**  
 1001 Westbrook Street  
 Portland, Maine 04102

**Gensler**  
 2020 K Street, NW  
 Suite 200  
 Washington, DC 20006  
 Telephone 202.771.5200  
 Facsimile 202.872.8587

**oest ASSOCIATES, INC.**  
 363 Gopham Road, South Portland, ME 04106  
 P: (207) 761-1770 F: (207) 774-1246 www.oest.com  
 engineers - architects - surveyors - construction managers

**amec**  
 343 Gorham Road, South Portland ME 04106  
 P: (207) 761-1770 F: (207) 774-1246 www.amec.com


THESE DRAWINGS ARE ISSUED FOR CONSTRUCTION AND REFLECT ALL AMEC ISSUED BULLETINS AND SKETCHES.

Issue	Date & Issue Description	By	Check	
01	09/22/08	LAM	BHG	
DESIGN DEVELOPMENT				
02	12/03/08	LAM	BHG	
75% CONSTRUCTION DOCUMENTS				
03	01/23/09	LAM	BHG	
95% CONSTRUCTION DOCUMENTS				
04	10/26/09	LAM	BHG	
ISSUED FOR PERMIT				
05	11/02/09	LAM	BHG	
ADDENDUM #1				
02	06	11/12/09	LAM	BHG
ADDENDUM #2				
03	07	11/20/09	LAM	BHG
ADDENDUM #3				
06	08	09/01/11	LAM	BHG
ISSUED FOR CONSTRUCTION				

**GENERAL NOTES**

A SEE SHEET E00.00 FOR LEGEND AND GENERAL NOTES.

**KEY PLAN**

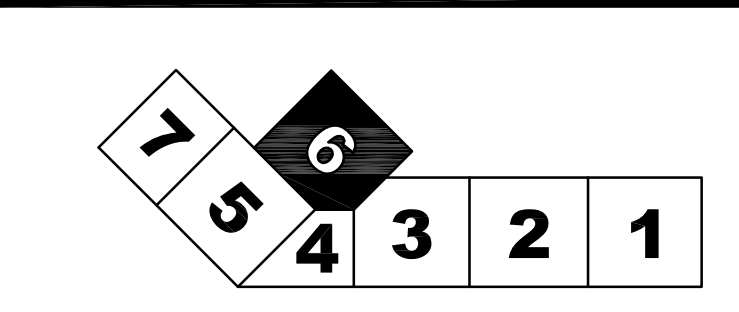

Project Name  
 PWM Terminal Enhancement

Project Number  
 03-6395-000

CAD File Name  
 C:\AMEC\033011E04.05.06.dwg

Description  
 ELECTRICAL LIGHTING PLAN - LEVEL 5 - ZONE 6

Scale  
 1/8" = 1'-0"

Ref. North

**E04.05.06**

©2009 Gensler