


**SHEET NOTES**

- 01 REMOVE EXISTING RADIANT FLOOR MANIFOLD, PIPE AND CONTROLS.
- 02 REMOVE EXISTING RADIANT FLOOR TUBING FOR ENTIRE FLOOR.
- 03 REMOVE PIPE FROM BRANCH TO RISER AND STOP DEMOLITION AT ELBOW AT BOTTOM OF RISER, PIPE RISERS TO REMAIN.
- 04 REMOVE CABINET UNIT HEATERS AND PIPING.
- 05 REMOVE VAV BOX AND ASSOCIATED DUCTWORK, FITTINGS, HANGERS AND DIFFUSERS.
- 06 REMOVE SWITCH AND CONTROLS.
- 07 CAREFULLY REMOVE EXISTING DDC CONTROL PANEL AND ELECTRICAL BOXES; RELOCATE AS INDICATED ON NEW WORK DRAWINGS. NOTE: DDC CONTROLS MUST BE KEPT OPERATIONAL.
- 08 REMOVE MAKEUP AIR UNIT, INCLUDING MAU, DUCTWORK, FITTINGS, HANGERS AND DIFFUSERS. DEMOLISH AND REMOVE WALL LOUVER.
- 09 REMOVE EXHAUST FAN, INCLUDING DUCTWORK, FITTINGS, AND HANGERS. DEMOLISH AND REMOVE WALL LOUVER.
- 10 REMOVE EXHAUST FAN AND 18"x18" DUCT, INCLUDING FITTINGS AND HANGERS. REMOVE WALL LOUVER.

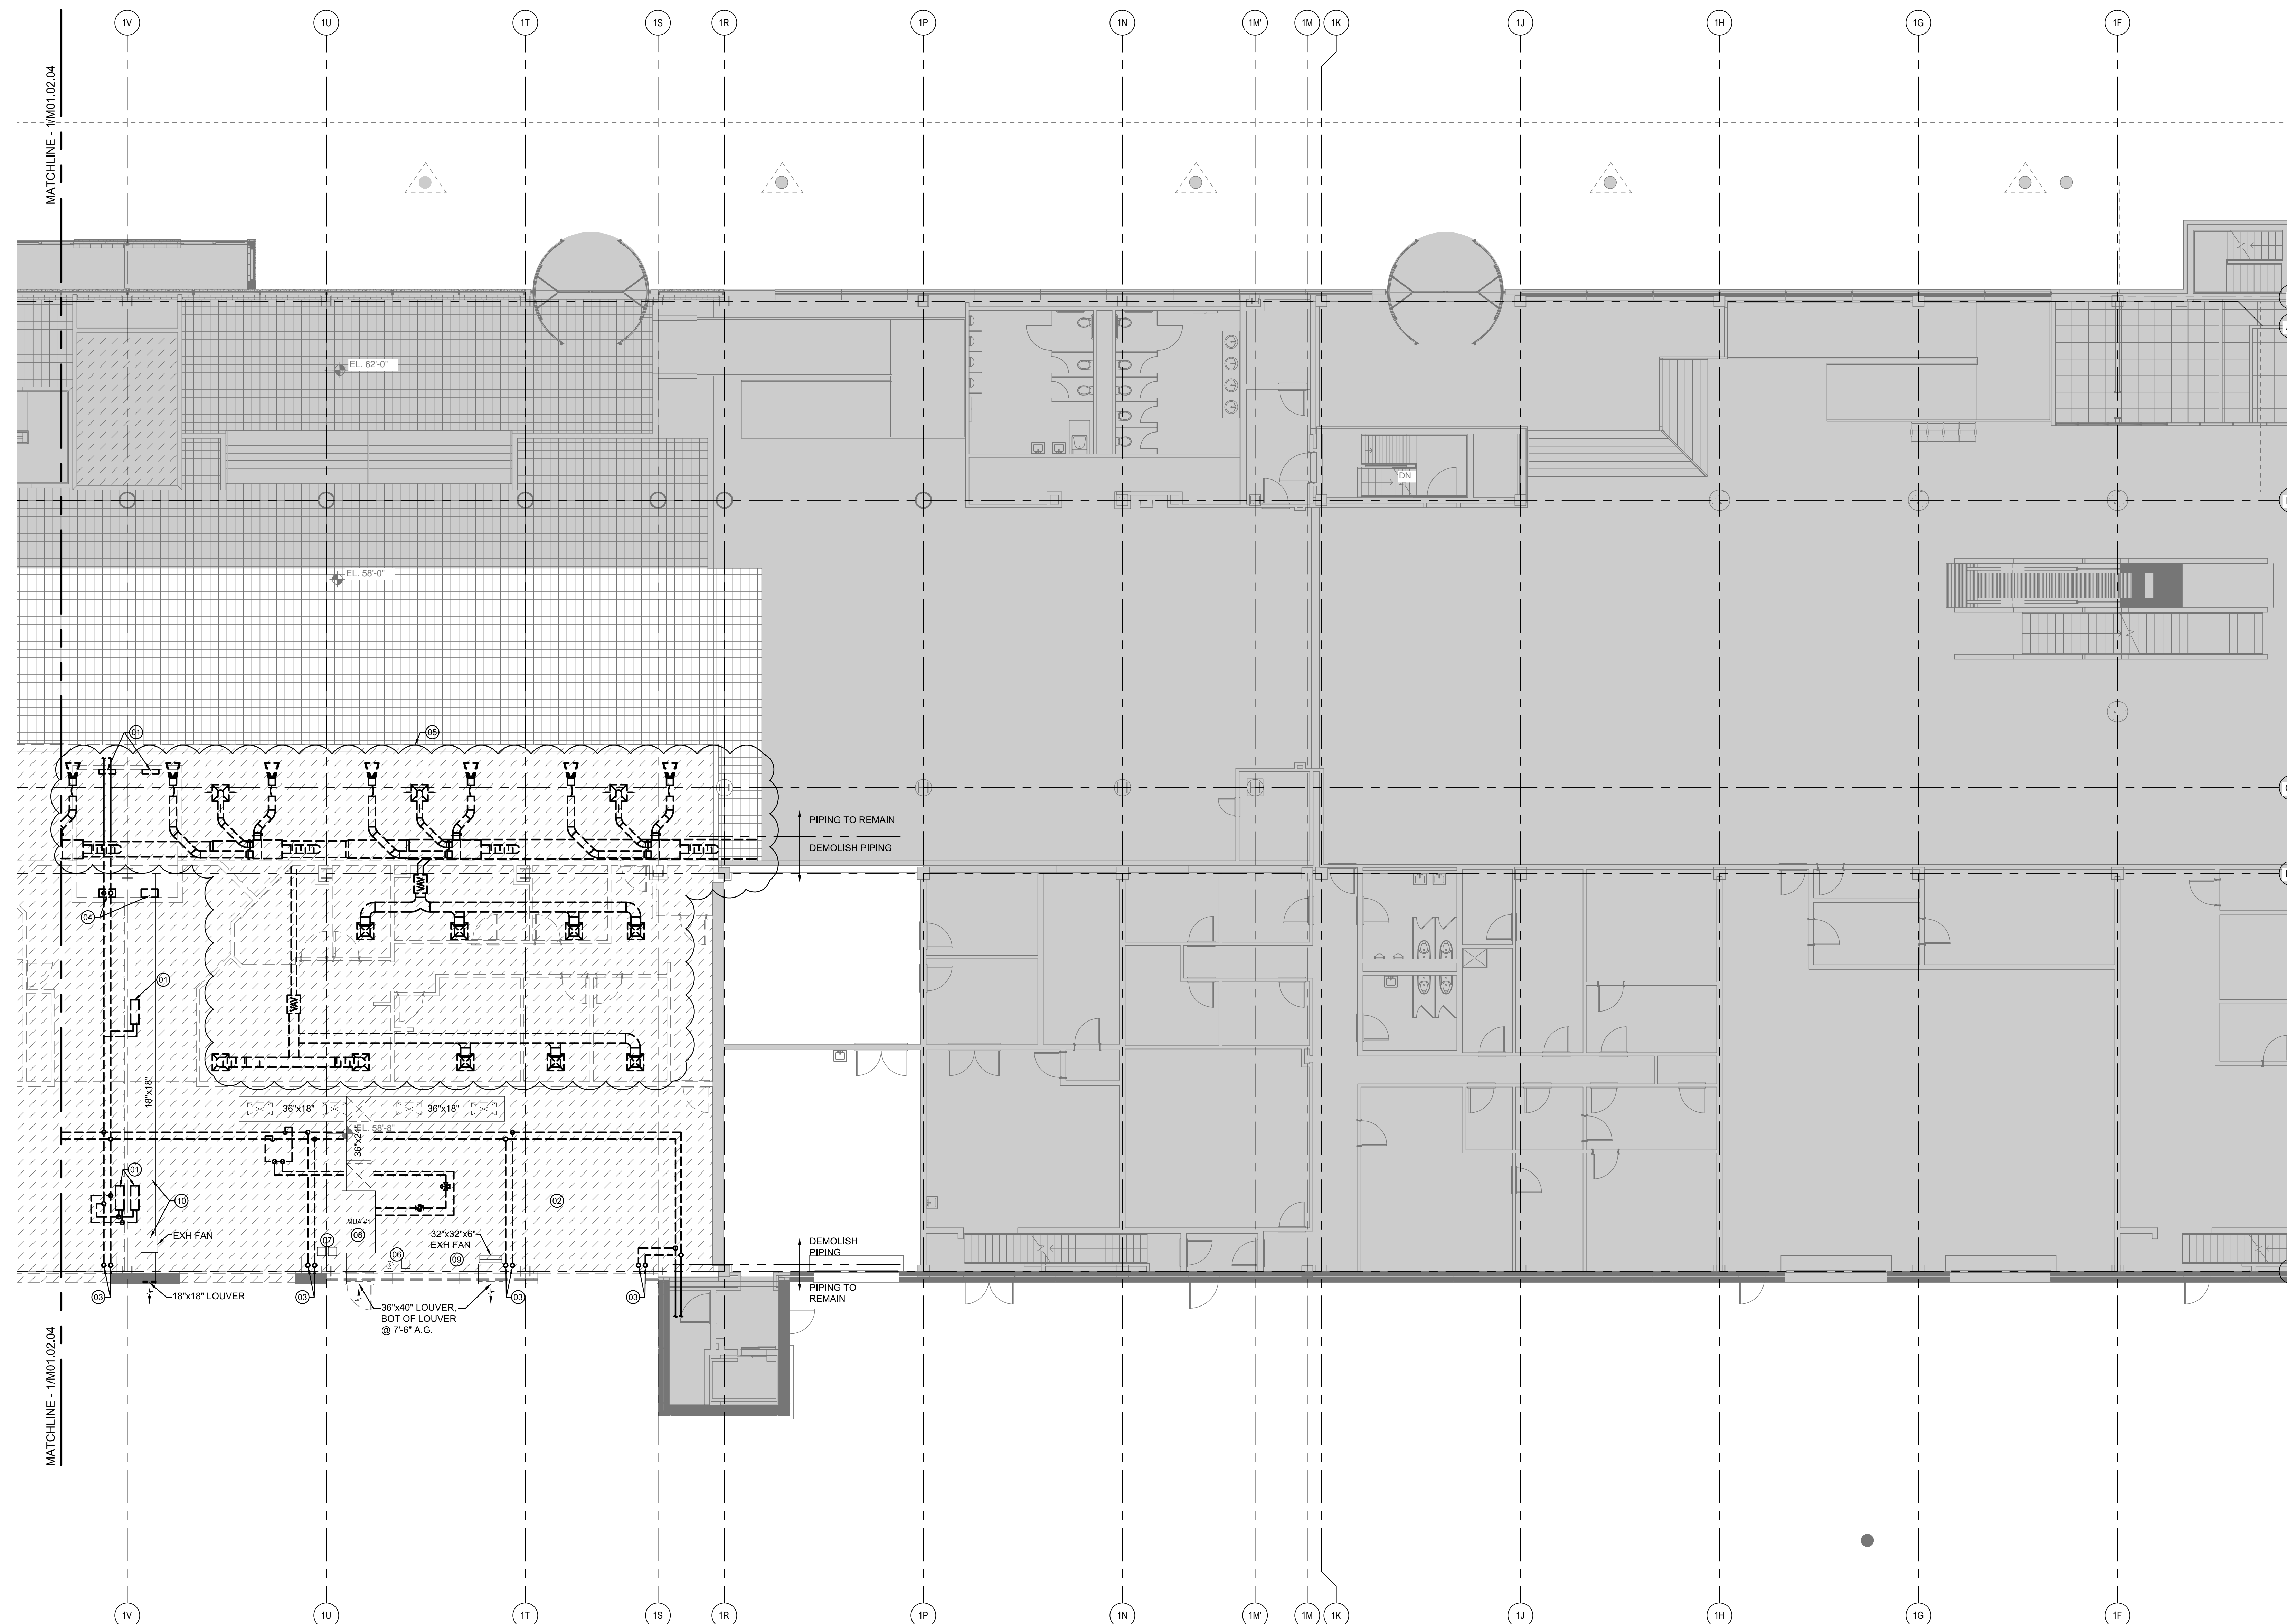

THESE DRAWINGS ARE ISSUED FOR CONSTRUCTION AND REFLECT ALL AMEC ISSUED BULLETINS AND SKETCHES.

Issue	Date & Issue Description	By	Check
01	12/03/08	PWZ	RHB
02	01/23/09	PWZ	RHB
03	10/26/09	PWZ	RHB
04	11/12/09	PWZ	RHB
05	09/01/11	PWZ	RHB

**GENERAL NOTES**

- A SEE SHEET M00.00 FOR LEGEND AND GENERAL NOTES.
- B CONTRACTOR SHALL FIELD VERIFY EXISTING DUCTWORK & PIPING PRIOR TO DEMOLITION.

Seal/Signature  
  
 09/01/11

Project Name  
PJM Terminal Enhancement

Project Number  
08.0395.000

CAD File Name  
T:\5330101\Sheets\M01.02.03.dwg

Description  
MECHANICAL DEMOLITION PLAN - LEVEL 2 - ZONE 3

**KEY PLAN**

