

# City of Portland, Maine – Building or Use Permit Application 389 Congress Street, 04101, Tel: (207) 874-8703, FAX: 874-8716

Location of Construction: 21 Kingsmark Ln		Owner: Peverada, Judith & John		Phone:		Permit No: 970551	
Owner Address:		Lessee/Buyer's Name:		Phone: X8444		BusinessName:	
Contractor Name: Owner		Address:		Phone:		<div style="border: 2px solid black; padding: 5px; text-align: center;"> <b>PERMIT ISSUED</b>  <b>JUN - 6 1997</b>  <b>CITY OF PORTLAND</b> </div>	
Past Use: 1-fam		Proposed Use: Same		<b>COST OF WORK:</b> \$ 2,000.00 <b>PERMIT FEE:</b> \$ 30.00		<b>INSPECTION:</b> Use Group: 193 Type 53 Signature: [Signature]	
Proposed Project Description: Construct Deck (20 x 12)				<b>FIRE DEPT.</b> <input type="checkbox"/> Approved <input type="checkbox"/> Denied Signature: _____			
				<b>PEDESTRIAN ACTIVITIES DISTRICT (P.A.D.)</b> Action: <input type="checkbox"/> Approved <input type="checkbox"/> Approved with Conditions <input type="checkbox"/> Denied Signature: _____ Date: _____			
				<b>Zone:</b> CBL: 227-E-020 Zoning Approval: [Signature] <b>Special Zone or Reviews:</b> <input type="checkbox"/> Shoreland <input type="checkbox"/> Wetland <input type="checkbox"/> Flood Zone <input type="checkbox"/> Subdivision <input type="checkbox"/> Site Plan maj <input type="checkbox"/> minor <input type="checkbox"/> mm <input type="checkbox"/>			
Permit Taken By: Mary Gresik		Date Applied For: 05 June 1997					

1. This permit application does not preclude the Applicant(s) from meeting applicable State and Federal rules.
2. Building permits do not include plumbing, septic or electrical work.
3. Building permits are void if work is not started within six (6) months of the date of issuance. False information may invalidate a building permit and stop all work..

## CERTIFICATION

I hereby certify that I am the owner of record of the named property, or that the proposed work is authorized by the owner of record and that I have been authorized by the owner to make this application as his authorized agent and I agree to conform to all applicable laws of this jurisdiction. In addition, if a permit for work described in the application is issued, I certify that the code official's authorized representative shall have the authority to enter all areas covered by such permit at any reasonable hour to enforce the provisions of the code(s) applicable to such permit

SIGNATURE OF APPLICANT: John Peverada ADDRESS: 21 Kingsmark Ln DATE: 05 June 1997 PHONE: 775-0030

RESPONSIBLE PERSON IN CHARGE OF WORK, TITLE

PHONE:

White-Permit Desk Green-Assessor's Canary-D.P.W. Pink-Public File Ivory Card-Inspector

CEO DISTRICT

4

A. Powers

PERMIT ISSUED  
WITH REQUIREMENTS

# COMMENTS

3-5-99

OK on Final Balaster's OK on spacing and hand  
Rails + Guard Rails in place (T.R.)

## Inspection Record

Type	Date
Foundation: _____	_____
Framing: _____	_____
Plumbing: _____	_____
Final: <u>D. E. Reinhold</u>	<u>3-5-99</u>
Other: _____	_____



# City of Portland, Maine – Building or Use Permit Application 389 Congress Street, 04101, Tel: (207) 874-8703, FAX: 874-8716

Location of Construction: 21 Kingsmark Ln		Owner: Peverada, Judith & John		Phone:		Permit No: 970551 <b>PERMIT ISSUED</b> Permit Issued: JUN - 6 1997 <b>CITY OF PORTLAND</b>	
Owner Address:		Lessee/Buyer's Name:		Phone: X8444			BusinessName:
Contractor Name: Owner		Address:		Phone:			
Past Use:  1-fam		Proposed Use:  Same		COST OF WORK: \$ 2,000.00 FIRE DEPT. <input type="checkbox"/> Approved <input type="checkbox"/> Denied Signature:			PERMIT FEE: \$ 30.00 INSPECTION: Use Group 193 Type: 5B BOC # 96 Signature: <i>Hayfae</i>
Proposed Project Description:  Construct Deck (20 x 12)				PEDESTRIAN ACTIVITIES DISTRICT (P.A.D.) Action: Approved <input type="checkbox"/> Approved with Conditions: <input type="checkbox"/> Denied <input type="checkbox"/> Signature: _____ Date: _____			
Permit Taken By: Mary Gresik		Date Applied For: 05 June 1997					Zoning: R-2 CBL: 227-E-020 Zoning Approval: <i>OK - 3 6/5/96</i> Special Zone or Reviews: <input type="checkbox"/> Shoreland <input type="checkbox"/> Wetland <input type="checkbox"/> Flood Zone <input type="checkbox"/> Subdivision <input type="checkbox"/> Site Plan maj <input type="checkbox"/> minor <input type="checkbox"/> mm <input type="checkbox"/>

1. This permit application does not preclude the Applicant(s) from meeting applicable State and Federal rules.
2. Building permits do not include plumbing, septic or electrical work.
3. Building permits are void if work is not started within six (6) months of the date of issuance. False information may invalidate a building permit and stop all work..

PERMIT ISSUED  
WITH REQUIREMENTS

## CERTIFICATION

I hereby certify that I am the owner of record of the named property, or that the proposed work is authorized by the owner of record and that I have been authorized by the owner to make this application as his authorized agent and I agree to conform to all applicable laws of this jurisdiction. In addition, if a permit for work described in the application is issued, I certify that the code official's authorized representative shall have the authority to enter all areas covered by such permit at any reasonable hour to enforce the provisions of the code(s) applicable to such permit

*John Peverada* 21 Kingsmark Ln. P.H.D. 05 June 1997 775-0690  
 SIGNATURE OF APPLICANT John Peverada ADDRESS: DATE: PHONE:  
 SAME  
 RESPONSIBLE PERSON IN CHARGE OF WORK, TITLE PHONE:

White-Permit Desk Green-Assessor's Canary-D.P.W. Pink-Public File Ivory Card-Inspector

**Historic Preservation**  
☒ Not in District or Landmark  
☐ Does Not Require Review  
☐ Requires Review

## Action:

☐ Approved  
☐ Approved with Conditions  
☐ Denied

Date: 6/5/97

CEO DISTRICT

4

A. Powers

Applicant: John Perenzda

Date: 6/5/97

Address: 21 Keysmark Lane

C-B-L: 227-E-20

CHECK-LIST AGAINST ZONING ORDINANCE

Date - Existing 1996

Zone Location - R-2

Interior or corner lot -

Proposed Use/Work - New deck 12 x 20

Sewage Disposal - City

Lot Street Frontage -

Front Yard - N/A

Rear Yard - 25' req - 25' + shown

Side Yard - 12' req - 16' + shown

Projections -

Width of Lot -

Height -

Lot Area - 10,000<sup>sq</sup> ft 12,567<sup>sq</sup> ft shown

Lot Coverage/ Impervious Surface - 20% MAX

= 2513.4

Area per Family -

Off-street Parking -

Loading Bays -

Site Plan -

Shoreland Zoning/ Stream Protection -

Flood Plains -

26 x 30 780  
26 x 36 936  
12 x 20 = 240

1956<sup>sq</sup> ft

## BUILDING PERMIT REPORT

DATE: 6 June 92 ADDRESS: 21 Kingsmark Lane  
REASON FOR PERMIT: To Construct 12'x20' deck  
BUILDING OWNER: Judith & John Peverada  
CONTRACTOR: Owner  
PERMIT APPLICANT: ↑ APPROVAL: \*1, \*2, \*7, \*9 ~~DENIED~~

### CONDITION(S) OF APPROVAL

- X 1. This permit does not excuse the applicant from meeting applicable State and Federal rules and laws.
- X 2. Before concrete for foundation is placed, approvals from the ~~Development Review Coordinator and~~ Inspection Services must be obtained. (A 24 hour notice is required prior to inspection)
3. Precaution must be taken to protect concrete from freezing.
4. It is strongly recommended that a registered land surveyor check all foundation forms before concrete is placed. This is done to verify that the proper setbacks are maintained.
5. Private garages located beneath habitable rooms in occupancies in Use Group R-1, R-2, R-3 or I-1 shall be separated from adjacent interior spaces by fire partitions and floor/ceiling assembly which are constructed with not less than 1-hour fire resisting rating. Private garages attached side-by-side to rooms in the above occupancies shall be completely separated from the interior spaces and the attic area by means of ½ inch gypsum board or the equivalent applied to the garage means of ½ inch gypsum board or the equivalent applied to the garage side. (Chapter 4 Section 407.0 of the BOCA/1996)
6. All chimneys and vents shall be installed and maintained as per Chapter 12 of the City's Mechanical Code. (The BOCA National Mechanical Code/1993) U.L. 103.
- X 7. Guardrail & Handrails A guardrail system is a system of building components located near the open sides of elevated walking surfaces for the purpose of minimizing the possibility of an accidental fall from the walking surface to the lower level. Minimum height all Use Groups 42", except Use Group R which is 36". In occupancies in Use Group A, B, H-4, I-1, I-2 M and R and public garages and open parking structures, open guards shall have balusters or be of solid material such that a sphere with a diameter of 4" cannot pass through any opening. Guards shall not have an ornamental pattern that would provide a ladder effect.
8. Headroom in habitable space is a minimum of 7'6".
- X 9. Stair construction in Use Group R-3 & R-4 is a minimum of 10" tread and 7 3/4" maximum rise. All other Use group minimum 11" tread, 7" maximum rise.
10. The minimum headroom in all parts of a stairway shall not be less than 80 inches.
11. Every sleeping room below the fourth story in buildings of use Groups R and I-1 shall have at least one operable window or exterior door approved for emergency egress or rescue. The units must be operable from the inside without the use of special knowledge or separate tools. Where windows are provided as means of egress or rescue they shall have a sill height not more than 44 inches (1118mm) above the floor. All egress or rescue windows from sleeping rooms shall have a minimum net clear opening height dimension of 24 inches (610mm). The minimum net clear opening width dimension shall be 20 inches (508mm), and a minimum net clear opening of 5.7 sq. ft.
12. Each apartment shall have access to two (2) separate, remote and approved means of egress. A single exit is acceptable when it exits directly from the apartment to the building exterior with no communications to other apartment units.
13. All vertical openings shall be enclosed with construction having a fire rating of at least one (1) hour, including fire doors with self closer's.
14. The boiler shall be protected by enclosing with (1) hour fire-rated construction including fire doors and ceiling, or by providing automatic extinguishment.
15. All single and multiple station smoke detectors shall be of an approved type and shall be installed in accordance with the provisions of the City's Building Code Chapter 9, Section 19, 920.3.2 (BOCA National Building Code/1996), and NFPA 101 Chapter 18 & 19. (Smoke detectors shall be installed and maintained at the following locations):
  - In the immediate vicinity of bedrooms
  - In all bedrooms
  - In each story within a dwelling unit, including basements

In addition to the required AC primary power source, required smoke detectors in occupancies in Use Groups R-2, R-3 and I-1 shall receive power from a battery when the AC primary power source is interrupted. (Interconnection is required)




16. A portable fire extinguisher shall be located as per NFPA #10. They shall bear the label of an approved agency and be of an approved type.
17. The Fire Alarm System shall be maintained to NFPA #72 Standard.
18. The Sprinkler System shall maintained to NFPA #13 Standard.
19. All exit signs, lights, and means of egress lighting shall be done in accordance with Chapter 10 Section & Subsections 1023. & 1024. Of the City's building code. (The BOCA National Building Code/1996)
20. All construction and demolition debris must be disposed at the City's authorized reclamation site. The fee rate is attached. Proof of such disposal must be furnished to the office of Inspection Services before final Certificate of Occupancy is issued or demolition permit is granted.
21. Section 25-135 of the Municipal Code for the City of Portland states, "No person or utility shall be granted a permit to excavate or open any street or sidewalk from the time of November 15 of each year to April 15 of the following year".
22. The builder of a facility to which Section 4594-C of the Maine State Human Rights Act Title 5 MRSA refers, shall obtain a certification from a design professional that the plans commencing construction of the facility, the builder shall submit the certification to the Division of Inspection Services.
23. This permit does not excuse the applicant from obtaining any license which may be needed from the City Clerk's office.
24. Ventilation shall meet the requirements of Chapter 12 Sections 1210. of the City's Building Code.
25. All electrical and plumbing permits must be obtained by a Master Licensed holders of their trade.
26. \_\_\_\_\_
27. \_\_\_\_\_
28. \_\_\_\_\_

  
P. Samuel Hoffes, Chief of Code Enforcement

cc: Lt. McDougall, PFD  
Marge Schmuckal

MORTGAGE INSPECTION FOR-

JOHN PERVERADA R-2 Zone  
21 KINGSMARK LANE 227-6-20  
PORTLAND, MAINE 12,567 sq lot  
25'x45' / 125' side


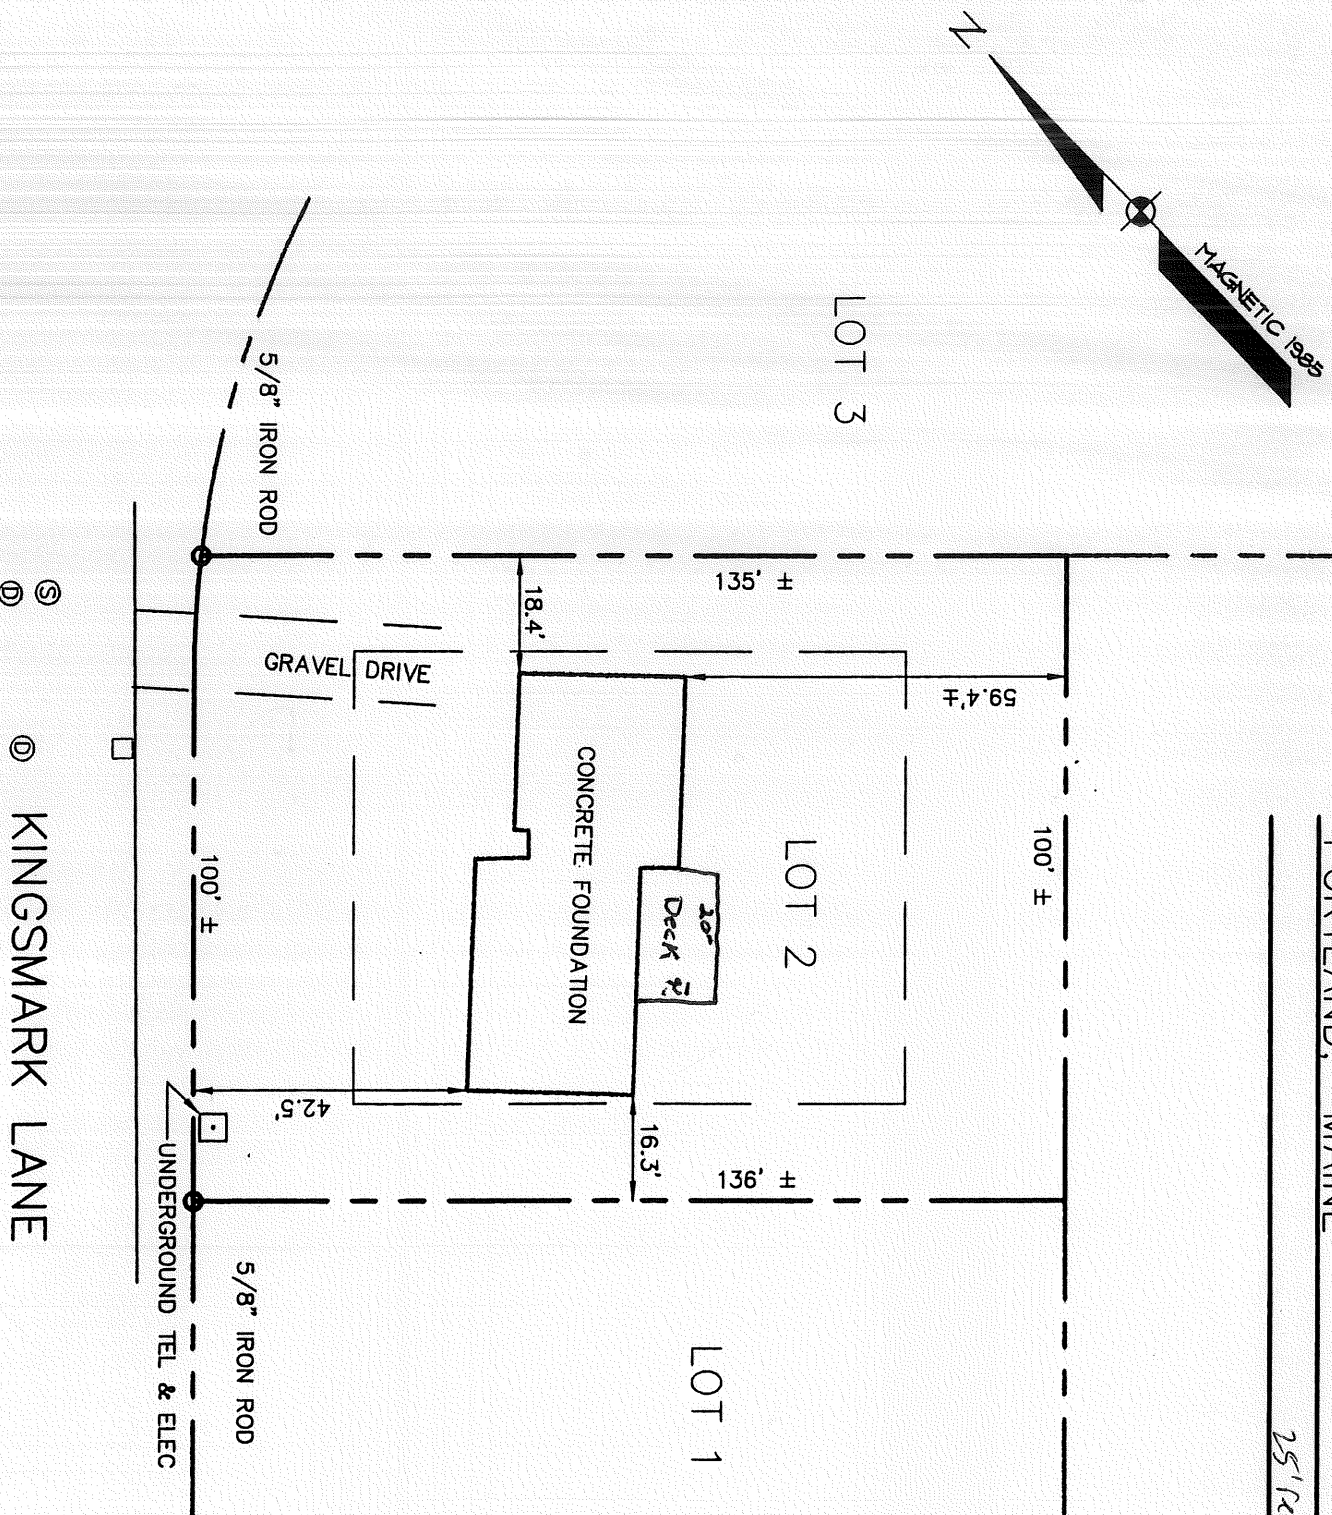


NOTES-

1. THIS PLAN IS NOT A STANDARD BOUNDARY SURVEY AND IS NOT TO BE RECORDED.
2. THE DECLARATIONS HEREON ARE FOR MORTGAGE PURPOSES ONLY.
3. THIS PLAN CONSTITUTES A LOCATIONAL DETERMINATION OF THE STRUCTURES IN RELATION TO THE APPARENT PROPERTY LINES AS OBSERVED AT THE TIME OF THE FIELD INSPECTION. THIS PLAN DOES NOT CONSTITUTE A FULL INSTRUMENT SURVEY OF THE PROPERTY BOUNDARIES.
4. "I HEREBY DECLARE THAT THIS SKETCH IS SUBSTANTIALLY CORRECT IN ACCORDANCE WITH CHAPTER 6, SECTION 12 OF THE RULES OF THE MAINE STATE BOARD OF LICENSURE FOR PROFESSIONAL LAND SURVEYORS. THIS SKETCH IS COMPILED FROM OTHER MAPS, DEED DIMENSIONS, AND/OR OTHER SOURCES OF INFORMATION, AND IS SUBJECT TO CHANGE AS A STANDARD BOUNDARY OR LAND TITLE SURVEY MIGHT DISCLOSE."
5. PLAN REFERENCE: PLAN BOOK 168, PAGE 28

CONFIRMATION STATEMENTS-

I HEREBY DECLARE TO: APPROVED HOME MORTGAGE  
AND ITS TITLE INSURER THAT TO THE BEST OF MY KNOWLEDGE THIS PLAN DEPICTS THE RESULTS OF AN EXAMINATION OF THE PREMISES DESCRIBED IN VOLUME 12236 PAGE 62 OF THE CUMBERLAND COUNTY REGISTRY OF DEEDS AND THAT EASEMENTS, ENCROACHMENTS, AND BUILDINGS OBSERVED ARE SHOWN AS LOCATED ON THE GROUND  
THAT THE BUILDING LOCATION AS SHOWN DOES COMPLY WITH THE LOCAL ZONING REQUIREMENT.  
THAT THIS LOT DOES NOT FALL WITHIN A FLOOD HAZARD AREA IN ACCORDANCE WITH THE LOCAL MUNICIPALITY AND FLOOD HAZARD MAP NO. 230051-0012-B JULY 17, 1986

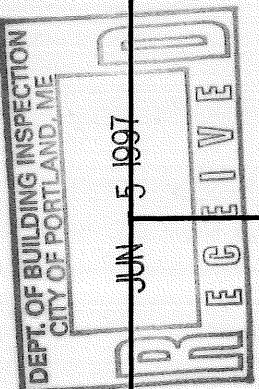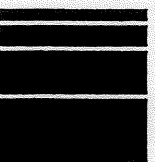

**Sebago Technics**  
*Engineering & Planning for the Future*  
12 WESTBROOK COMMON  
WESTBROOK, ME 04098-1339  
TEL (207) 856-0277



DRAWN BY:	DB
CHECKED BY:	TFM
SCALE:	1" = 30'
FIELD BOOK:	518-533
DATE:	1-03-96
PROJECT NO.	95601

*Handwritten signature*



John Peveroda  
21 Kingsmark La.

X 8444

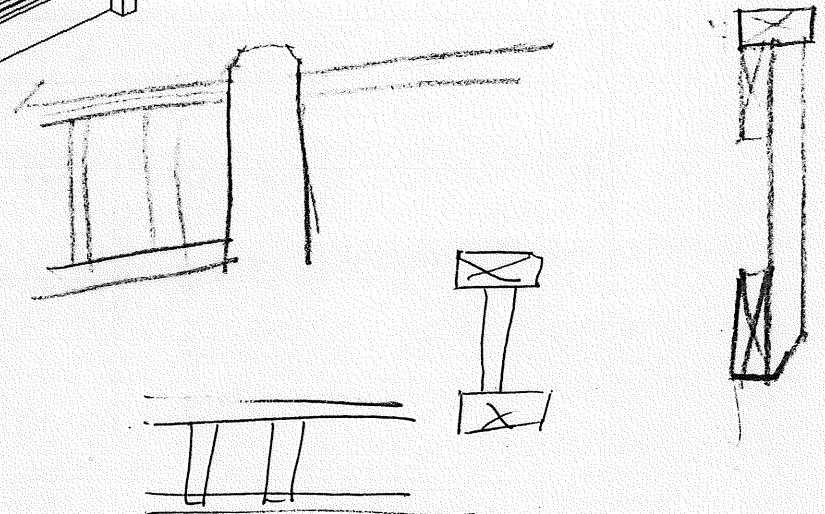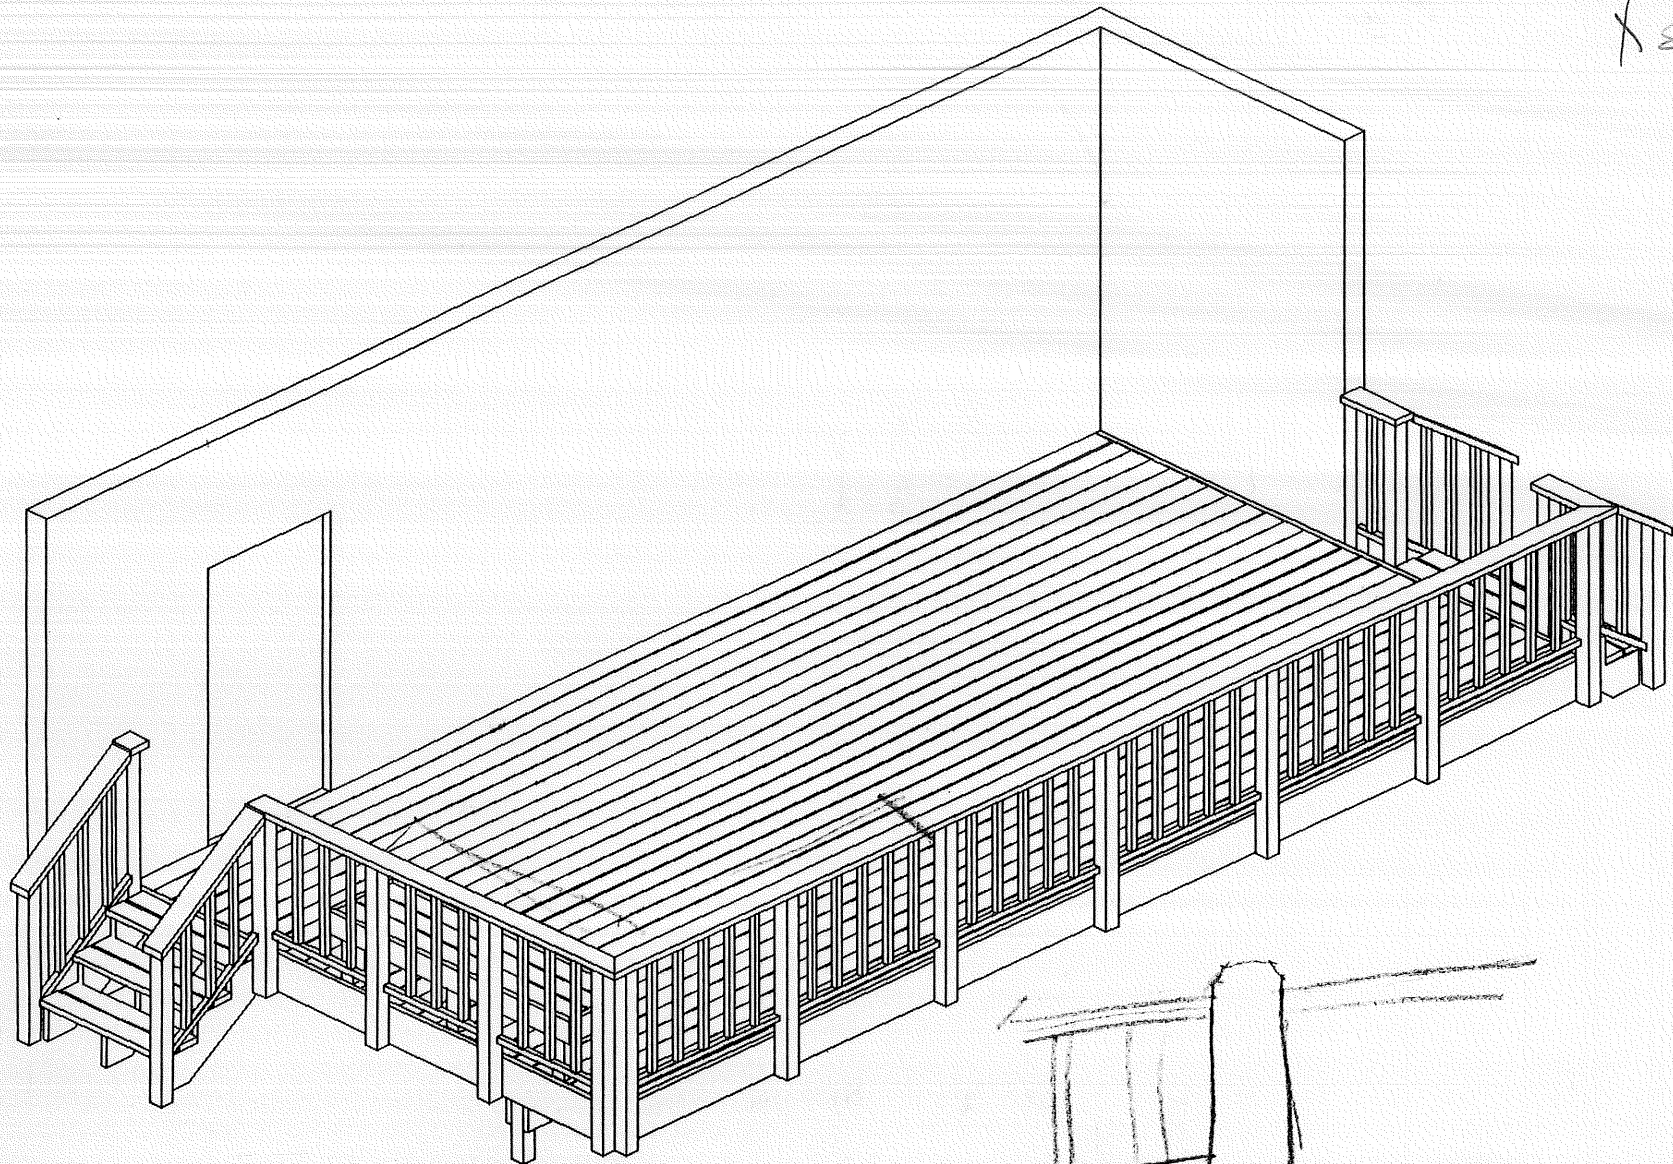




# BEAM LAYOUT

CUSTOMER -- J B P


DATE 06/02/96 REF JBP50690

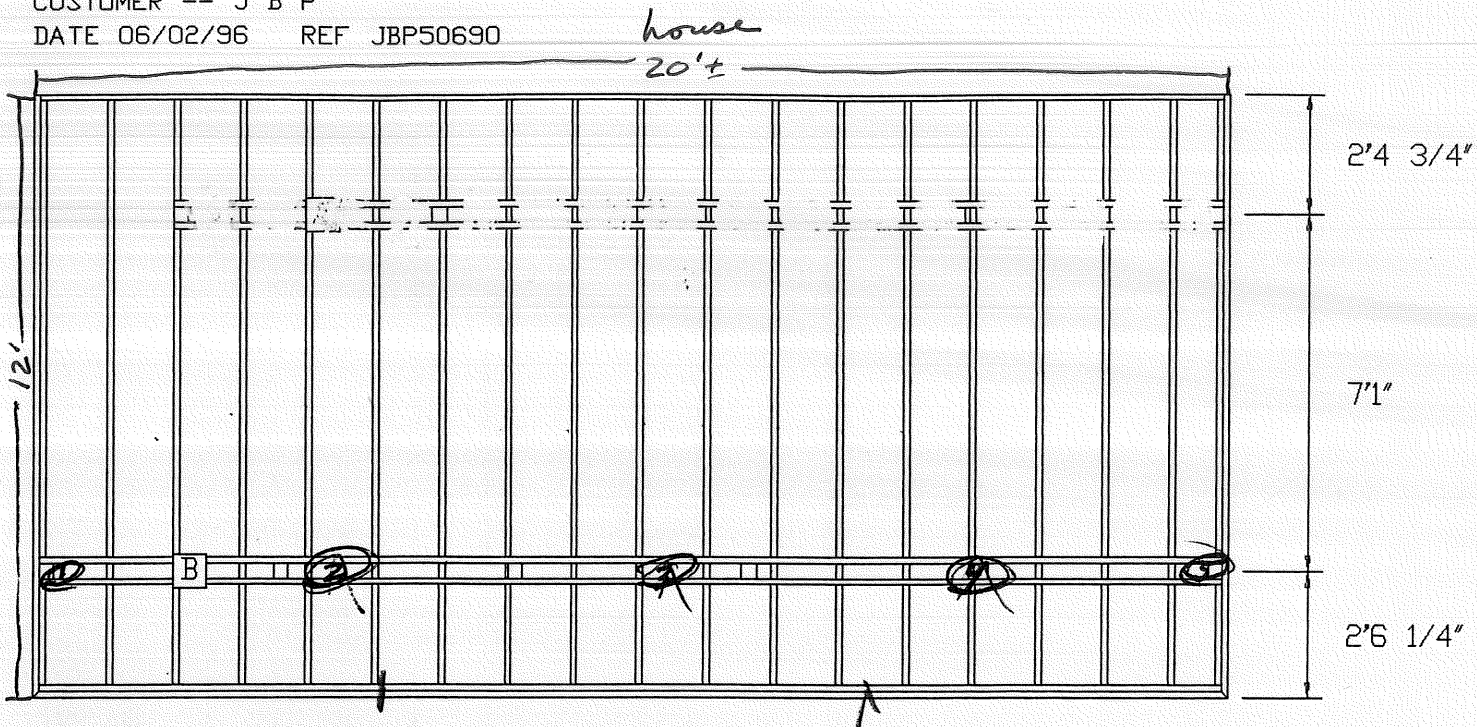

BEAM LABEL	BEAM LENGTH	POST COUNT	POST SPACING	
<del>A</del>	<del>21'1"</del>	<del>5</del>	5'2 3/8"	
B	23'9"	5	4'8 5/16" 5'±	O = Sonotubes

Post spacing is measured center-to-center.

Depth of concrete footers --- 48 inches.

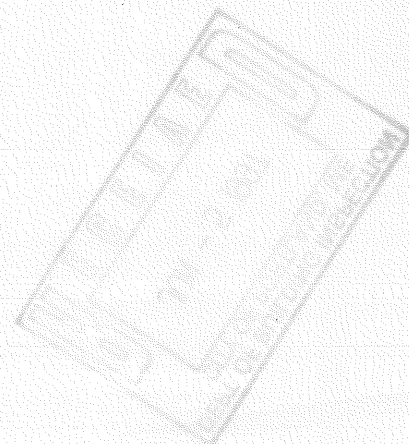

## BASIC GUIDELINES FOR DECK PERMITS

Materials needed to apply for permit:

- 1) Plot Plan - A Bird's eye view of your property showing where all your buildings are located in relationship to the lot lines and each other. You need to show those distances (the front, rear and sides) in feet.
- 2) Construction Plan - Cross Section. What dimensional lumber/materials are being used and what is their make-up?
- 3) Fee - Based on cost of work labor/materials. 25.00 1st 1,000 worth of work, 5.00 each additional 1,000.

The following check-off sheet can be used in most circumstances:

### Foundation

\_\_\_\_\_ Frost wall, min 4' below grade  
8" Sone tubes, min 4' below grade, 6" min on footing, hard pan or bedrock  
\_\_\_\_\_ Other

### Sill

5' Distance between foundation supports

### Joist Size

\_\_\_\_\_ 2x6 X 2x8 \_\_\_\_\_ 2x10

### Joist Span

10'

### Distance Between Joists

X 16"oc \_\_\_\_\_ 24"oc \_\_\_\_\_ other

### Decking

X 5/4 x6" P.T. other/explain

### Stair Construction

✓ 10" min tread ✓ 7 3/4" max riser

### Guard Height

X 36" \_\_\_\_\_ 42"

Guards shall be located along open-sided walking surfaces located 15 1/2" above the floor or below grade. Single family - min 36", all others 42", measured vertically above the leading edge of the tread or adjacent walking surface. BOCA 1005.5/1021.2

### Balusters

✓ /under 4"

Open guards shall have balusters or be of a solid material such that a sphere with a diameter of 4" cannot pass through any opening. Guards shall not have an ornamental pattern that would provide a ladder effect.