

**City of Portland, Maine – Building or Use Permit Application** 389 Congress Street, 04101, Tel: (207) 874-8703, FAX: 874-8716

Location of Construction: 86 Partridge Circle		Owner: Catherine Morin- Matthew Campbell/ Campbell		Phone: 774-9485	Permit No: <b>991083</b>
Owner Address: SAA		Lessee/Buyer's Name:		Phone:	
Contractor Name: **Weigel Const. Ben Weigel		Address: 12 Madokawando Landing ME 04105		Phone: 781-5569	BusinessName:
Past Use: 1-Family		Proposed Use: Same		<b>COST OF WORK:</b> \$ 32,000	<b>PERMIT FEE:</b> \$ 216.00
Proposed Project Description: Complete existing rough-framed family room over garage, provide small dormer over stairway .		FIRE DEPT. <input type="checkbox"/> Approved <input type="checkbox"/> Denied		INSPECTION: Use Group: 93 Type: 5B BOCA 96	
		Signature:		Signature: <i>[Signature]</i>	
		<b>PEDESTRIAN ACTIVITIES DISTRICT (P.A.D.)</b>		Action: <input type="checkbox"/> Approved <input type="checkbox"/> Approved with Conditions <input type="checkbox"/> Denied	
Permit Taken By: <i>UA</i>		Date Applied For: 9-22-99		Signature: _____ Date: _____	

1. This permit application does not preclude the Applicant(s) from meeting applicable State and Federal rules.
2. Building permits do not include plumbing, septic or electrical work.
3. Building permits are void if work is not started within six (6) months of the date of issuance. False information may invalidate a building permit and stop all work..

\*\*\*Send To: Ben Weigel  
Weigel Construction  
12 Madokawando Landing  
Falmouth, ME 04105

**PERMIT ISSUED  
WITH REQUIREMENTS**

**CERTIFICATION**

I hereby certify that I am the owner of record of the named property, or that the proposed work is authorized by the owner of record and that I have been authorized by the owner to make this application as his authorized agent and I agree to conform to all applicable laws of this jurisdiction. In addition, if a permit for work described in the application is issued, I certify that the code official's authorized representative shall have the authority to enter all areas covered by such permit at any reasonable hour to enforce the provisions of the code(s) applicable to such permit

SIGNATURE OF APPLICANT	ADDRESS:	DATE: 9-22-99	PHONE:
RESPONSIBLE PERSON IN CHARGE OF WORK, TITLE			PHONE:

Zone: \_\_\_\_\_ CBL: 228-A-A-008  
 Zoning Approval: *[Signature]*  
**Special Zone or Reviews:**  
 Shoreland  
 Wetland  
 Flood Zone  
 Subdivision  
 Site Plan maj  minor  mm

**Zoning Appeal**  
 Variance  
 Miscellaneous  
 Conditional Use  
 Interpretation  
 Approved  
 Denied

**Historic Preservation**  
 Not in District or Landmark  
 Does Not Require Review  
 Requires Review

**Action:**  
 Approved  
 Approved with Conditions  
 Denied  
 Date: *[Signature]*

COMMENTS

11/22/99 - FRAMING is all in good condition and within code - windows meet egress and stairs have 10 3/4 inch TREAD (Rauch) and 7- 7 1/2 rise. Waiting for electrical inspection before closing in. TOM M.

2/1/00 Checked addition stairs, smoke Det's/ Bedroom windows OK - Egress gauge all OK. Satisfied OK to Close permit.  
MUM

	Type	Inspection Record	Date
Foundation:	_____	_____	_____
Framing:	_____	_____	_____
Plumbing:	_____	_____	_____
Final:	_____	_____	_____
Other:	_____	_____	_____

**BUILDING PERMIT REPORT**

DATE: 23 Sept. 97 ADDRESS: 86 Partridge Circle CBL: 228-A-A-408  
 REASON FOR PERMIT: To complete room over garage  
 BUILDING OWNER: Campbell-Campbell  
 PERMIT APPLICANT: \_\_\_\_\_ (Contractor Weigel Const.)  
 USE GROUP R-3 CONSTRUCTION TYPE 5B

The City's Adopted Building Code (The BOCA National Building Code/1996 with City Amendments)  
 The City's Adopted Mechanical Code (The BOCA National Mechanical Code/1993)


**CONDITION(S) OF APPROVAL**

This permit is being issued with the understanding that the following conditions are met: \*1, \*8, \*11, \*12, \*13, \*15, \*14  
\*19, \*27, \*29, \*32, \*33, \*31  
 Approved with the following conditions: \_\_\_\_\_

1. This permit does not excuse the applicant from meeting applicable State and Federal rules and laws.
2. Before concrete for foundation is placed, approvals from the Development Review Coordinator and Inspection Services must be obtained. (A 24 hour notice is required prior to inspection) **"ALL LOT LINES SHALL BE CLEARLY MARKED BEFORE CALLING."**
3. Foundation drain shall be placed around the perimeter of a foundation that consists of gravel or crushed stone containing not more than 10 percent material that passes through a No. 4 sieve. The drain shall extend a minimum of 12 inches beyond the outside edge of the footing. The thickness shall be such that the bottom of the drain is not higher than the bottom of the base under the floor, and that the top of the drain is not less than 6 inches above the top of the footing. The top of the drain shall be covered with an approved filter membrane material. Where a drain tile or perforated pipe is used, the invert of the pipe or tile shall not be higher than the floor elevation. The top of joints or top of perforations shall be protected with an approved filter membrane material. The pipe or tile shall be placed on not less than 2" of gravel or crushed stone, and shall be covered with not less than 6" of the same material. Section 1813.5.2
4. Foundations anchors shall be a minimum of 1/2" in diameter, 7" into the foundation wall, minimum of 12" from corners of foundation and a maximum 6' o.c. between bolts. (Section 2305.17)
5. Waterproofing and dampproofing shall be done in accordance with Section 1813.0 of the building code.
6. Precaution must be taken to protect concrete from freezing. Section 1908.0
7. It is strongly recommended that a registered land surveyor check all foundation forms before concrete is placed. This is done to verify that the proper setbacks are maintained.
8. Private garages located beneath habitable rooms in occupancies in Use Group R-1, R-2, R-3 or I-1 shall be separated from adjacent interior spaces by fire partitions and floor/ceiling assembly which are constructed with not less than 1-hour fire resisting rating. Private garages attached side-by-side to rooms in the above occupancies shall be completely separated from the interior spaces and the attic area by means of 1/2 inch gypsum board or the equivalent applied to the garage means of 1/2 inch gypsum board or the equivalent applied to the garage side. (Chapter 4, Section 407.0 of the BOCA/1996)
9. All chimneys and vents shall be installed and maintained as per Chapter 12 of the City's Mechanical Code. (The BOCA National Mechanical Code/1993). Chapter 12 & NFPA 211
10. Sound transmission control in residential building shall be done in accordance with Chapter 12, Section 1214.0 of the City's Building Code.
11. Guardrails & Handrails: A guardrail system is a system of building components located near the open sides of elevated walking surfaces for the purpose of minimizing the possibility of an accidental fall from the walking surface to the lower level. Minimum height all Use Groups 42", except Use Group R which is 36". In occupancies in Use Group A, B, H-4, I-1, I-2, M and R and public garages and open parking structures, open guards shall have balusters or be of solid material such that a sphere with a diameter of 4" cannot pass through any opening. Guards shall not have an ornamental pattern that would provide a ladder effect. (Handrails shall be a minimum of 3e4" but not more than 38". Use Group R-3 shall not be less than 30", but not more than 38".) Handrail grip size shall have a circular cross section with an outside diameter of at least 1 1/4" and not greater than 2". (Sections 1021 & 1022.0) - Handrails shall be on both sides of stairway. (Section 1014.7)
12. Headroom in habitable space is a minimum of 7'6". (Section 1204.0)
13. Stair construction in Use Group R-3 & R-4 is a minimum of 10" tread and 7 3/4" maximum rise. All other Use Group minimum 11" tread, 7" maximum rise. (Section 1014.0)
14. The minimum headroom in all parts of a stairway shall not be less than 80 inches. (6'8") 1014.4
15. Every sleeping room below the fourth story in buildings of Use Groups R and I-1 shall have at least one operable window or exterior door approved for emergency egress or rescue. The units must be operable from the inside without the use of special knowledge or separate tools. Where windows are provided as means of egress or rescue they shall have a sill height not more than 44 inches (1118mm) above the floor. All egress or rescue windows from sleeping rooms shall have a minimum net clear opening height dimension of 24 inches (610mm). The minimum net clear opening width dimension shall be 20 inches (508mm), and a minimum net clear opening of 5.7 sq. ft. (Section 1018.6)



16. Each apartment shall have access to two (2) separate, remote and approved means of egress. A single exit is acceptable when it exits directly from the apartment to the building exterior with no communications to other apartment units. (Section 1010.1)
17. All vertical openings shall be enclosed with construction having a fire rating of at least one (1) hour, including fire doors with self closer's. (Over 3 stories in height requirements for fire rating is two (2) hours.) (Section 710.0)
18. The boiler shall be protected by enclosing with (1)hour fire rated construction including fire doors and ceiling, or by providing automatic extinguishment. (Table 302.1.1)
19. All single and multiple station smoke detectors shall be of an approved type and shall be installed in accordance with the provisions of the City's Building Code Chapter 9, Section 920.3.2 (BOCA National Building Code/1996), and NFPA 101 Chapter 18 &19. (Smoke detectors shall be installed and maintained at the following locations):
  - In the immediate vicinity of bedrooms
  - In all bedrooms
  - In each story within a dwelling unit, including basements
 In addition to the required AC primary power source, required smoke detectors in occupancies in Use Groups R-2, R-3 and I-1 shall receive power from a battery when the AC primary power source is interrupted. (Interconnection is required) Section 920.3.2.
20. A portable fire extinguisher shall be located as per NFPA #10. They shall bear the label of an approved agency and be of an approved type. (Section 921.0)
21. The Fire Alarm System shall maintained to NFPA #72 Standard.
22. The Sprinkler System shall maintained to NFPA #13 Standard.
23. All exit signs, lights and means of egress lighting shall be done in accordance with Chapter 10 Section & Subsections 1023.0 & 1024.0 of the City's Building Code. (The BOCA National Building Code/1996)
24. Section 25-135 of the Municipal Code for the City of Portland states, "No person or utility shall be granted a permit to excavate or open any street or sidewalk from the time of November 15 of each year to April 15 of the following year".
25. The builder of a facility to which Section 4594-C of the Maine State Human Rights Act Title 5 MRSA refers, shall obtain a certification from a design professional that the plans commencing construction of the facility, the builder shall submit the certification the Division of Inspection Services.
26. Ventilation shall meet the requirements of Chapter 12 Sections 1210.0 of the City's Building Code. (Crawl spaces & attics).
27. All electrical, plumbing and HVAC permits must be obtained by a Master Licensed holders of their trade. **No closing in of walls until all electrical (min.72 hours notice) and plumbing inspections have been done.**
28. All requirements must be met before a final Certificate of Occupancy is issued.
29. All building elements shall meet the fastening schedule as per Table 2305.2 of the City's Building Code (the BOCA National Building Code/1996).
30. Ventilation of spaces within a building shall be done in accordance with the City's Mechanical Code (The BOCA National Mechanical Code/1993). (Chapter M-16)
31. Please read and implement the attached Land Use Zoning report requirements. *see attached*
32. Boring, cutting and notching shall be done in accordance with Sections 2305.4.4, 2305.5.1 and 2305.5.3 of the City's Building Code.
33. Glass and glazing shall meet the requirements of Chapter 24 of the building code.
34. All signage, shall be done in accordance with Section 3102.0 signs of the City's Building Code, (The BOCA National Building Code 1996).
35. \_\_\_\_\_
36. \_\_\_\_\_
37. \_\_\_\_\_
38. \_\_\_\_\_

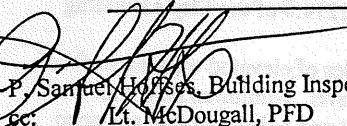  
 P. Samuel Hoffes, Building Inspector  
 cc. Lt. McDougall, PFD  
 Marge Schmuckal, Zoning Administrator

PSH 7/24/99


**\*\*On the basis of plans submitted and conditions placed on these plans any deviations shall require a separate approval.**



# WEIGEL CONSTRUCTION

Ben Weigel • 12 Madokawando Ldg. • Falmouth, ME 04105 (207) 781-5569

Campbell Section Thru Dormer over Stairway

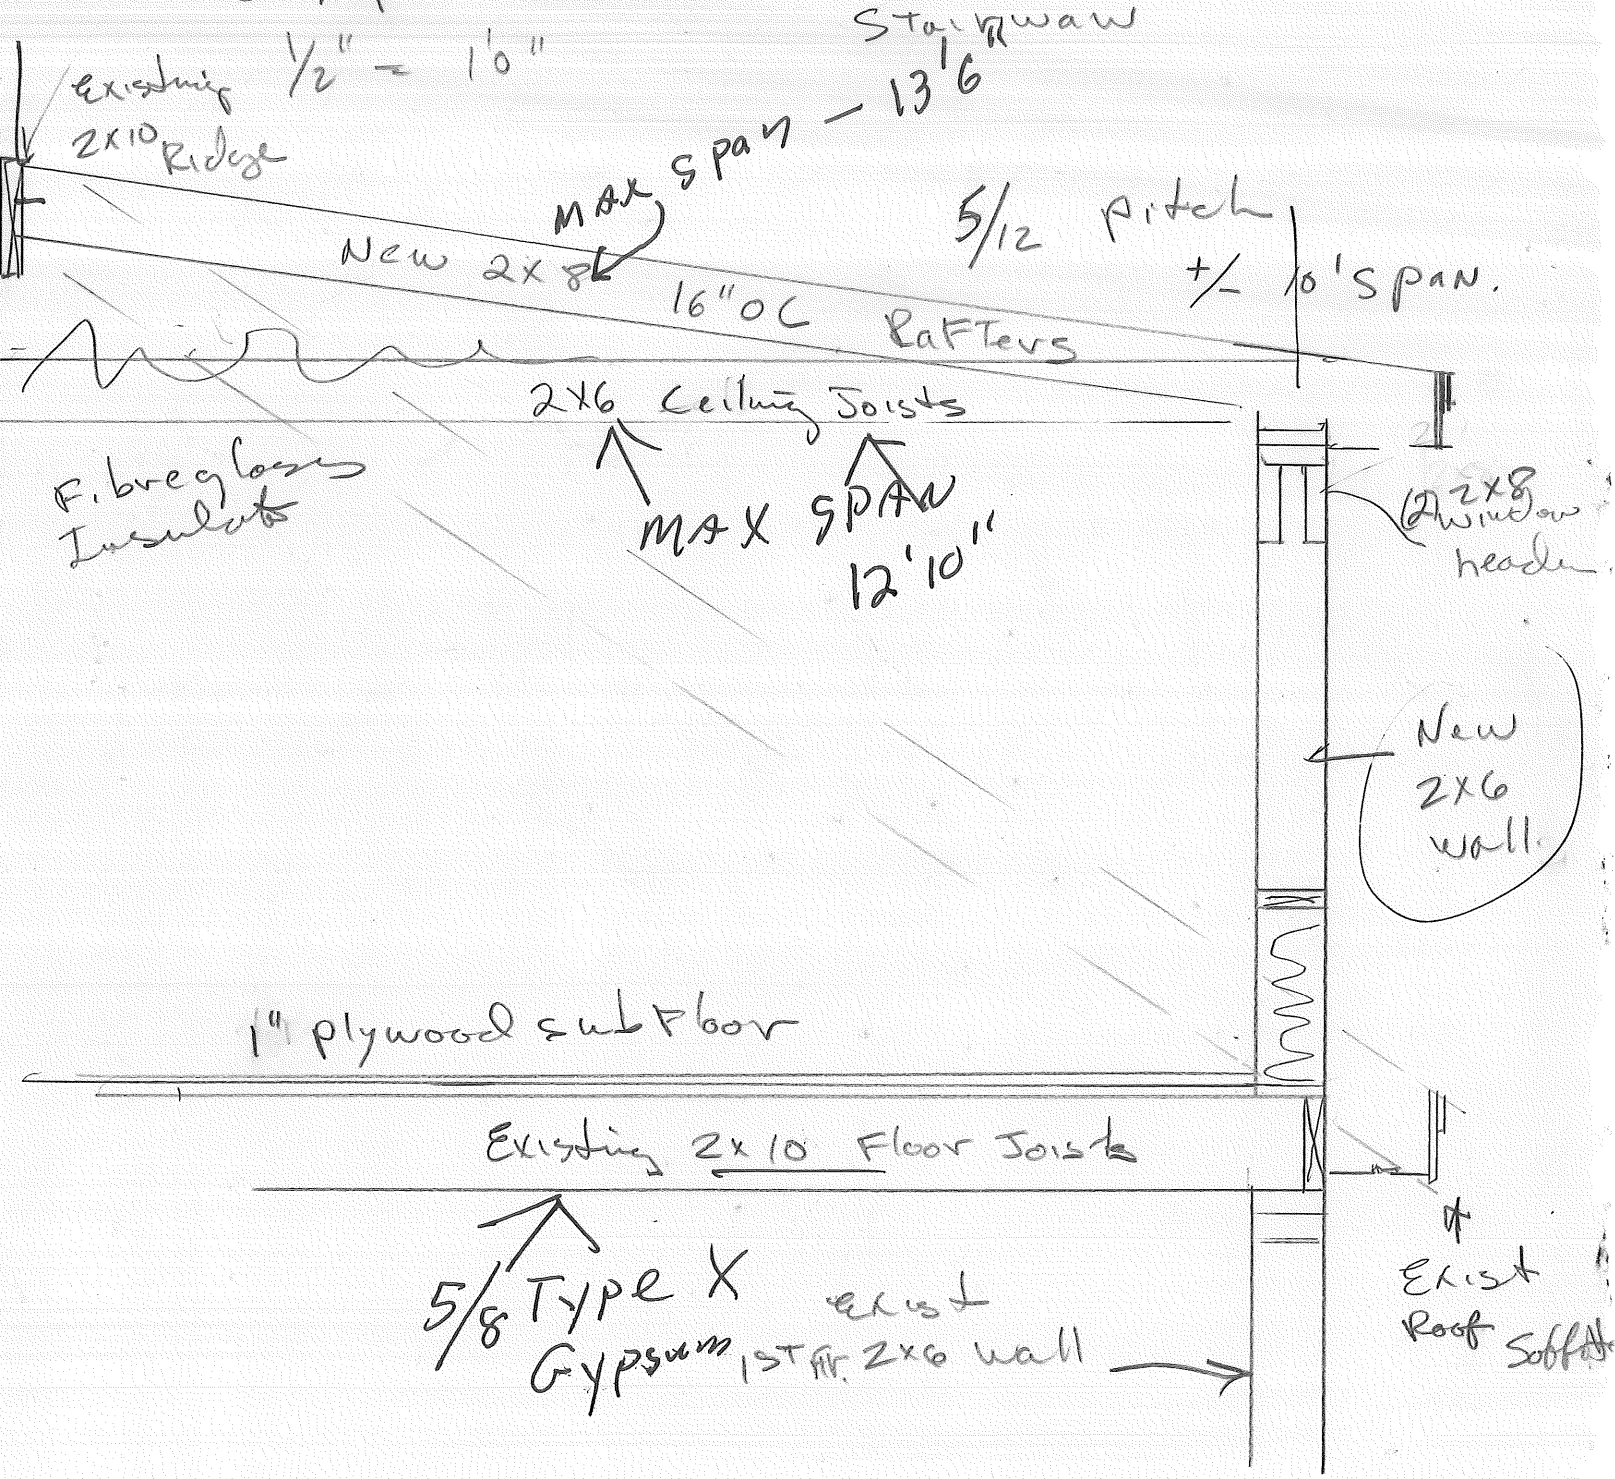




# WEIGEL CONSTRUCTION

Ben Weigel • 12 Madokawando Ldg. • Falmouth, ME 04105 (207) 781-5569

Campbell  
Dormer  
 $\frac{1}{4}'' = 1'0''$

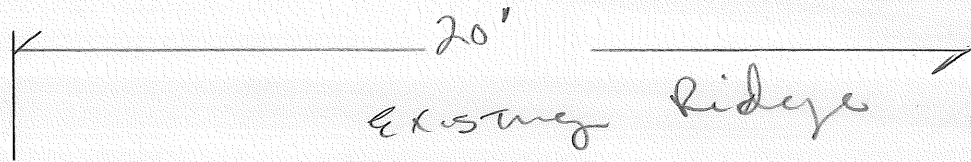


Existing  
Roof  
8/12

New Roof 5/12 pitch

EXIST  
garage

Existing 1st Floor wall



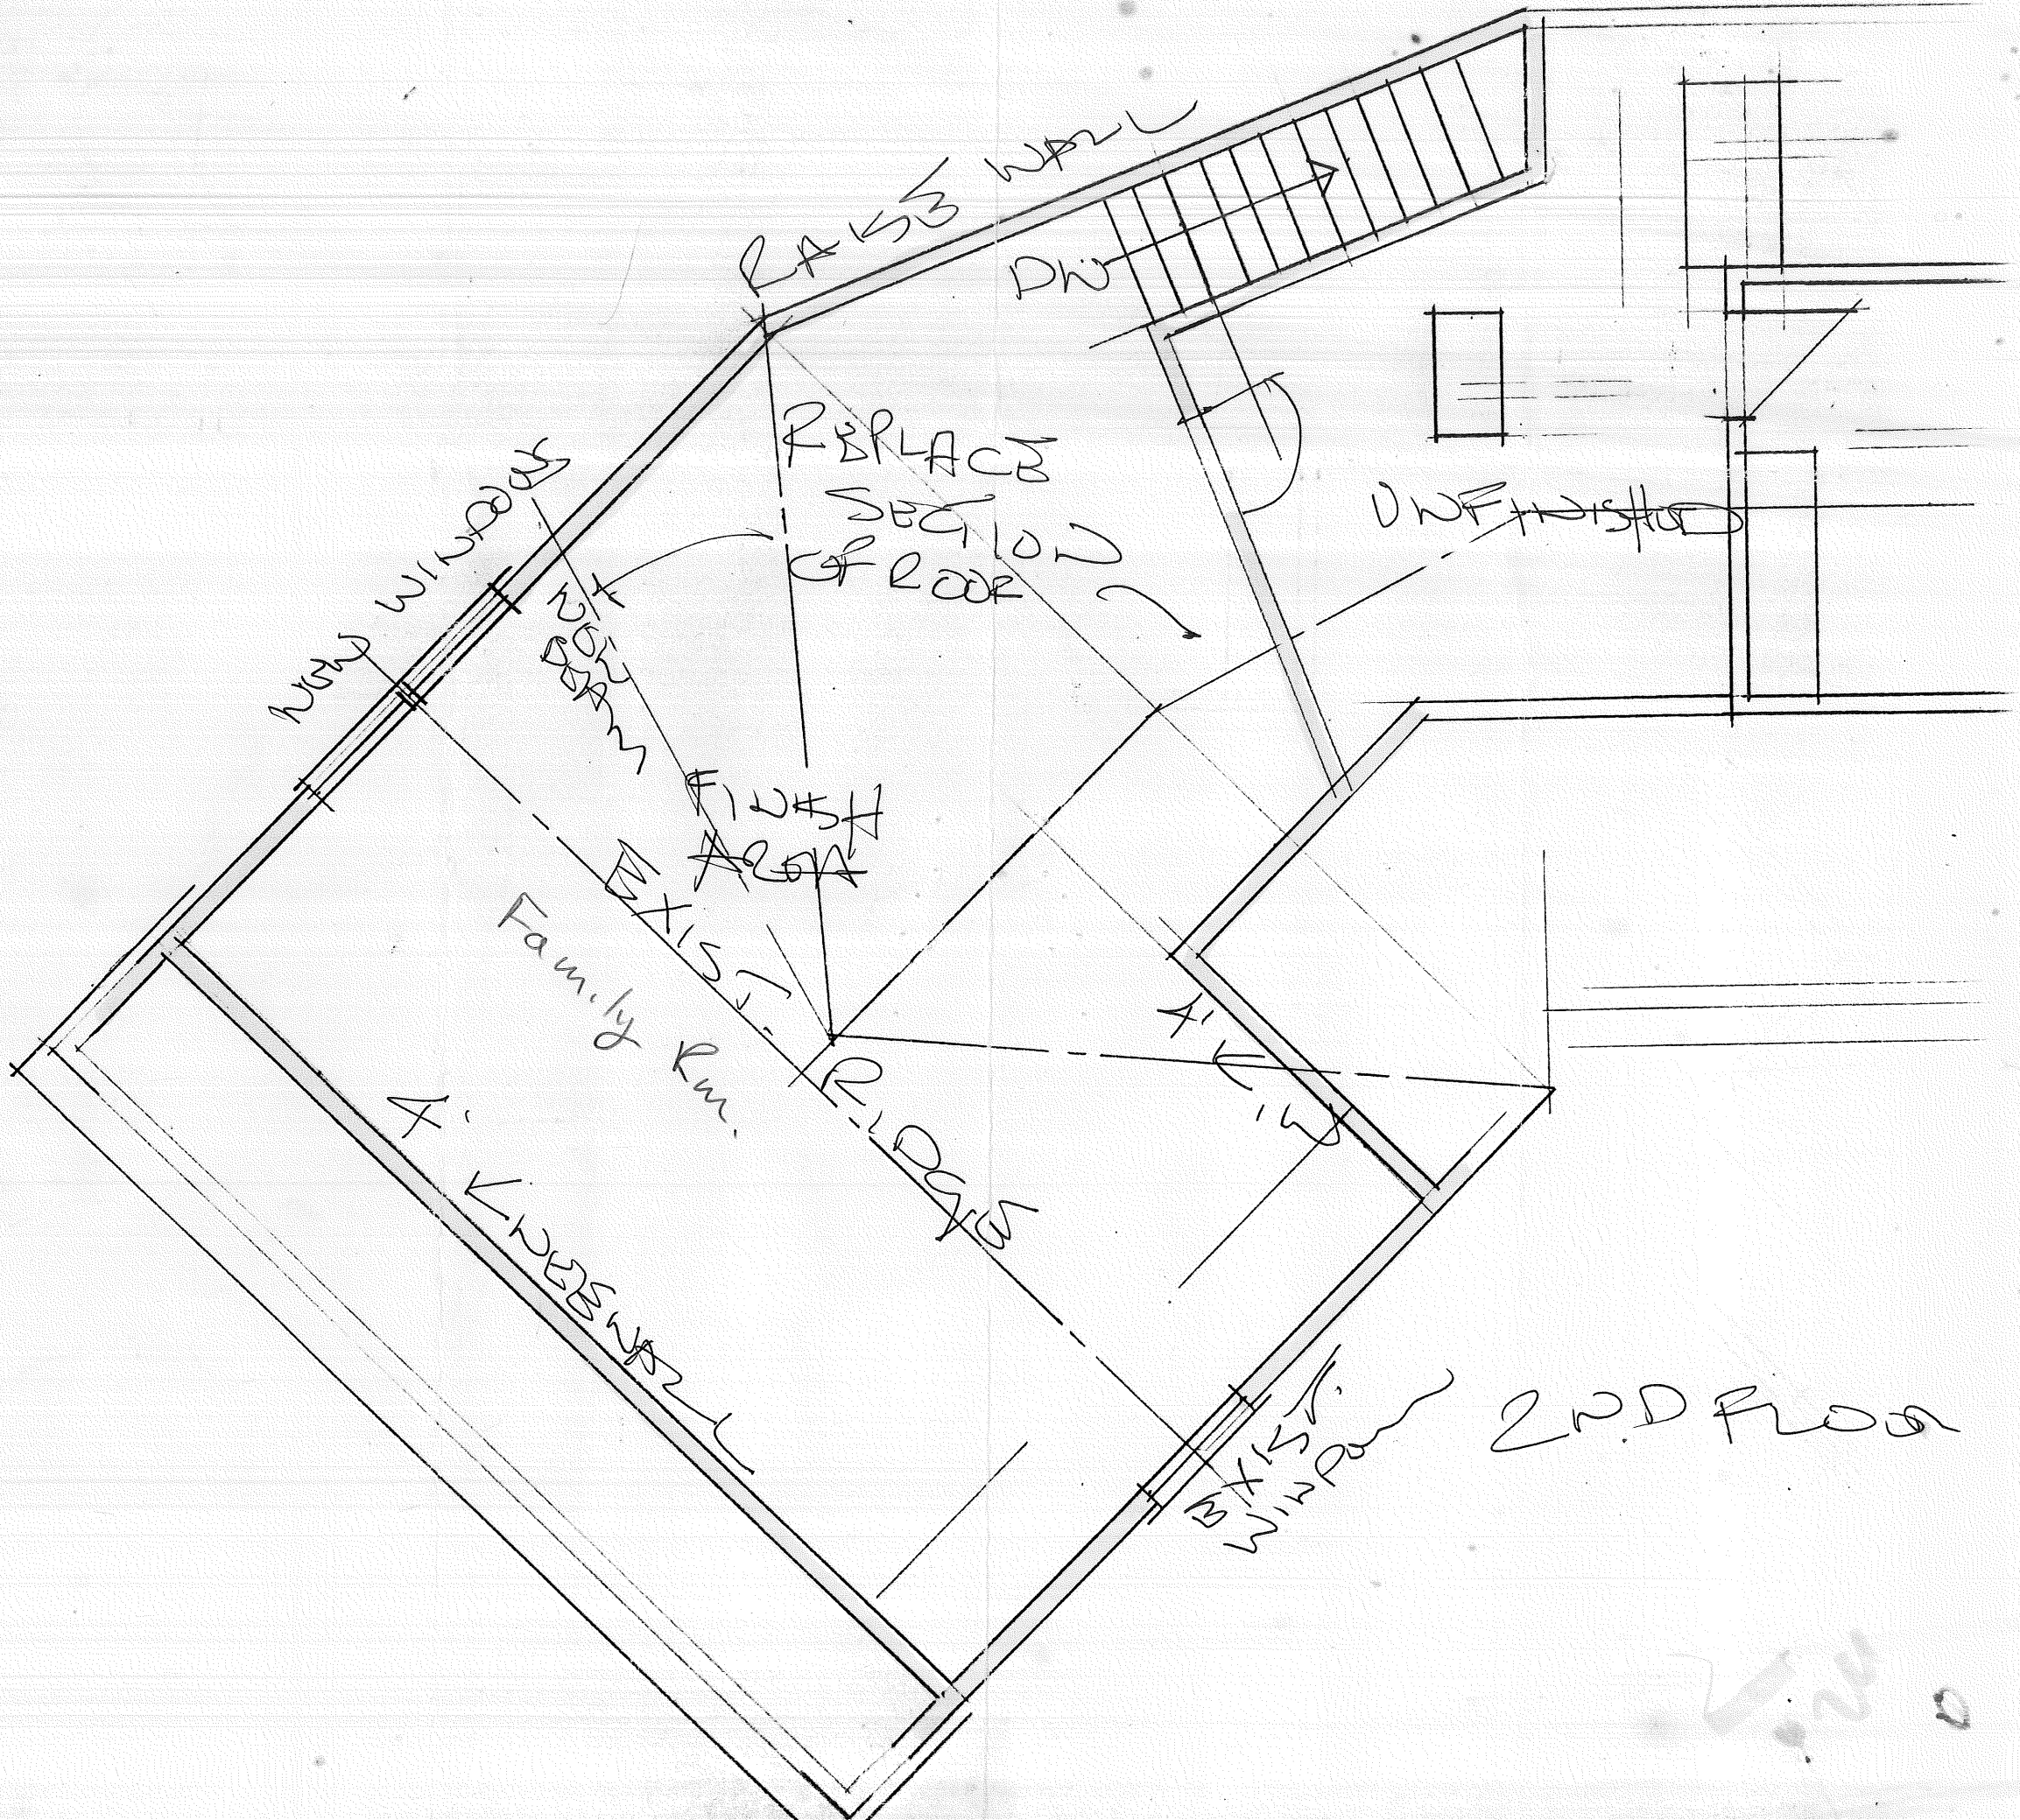

2ND FLOOR

Campbell  
Residence

1/4" = 1'0"

20' Dust Pan Dormer  
addition over existing  
space.


Bearing wall of Dormer  
To be located over  
existing outside 1st  
Floor wall.

Total height of Dormer  
Not to exceed height  
of existing Breezeway  
Roof.

Finish existing garage  
ATTIC.

Existing garage  
Existing Breezeway

New Dormer  
To provide Head Room For  
Stairway.

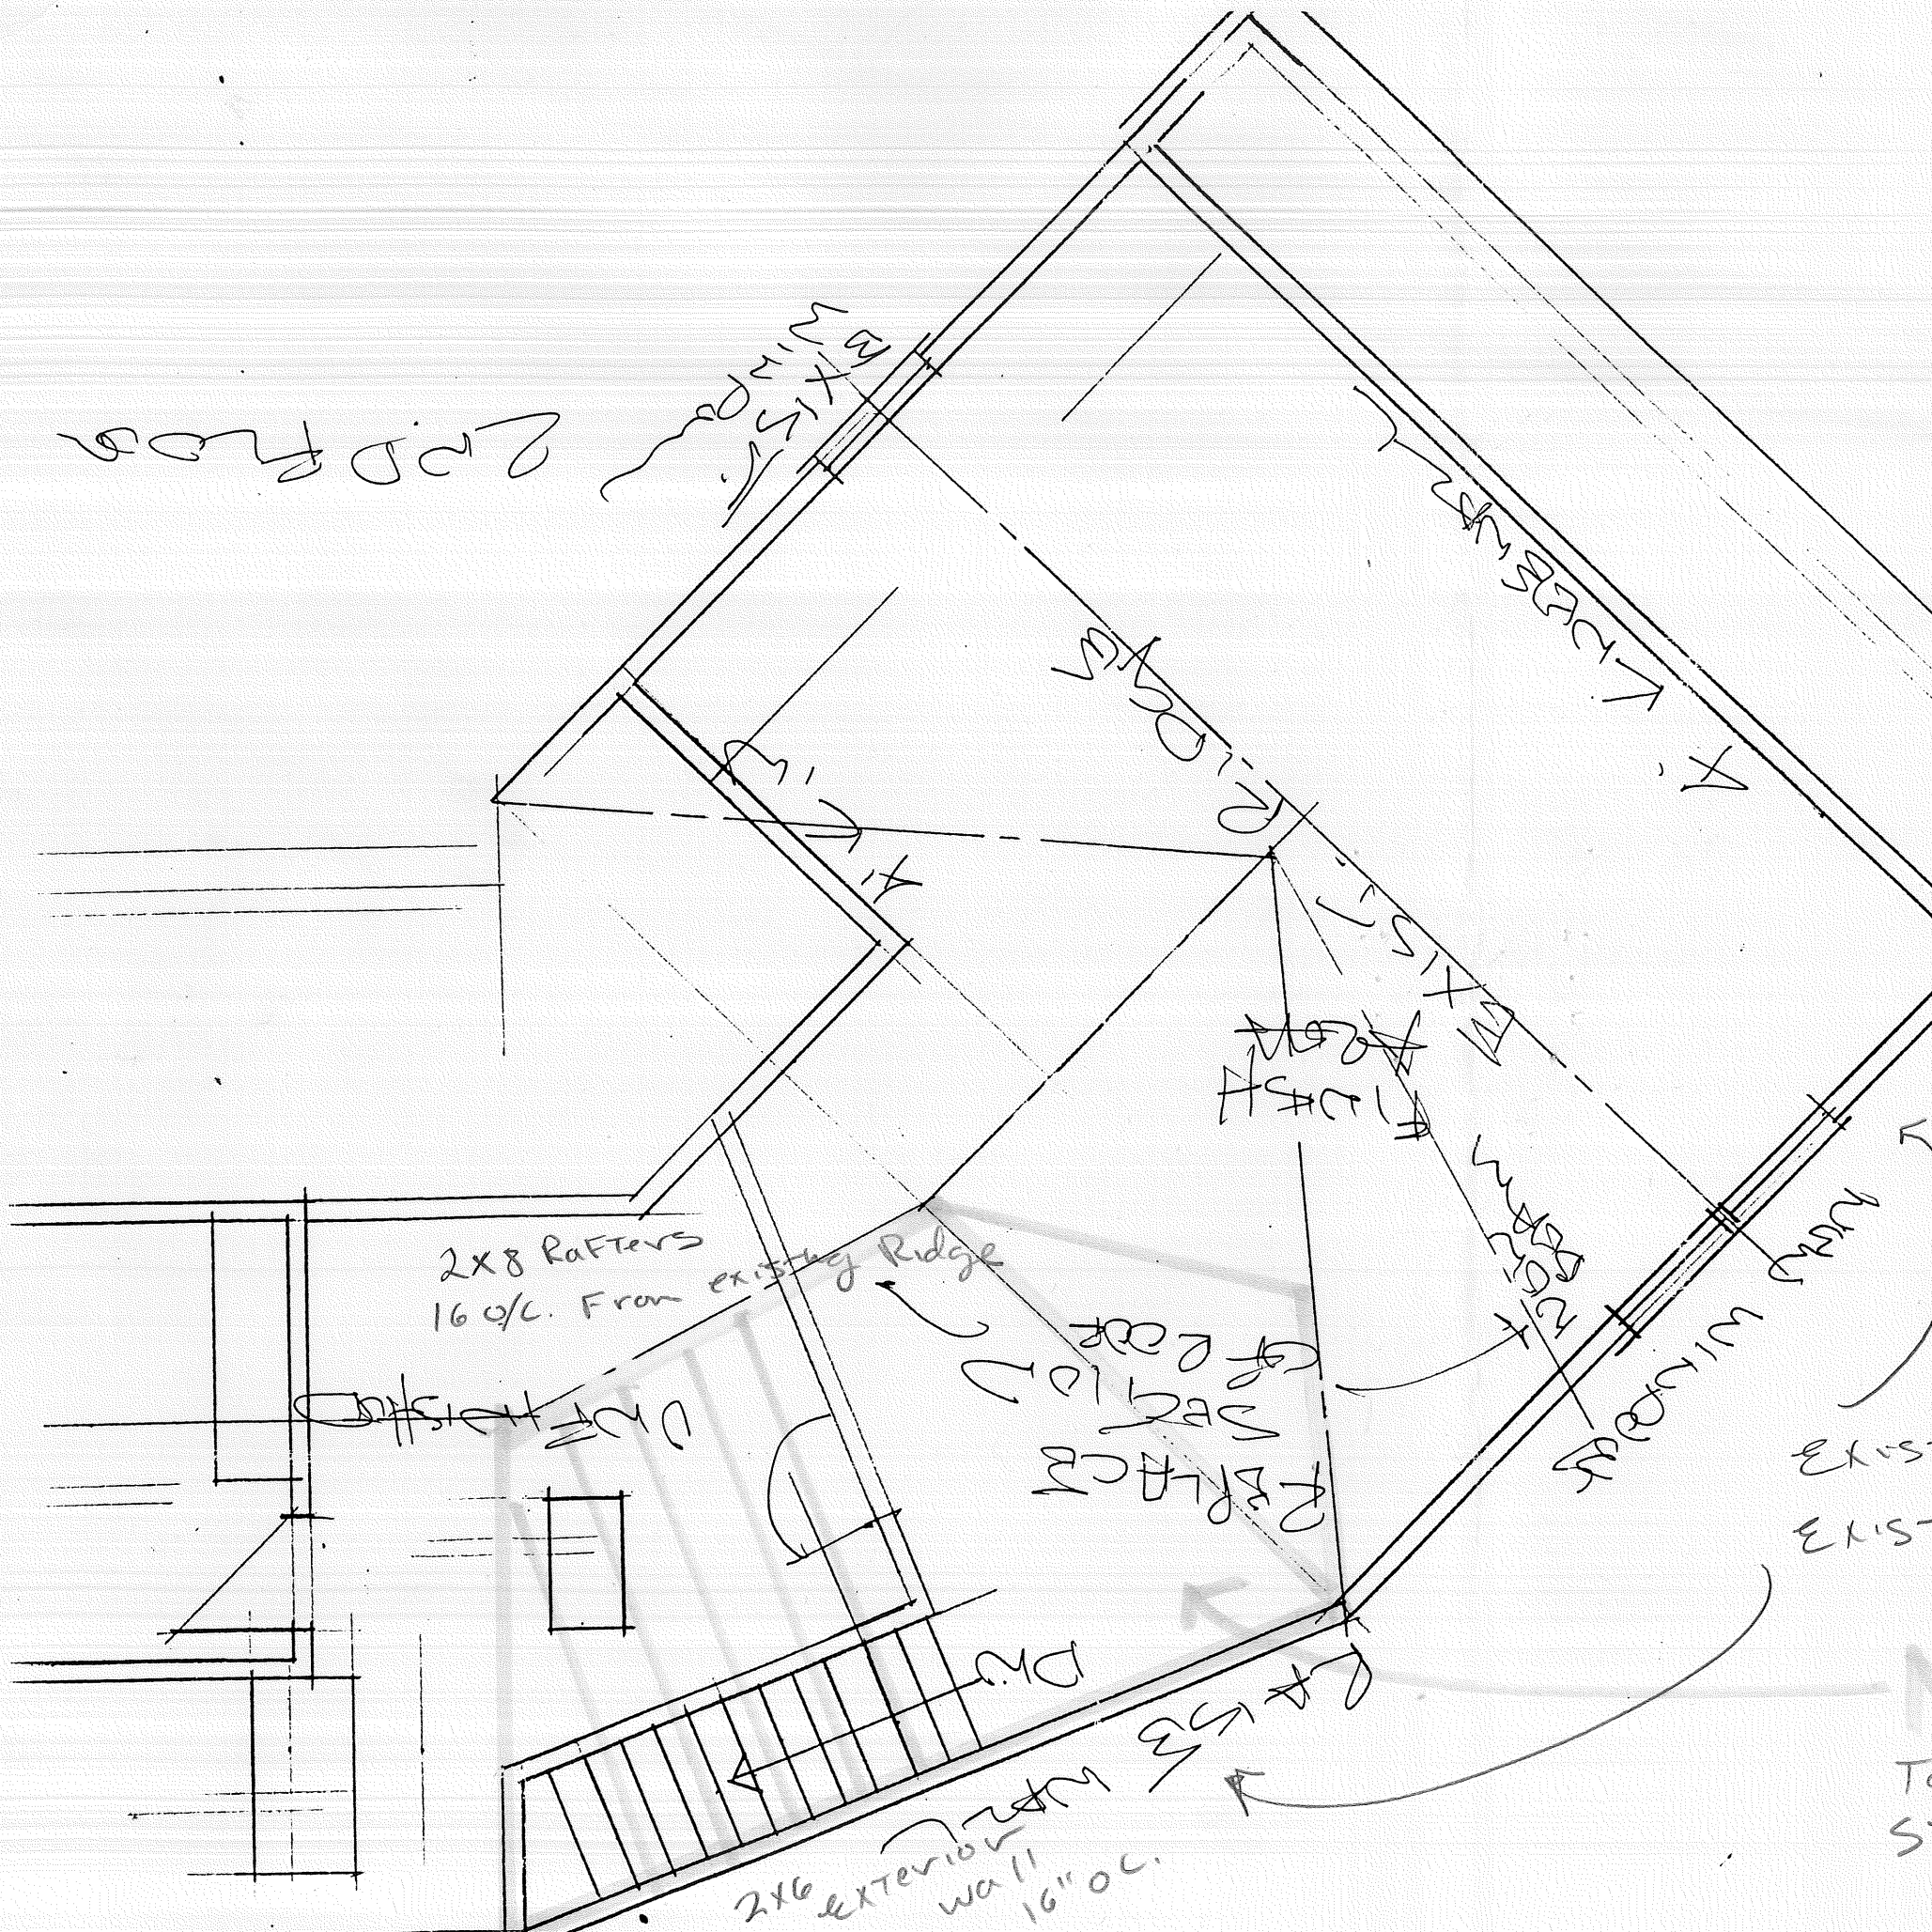

2nd Floor

2X8 RAFTERS  
16 O/C FROM EXISTING RIDGE

2X6 EXTERIOR  
WALL  
16" O.C.

FRANCE  
STAIR CASE  
FINISH FLOOR

2X12 JOIST

2X8 RIBBON

New Dormer

To provide Head Room For  
Stairway.

20' Dust Pan Dormer  
addition over existing  
space.

Bearing wall of Dormer  
To be located over  
existing outside 1st  
Floor wall.

Total height of Dormer  
Not to exceed height  
of existing Breezeway  
Roof.

Finish existing garage  
ATTIC.

Existing garage  
Existing Breezeway

Campbell  
Residence

1/4" = 1'0"



LAND USE - ZONING REPORT

ADDRESS: 86 Partridge Circle DATE: 9/30/99

REASON FOR PERMIT: Add Porcher, complete Area over garage

BUILDING OWNER: Matthew & Catherine <sup>main - Campbell</sup> C-B-L: 228A-A-8

PERMIT APPLICANT: Weigel Const.

APPROVED: with conditions DENIED: \_\_\_\_\_

#1, #6, #10

CONDITION(S) OF APPROVAL

1. This permit is being approved on the basis of plans submitted. Any deviations shall require a separate approval before starting that work.
2. During its existence, all aspects of the Home Occupation criteria, Section 14-410, shall be maintained.
3. The footprint of the existing \_\_\_\_\_ shall not be increased during maintenance reconstruction.
4. All the conditions placed on the original, previously approved, permit issued on \_\_\_\_\_ are still in effect for this amendment.
5. Your present structure is legally nonconforming as to rear and side setbacks. If you were to demolish the building on your own volition, you will **not** be able to maintain these same setbacks. Instead you would need to meet the zoning setbacks set forth in today's ordinances. In order to preserve these legally non-conforming setbacks, you may only rebuild the \_\_\_\_\_ in place and in phases.
6. This property shall remain a single family dwelling. Any change of use shall require a separate permit application for review and approval.
7. Our records indicate that this property has a legal use of \_\_\_\_\_ units. Any change in this approved use shall require a separate permit application for review and approval.
8. Separate permits shall be required for any signage.
9. Separate permits shall be required for future decks, sheds, pool(s), and/or garage.
10. This is **not** an approval for an additional dwelling unit. You **shall not** add any additional kitchen equipment, such as stoves, microwaves, refrigerators, or kitchen sinks, etc.
11. Other requirements of condition \_\_\_\_\_

Marge Schmuckal Marge Schmuckal, Zoning Administrator

THIS IS NOT A BOUNDARY SURVEY

INSPECTION OF PREMISES


I HEREBY CERTIFY TO  
NORTHEAST LAND TITLE, SCHAEFER  
MORTGAGE & ITS TITLE INSURETY

86 PARTRIDGE CIR.,  
PORTLAND, ME.

Job Number: 215-49  
Inspection Date: 9-11-93  
Scale: 1" = 60'

The monumentation is ~~not~~ in harmony with current deed description.  
The building setbacks are ~~not~~ in conformity with town zoning requirements.  
The dwelling does not ~~appear to~~ fall within the special flood hazard zone as delineated by the Federal Emergency Management Agency.  
The land does ~~not appear to~~ fall within the special flood hazard zone as indicated on community-panel # 230051 0012 B.

BUYER: CAMPBELL, MATTHEW E. &  
MORIN-CAMPBELL, CATHERINE  
SELLER: PLYMALE, CORBIN L. & FRANKIE

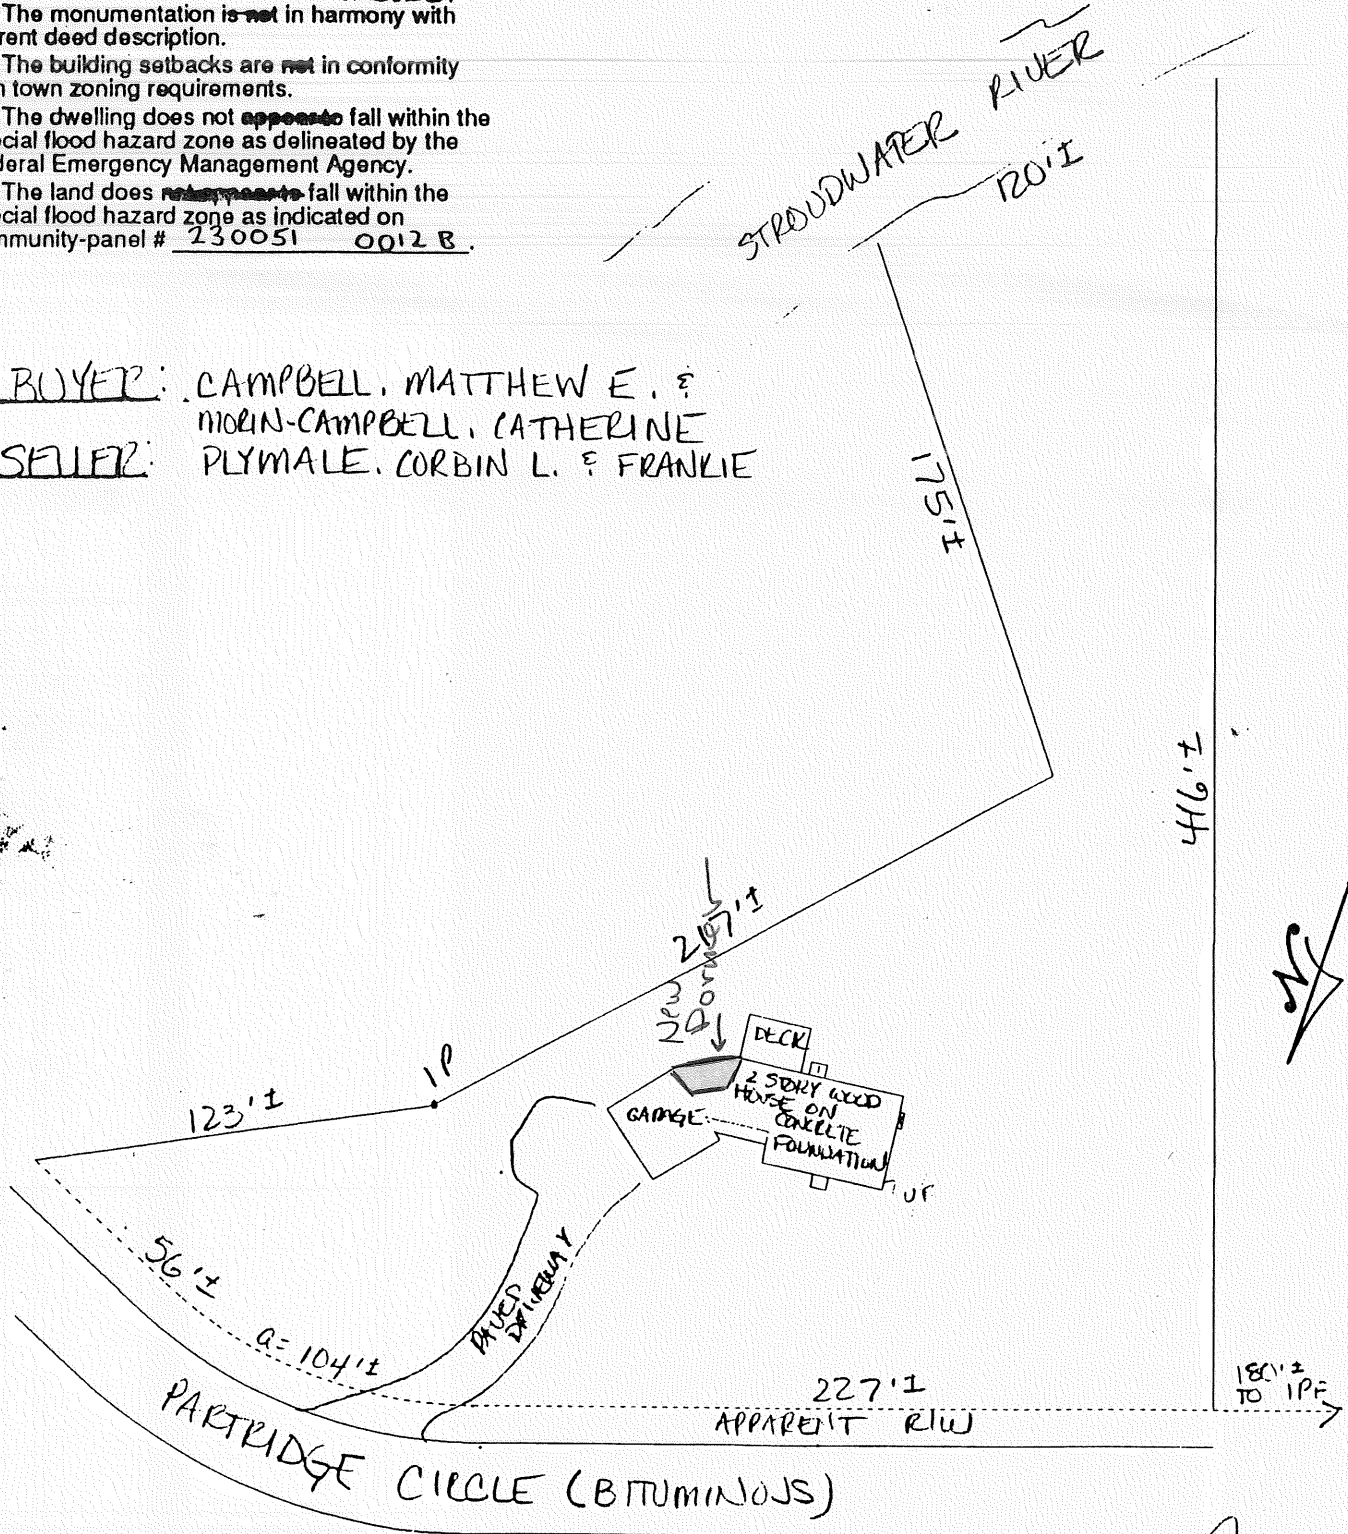

THIS PROPERTY IS SUBJECT TO ALL RIGHTS AND EASEMENTS OF RECORD. THOSE THAT ARE EVIDENT ARE SHOWN. THIS PLAN MIGHT NOT REVEAL CONFLICTS WITH ABUTTING DEEDS.

• IPF      □ TRANS

BRUCE R. BOWMAN, INC.  
176 Gray Road  
Cumberland, Maine 04021  
Phone: (207)829-3959  
Fax: (207)829-3522

PLAN BOOK 125 PAGE 21 LOT 8  
DEED BOOK 7522 PAGE 267 COUNTY CUMBERLAND

THIS PLAN IS NOT FOR RECORDING Drawn by: DAB

**THIS IS NOT A PERMIT/CONSTRUCTION CANNOT COMMENCE UNTIL THE PERMIT IS ISSUED**

**Building or Use Permit Pre-Application  
Additions/Alterations/Accessory Structures  
To Detached Single Family Dwelling**

In the interest of processing your application in the quickest possible manner, please complete the Information below for a Building or Use Permit.

**NOTE\*\*If you or the property owner owes real estate or personal property taxes or user charges on any property within the City, payment arrangements must be made before permits of any kind are accepted.**

Location/Address of Construction: 86 Partridge Circle, Portland

Tax Assessor's Chart, Block & Lot Number 228 Chart# <del>123</del> Block# <del>A-A</del> Lot# <del>8</del>	008 Owner: <u>MATTHEW Campbell</u> <u>Catherine - MORIN - Campbell</u>	Telephone#: <u>774 9485</u>
Owner's Address: <u>86 Partridge Circle</u>	Lessee/Buyer's Name (If Applicable) <u>-</u>	Cost Of Work: <u>\$32,000.</u> Fee: <u>\$214</u>
Proposed Project Description: (Please be as specific as possible) <u>Complete (Existing Rough-Framed Family Rm over garage) Provide small corner over stairway</u>		
Contractor's Name, Address & Telephone <u>Weigel Const. 12 Madokawando ldy, Falmouth, Me 04105</u>		Rec'd By: <u>UB</u> <u>781-5569</u>

*interior reno*

Separate permits are required for Internal & External Plumbing, HVAC and Electrical installation.

- All construction must be conducted in compliance with the 1996 B.O.C.A. Building Code as amended by Section 6-Art II.
- All plumbing must be conducted in compliance with the State of Maine Plumbing Code.
- All Electrical Installation must comply with the 1996 National Electrical Code as amended by Section 6-Art III.
- HVAC (Heating, Ventilation and Air Conditioning) installation must comply with the 1993 BOCA Mechanical Code.

You must include the following with you application:

- 1) A Copy of Your Deed or Purchase and Sale Agreement
- 2) A Copy of your Construction Contract, if available
- 3) A Plot Plan (Sample Attached)


If there is expansion to the structure, a complete plot plan (Site Plan) must include:

- The shape and dimension of the lot, all existing buildings (if any), the proposed structure and the distance from the actual property lines. Structures include decks porches, a bow windows cantilever sections and roof overhangs, as well as, sheds, pools, garages and any other accessory structures.
- Scale and required zoning district setbacks

**4) Building Plans (Sample Attached)**

A complete set of construction drawings showing all of the following elements of construction:

- Cross Sections w/Framing details (including porches, decks w/ railings, and accessory structures)
- Floor Plans & Elevations
- Window and door schedules
- Foundation plans with required drainage and dampproofing
- Electrical and plumbing layout. Mechanical drawings for any specialized equipment such as furnaces, chimneys, gas equipment, HVAC equipment (air handling) or other types of work that may require special review must be included.

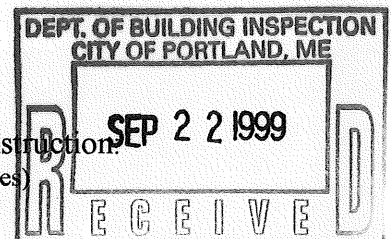

**Certification**

I hereby certify that I am the Owner of record of the named property, or that the proposed work is authorized by the owner of record and that I have been authorized by the owner to make this application as his/her authorized agent. I agree to conform to all applicable laws of this jurisdiction. In addition, if a permit for work described in this application is issued, I certify that the Code Official's authorized representative shall have the authority to enter all areas covered by this permit at any reasonable hour to enforce the provisions of the codes applicable to this permit.

Signature of applicant: R Weigel Date: 9/21/99

Building Permit Fee: \$30.00 for the 1st \$1000.cost plus \$6.00 per \$1,000.00 construction cost thereafter.



Inspection Services  
Michael J. Nugent  
Manager



Department of Urban Development  
Joseph E. Gray, Jr.  
Director

## CITY OF PORTLAND

Congratulations!!!!!!

### Building or Use Permit Application Additions/Alterations/Accessory Structures To Detached Single Family Dwelling

As an applicant for a building permit, you are about to enter into a relationship with our Office. We welcome any questions, comments or suggestions that will make the process more efficient. Attached you will find an application and some samples of the submissions you will provide at application time. Please read **ALL** of the information and if you need any further assistance please call 874-8703 or 874-8693.

