



ALPHAarchitects  
 17 CHESTNUT STREET  
 PORTLAND, ME 04101  
 PHONE: 207.761.9500  
 FAX: 207.761.9595  
 design@alphaarchitects.com

COPYRIGHT


Reuse or reproduction of the contents of this document is not permitted without written permission of ALPHAARCHITECTS

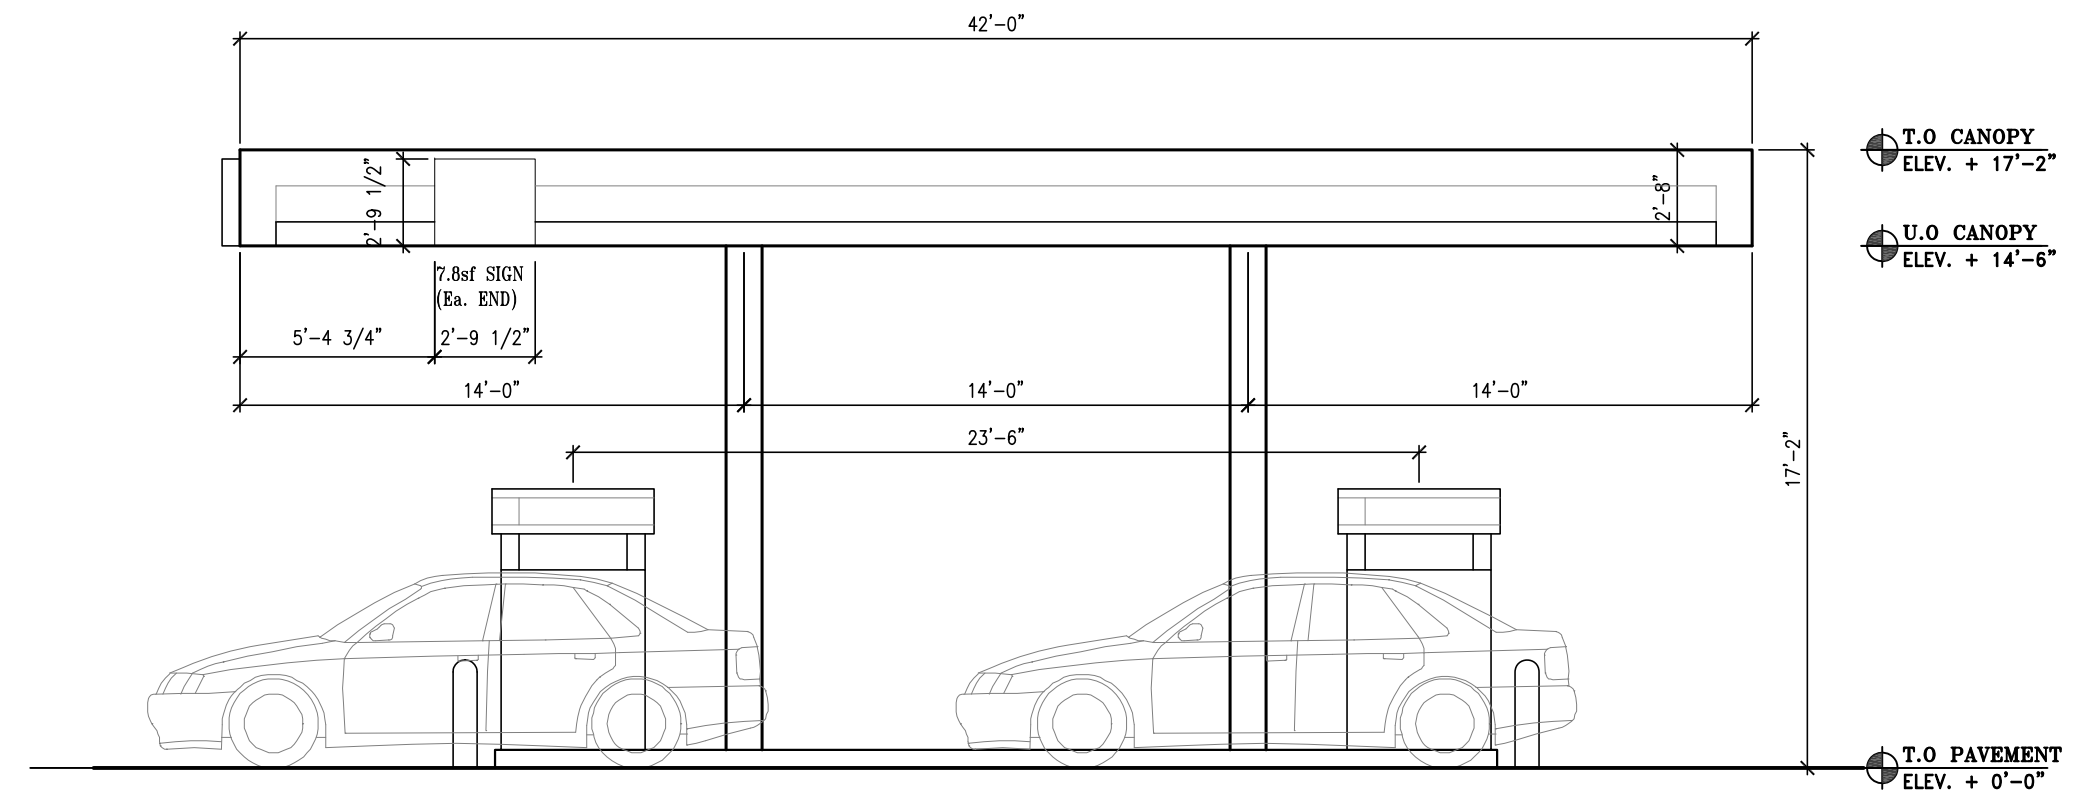


GAS CANOPY SIDE ELEVATION FROM CONGRESS ST.  
 SCALE: 3/16" = 1'-0"

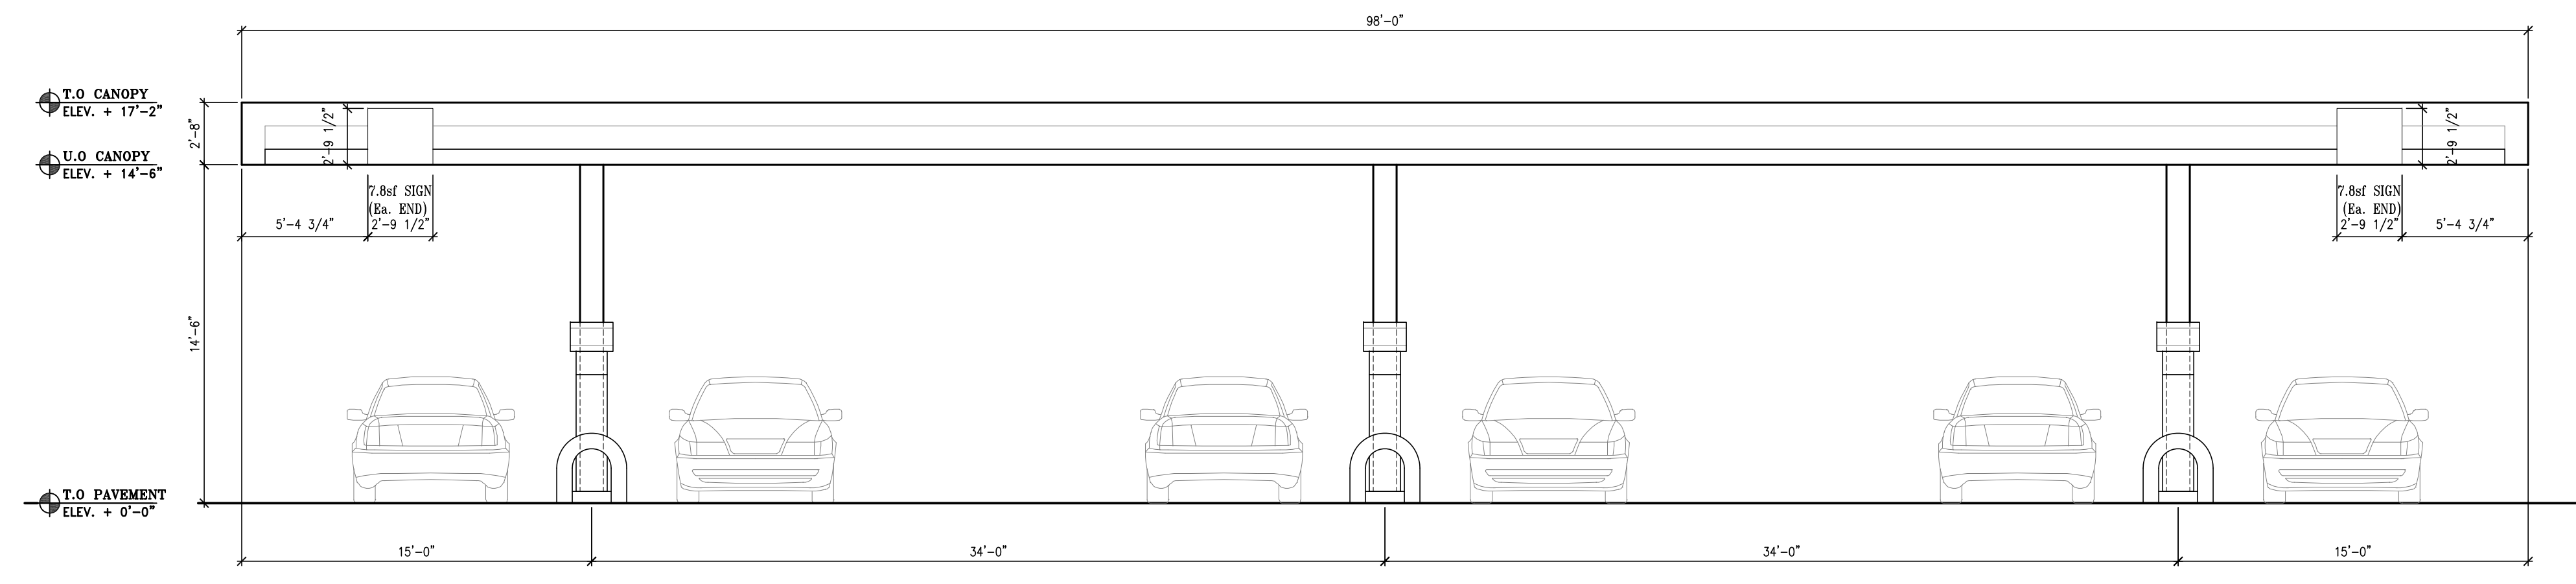

GAS CANOPY FRONT ELEVATION  
 SCALE: 3/16" = 1'-0"

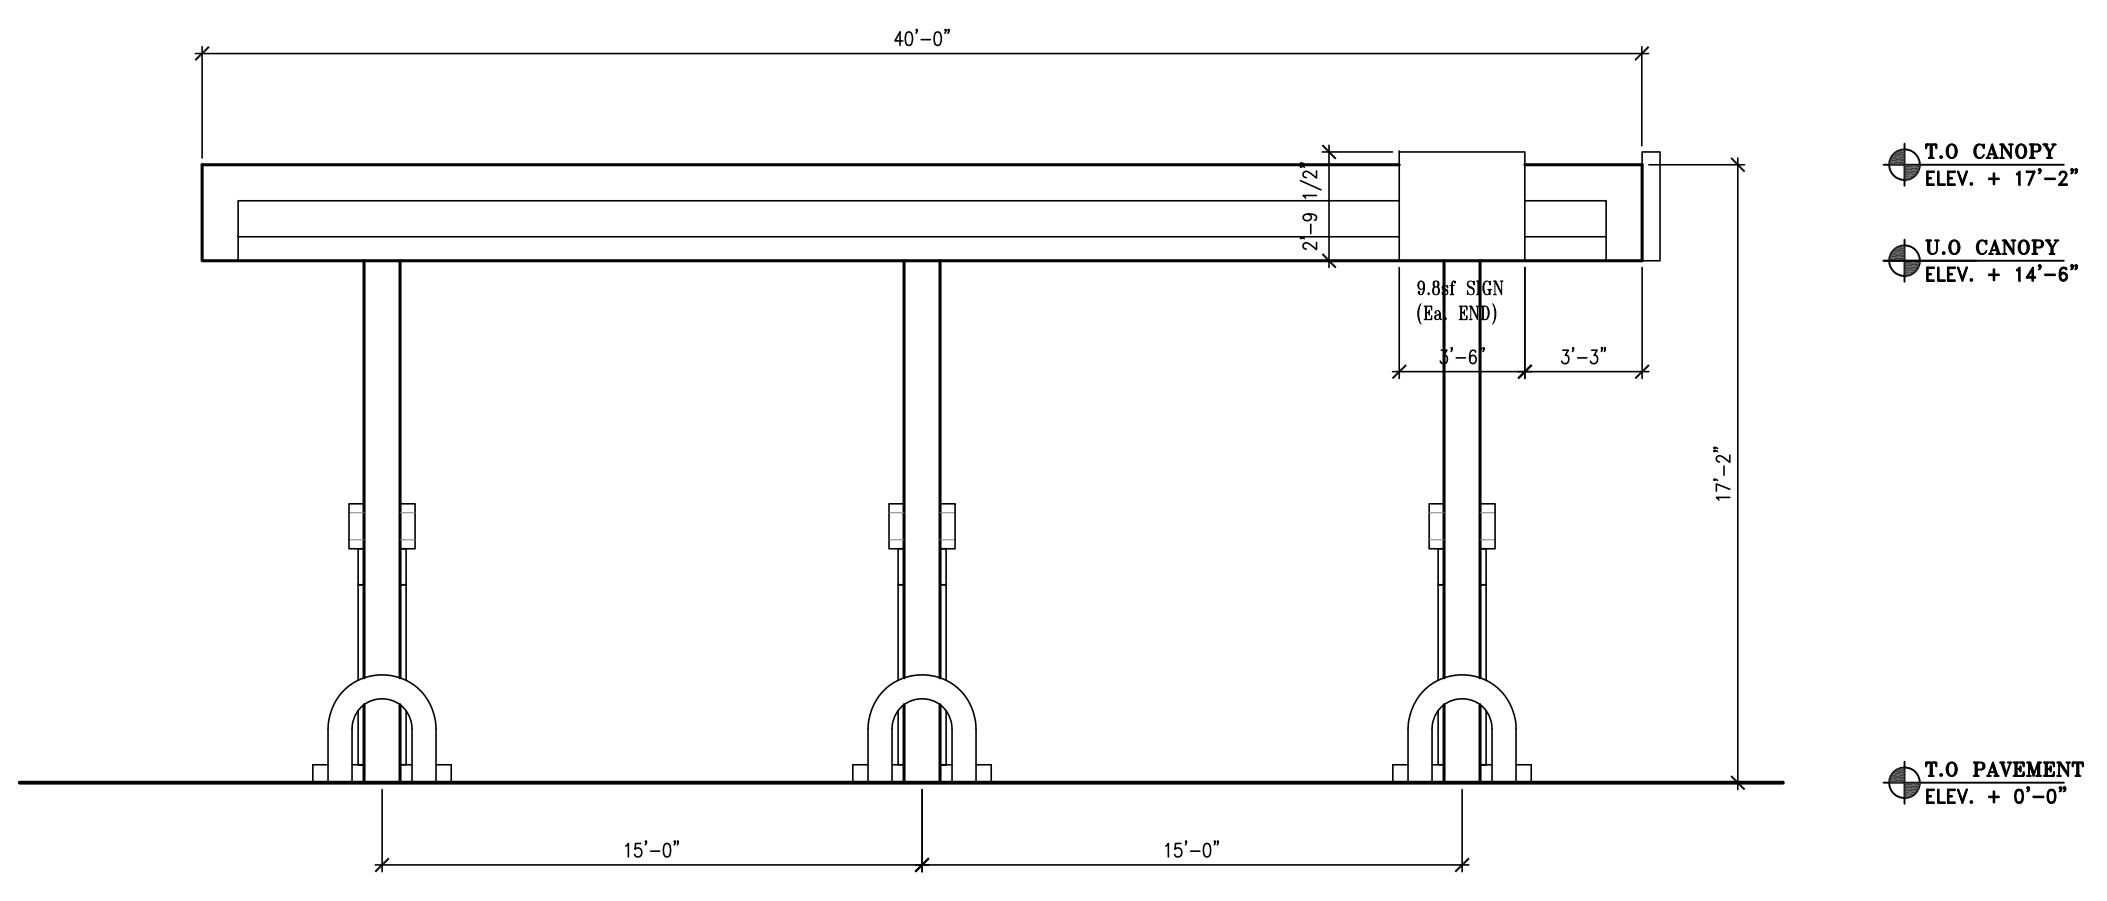

DIESEL CANOPY FRONT ELEVATION  
 SCALE: 3/16" = 1'-0"

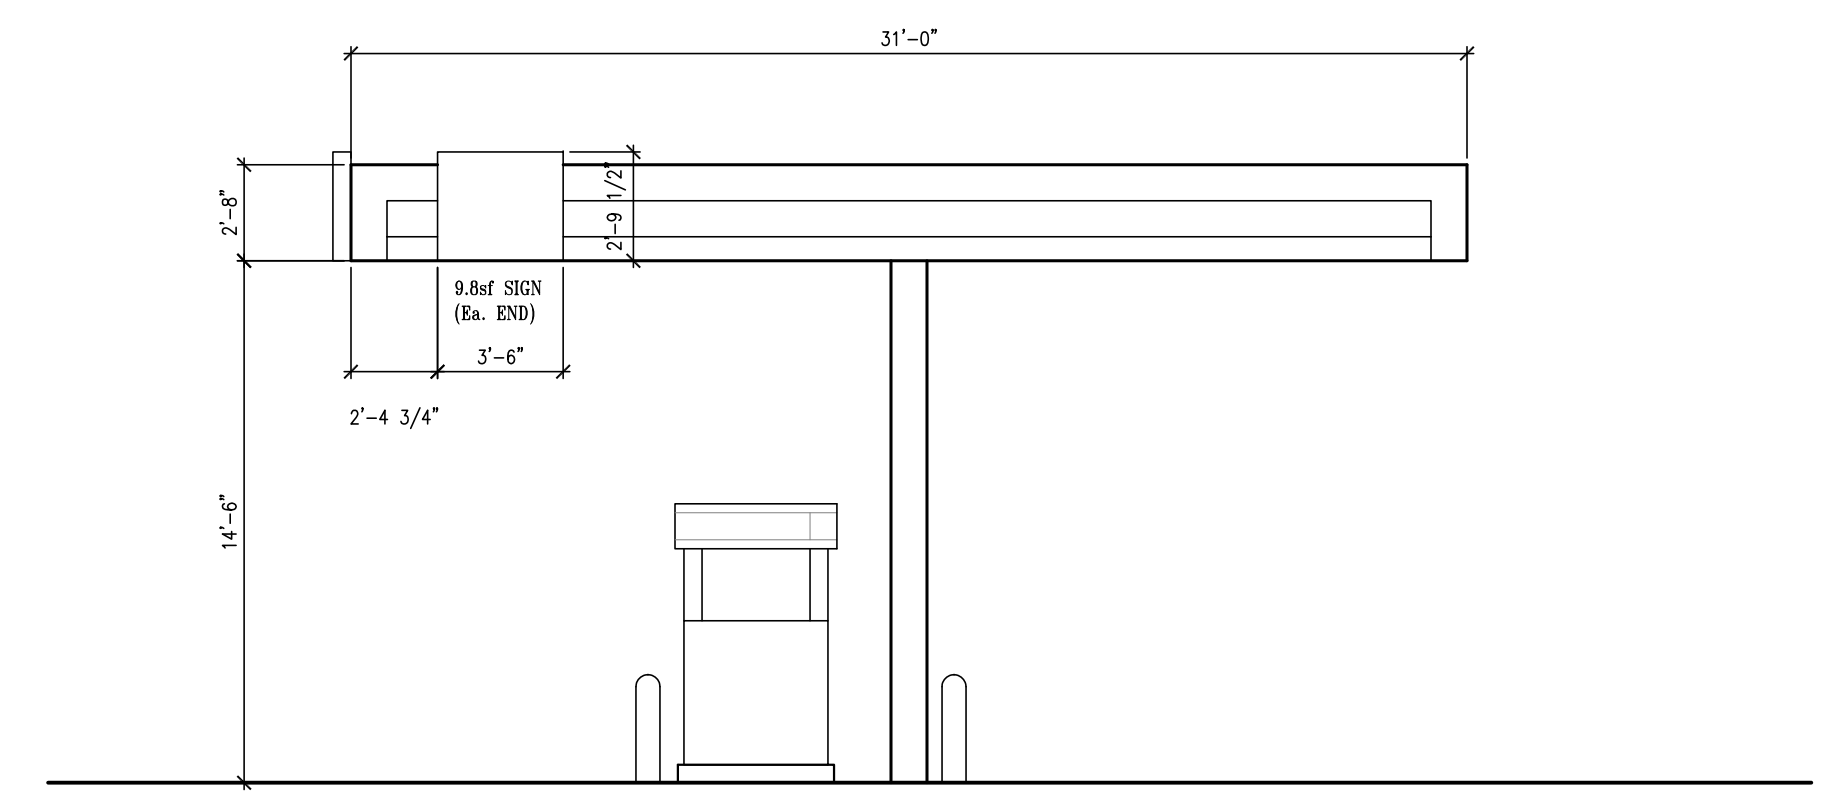

DIESEL CANOPY SIDE ELEVATION  
 SCALE: 3/16" = 1'-0"

Portland Property Holdings LLC  
 2282 Congress Street  
 Portland, ME. 04102

JOB: 12132

ISSUE DATE	
PRELIM	03-27-13
P BOARD	-
SFMO 2	10-16-15
CD's	-
REV. 1	10-16-15
PRINT	10-16-15

CANOPY ELEVATIONS  
**A2.2**

10-16-15