

ALPHAarchitects  
 17 CHESTNUT STREET  
 PORTLAND, ME 04101  
 PHONE: 207.761.9500  
 FAX: 207.761.9595  
 design@alphaarchitects.com

**© COPYRIGHT**  
 Reuse or reproduction of the contents of this document is not permitted without written permission of ALPHA ARCHITECTS







**Portland Property Holdings LLC**  
 2282 Congress Street  
 Portland, ME. 04102

JOB: 12132

ISSUE DATE	
PRELIM	03-27-13
P BOARD	-
SFMO 2	10-16-15
CD's	-
REV. 1	10-16-15
PRINT	10-16-15

BUILDING SECTIONS  
**A3.1**

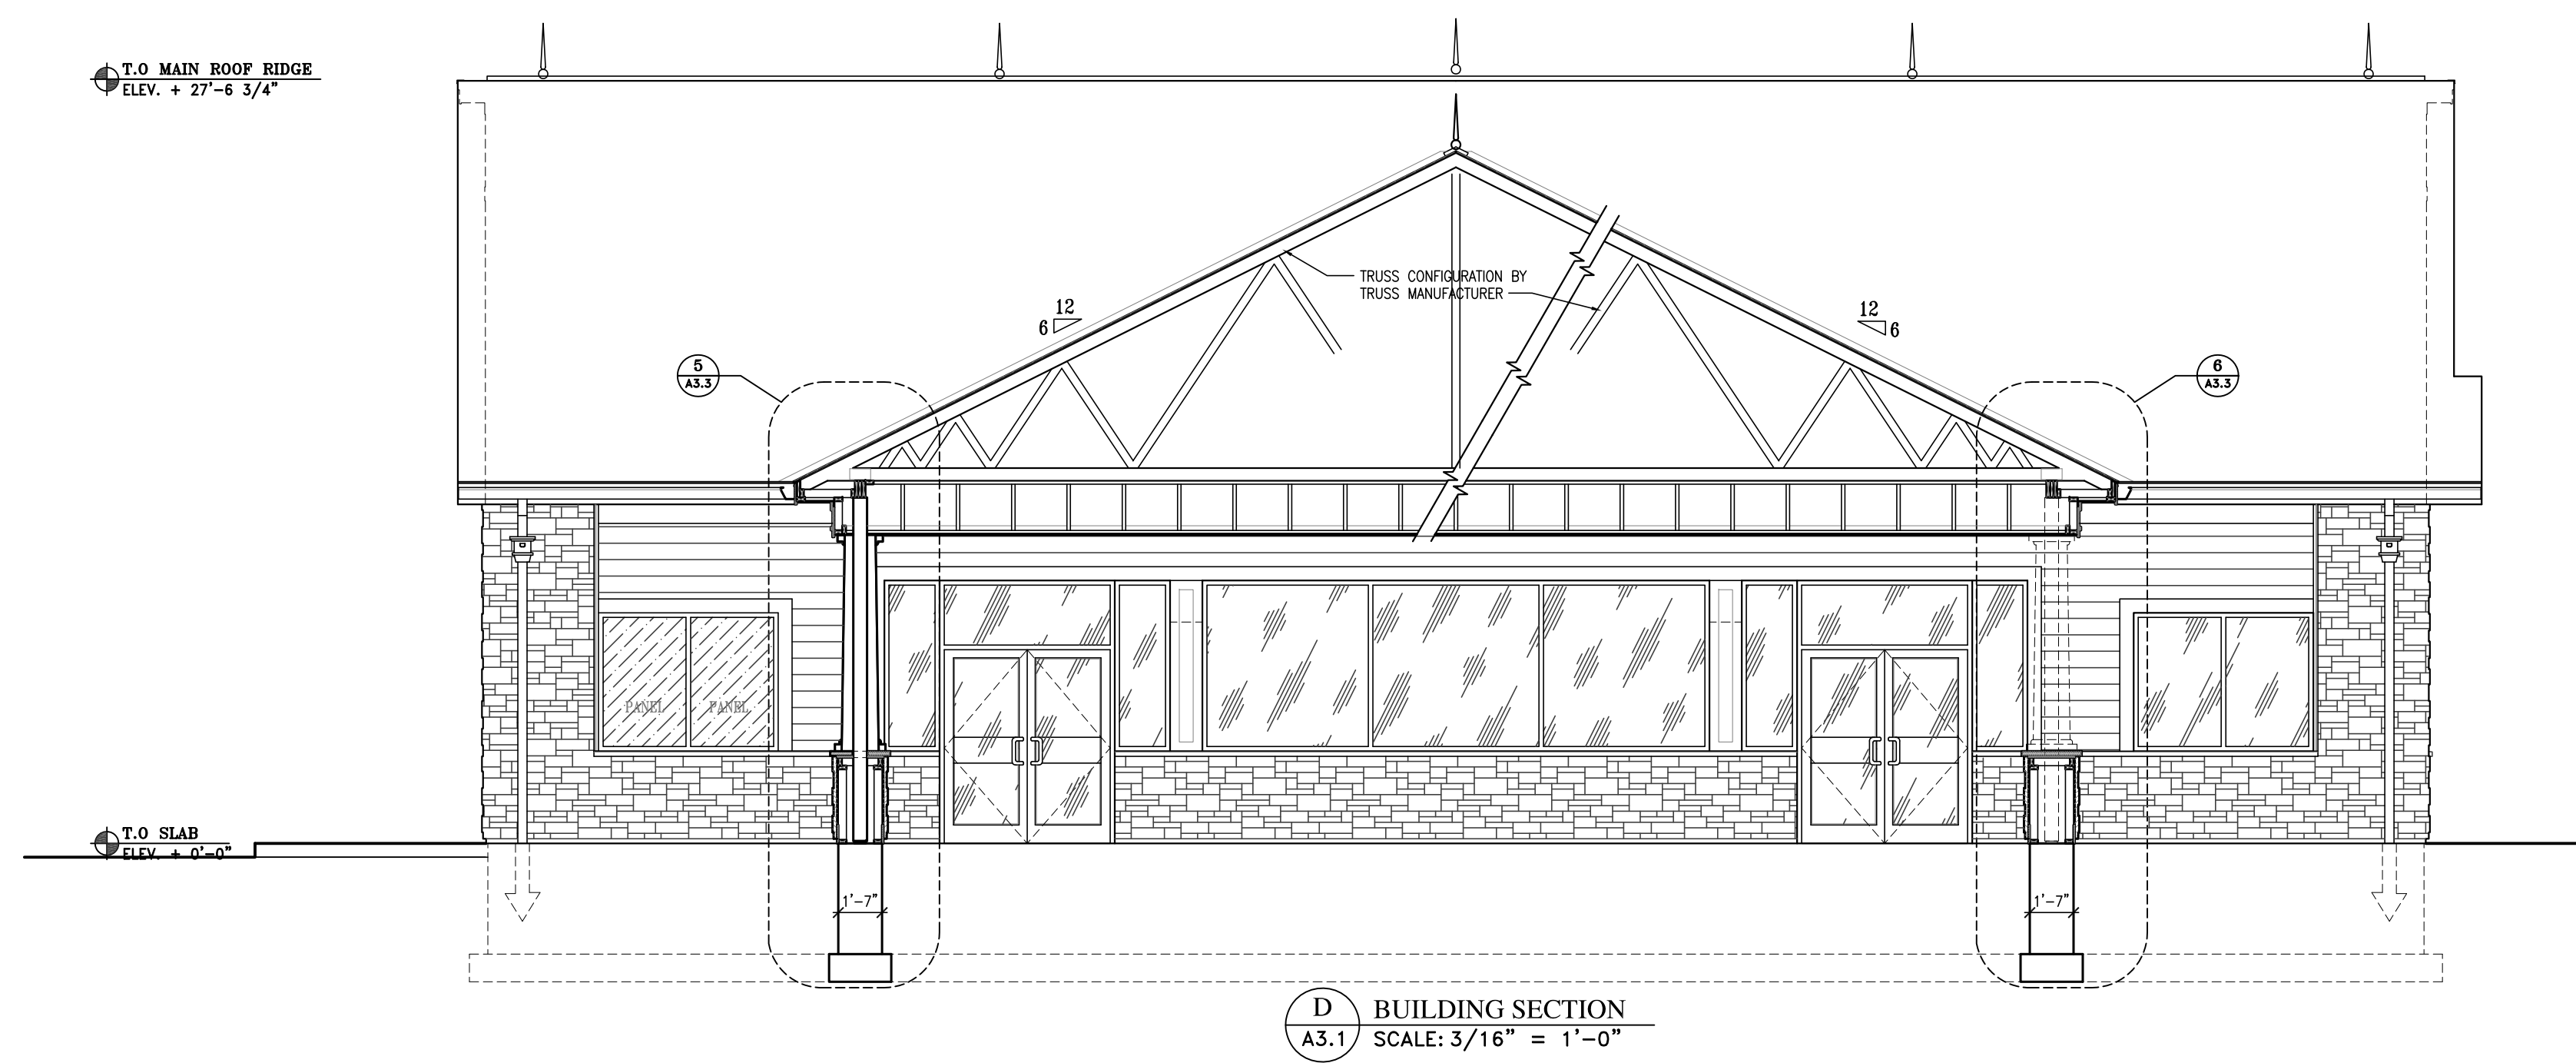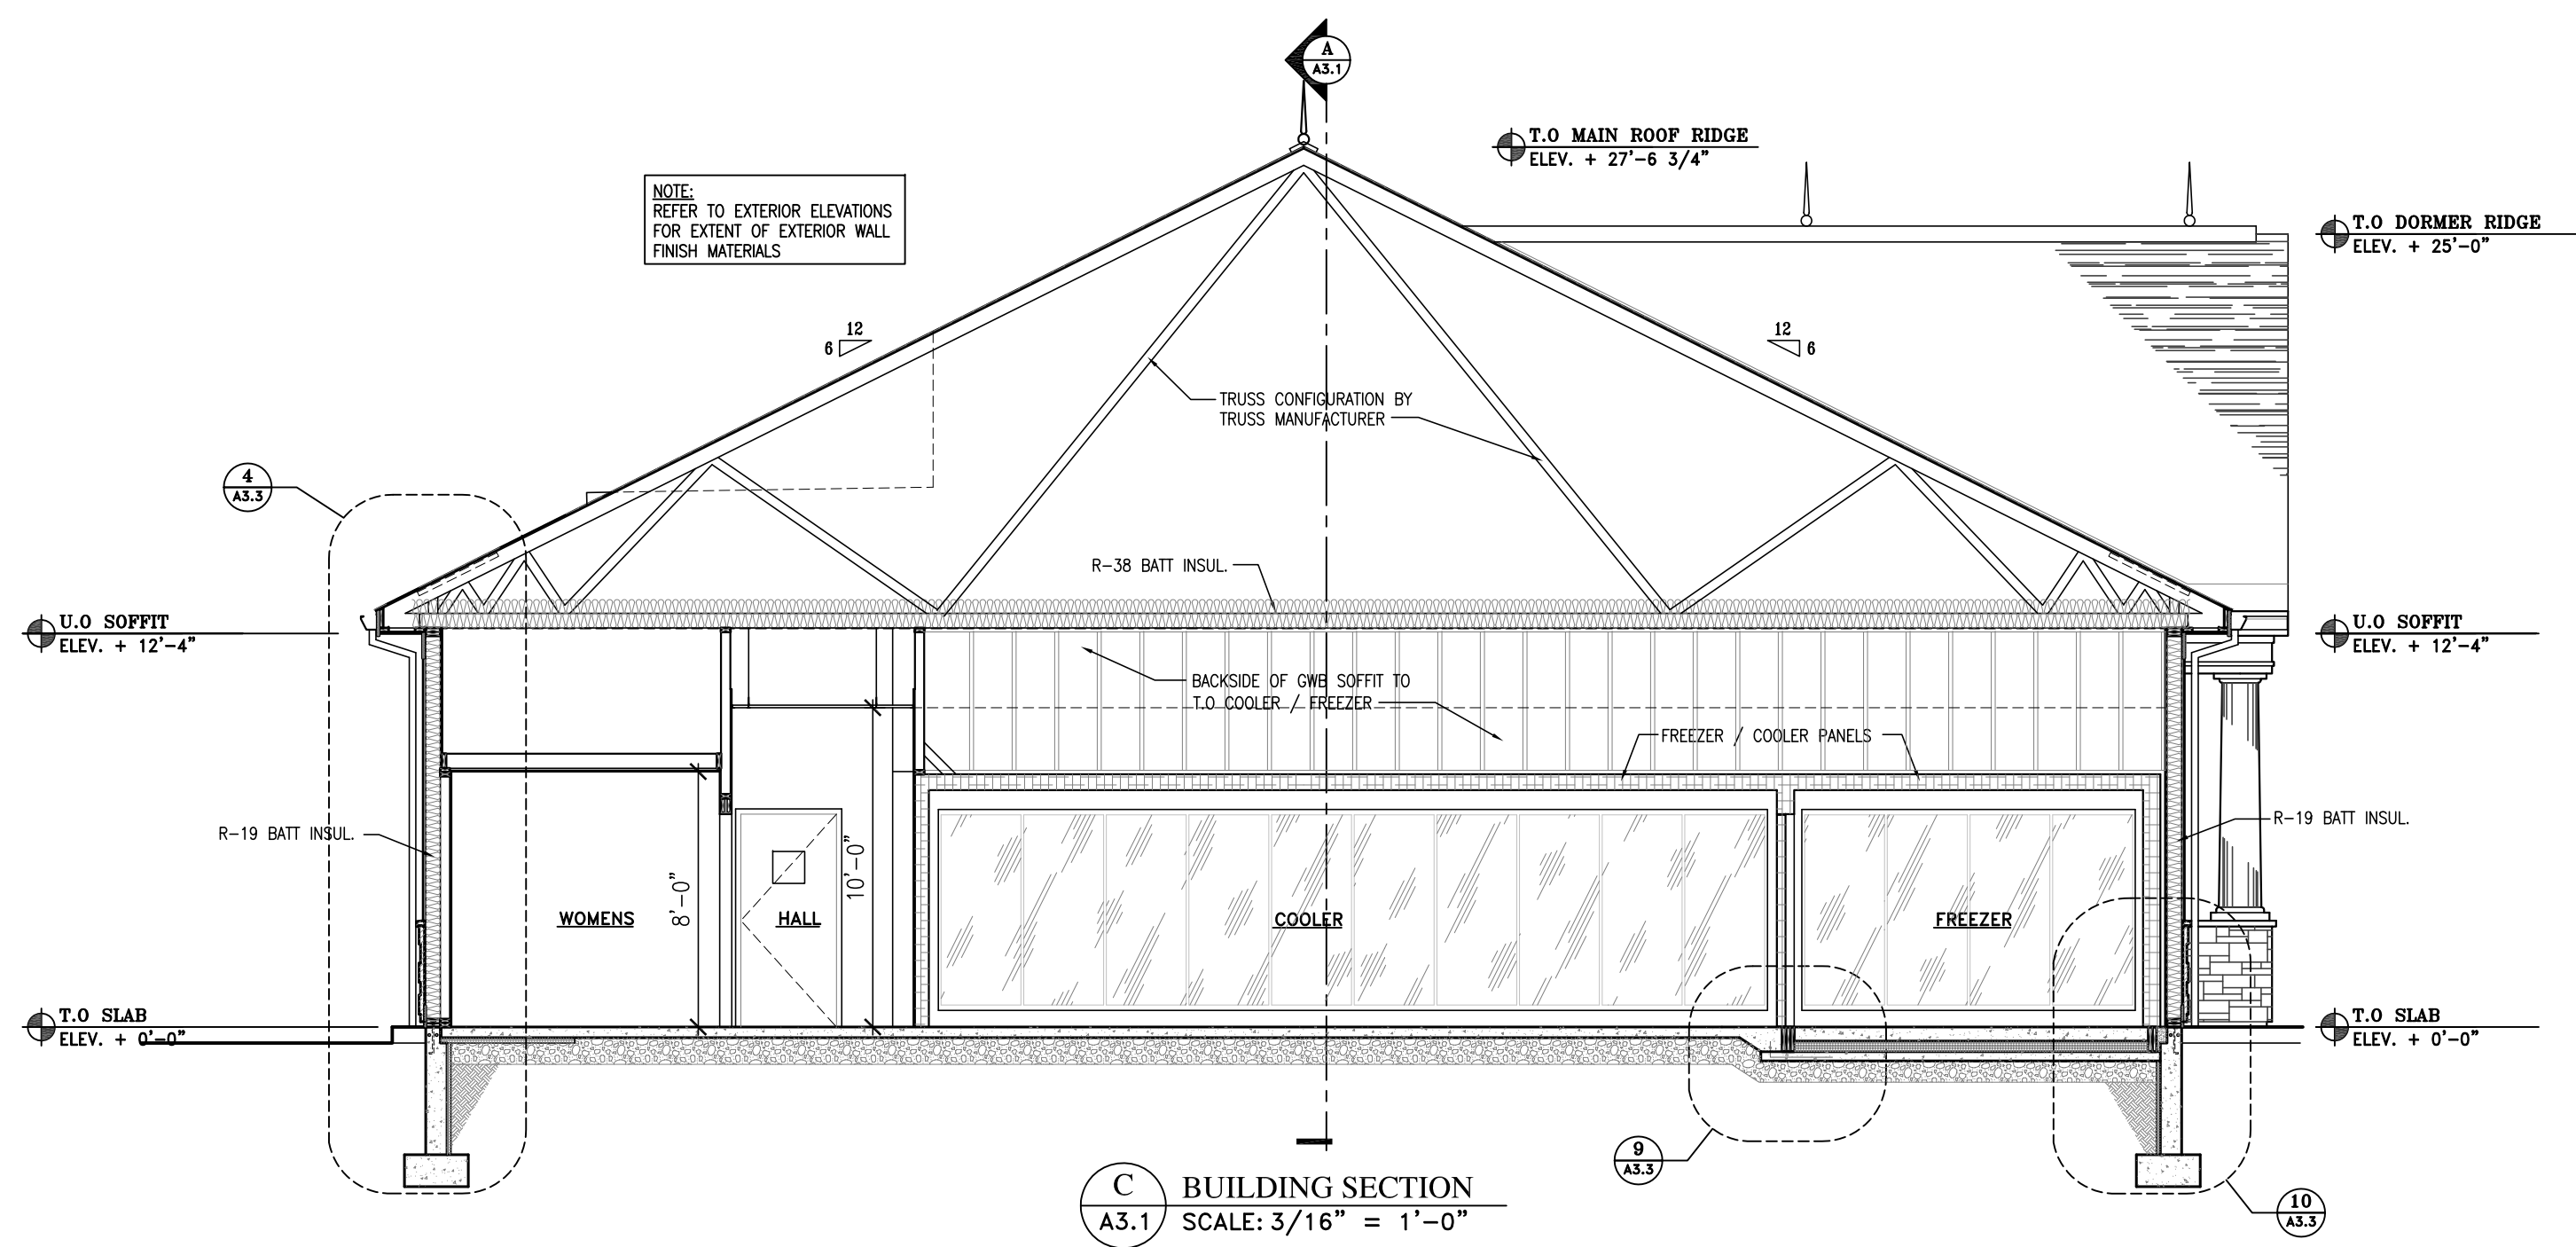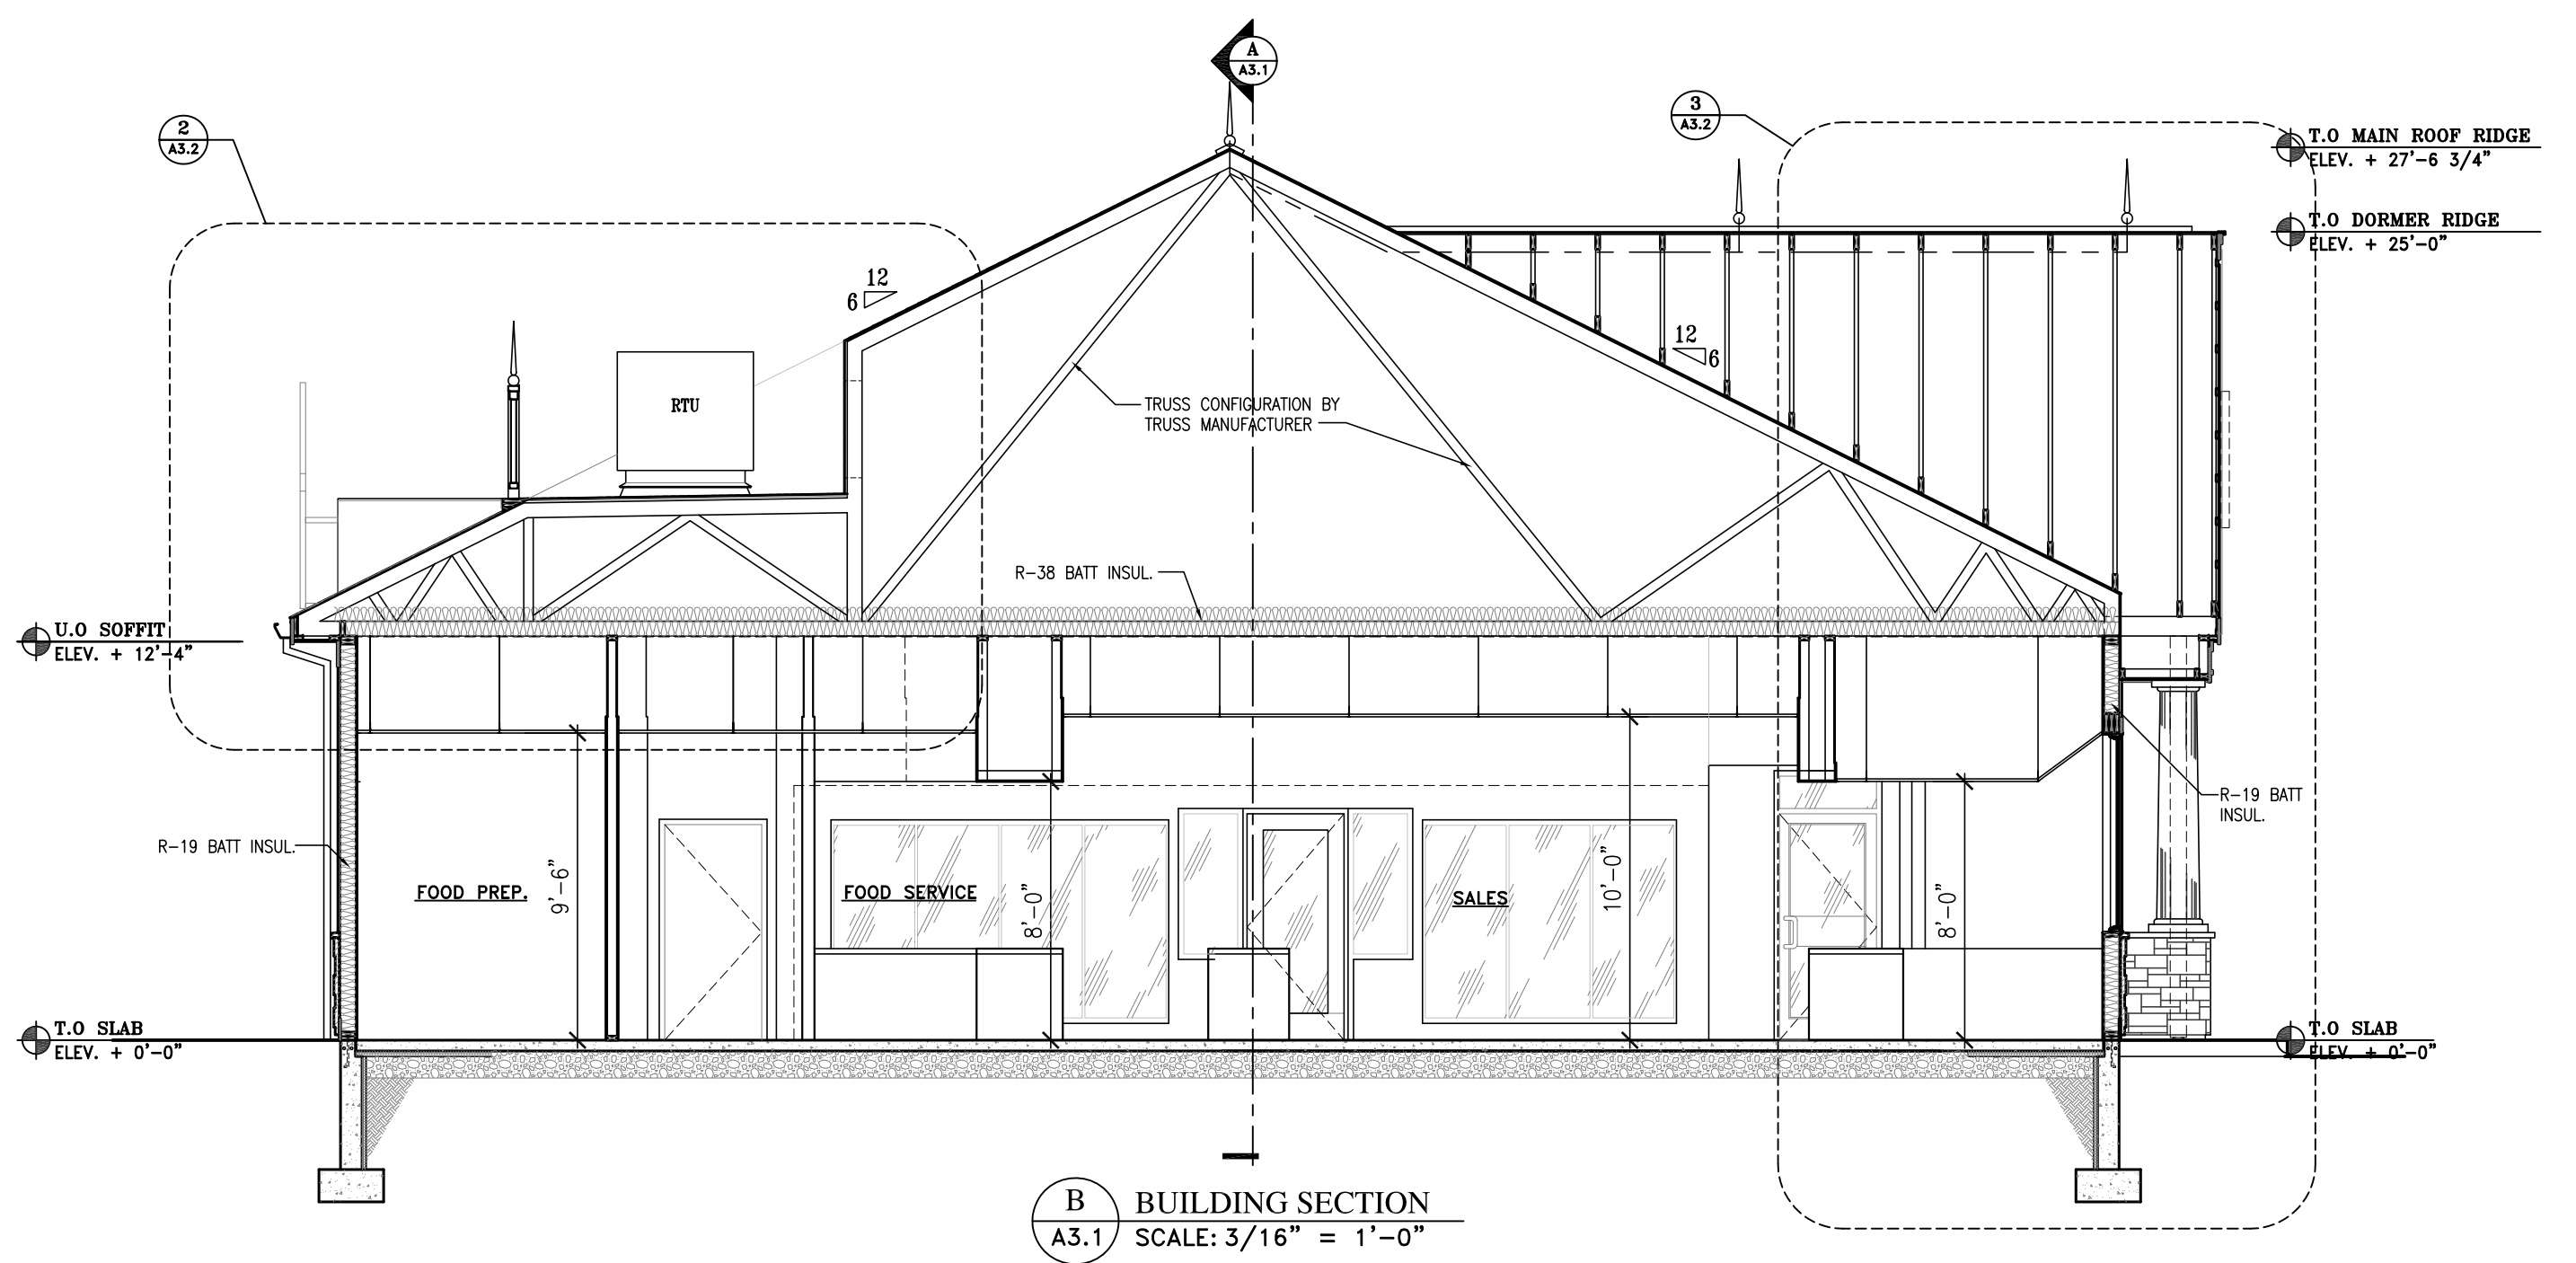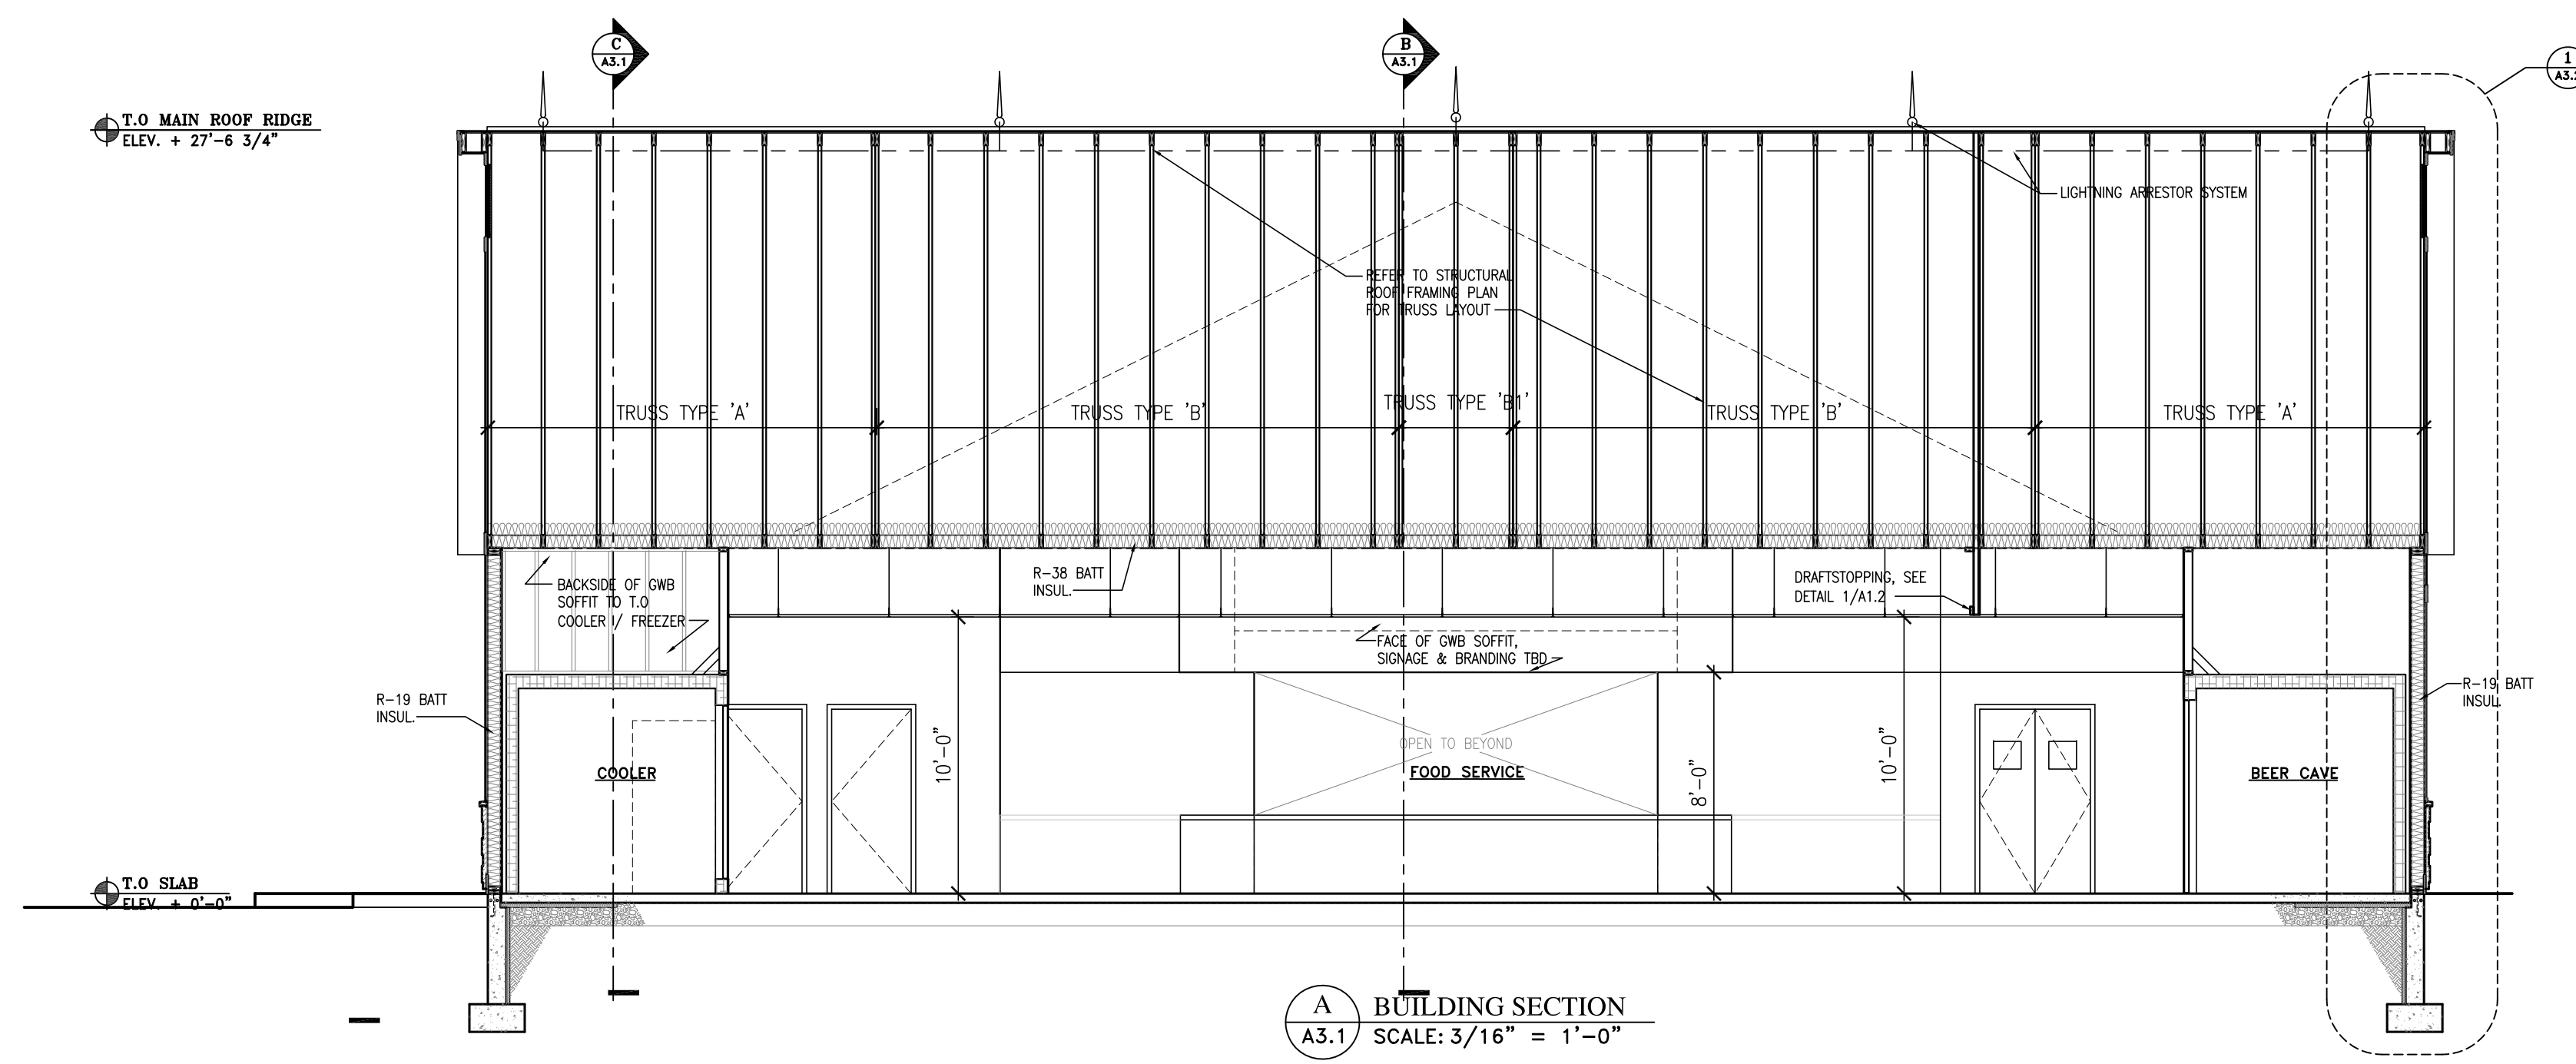

10-16-15