

ALPHAarchitects
 17 CHESTNUT STREET
 PORTLAND, ME 04101
 PHONE: 207.761.9500
 FAX: 207.761.9595
 design@alphaarchitects.com

COPYRIGHT

Reuse or reproduction of the contents of this document is not permitted without written permission of ALPHA ARCHITECTS



Portland Property Holdings LLC
 2282 Congress Street
 Portland, ME. 04102


JOB: 12132

ISSUE DATE	
PRELIM	03-27-13
P BOARD	-
SFMO 2	10-16-15
CD's	-
REV. 1	10-16-15
PRINT	10-16-15

WALL SECTIONS


A3.3

10-16-15

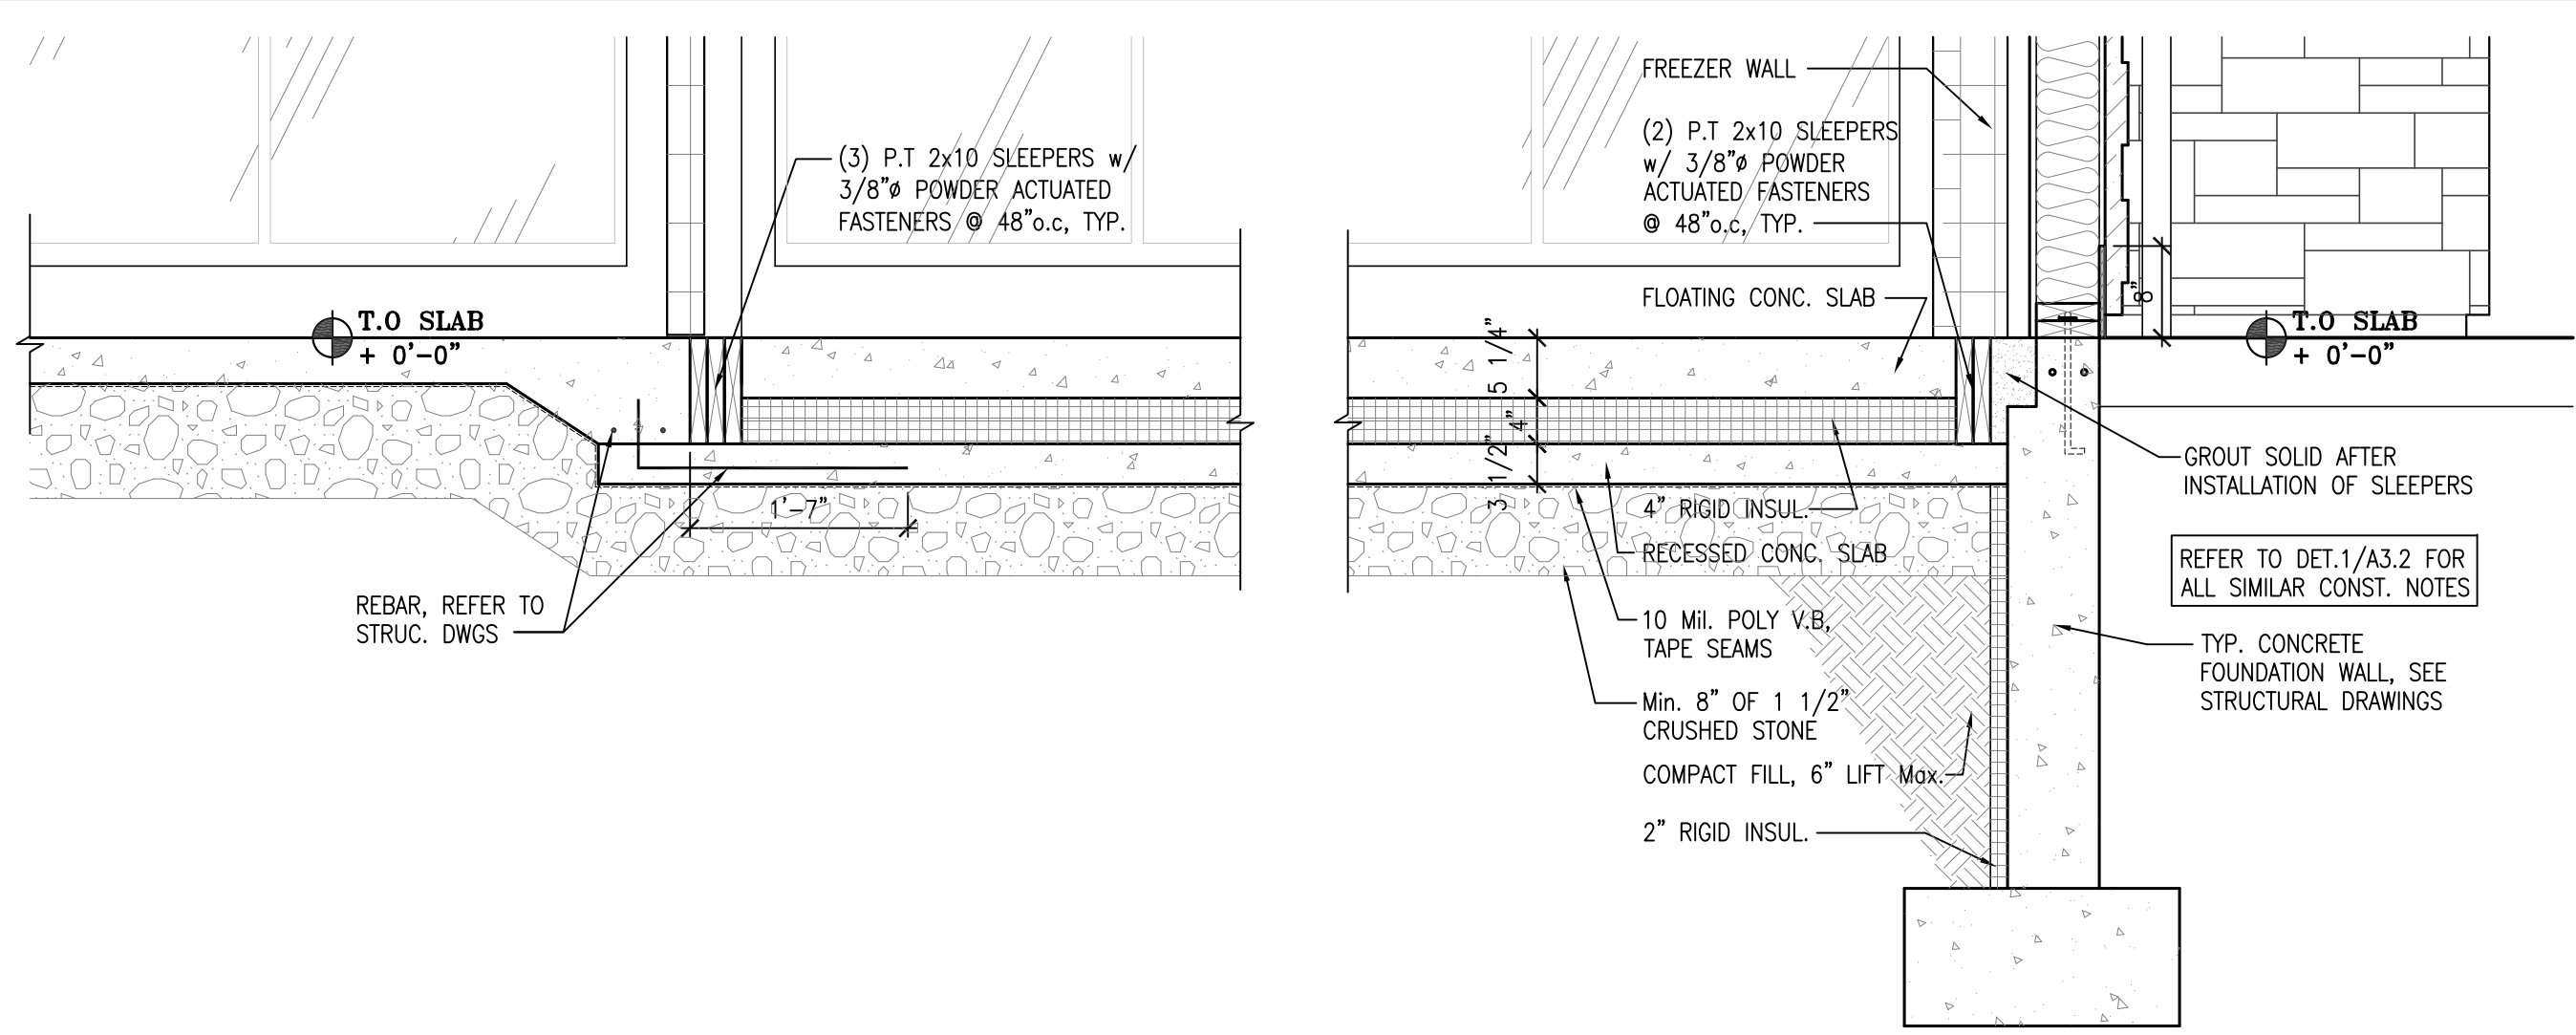


9 DETAIL @ FREEZER/COOLER FLOOR
 SCALE: 3/4" = 1'-0"


10 DETAIL @ FREEZER FLOOR
 SCALE: 3/4" = 1'-0"

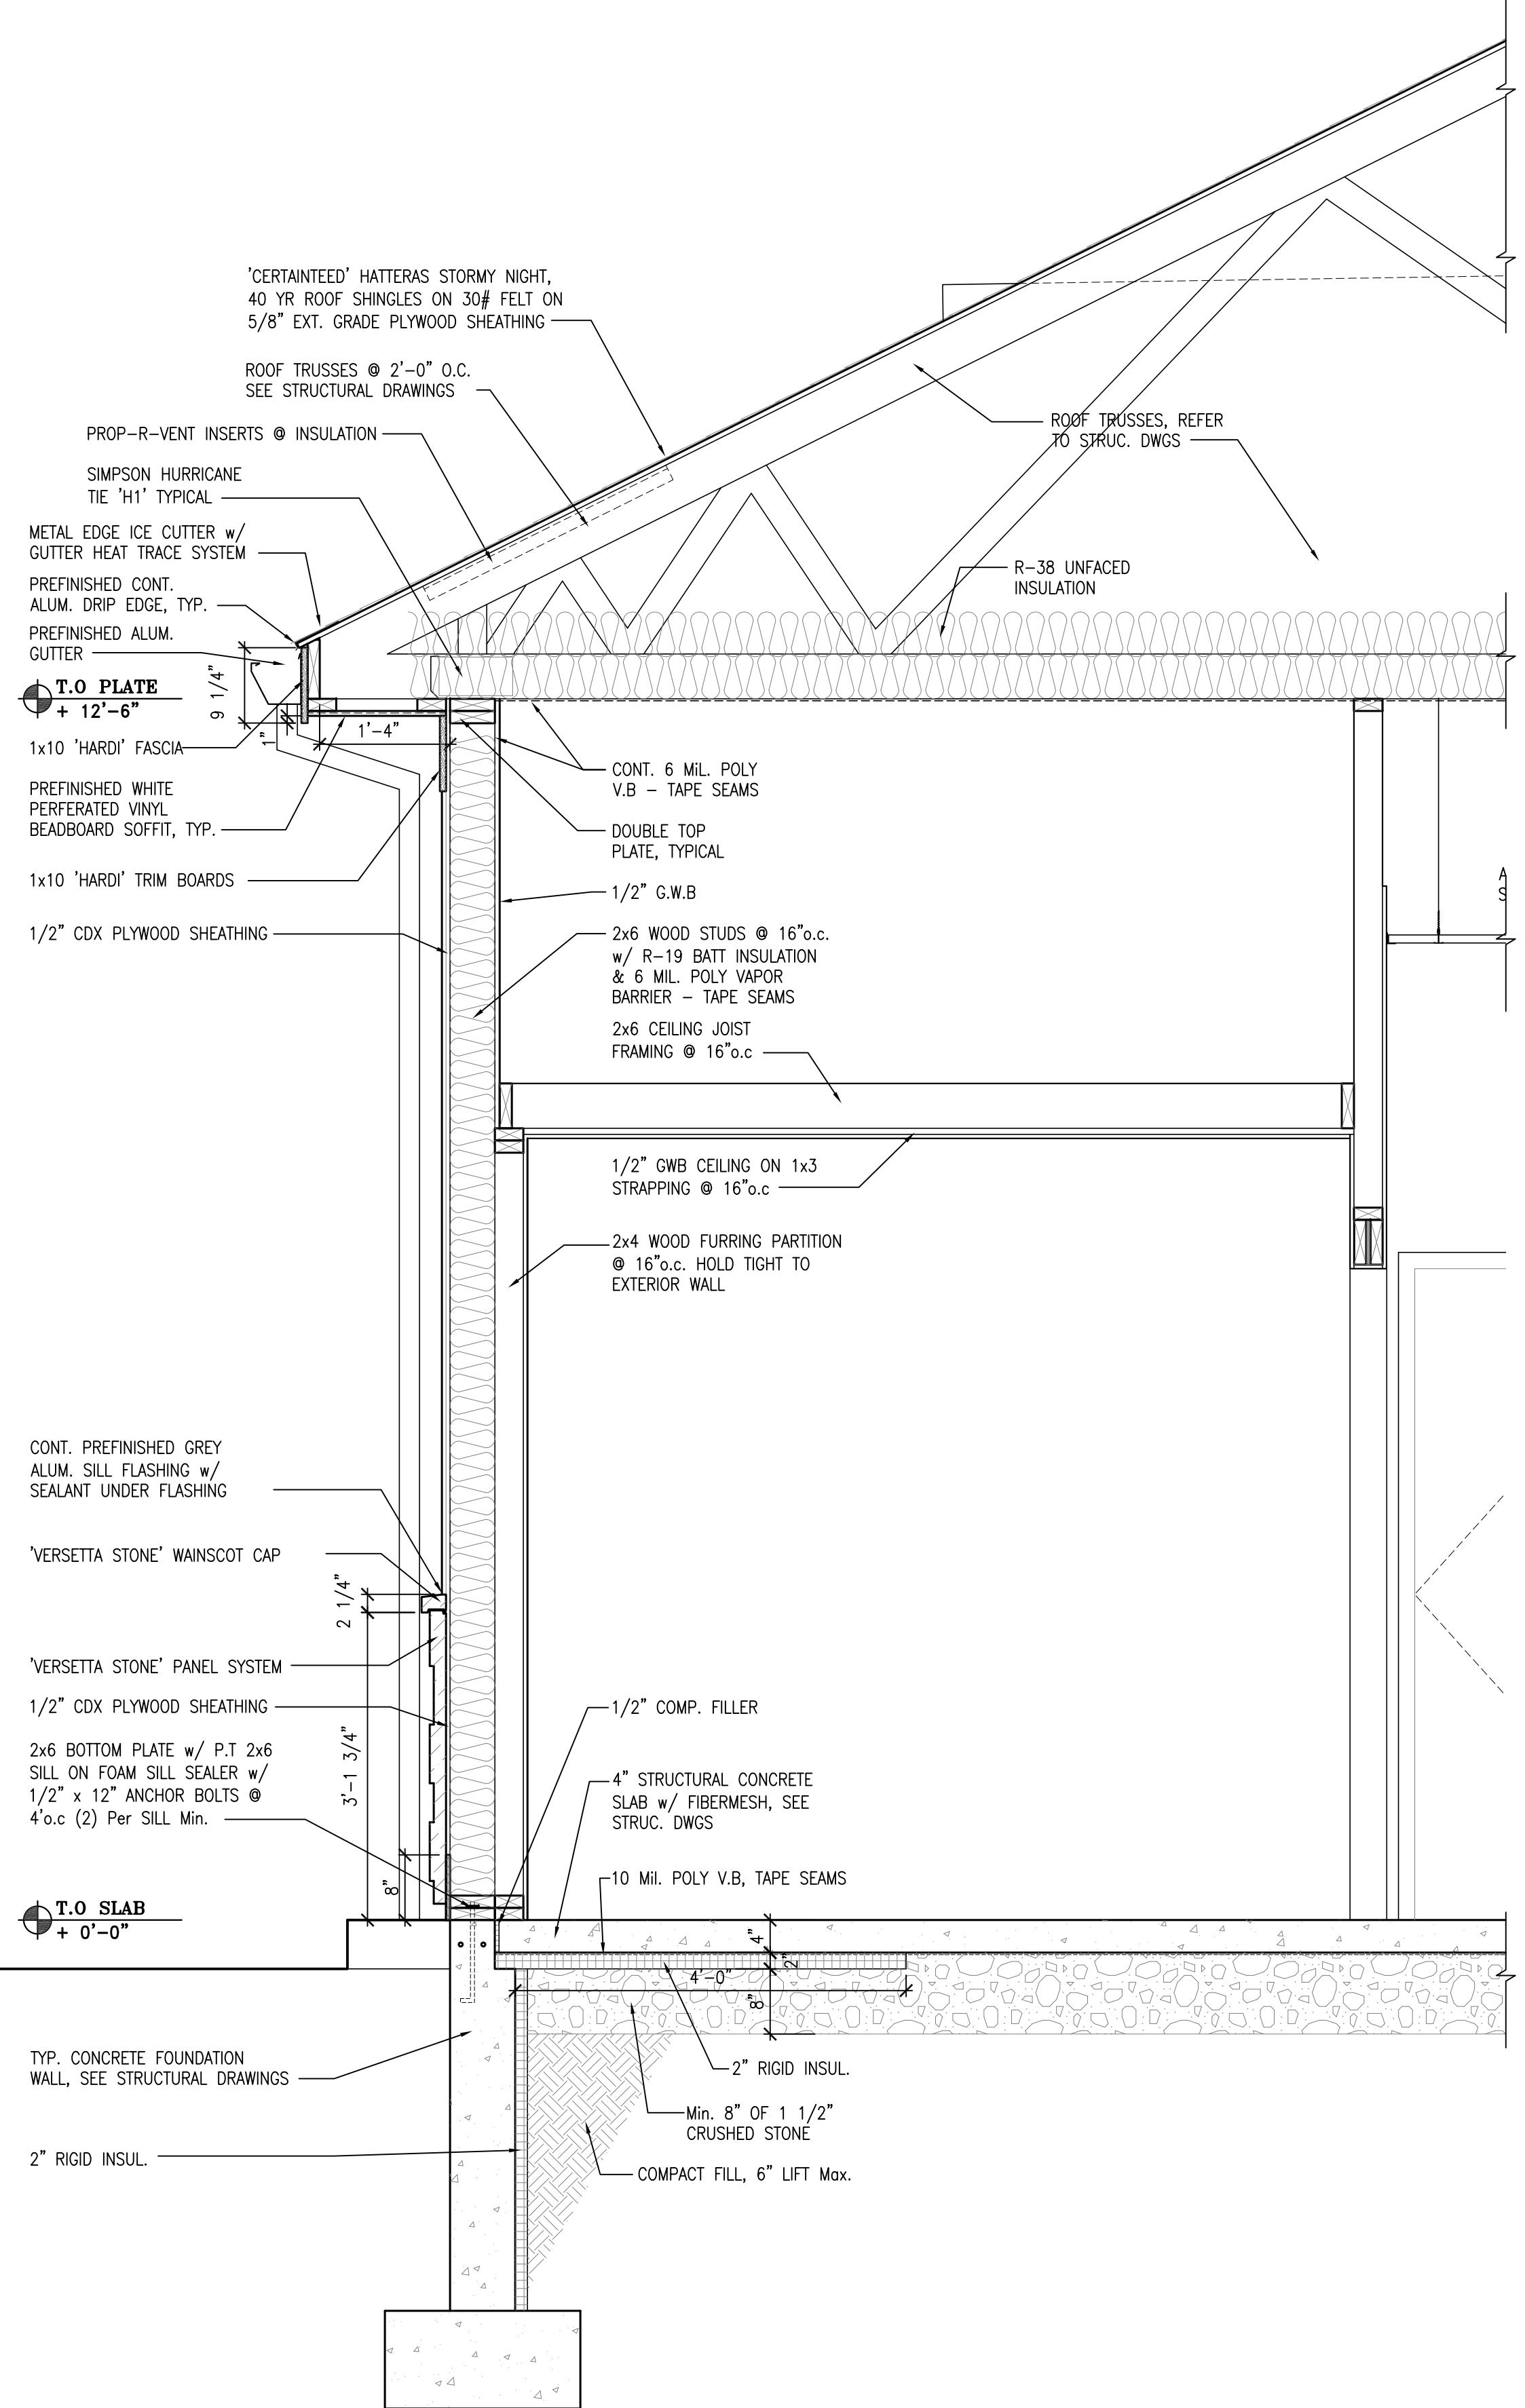

4 WALL SECTION
 SCALE: 3/4" = 1'-0"

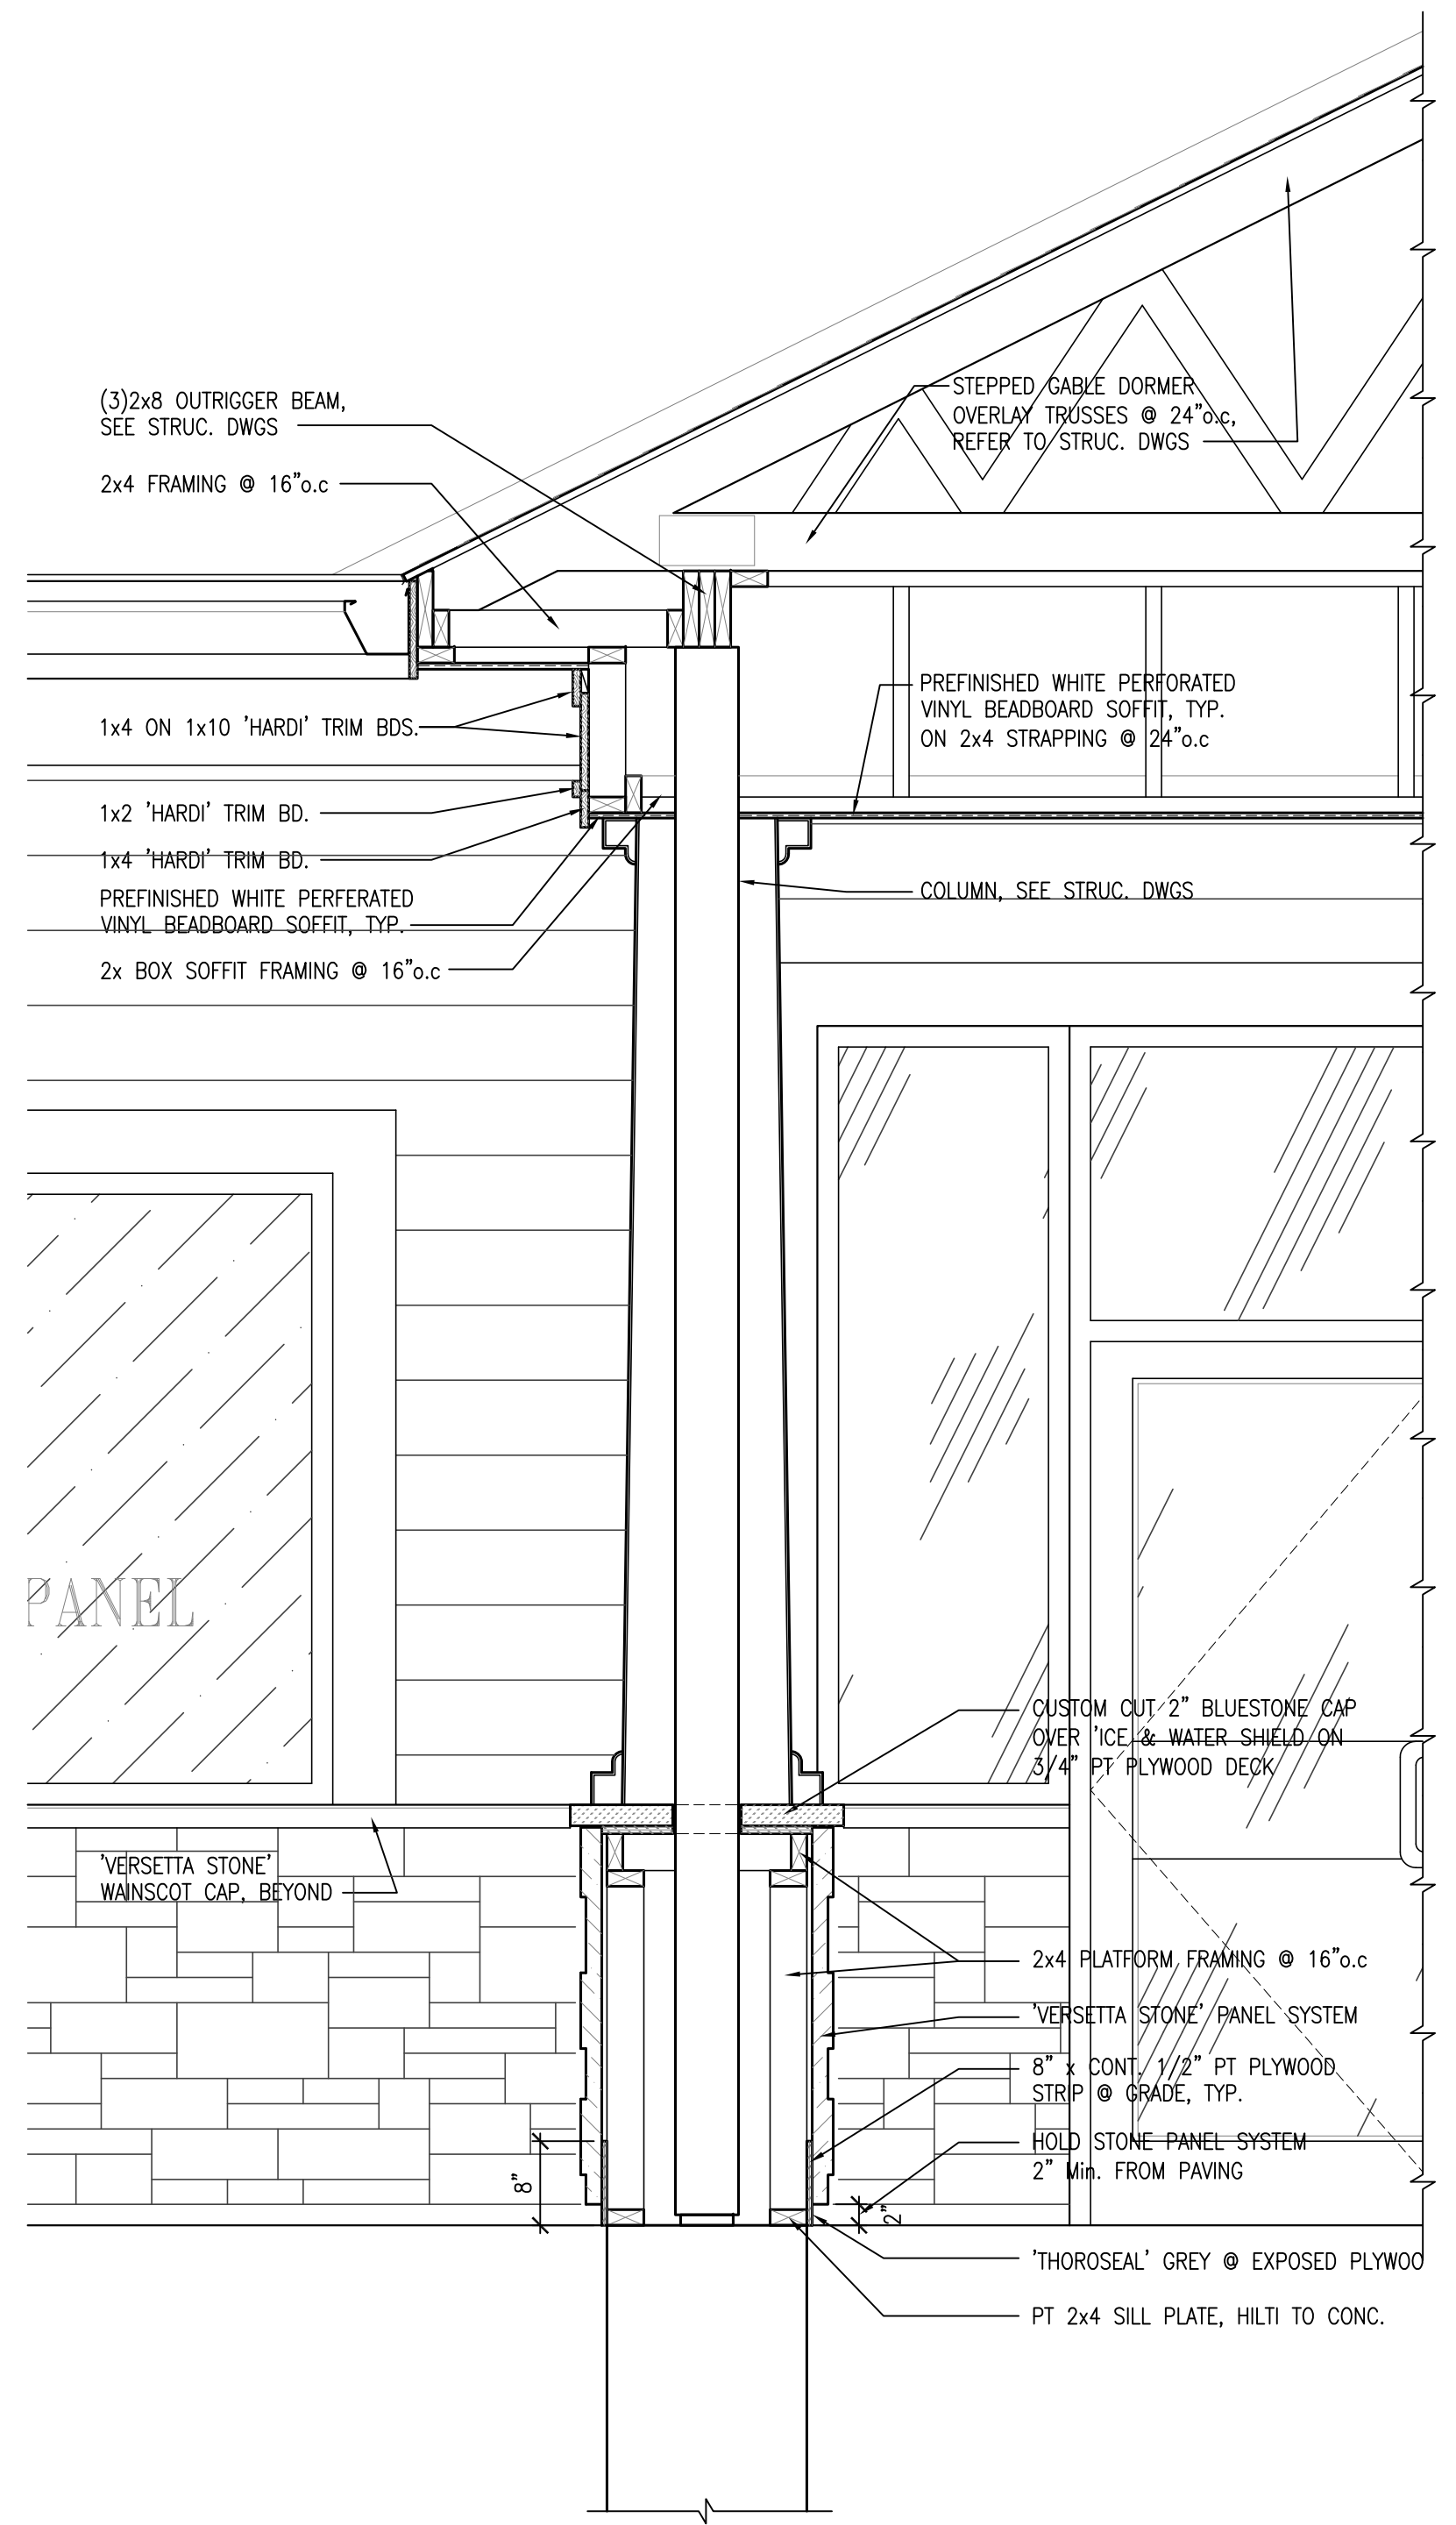

5 WALL SECTION
 SCALE: 3/4" = 1'-0"

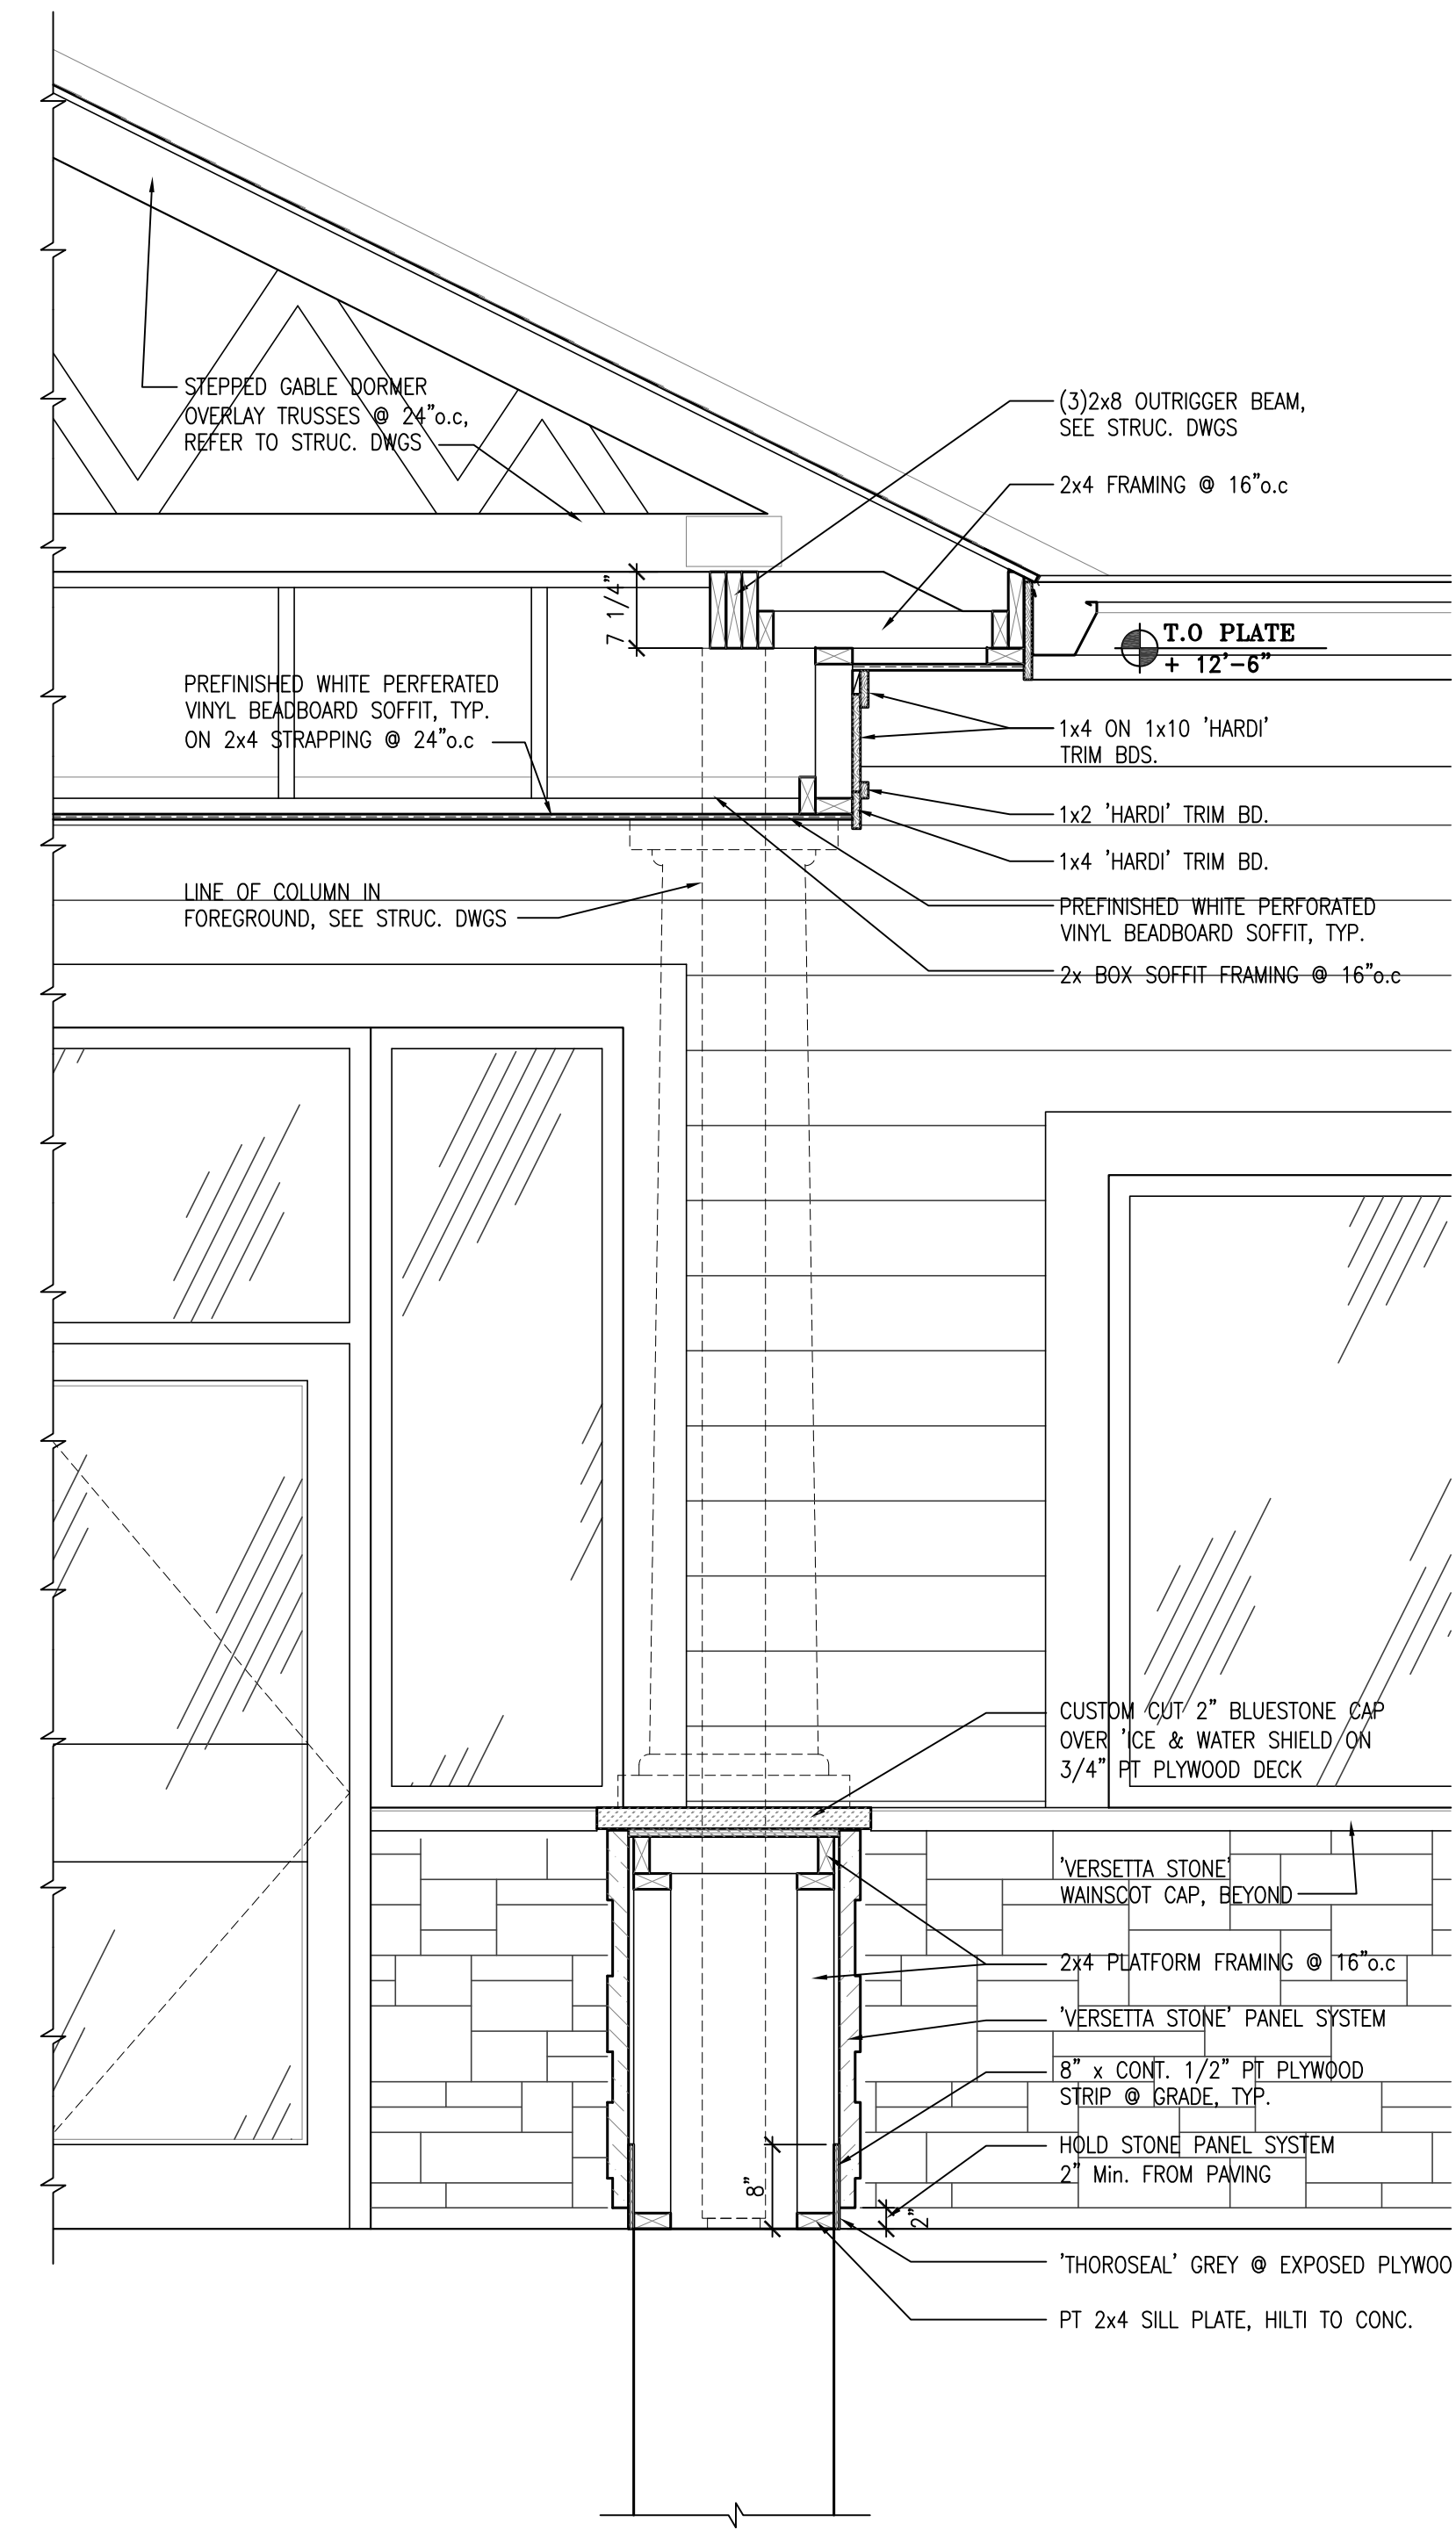

6 WALL SECTION
 SCALE: 3/4" = 1'-0"