




Priority - Portland

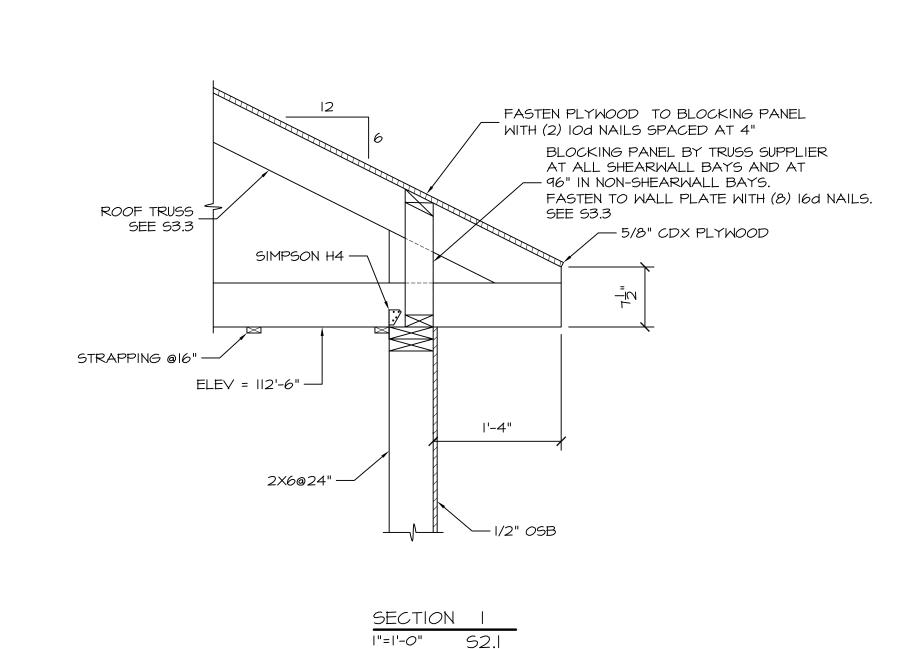


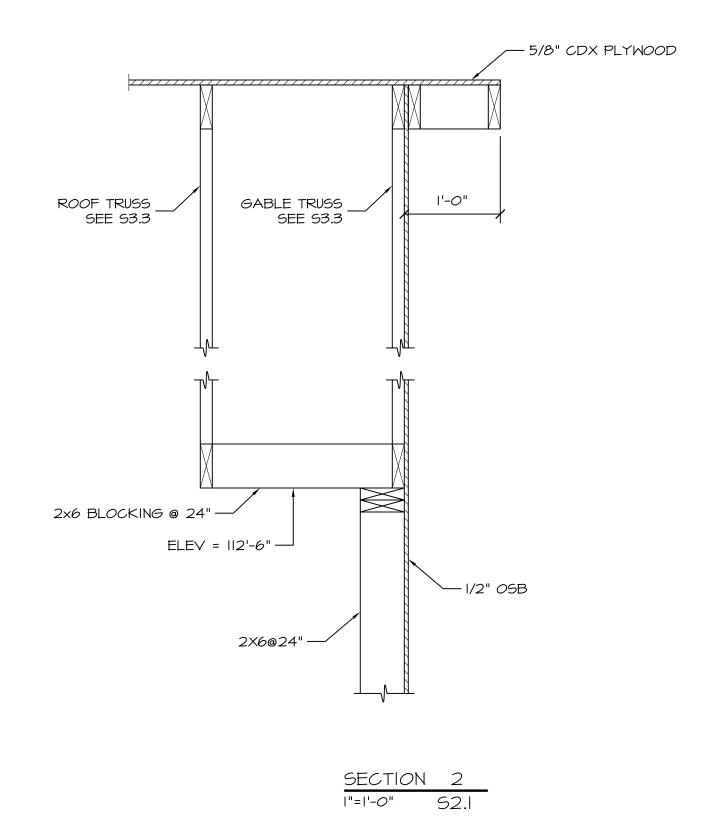

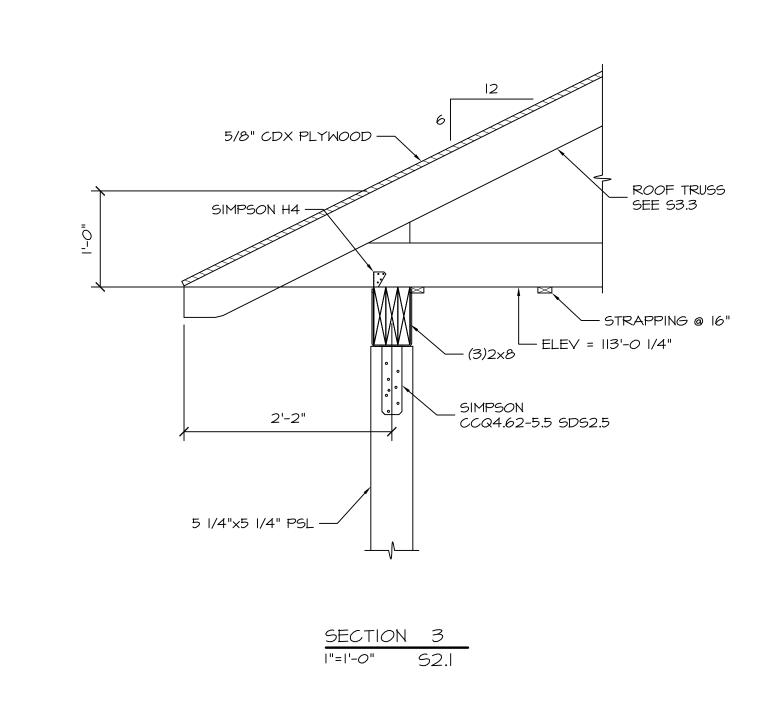

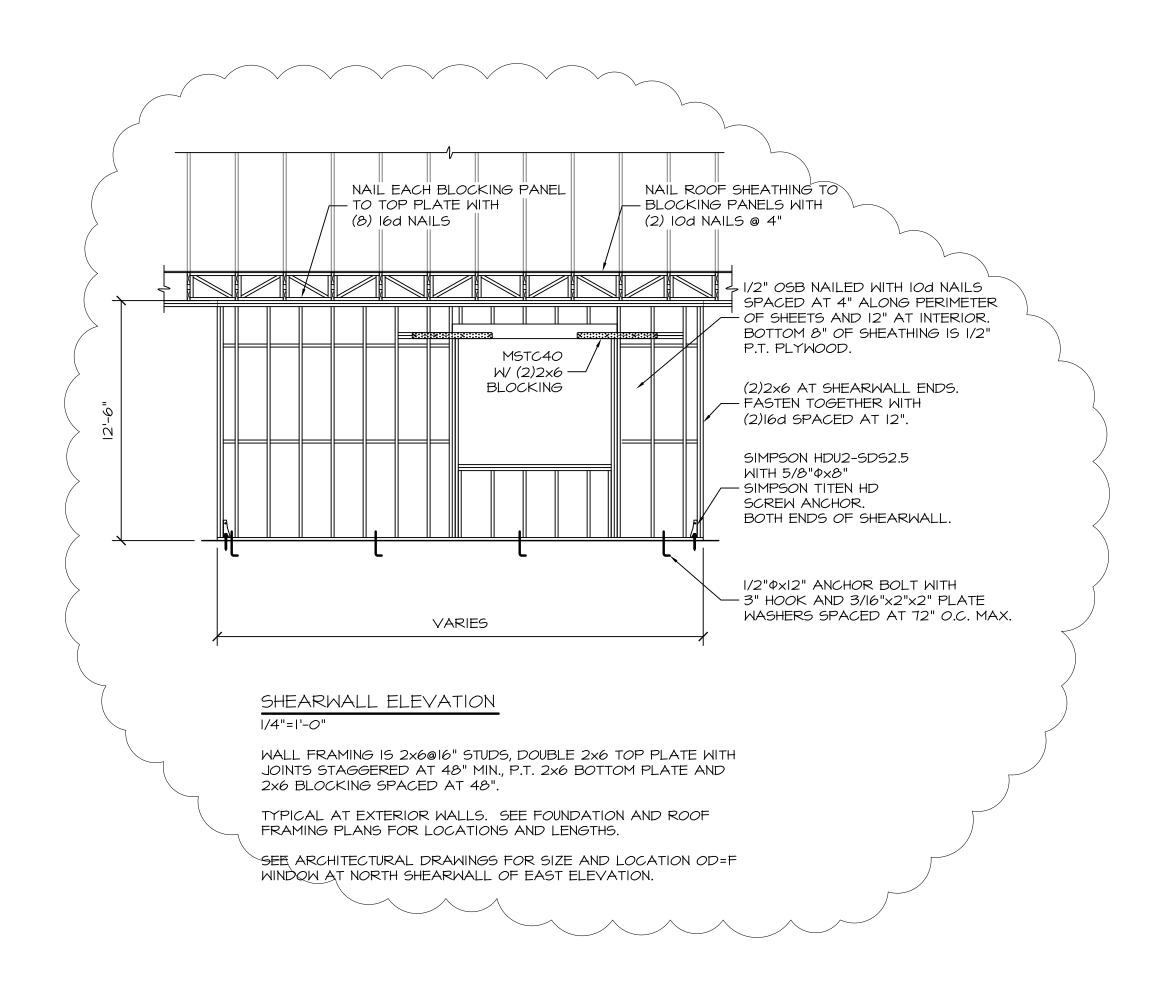

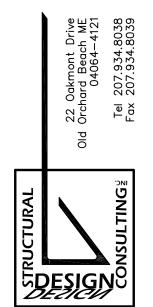

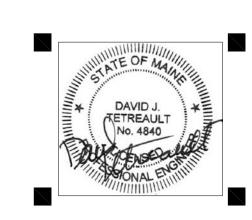

Portland Property Holdings LLC

JOB: 13026

	ISSUE DATE	
	PRELIM	_
	P BOARD	_
	SFMO	_
	CD's	09-12-14
	REV. 2	07-08-15
	PRINT	07-08-15
I		

S3.2