

930145

Permit # \_\_\_\_\_ City of Portland BUILDING PERMIT APPLICATION Fee \_\_\_\_\_ Zone \_\_\_\_\_ Map # \_\_\_\_\_ Lot# \_\_\_\_\_

Please fill out any part which applies to job. Proper plans must accompany form.

262-13-012

Owner: Brent Varney Phone # \_\_\_\_\_  
 Address: 119 Webb St. - Ptld, ME 04102  
 LOCATION OF CONSTRUCTION 119 Webb St.  
 Contractor: B & C Carpentry Sub.: 284-1868  
 Address: Box 393- West Kennebunk Phone # ME 04094  
 Est. Construction Cost: \$15,000 Proposed Use: 1-fam w intr renov  
 Past Use: 1-fam  
 # of Existing Res. Units \_\_\_\_\_ # of New Res. Units \_\_\_\_\_  
 Building Dimensions L \_\_\_\_\_ W \_\_\_\_\_ Total Sq. Ft. \_\_\_\_\_  
 # Stories: \_\_\_\_\_ # Bedrooms \_\_\_\_\_ Lot Size: \_\_\_\_\_  
 Is Proposed Use: Seasonal \_\_\_\_\_ Condominium \_\_\_\_\_ Conversion \_\_\_\_\_  
 Explain Conversion Interior renovations - basement

**For Official Use Only**  
 Date 2/24/93 Subdivision: \_\_\_\_\_  
 Inside Fire Limits \_\_\_\_\_ Name FEB 26 1993  
 Bldg Code \_\_\_\_\_ Lot \_\_\_\_\_  
 Time Limit \_\_\_\_\_ Ownership: \_\_\_\_\_ Public \_\_\_\_\_ Private \_\_\_\_\_  
 Estimated Cost 15,000

**Zoning:** R3  
 Street Frontage Provided: \_\_\_\_\_  
 Provided Setbacks: Front \_\_\_\_\_ Back \_\_\_\_\_ Side \_\_\_\_\_ Side \_\_\_\_\_  
**Review Required:**  
 Zoning Board Approval: Yes \_\_\_\_\_ No \_\_\_\_\_ Date: \_\_\_\_\_  
 Planning Board Approval: Yes \_\_\_\_\_ No \_\_\_\_\_ Date: \_\_\_\_\_  
 Conditional Use: \_\_\_\_\_ Variance \_\_\_\_\_ Site Plan \_\_\_\_\_ Subdivision \_\_\_\_\_  
 Shoreland Zoning Yes \_\_\_\_\_ No \_\_\_\_\_ Floodplain Yes \_\_\_\_\_ No \_\_\_\_\_  
 Special Exception \_\_\_\_\_  
 Other WAD-2-25-93 (Explain) \_\_\_\_\_

262 B 12 Construct garage - 24'x24'

**Foundation:**  
 1. Type of Soil: \_\_\_\_\_  
 2. Set Backs - Front \_\_\_\_\_ Rear \_\_\_\_\_ Side(s) \_\_\_\_\_  
 3. Footings Size: \_\_\_\_\_  
 4. Foundation Size: \_\_\_\_\_  
 5. Other \_\_\_\_\_

**Floor:**  
 1. Sills Size: \_\_\_\_\_ Sills must be anchored.  
 2. Girder Size: \_\_\_\_\_  
 3. Lally Column Spacing: \_\_\_\_\_ Size: \_\_\_\_\_  
 4. Joists Size: \_\_\_\_\_ Spacing 16" O.C.  
 5. Bridging Type: \_\_\_\_\_ Size: \_\_\_\_\_  
 6. Floor Sheathing Type: \_\_\_\_\_ Size: \_\_\_\_\_  
 7. Other Material: \_\_\_\_\_

**Exterior Walls:**  
 1. Studding Size \_\_\_\_\_ Spacing \_\_\_\_\_  
 2. No. windows \_\_\_\_\_  
 3. No. Doors \_\_\_\_\_  
 4. Header Sizes \_\_\_\_\_ Span(s) \_\_\_\_\_  
 5. Bracing: Yes \_\_\_\_\_ No \_\_\_\_\_  
 6. Corner Posts Size \_\_\_\_\_  
 7. Insulation Type \_\_\_\_\_ Size \_\_\_\_\_  
 8. Sheathing Type \_\_\_\_\_ Size \_\_\_\_\_  
 9. Siding Type \_\_\_\_\_ Weather Exposure \_\_\_\_\_  
 10. Masonry Materials \_\_\_\_\_  
 11. Metal Materials \_\_\_\_\_

**Interior Walls:**  
 1. Studding Size \_\_\_\_\_ Spacing \_\_\_\_\_  
 2. Header Sizes \_\_\_\_\_ Span(s) \_\_\_\_\_  
 3. Wall Covering Type \_\_\_\_\_  
 4. Fire Wall if required \_\_\_\_\_  
 5. Other Materials \_\_\_\_\_

**Ceiling:**  
 1. Ceiling Joists Size: \_\_\_\_\_  
 2. Ceiling Strapping Size \_\_\_\_\_ Spacing \_\_\_\_\_ Not in District nor Landmark.  
 3. Type Ceilings: \_\_\_\_\_ Does not require review.  
 4. Insulation Type \_\_\_\_\_ Size \_\_\_\_\_ Requires Review.  
 5. Ceiling Height: \_\_\_\_\_  
 \*\*\*\*\*  
**Roof:**  
 1. Truss or Rafter Size \_\_\_\_\_ Span \_\_\_\_\_ Action: Approved.  
 2. Sheathing Type \_\_\_\_\_ Size \_\_\_\_\_ Approved with Conditions.  
 3. Roof Covering Type \_\_\_\_\_ Detailed.  
**Chimneys:** \_\_\_\_\_ Date: 2/24/93  
 Type: \_\_\_\_\_ Number of Fire Places \_\_\_\_\_ Signature: \_\_\_\_\_  
**Heating:** \_\_\_\_\_  
 Type of Heat: \_\_\_\_\_  
**Electrical:** \_\_\_\_\_  
 Service Entrance Size: \_\_\_\_\_ Smoke Detector Required Yes \_\_\_\_\_ No \_\_\_\_\_  
**Plumbing:** \_\_\_\_\_  
 1. Approval of soil test if required Yes \_\_\_\_\_ No \_\_\_\_\_  
 2. No. of Tubs or Showers \_\_\_\_\_  
 3. No. of Flushes \_\_\_\_\_  
 4. No. of Lavatories \_\_\_\_\_  
 5. No. of Other Fixtures \_\_\_\_\_  
**Swimming Pools:** \_\_\_\_\_  
 1. Type: \_\_\_\_\_  
 2. Pool Size: \_\_\_\_\_ x \_\_\_\_\_ Square Footage \_\_\_\_\_  
 3. Must conform to National Electrical Code and State Law.

HISTORIC PRESERVATION

Permit Received by Louise E. Charney  
 Signature of Applicant \_\_\_\_\_ Date 2/24/93  
 Signature of CEO Michael Creamer Date \_\_\_\_\_  
 Inspection Dates \_\_\_\_\_

PERMIT ISSUED WITH REQUIREMENTS

PERMIT ISSUED WITH REQUIREMENTS

**PLOT PLAN**



**FEES (Breakdown From Front)**

Base Fee \$ 95  
 Subdivision Fee \$ \_\_\_\_\_  
 Site Plan Review Fee \$ \_\_\_\_\_  
 Other Fees \$ \_\_\_\_\_  
 (Explain) \_\_\_\_\_  
 Late Fee \$ \_\_\_\_\_

**Inspection Record**


Type	Date
Checked side yd. 8' 8" OK	4/15/93
Bill Crinock said 5' min. missing	1/1
10/13 work completed OK	1/1

**COMMENTS**

\_\_\_\_\_  
 \_\_\_\_\_  
Signature of Applicant Michael Crinock 284-1868 Date 2/24/93

I HEREBY CERTIFY TO BAY PORT TITLE COMPANY THAT THIS PLAN DEPICTS THE RESULTS OF A CURRENT EXAMINATION OF THE PREMISES DESCRIBED IN BOOK 7999, PAGE 290 OF THE CUMBERLAND COUNTY REGISTRY OF DEEDS AND THAT ALL BUILDINGS ARE LOCATED ON THE GROUND AS SHOWN THEREON.

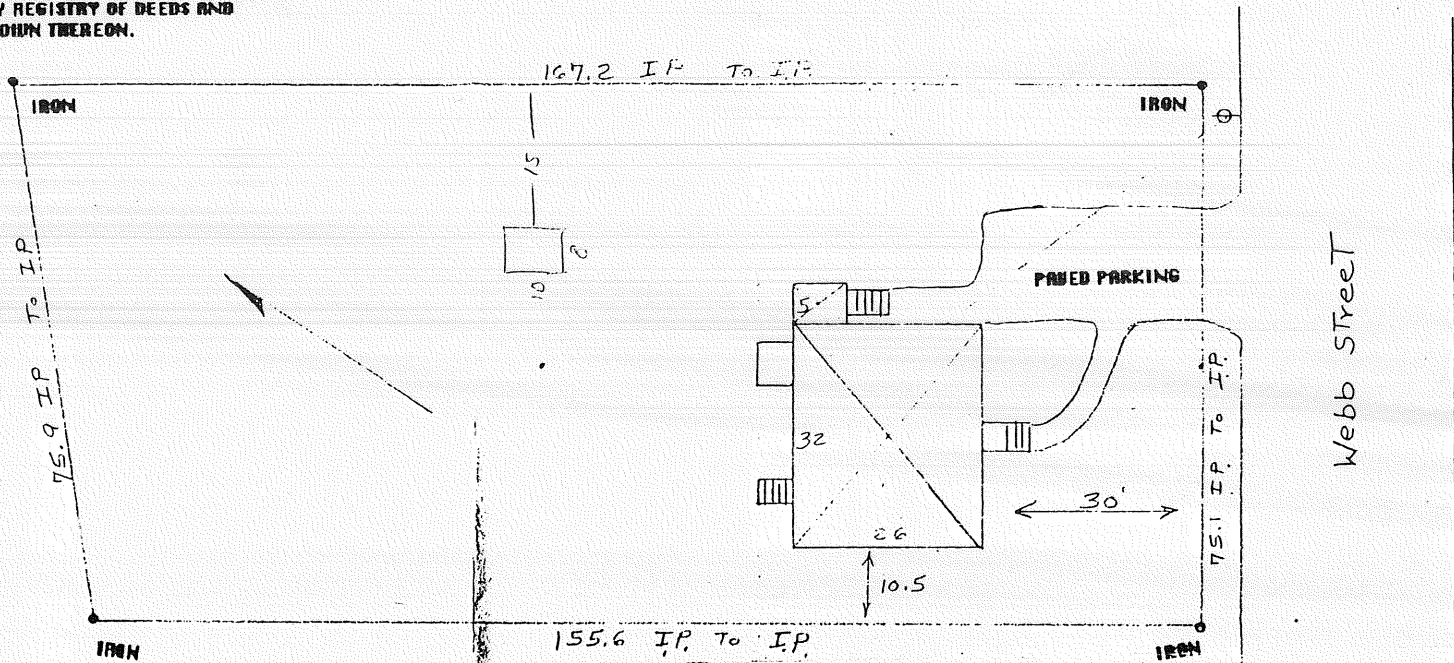

NOTES:  
This plan was not made from an instrument survey and is not for recording purposes. The plan shows conditions existing as of the date shown hereon. Certification is for mortgage purposes only. Property lines as shown are apparent only.

2. In accordance with The Department of H.U.D. Federal Insurance Administration Maps this lot  is  within a flood Hazard zone.

3. The town code enforcement officer knows of  an  apparent zone violation at the time of construction. - JUST BUILT -

*No variance needed 1-28-93*  
*WDH*  
*14-433*

*- Cape with Full back Dormer Believed 2 story Needs 14' side set back -*

Remarks: *- Assessor's Card States*  
*Lot 12 & 13 -> Lot 13*  
*Not Found on Assessor Drawing -*  
*- Deed Reference To Lot 20 in Error -*

RECEIVED  
MAY 22 1989

DEPT. OF BUILDING INSPECTIONS  
CITY OF PORTLAND


RECEIVED  
MAR 24 1989

DEPT. OF BUILDING INSPECTIONS  
CITY OF PORTLAND

DESCRIPTION FOR DEEDED ERECTION UNKNOWN

**SURVEYOR'S CLASS B REPORT**  
**MORTGAGE CERTIFICATION DRAWING**

PROPERTY OF John A. & Deborah S. Stiteler 119 Webb Street, Portland		
SCALE: 1"=20	INSTITUTION	DRAWN BY: P.A.W.
DATE: 6/21/88	FILE NO.:	
FOR: Brent A. Varney		
SURVEYOR Peter A. Webber, R.L.S. 0829 Scarborough, Maine	DRAWING NUMBER 198806213	

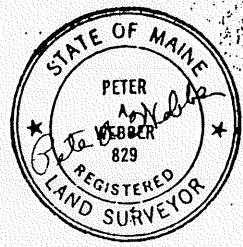

Fold line

BUILDING PERMIT REPORT

ADDRESS: 119 Webb St. DATE: 26 Feb 1993  
REASON FOR PERMIT: To construct 24x24' attached garage  
with interior renovations (basement)  
BUILDING OWNER: Brent Varney  
CONTRACTOR: B.C. Carpentry  
PERMIT APPLICANT: '  
APPROVED: \*1 \*2 \*6 \*7 \*8 \*9 \*12 \*13 \*14 \*15


CONDITION OF APPROVAL:

- 1.) Before concrete for foundation is placed, approvals from Public Works and Inspection Services must be obtained. (A 24 hour notice is required prior to inspection.)
- 2.) Precaution must be taken to protect concrete from freezing.
- 3.) All vertical openings shall be enclosed with construction having a fire rating of at least one(1) hour, including fire doors with self-closers.
- 4.) Each apartment shall have access to two(2) separate, remote and approved means of egress. A single exit is acceptable when it exits directly from the apartment to the building exterior with no communications to other apartment units.
- 5.) The boiler shall be protected by enclosing with one(1) hour fire rated construction including fire doors and ceiling, or by providing automatic extinguishment. Sprinkler piping serving not more than six sprinklers may be connected to a domestic water supply system having a capacity sufficient to provide 0.15 gallons per minute, per square foot of floor throughout the entire area. An INDICATING shut-off valve shall be installed in an accessible location between the sprinkler and the connection to the domestic water supply. Minimum pipe size shall be 3/4 inch copper or 1 inch steel. Maximum coverage area of a residential sprinkler is 144 square feet per sprinkler.
- 6.) Every sleeping room below the fourth story in buildings of Use Groups R and I-1 shall have at least one operable window or exterior door approved for emergency egress or rescue. The units must be operable from the inside opening without the use of separate tools. Where windows are provided as a means of egress or rescue, they shall have a sill height not more than 44 inches (1118 mm) above the floor. All egress or rescue windows from sleeping rooms must have minimum net clear openings of 5.7 square feet (0.53m<sup>2</sup>). The minimum net clear opening height dimension shall be 24 inches (610 mm). The minimum net clear opening width dimension shall be 20 inches (508 mm).
- 7.) All single and multiple-station smoke detectors shall be of an approved type and shall be installed in accordance with the provisions of the building code (BOCA National Building Code 1990, and N.F.P.A. 101 Chapter 18 & 19.

(over)

- 8.) Private garages located beneath rooms in buildings of Use Groups R-1, R-2, R-3 or I-1 shall have walls, partitions, floors and ceilings separating the garage space from the adjacent interior spaces constructed of not less than 1-hour fireresistance rating. Attached private garages shall be completely separated from the adjacent interior spaces and the attic area by means of 1/2-inch gypsum board or equivalent applied to the garage side. The sills of all door openings between the garage and adjacent interior spaces shall be raised not less than 4 inches (102 mm) above the garage floor. The door opening protectives shall be 1 3/4-inch solid core wood doors or approved equivalent.
- 9.) A guardrail system located near the open side of deck or elevated walking surfaces shall be constructed. Guards in buildings of Use Group R-3 shall be not less than 36 inches in height. Open guards shall have intermediate rails, balusters or other construction such that a sphere with a diameter of 4 inches cannot pass through any opening. Handrails on stairs shall be no less than 34 inches nor more than 38 inches. Handrails within individual dwelling units shall not be less than 30 inches nor more than 38 inches. For more detail on guards & handrails see Article 8 section 824.0 and 825.0 of the BOCA National Building Code.
- 10.) Section 25-135 of the Municipal Code for the City of Portland states: "No person or utility shall be granted a permit to excavate or open any street or sidewalk from the time of November 15 of each year to April 15 of the following year.
- 11.) The builder of a facility to which Section 4594-C of the Maine State Human Rights Act, Title 5 M.R.S.A. refers, shall obtain a certification from a design professional that the plans of the facility meet the standards of construction required by this section. Prior to commencing construction of the facility, the builder shall submit the certification to the Division of Inspection Services.
- 12.) Stair construction in Use Group R-3, R-4, is a minimum of 9" tread and 8-1/4" maximum rise.
- 13.) Headroom in habitable spaces is a minimum of 7'6".
- 14.) The minimum headroom in all parts of a stairway shall not be less than 6 feet 8 inches.
- 15.) All construction and demolition debris must be disposed at the RWS by a licensed carrier or solid waste at the City's authorized reclamation site. The fee rate is attached. Proof of such disposal must be furnished to the office of Inspection Services before final certificate of occupancy is issued or demolition permit is granted.


Sincerely,

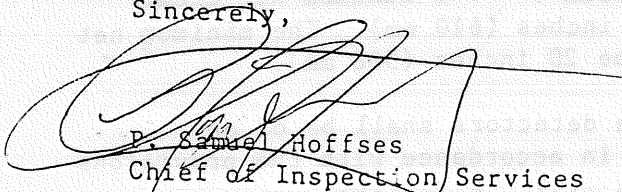  
P. Samuel Hoffses  
Chief of Inspection Services

/el

11/16/88-11/27/90-8/14/91-9/2/92-10/14/92

EXISTING HOUSE

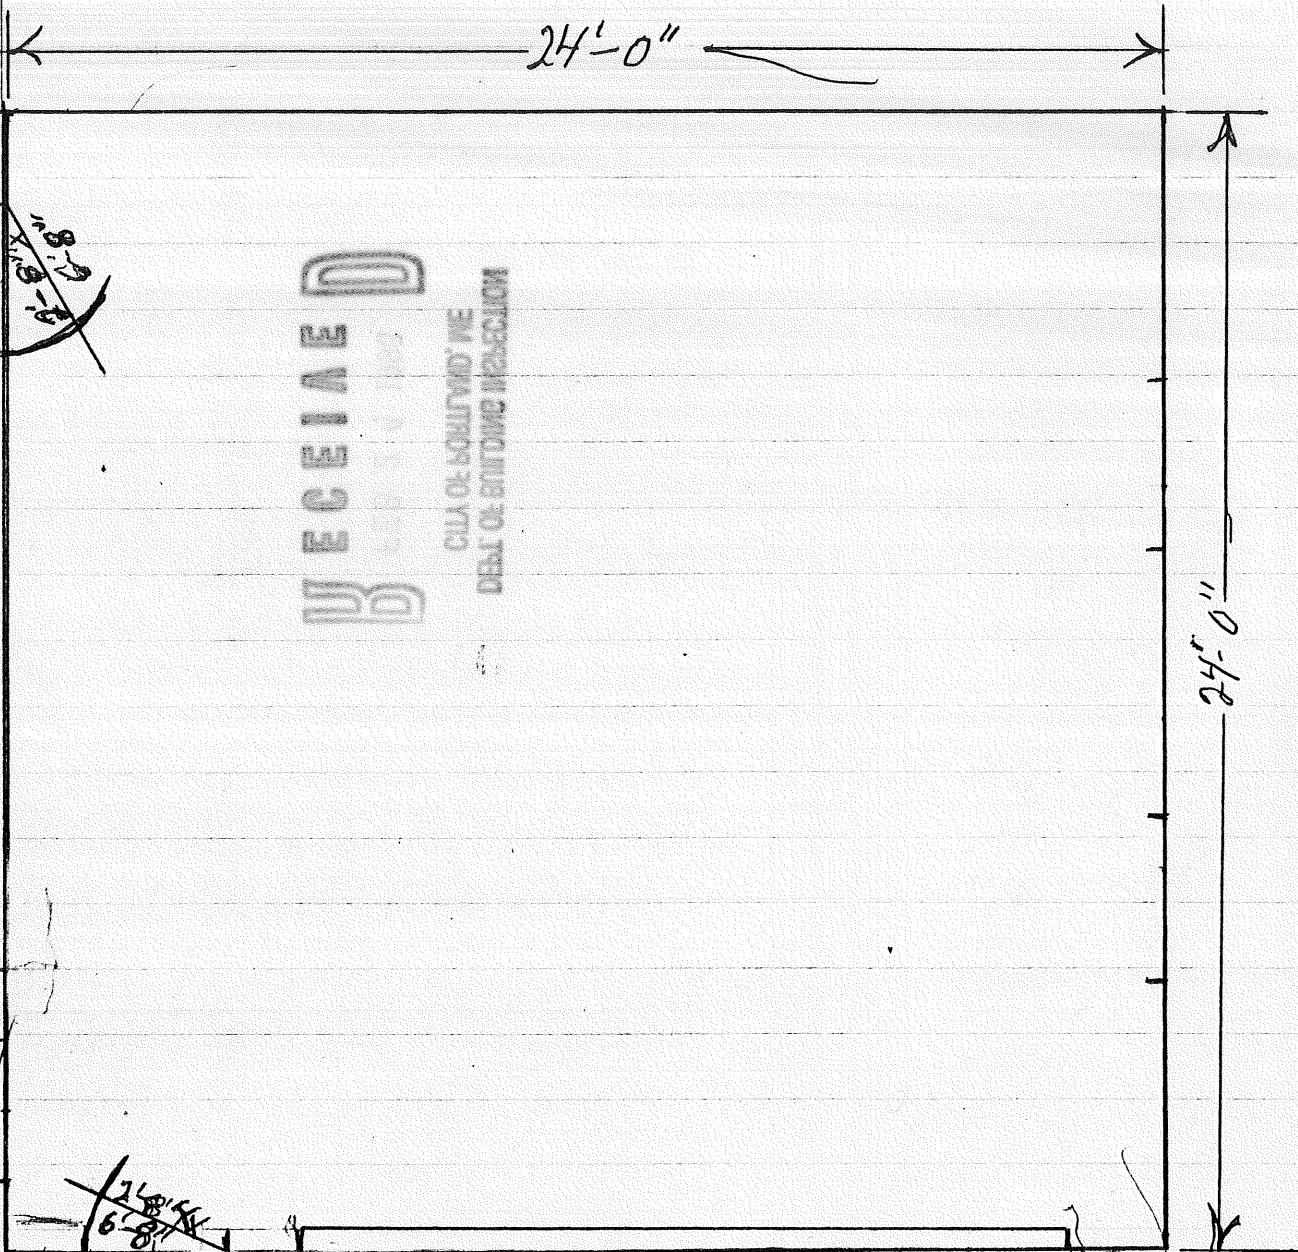

GARAGE - B. VARNEY 119 WEBB ST. PORT.

BULK HEAD

RECEIVED  
FEB 5 1933  
CITY OF BOSTON  
DEPT. OF BUILDING INSPECTION


DRY BAR


BOOK CASE

26'-0"

32'-0"

FAMILY ROOM - R. VARNEY 119 WEBB ST. PORT.

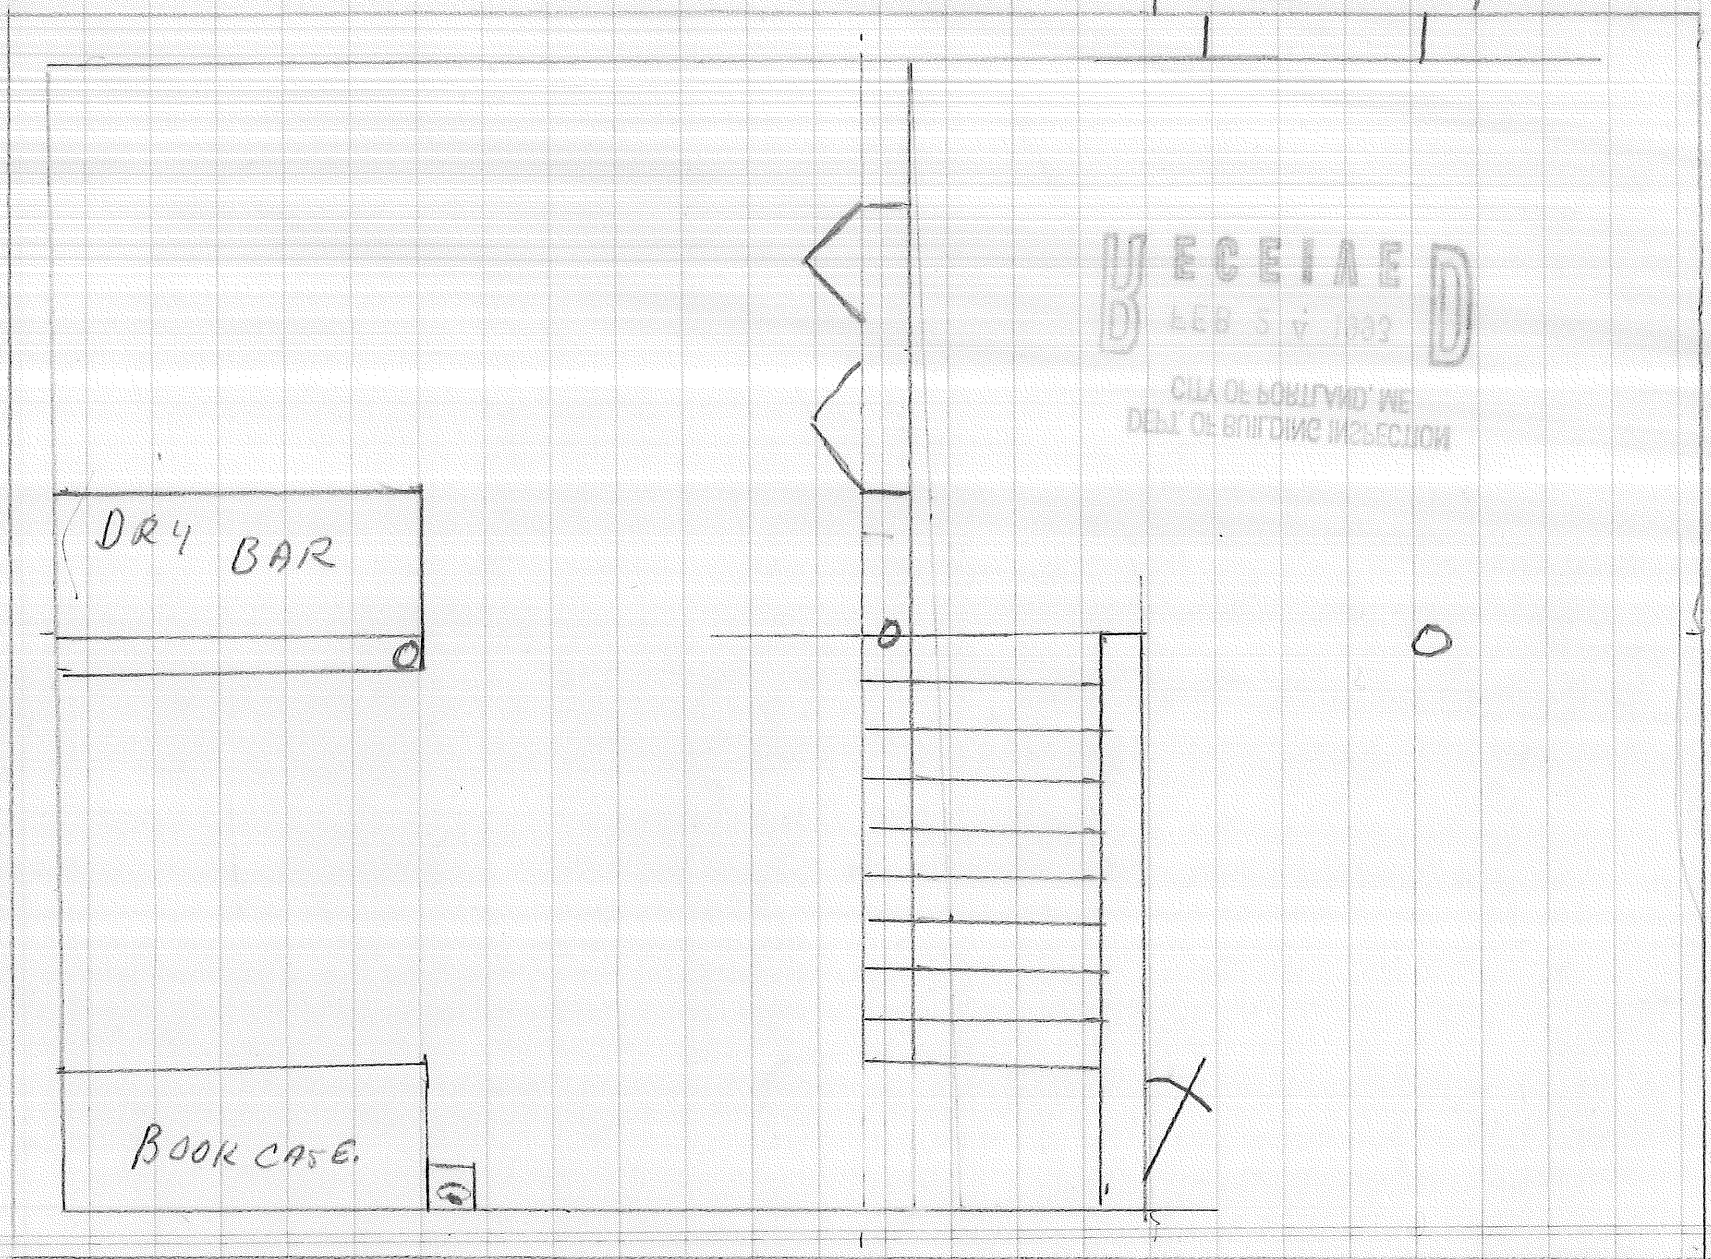

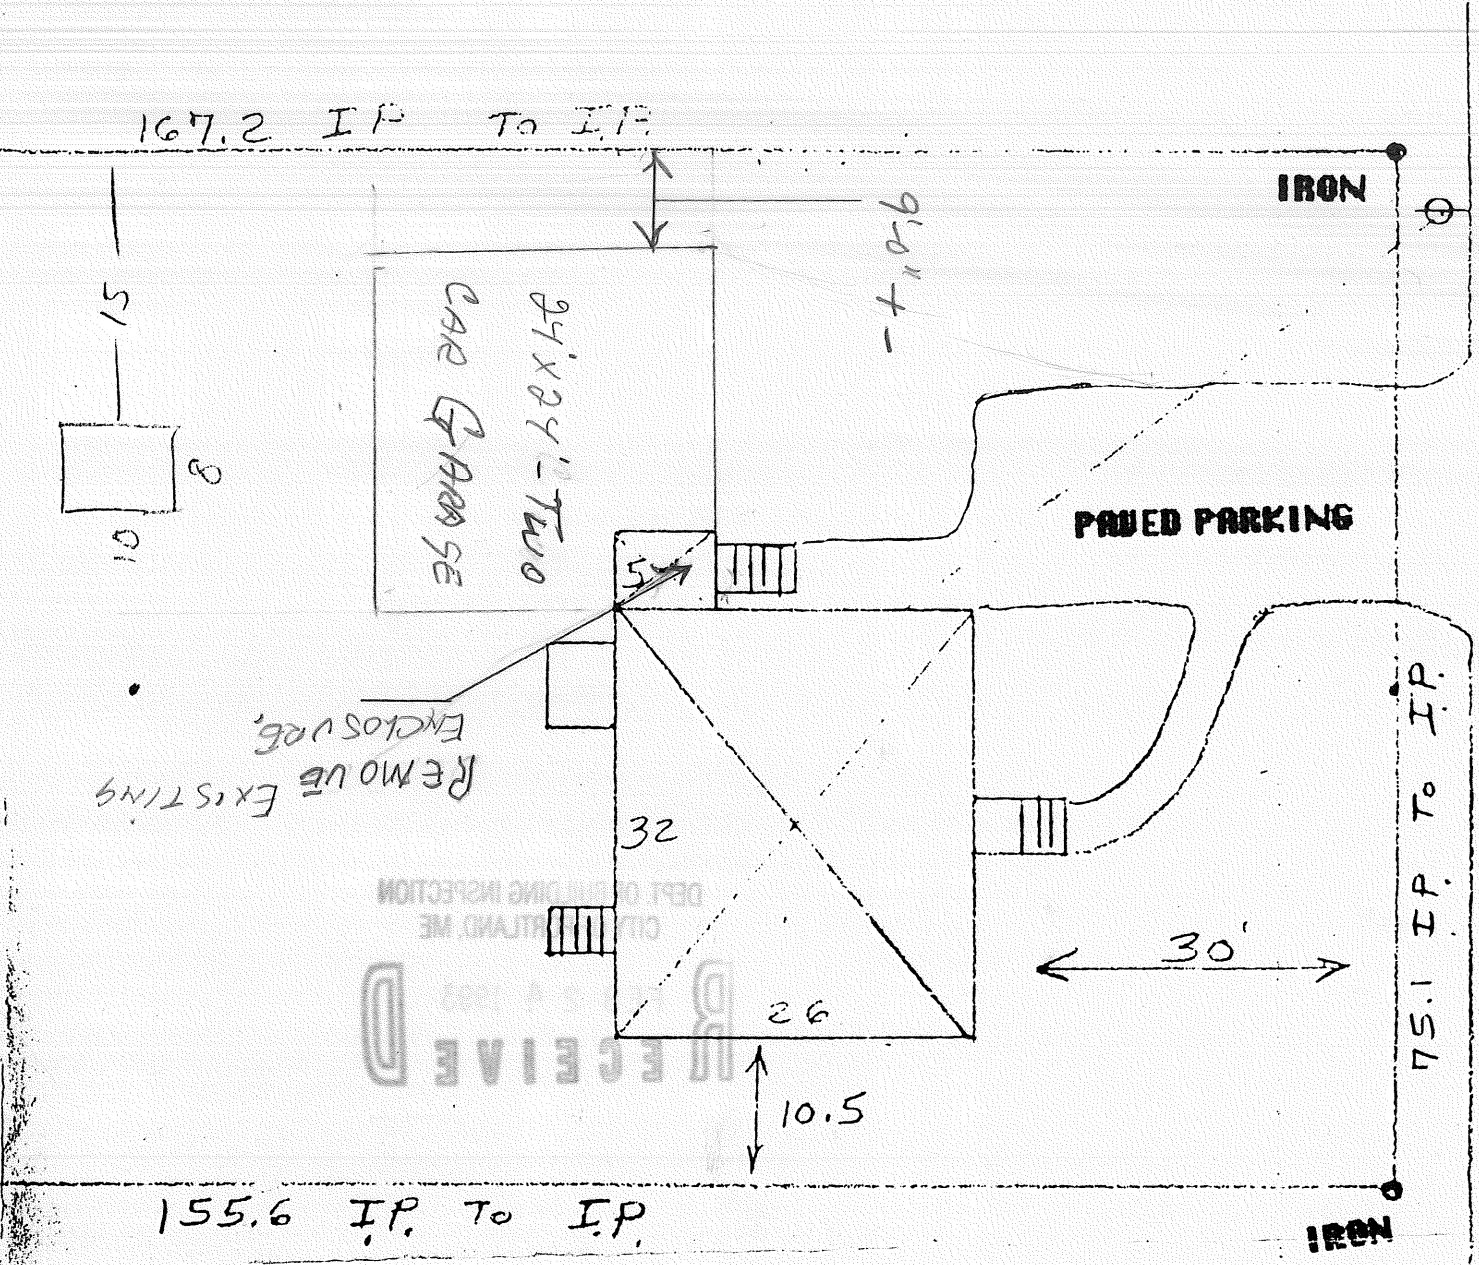

Webb Street

RECEIVED

RECEIVED