

DISPLAY THIS CARD ON PRINCIPAL FRONTAGE OF WORK

# CITY OF PORTLAND

## BUILDING INSPECTION

# PERMIT

### PERMIT ISSUED

Permit Number: 101124

Please Read Application And Notes, If Any, Attached

This is to certify that Portland Hotels Inc. OCT 7 2010

has permission to Convert six motel rooms into one dwelling unit

AT 1210 Brighton Ave CBL 265 A001001 City of Portland

provided that the person or persons, firm or corporation accepting this permit shall comply with all of the provisions of the Statutes of Maine and of the Ordinances of the City of Portland regulating the construction, maintenance and use of buildings and structures, and of the application on file in this department.

Apply to Public Works for street line and grade if nature of work requires such information.

Notification of inspection must be given and written permission procured before this building or part thereof is lathed or otherwise closed-in. 24 HOUR NOTICE IS REQUIRED.

A certificate of occupancy must be procured by owner before this building or part thereof is occupied.

#### OTHER REQUIRED APPROVALS

Fire Dept. CAPT. R. Gauthier

Health Dept. \_\_\_\_\_

Appeal Board \_\_\_\_\_

Other \_\_\_\_\_

Department Name

*Jeanne Barber*  
Director - Building & Inspection Services

**PENALTY FOR REMOVING THIS CARD**

**City of Portland, Maine - Building or Use Permit Application**

389 Congress Street, 04101 Tel: (207) 874-8703, Fax: (207) 874-8716

Permit No: 10-1124	Issue Date:	CBL: 265 A001001
-----------------------	-------------	---------------------

Location of Construction: 1210 Brighton Ave	Owner Name: Portland Hotels Inc.	Owner Address: 1200 Brighton Avenue	Phone:
Business Name:	Contractor Name:	Contractor Address:	Phone:
Lessee/Buyer's Name	Phone:	Permit Type: Change of Use - Commercial	Zone: B-4

Past Use: Commercial motel <del>unit rental unit</del>	Proposed Use: Commercial motel <del>residential unit</del> - Convert six motel rooms into one dwelling unit	Permit Fee: \$145.00	Cost of Work: \$4,500.00	CEO District: 3
Proposed Project Description: Convert six motel rooms into one dwelling unit		FIRE DEPT: <input checked="" type="checkbox"/> Approved <input type="checkbox"/> Denied <i>*See Conditions</i>	INSPECTION: Use Group: <i>R-1/R-3</i> Type: <i>IBC 2003</i>	
		Signature: <i>(KG)</i>	Signature: <i>AMB 10/10</i>	
PEDESTRIAN ACTIVITIES DISTRICT (P.A.D.)				
Action: <input type="checkbox"/> Approved <input type="checkbox"/> Approved w/Conditions <input type="checkbox"/> Denied				
Signature: _____ Date: _____				

Permit Taken By: ldobson	Date Applied For: 09/08/2010	<b>Zoning Approval</b>
-----------------------------	---------------------------------	------------------------

- This permit application does not preclude the Applicant(s) from meeting applicable State and Federal Rules.
- Building permits do not include plumbing, septic or electrical work.
- Building permits are void if work is not started within six (6) months of the date of issuance. False information may invalidate a building permit and stop all work..

**PERMIT ISSUED**

OCT 18 7 2010

City of Portland

<b>Special Zone or Reviews</b> <input type="checkbox"/> Shoreland <input type="checkbox"/> Wetland <input type="checkbox"/> Flood Zone <input type="checkbox"/> Subdivision <input type="checkbox"/> Site Plan Maj <input type="checkbox"/> Minor <input type="checkbox"/> MM <input type="checkbox"/> <i>OK w/ conditions</i> Date: <i>9/22/10</i> <i>AKM</i>	<b>Zoning Appeal</b> <input type="checkbox"/> Variance <input type="checkbox"/> Miscellaneous <input type="checkbox"/> Conditional Use <input type="checkbox"/> Interpretation <input type="checkbox"/> Approved <input type="checkbox"/> Denied Date: _____	<b>Historic Preservation</b> <input checked="" type="checkbox"/> Not in District or Landmark <input type="checkbox"/> Does Not Require Review <input type="checkbox"/> Requires Review <input type="checkbox"/> Approved <input type="checkbox"/> Approved w/Conditions <input type="checkbox"/> Denied Date: <i>AKM</i>
--	---	---

**CERTIFICATION**

I hereby certify that I am the owner of record of the named property, or that the proposed work is authorized by the owner of record and that I have been authorized by the owner to make this application as his authorized agent and I agree to conform to all applicable laws of this jurisdiction. In addition, if a permit for work described in the application is issued, I certify that the code official's authorized representative shall have the authority to enter all areas covered by such permit at any reasonable hour to enforce the provision of the code(s) applicable to such permit.

SIGNATURE OF APPLICANT	ADDRESS	DATE	PHONE
RESPONSIBLE PERSON IN CHARGE OF WORK, TITLE		DATE	PHONE

**City of Portland, Maine - Building or Use Permit**

389 Congress Street, 04101 Tel: (207) 874-8703, Fax: (207) 874-8716

Permit No: 10-1124	Date Applied For: 09/08/2010	CBL: 265 A001001
-----------------------	---------------------------------	---------------------

Location of Construction: 1210 Brighton Ave	Owner Name: Portland Hotels Inc.	Owner Address: 1200 Brighton Avenue	Phone:
Business Name:	Contractor Name:	Contractor Address:	Phone
Lessee/Buyer's Name	Phone:	Permit Type: Change of Use - Commercial	

Proposed Use: Commercial motel residential unit - Convert six motel rooms into one dwelling unit	Proposed Project Description: Convert six motel rooms into one dwelling unit
---	---

**Dept:** Zoning      **Status:** Approved with Conditions      **Reviewer:** Ann Machado      **Approval Date:** 09/22/2010

**Note:** A motel is defined as a building that contains guest rooms or dwelling units. It also says that it is intended to be used principally by automobile transients for compensation. A transient is defined as someone who occupies a facility on an overnight basis for compensation and whose occupancy is limited to no more than fifteen days out of a sixty day period. These definitions apply to the use of this dwelling unit. **Ok to Issue:**

- 1) This permit is being approved on the basis of plans submitted. Any deviations shall require a separate approval before starting that work.

**Dept:** Building      **Status:** Approved with Conditions      **Reviewer:** Jeanine Bourke      **Approval Date:**

**Note:** 10/5/10 Routed from Tammy M. **Ok to Issue:**

- 1) All penetrations through rated assemblies must be protected by an approved firestop system installed in accordance with ASTM 814 or UL 1479, per IBC 2003 Section 712.
- 2) Separate permits are required for any electrical, plumbing, sprinkler, fire alarm HVAC systems, heating appliances, including pellet/wood stoves, commercial hood exhaust systems and fuel tanks. Separate plans may need to be submitted for approval as a part of this process.
- 3) Application approval based upon information provided by applicant. Any deviation from approved plans requires separate review and approval prior to work.
- 4) Those renovating dwellings shall install a CO detector in each area within or giving access to bedrooms. That detection must be powered by the electrical service in the building and battery.

**Dept:** Fire      **Status:** Approved with Conditions      **Reviewer:** Capt Keith Gautreau      **Approval Date:** 09/28/2010

**Note:** **Ok to Issue:**

- 1) All construction shall comply with City Code Chapter 10.
- 2) All smoke detectors and smoke alarms shall be photoelectric. Carbon Monoxide detectors are required in the dwelling units by State law.

**Comments:**

10/6/2010-jmb: Spoke with Mr. Patel about the structural support of the new 6' door opening, he will submit a detail when he picks up the permit.

## **BUILDING PERMIT INSPECTION PROCEDURES**

**Please call 874-8703 or 874-8693 (ONLY )**

**or email: [buildinginspections@portlandmaine.gov](mailto:buildinginspections@portlandmaine.gov)**

With the issuance of this permit, the owner, builder or their designee is required to provide adequate notice to the City of Portland Inspection Services for the following inspections. Appointments must be requested 48 to 72 hours in advance of the required inspection. The inspection date will need to be confirmed by this office.

- **Please read the conditions of approval that is attached to this permit!! Contact this office if you have any questions.**
- **Permits expire in 6 months, if the project is not started or ceases for 6 months.**
- **If the inspection requirements are not followed as stated below additional fees may be incurred due to the issuance of a "Stop Work Order" and subsequent release to continue with construction.**

  X   **Framing/Rough Plumbing/Electrical: Prior to Any Insulating or drywalling**

  X   **Final/Certificate of Occupancy: Prior to any occupancy of the structure or use.**

**NOTE: There is a \$75.00 fee per inspection at this point.**

**The project cannot move to the next phase prior to the required inspection and approval to continue, REGARDLESS OF THE NOTICE OR CIRCUMSTANCES.**

**IF THE PERMIT REQUIRES A CERTIFICATE OF OCCUPANCY, IT MUST BE PAID FOR AND ISSUED TO THE OWNER OR DESIGNEE BEFORE THE SPACE MAY BE OCCUPIED.**



# General Building Permit Application

If you or the property owner owes real estate or personal property taxes or user charges on any property within the City, payment arrangements must be made before permits of any kind are accepted.

Location/Address of Construction: <u>1200 Brighton Ave.</u>		
Total Square Footage of Proposed Structure/Area	Square Footage of Lot	Number of Stories <u>2</u>
Tax Assessor's Chart, Block & Lot Chart# <u>205</u> Block# <u>A</u> Lot# <u>B</u>	Applicant "must be owner, Lessee or Buyer" Name <u>Kamlesh Patel</u> Address <u>1200 Brighton Ave.</u> City, State & Zip <u>Portland ME 04102</u>	Telephone: <u>207 807 1127</u>
Lessee/DBA (If Applicable)	Owner (if different from Applicant) Name Address City, State & Zip	Cost Of Work: \$ <u>4,500.-</u> C of O Fee: \$ <u>75</u> Total Fee: \$ <u>175</u>
Current legal use (i.e. single family) <u>motel</u> Number of Residential Units <u>122</u>		
If vacant, what was the previous use? _____		
Proposed Specific use: <u>Drill Unit</u>		
Is property part of a subdivision? <u>NO</u> If yes, please name _____		
Project description: <u>living unit</u> <u>Drill Unit</u>		
Contractor's name: _____		
Address: _____		
City, State & Zip _____ Telephone: _____		
Who should we contact when the permit is ready: <u>Kamlesh Patel</u> Telephone: <u>207 807 1127</u>		
Mailing address: <u>1200 Brighton Ave. Portland ME 04102</u>		


Please submit all of the information outlined on the applicable Checklist. Failure to do so will result in the automatic denial of your permit.

**RECEIVED**


In order to be sure the City fully understands the full scope of the project, the Planning and Development Department may request additional information prior to the issuance of a permit. For further information or to download copies of this form and other applications visit the Inspections Division on-line at [www.portlandmaine.gov](http://www.portlandmaine.gov), or stop by the Inspections Division office, room 315 City Hall or call 874-8703.

Dept. of Building Inspections


I hereby certify that I am the Owner of record of the named property, or that the owner of \_\_\_\_\_ City of \_\_\_\_\_ has authorized the proposed work and that I have been authorized by the owner to make this application as his/her authorized agent. I agree to conform to all applicable laws of this jurisdiction. In addition, if a permit for work described in this application is issued, I certify that the Code Official's authorized representative shall have the authority to enter all areas covered by this permit at any reasonable hour to enforce the provisions of the codes applicable to this permit.

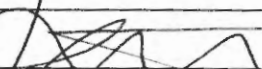Signature:  Date: 9/8/2010

This is not a permit; you may not commence ANY work until the permit is issued.

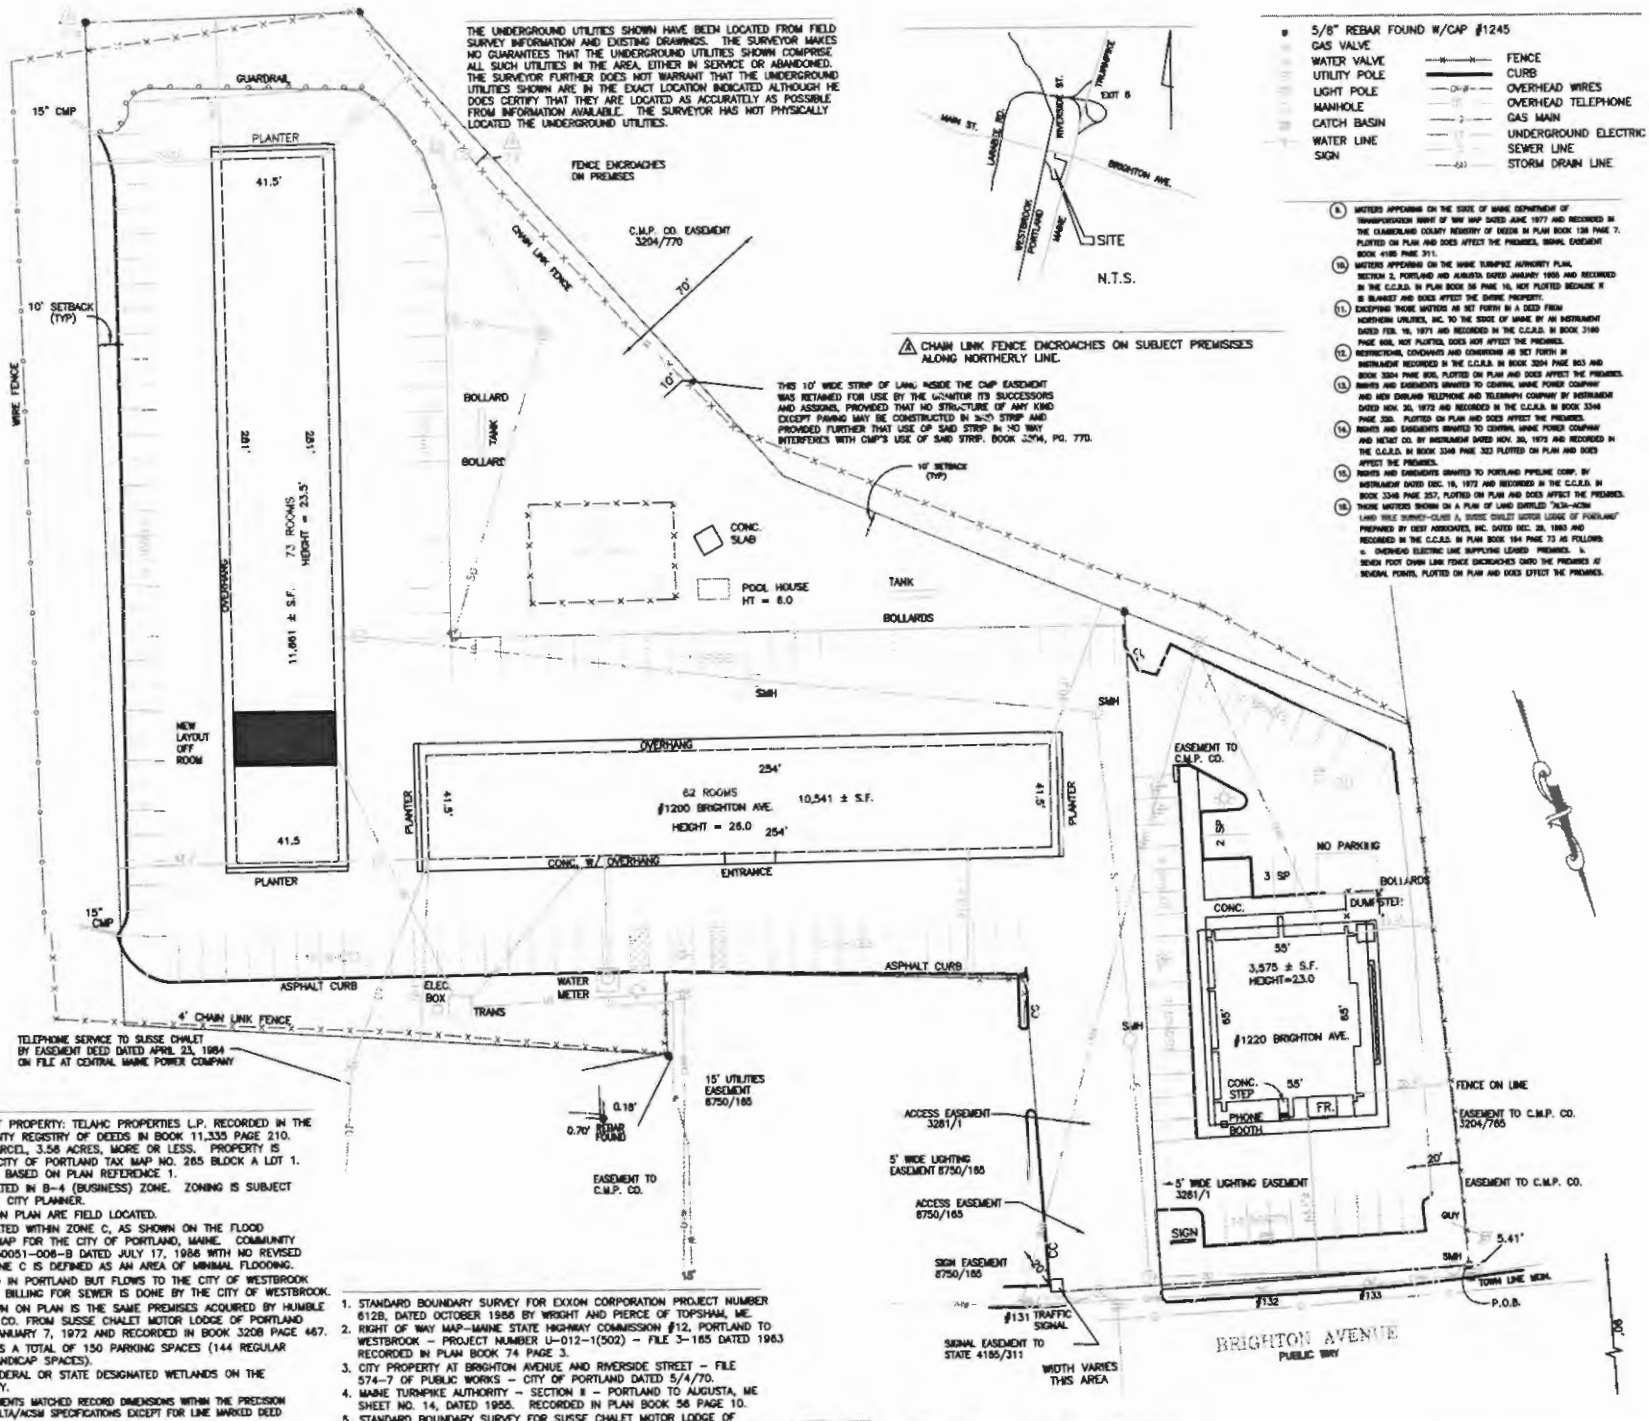

THE UNDERGROUND UTILITIES SHOWN HAVE BEEN LOCATED FROM FIELD SURVEY INFORMATION AND EXISTING DRAWINGS. THE SURVEYOR MAKES NO GUARANTEES THAT THE UNDERGROUND UTILITIES SHOWN COMPRISE ALL SUCH UTILITIES IN THE AREA, EITHER IN SERVICE OR ABANDONED. THE SURVEYOR FURTHER DOES NOT WARRANT THAT THE UNDERGROUND UTILITIES SHOWN ARE IN THE EXACT LOCATION INDICATED ALTHOUGH HE DOES CERTIFY THAT THEY ARE LOCATED AS ACCURATELY AS POSSIBLE FROM INFORMATION AVAILABLE. THE SURVEYOR HAS NOT PHYSICALLY LOCATED THE UNDERGROUND UTILITIES.

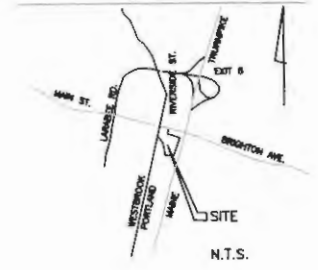

- 5/8" REBAR FOUND W/CAP #1245
- GAS VALVE
- WATER VALVE
- UTILITY POLE
- LIGHT POLE
- MANHOLE
- CATCH BASIN
- WATER LINE
- SIGN
- FENCE
- CURB
- OVERHEAD WIRES
- MANHOLE TELEPHONE
- GAS MAIN
- UNDERGROUND ELECTRIC
- SEWER LINE
- STORM DRAIN LINE

CHAIN LINK FENCE ENCROACHES ON SUBJECT PREMISES ALONG NORTHERLY LINE.

THIS 10' WIDE STRIP OF LAND INSIDE THE CMP EASEMENT WAS RETAINED FOR USE BY THE OWNER ITS SUCCESSORS AND ASSIGNS PROVIDED THAT NO STRUCTURE OF ANY KIND EXCEPT PAVING MAY BE CONSTRUCTED IN SAID STRIP AND PROMISED FURTHER THAT USE OF SAID STRIP IN NO WAY INTERFERES WITH CMP'S USE OF SAID STRIP. BOOK 3294, PG. 770.

8. MATTERS APPEARING ON THE FACE OF SAID INSTRUMENT OF UNINCORPORATED MAP OF MAY 1947 DATED JUNE 1977 AND RECORDED IN THE CLAMBLEND COUNTY REGISTRY OF DEEDS IN PLAN BOOK 128 PAGE 7. PLOTTED ON PLAN AND DOES AFFECT THE PREMISES. INSTRUMENT BOOK 4180 PAGE 311.
- 9A. MATTERS APPEARING ON THE SAID TURNPIKE AUTHORITY PLAN SECTION 2, PORTLAND AND AUGUSTA DATED JANUARY 1988 AND RECORDED IN THE C.C.A. IN PLAN BOOK 56 PAGE 16, NOT PLOTTED BECAUSE IT IS BLANKET AND DOES AFFECT THE ENTIRE PROPERTY.
10. EXCEPTING THOSE MATTERS AS SET FORTH IN A DEED FROM NORTHEAST UTILITIES, INC. TO THE SIDE OF SAID BY AN INSTRUMENT DATED FEB. 16, 1973 AND RECORDED IN THE C.C.A. IN BOOK 3140 PAGE 804, NOT PLOTTED, DOES NOT AFFECT THE PREMISES.
11. INSTRUMENTS, ENCUMBRANCES AND CONVEYANCES AS SET FORTH IN INSTRUMENTS RECORDED IN THE C.C.A. IN BOOK 3204 PAGE 803 AND BOOK 3204 PAGE 804, PLOTTED ON PLAN AND DOES AFFECT THE PREMISES.
12. INSTRUMENTS, ENCUMBRANCES AND CONVEYANCES BY INSTRUMENT DATED NOV. 30, 1972 AND RECORDED IN THE C.C.A. IN BOOK 3348 PAGE 328. PLOTTED ON PLAN AND DOES AFFECT THE PREMISES.
13. INSTRUMENTS, ENCUMBRANCES AND CONVEYANCES BY INSTRUMENT DATED NOV. 30, 1973 AND RECORDED IN THE C.C.A. IN BOOK 3348 PAGE 323 PLOTTED ON PLAN AND DOES AFFECT THE PREMISES.
14. RIGHTS AND ENCUMBRANCES GRANTED TO PORTLAND PIPELINE CORP. BY INSTRUMENT DATED DEC. 19, 1972 AND RECORDED IN THE C.C.A. IN BOOK 3248 PAGE 227, PLOTTED ON PLAN AND DOES AFFECT THE PREMISES.
15. MATTERS SHOWN ON A PLAN OF LAND ENTITLED "1234-ACRES LAND TITLE SURVEY-CLOSE A, SUSSE CHALET MOTOR LODGE OF PORTLAND" PREPARED BY CEST ASSOCIATES, INC. DATED DEC. 28, 1983 AND RECORDED IN THE C.C.A. IN PLAN BOOK 184 PAGE 73 AS FOLLOWS:
  - a. OVERHEAD ELECTRIC LINE SUPPLYING LEASED PREMISES.
  - b. SEVEN FOOT CHAIN LINK FENCE ENCROACHES OVER THE PREMISES AT VARIOUS POINTS, PLOTTED ON PLAN AND DOES AFFECT THE PREMISES.


RECORD OWNER OF PROPERTY: TELAHQ PROPERTIES L.P. RECORDED IN THE CLAMBLEND COUNTY REGISTRY OF DEEDS IN BOOK 11,333 PAGE 210. TOTAL AREA OF PARCEL: 3.56 ACRES, MORE OR LESS. PROPERTY IS LOCATED ON THE CITY OF PORTLAND TAX MAP NO. 265 BLOCK A LOT 1. J. BEARINGS ARE BASED ON PLAN REFERENCE 1. PROPERTY IS LOCATED IN B-4 (BUSINESS) ZONE. ZONING IS SUBJECT TO REVIEW BY THE CITY PLANNER. UTILITIES SHOWN ON PLAN ARE FIELD LOCATED. PROPERTY IS LOCATED WITHIN ZONE C, AS SHOWN ON THE FLOOD INSURANCE RATE MAP FOR THE CITY OF PORTLAND, MAINE. COMMUNITY ANEL NUMBER 230051-008-B DATED JULY 17, 1986 WITH NO REVISED ATE KNOWN. ZONE C IS DEFINED AS AN AREA OF MINOR FLOODING. EWER IS LOCATED IN PORTLAND BUT FLOWS TO THE CITY OF WESTBROOK TREATMENT PLANT. BILLING FOR SEWER IS DONE BY THE CITY OF WESTBROOK. JT A-B AS SHOWN ON PLAN IS THE SAME PREMISES ACQUIRED BY HUMBLE IL AND REFINING CO. FROM SUSSE CHALET MOTOR LODGE OF PORTLAND Y DEED DATED JANUARY 7, 1972 AND RECORDED IN BOOK 3208 PAGE 467. -IS SITE CONTAINS A TOTAL OF 150 PARKING SPACES (144 REGULAR SPACES AND 6 HANDICAP SPACES). -HERE ARE NO FEDERAL OR STATE DESIGNATED WETLANDS ON THE SUBJECT PROPERTY. ALL FIELD MEASUREMENTS MATCHED RECORD DIMENSIONS WITHIN THE PRECISION REQUIREMENTS OF ALTA/ACSM SPECIFICATIONS EXCEPT FOR LINE MARKED DEED JLL 218.87.

1. STANDARD BOUNDARY SURVEY FOR EXXON CORPORATION PROJECT NUMBER 6128, DATED OCTOBER 1986 BY WRIGHT AND PIERCE OF TOPSHAM, ME.
2. RIGHT OF WAY MAP-MAINE STATE HIGHWAY COMMISSION #12, PORTLAND TO WESTBROOK - PROJECT NUMBER U-012-1(502) - FILE 3-185 DATED 1943 RECORDED IN PLAN BOOK 74 PAGE 3.
3. CITY PROPERTY AT BRIGHTON AVENUE AND RIVERSIDE STREET - FILE 574-7 OF PUBLIC WORKS - CITY OF PORTLAND DATED 5/4/70.
4. MAINE TURNPIKE AUTHORITY - SECTION 1 - PORTLAND TO AUGUSTA, ME SHEET NO. 14, DATED 1955 - RECORDED IN PLAN BOOK 56 PAGE 10.
5. STANDARD BOUNDARY SURVEY FOR SUSSE CHALET MOTOR LODGE OF PORTLAND, 1200 BRIGHTON AVE., PORTLAND MAINE, DATED 12/14/90 BY CEST ASSOCIATES INC. OF SOUTH PORTLAND, MAINE.
6. RIGHT OF WAY MAP STATE HIGHWAY #12 F.A.P. #M-0630 (1) SECTION 4 DATED JUNE 1977 SHEET #9 D.O.T. FILE #3-245 RECORDED IN PLAN BOOK 128 PAGE 7.
7. ALTA/ACSM LAND TITLE SURVEY FOR SUSSE CHALET MOTOR LODGE OF PORTLAND DATED DEC. 1993 REVISED 12/29/1993 BY CEST ASSOCIATES, INC. RECORDED IN PLAN BOOK 184 PAGE 73.




PERMITTED USES: MOTEL WITH LESS THAN 150 ROOMS, RESTAURANT  
 MINIMUM LOT SIZE: 10,000 SQ. FT. SETBACKS: FRONT YARD: 10'  
 MINIMUM STREET FRONTAGE: 50' REAR YARD: 10'  
 MINIMUM LOT WIDTH: 50' SIDE YARD: 10'  
 MAXIMUM BUILDING HEIGHT: 45'  
 MAXIMUM IMPERVIOUS SURFACE RATIO: 80%  
 PARKING REQUIREMENT FOR MOTEL IS 1 SPACE PER SLEEPING ROOM.

COPYRIGHT 1989 - 1997  
 by Bost & Clark  
 This product style and format is protected by Copyright and all rights are reserved. The use of this style and format is strictly prohibited without the written consent and permission of Bost & Clark.

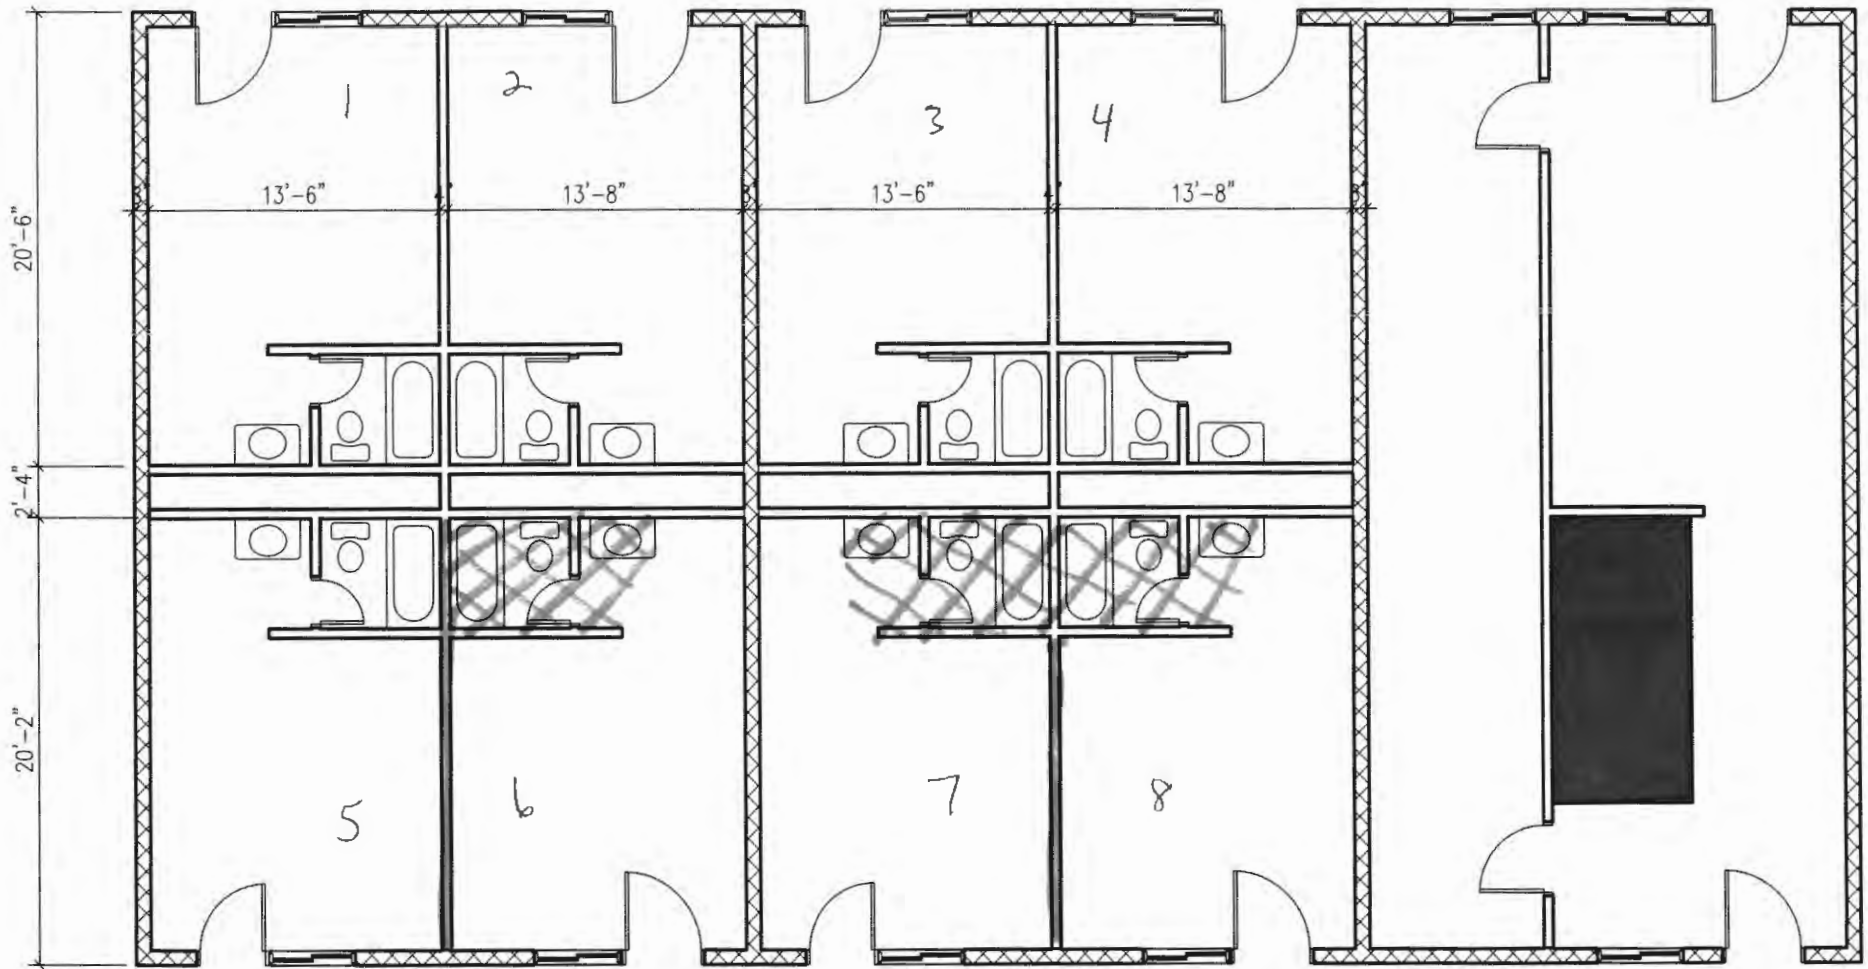




As is layout off the ROOM




-  Removing
-  CMU 8" BLOCK
-  METAL 2X4 AND SHEET ROCK

NEW LOOK ROOM

- CMU 8" BLOCK
- METAL 2X4 AND SHEET ROCK

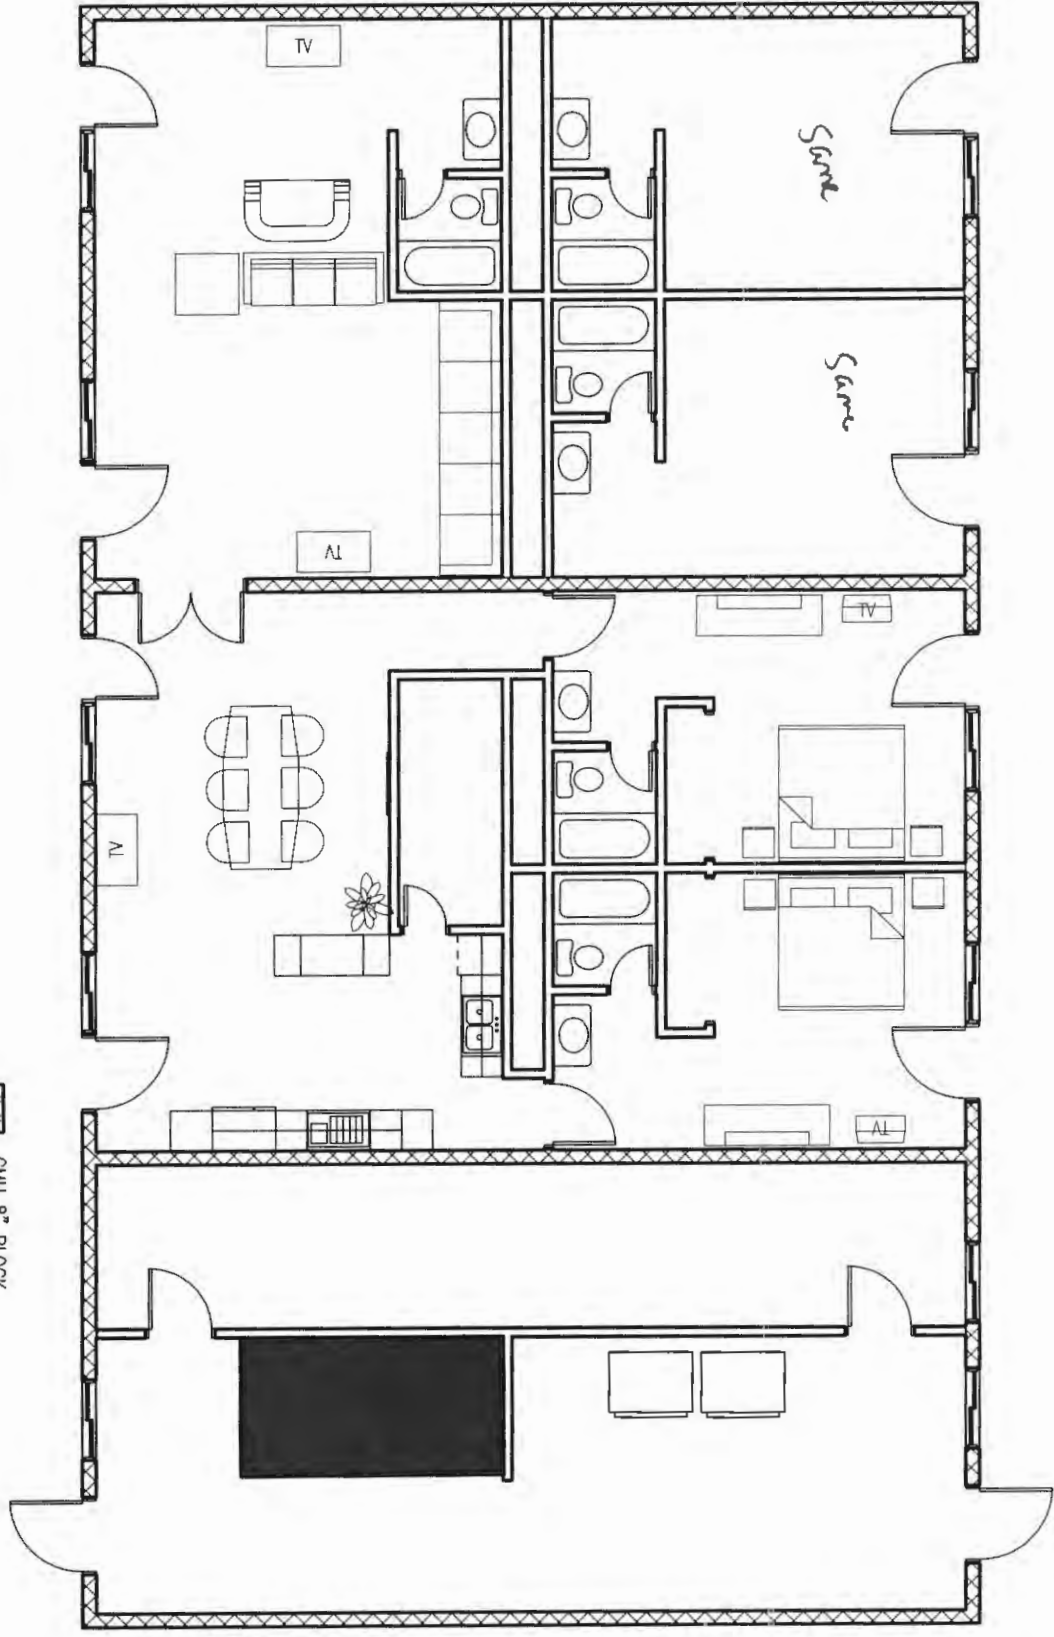



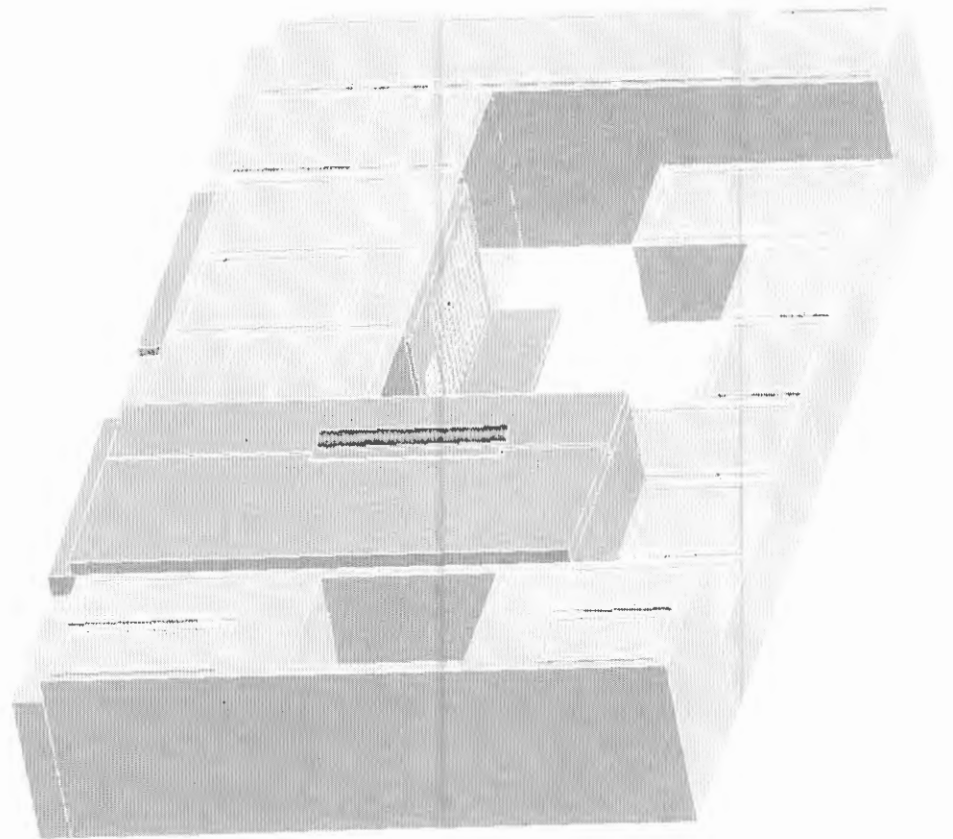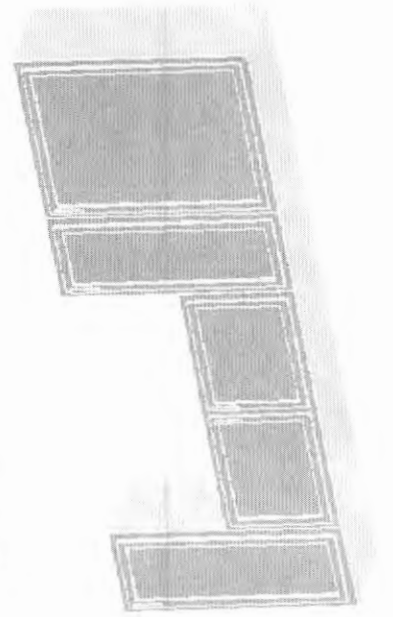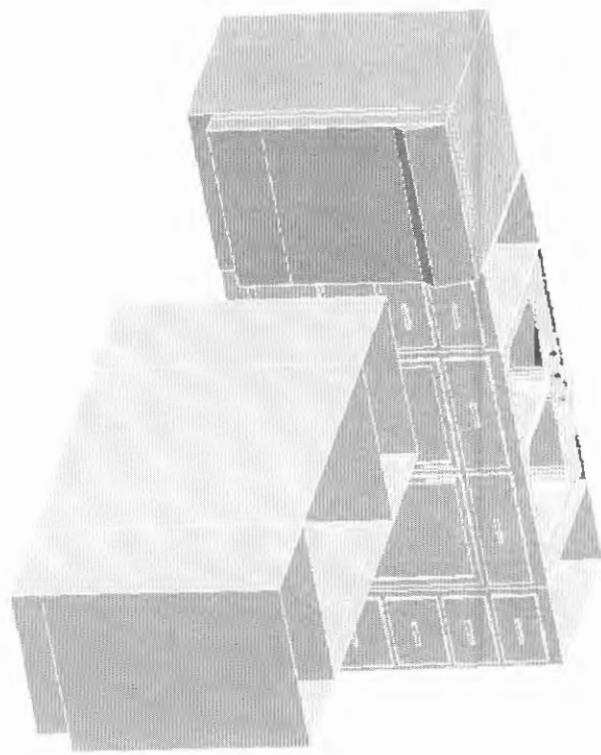



**Structural Steel Wide Flange Section Properties**  
**Moment of Inertia, Steel Beam Size, Cross Section Area**

Ads by Google

[Structural Materials Menu](#) | [Metal Products Supplier](#)  
[Engineering Materials Menu](#)


**Steel Flanges**

Choose From Wide Range of Flanges Visit Now & View Our Online Catalog  
[www.TexasFlange.com](http://www.TexasFlange.com)

Structural Steel Wide Flange (I Beam) Section Properties  
 Moment of Inertia, Steel Beam Size, Cross Section Area

**Steel I Beam Load Chart**

Find more sources/options for Steel I Beam Load Chart  
[www.webcrawler.com](http://www.webcrawler.com)

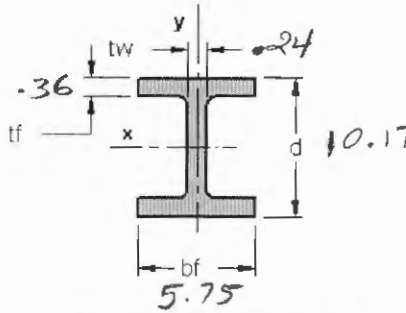

**NEMA 4x Enclosures**

Mounting Panel Incl. Great Prices & Free Shipping with \$300 Order!  
[IndustrialControlDirect.com](http://IndustrialControlDirect.com)

**I Beam Load**

Search Thousands of Catalogs for I Beam Load  
[www.globalspec.com](http://www.globalspec.com)

**Steel Specification Guide**

NEW update guidelines on AHSS steel information on forming auto parts  
[www.worldautosteel.org](http://www.worldautosteel.org)

**Applications and Design**

- [Engineering Analysis](#)
- [Engineering Basics](#)
- [Engineering Calculators](#)
- [Engineering Materials](#)

in x lb/ft	Area (in <sup>2</sup> )	d (in)	bf (in)	tf (in)	tw (in)	Ixx (in <sup>4</sup> )	Iyy (in <sup>4</sup> )
W12x336	98.8	16.82	13.385	2.955	1.775	4060	1190
W12x305	89.6	16.32	13.235	2.705	1.625	3550	1050
W12x279	81.9	15.85	13.14	2.47	1.53	3110	937
W12x252	74.1	15.41	13.005	2.25	1.395	2720	828
W12x230	67.7	15.05	12.895	2.07	1.285	2420	742
W12x210	61.8	14.71	12.79	1.9	1.18	2140	664
W12x190	55.8	14.38	12.67	1.735	1.06	1890	589
W12x170	50	14.03	12.57	1.56	0.96	1650	517
W12x152	44.7	13.71	12.48	1.4	0.87	1430	454
W12x136	39.9	13.41	12.4	1.25	0.79	1240	398
W12x120	35.3	13.12	12.32	1.105	0.71	1070	345
W12x106	31.2	12.89	12.22	0.99	0.61	933	301
W12x96	28.2	12.71	12.16	0.9	0.55	833	270
W12x87	25.6	12.53	12.125	0.81	0.515	740	241
W12x79	23.2	12.38	12.08	0.735	0.47	662	216
W12x72	21.1	12.25	12.04	0.67	0.43	597	195
W12x65	19.1	12.12	12	0.605	0.39	533	174
W12x58	17	12.19	10.01	0.64	0.36	475	107
W12x53	15.6	12.06	9.995	0.575	0.345	425	95.8
W12x50	14.7	12.19	8.08	0.64	0.37	394	56.3
W12x45	13.2	12.06	8.045	0.575	0.335	350	50
W12x40	11.8	11.94	8.005	0.515	0.295	310	44.1
W12x35	10.3	12.5	6.56	0.52	0.3	285	24.5
W12x30	8.79	12.34	6.52	0.44	0.26	238	20.3
W12x26	7.65	12.22	6.49	0.38	0.23	204	17.3
W12x22	6.48	12.31	4.03	0.425	0.26	156	4.66
W12x19	5.57	12.16	4.005	0.35	0.235	130	3.76
W12x16	4.71	11.99	3.99	0.265	0.22	103	2.82
W12x14	4.16	11.91	3.97	0.225	0.2	88.6	2.36
W10x112	32.9	11.36	10.415	1.25	0.755	716	236
W10x100	29.4	11.1	10.34	1.12	0.68	623	207
W10x88	25.9	10.84	10.265	0.99	0.605	534	179
W10x77	22.6	10.6	10.19	0.87	0.53	455	154
W10x68	20	10.4	10.13	0.77	0.47	394	134

1240 Brighton Ave.  
 we are using  
W10x22  
 Kamlesh Patel  
 207 807-1127

**Main Categories**

- Home
- Engineering Store
- Online Training Center
- PDH
- Products & Services
- Engineering Forum
- CAD Forum
- Engineering Design Data
- Engineering News
- Engineering Videos
- Engineering Calculators
- Industrial News Buzz
- Engineering Specifications
- Newsletter Register
- Advertise
- Feedback

Share |

Print Webpage

Sponsored Links

Foreign Exchange Trading  
 Free \$50,000 Practice Account  
 With Real-Time Charts, News & Research  
[www.Forex.com](http://www.Forex.com)

Search

What's New at Engineers Store?

Mailing Tube 25 x 2.5 Blue  
 36/box  
 \$159.95

- GD&T Training ASME Y14.5-2009
- DFM Training
- Copyright Notice

RECEIVED

OCT 18 2010

Dept. of Building Inspections  
 City of Portland Maine

W10x60	17.6	10.22	10.08	0.68	0.42	341	116
W10x54	15.8	10.09	10.03	0.615	0.37	303	103
W10x49	14.4	9.98	10	0.56	0.34	272	93.4
W10x45	13.3	10.1	8.02	0.62	0.35	248	53.4
W10x39	11.5	9.92	7.985	0.53	0.315	209	45
W10x33	9.71	9.73	7.96	0.435	0.29	170	36.6
W10x30	8.84	10.47	5.81	0.51	0.3	170	16.7
W10x26	7.61	10.33	5.77	0.44	0.26	144	14.1
W10x22	6.49	10.17	5.75	0.36	0.24	118	11.4
W10x19	5.62	10.24	4.02	0.395	0.25	96.3	4.29
W10x17	4.99	10.11	4.01	0.33	0.24	81.9	3.56
W10x15	4.41	9.99	4	0.27	0.23	68.9	2.89
W10x12	3.54	9.87	3.96	0.21	0.19	53.8	2.18
W8x67	19.7	9	8.28	0.935	0.57	272	88.6
W8x58	17.1	8.75	8.22	0.81	0.51	228	75.1
W8x48	14.1	8.5	8.11	0.685	0.4	184	60.9
W8x40	11.7	8.25	8.07	0.56	0.36	146	49.1
W8x35	10.3	8.12	8.02	0.495	0.31	127	42.6
W8x31	9.13	8	7.995	0.435	0.285	110	37.1
W8x28	8.25	8.06	6.535	0.465	0.285	98	21.7
W8x24	7.08	7.93	6.495	0.4	0.245	82.8	18.3
W8x21	6.16	8.28	5.27	0.4	0.25	75.3	9.77
W8x18	5.26	8.14	5.25	0.33	0.23	61.9	7.97
W8x15	4.44	8.11	4.015	0.315	0.245	48	3.41
W8x13	3.84	7.99	4	0.255	0.23	39.6	2.73
W8x10	2.96	7.89	3.94	0.205	0.17	30.8	2.09
W6x20	5.87	6.2	6.02	0.365	0.26	41.4	13.3
W6x16	4.74	6.28	4.03	0.405	0.26	32.1	4.43
W6x15	4.43	5.99	5.99	0.26	0.23	29.1	9.32
W6x12	3.55	6.03	4	0.28	0.23	22.1	2.99
W6x9	2.68	5.9	3.94	0.215	0.17	16.4	2.19
W5x19	5.54	5.15	5.03	0.43	0.27	26.2	9.13
W5x16	4.68	5.01	5	0.36	0.24	21.3	7.51
W4x13	3.83	4.16	4.06	0.345	0.28	11.3	3.86

**Steel Building Quotes**

Easily Compare Prices & Save. Find the Best Deal & Save Today!

**Currency Trading**

Free \$50,000 practice account with charts, news, research & analysis

© Copyright 2000 - 2010, by Engineers Edge, LLC All rights reserved.

Disclaimer



# CITY OF PORTLAND, MAINE

Department of Building Inspections

## Original Receipt

9-8 20 10

Received from Travell, Inc.

Location of Work 1200 Brighton

Cost of Construction \$ \_\_\_\_\_ Building Fee: 70

Permit Fee \$ \_\_\_\_\_ Site Fee: \_\_\_\_\_

Certificate of Occupancy Fee: 75

Total: 145

Building (I1) \_\_\_\_\_  Plumbing (I5) \_\_\_\_\_  Electrical (I2) \_\_\_\_\_  Site Plan (U2) \_\_\_\_\_

Other \_\_\_\_\_

CBL: 265-A 8

Check #: 115 Total Collected \$ 145

**No work is to be started until permit issued.  
Please keep original receipt for your records.**

Taken by: [Signature]

WHITE - Applicant's Copy  
YELLOW - Office Copy  
PINK - Permit Copy