

ALL DIMENSIONS ARE BASED ON 'AS-BUILT' DRAWINGS AS PROVIDED BY THE OWNER. ALL DIMENSIONS SHALL BE VERIFIED PRIOR TO CONSTRUCTION AND FABRICATION. DESIGN INTENT IS INDICATED ON DRAWINGS AND OVERALL INTENT IS TO ALIGN WITH THE EXISTING BUILDING AND THE BUILDING COMPONENTS: ROOF, WALLS, COLUMN GRID, ETC. UNLESS SPECIFICALLY INDICATED OTHERWISE. COORDINATE DIMENSIONS WITH ARCHITECT.

4N

NUDELL ARCHITECTS

31690 W. Twelve Mile Road
Farmington Hills, Michigan 48334
t 248 324 8800 f 248 324 5560

OFFICES IN

Dallas, Texas
972 387 5900

Orlando, Florida
407 740 9022

Costa Mesa, California
714 979 8100

Chicago, Illinois
312 258 1144

NOTICE

THIS ARCHITECTURAL AND/OR ENGINEERING DRAWING IS GIVEN IN CONFIDENCE. NO USE IN WHOLE OR PART MAY BE MADE WITHOUT PRIOR WRITTEN CONSENT OF NUDELL ARCHITECTS. ALL RIGHTS ARE HEREBY SPECIFICALLY RESERVED.

NUDELL ARCHITECTS
COPYRIGHT YEAR 2012

project title

EXISTING TSL BUILDING SHOWROOM ADDITION

PORTLAND, ME

sheet title

WALL SECTIONS

DO NOT SCALE DRAWINGS
USE FIGURED DIMENSIONS ONLY

project number
2008-279.06 (2008-279.03)


drawn JF/RC
checked BD
approved JHN

issued for date 10/2/11
OWNER REVIEW


PERMITS 03/16/12
PLANNING BOARD REVIEW 05/10/12
BULLETIN # 05/22/12
BULLETIN # 12/2/12

sheet


A310

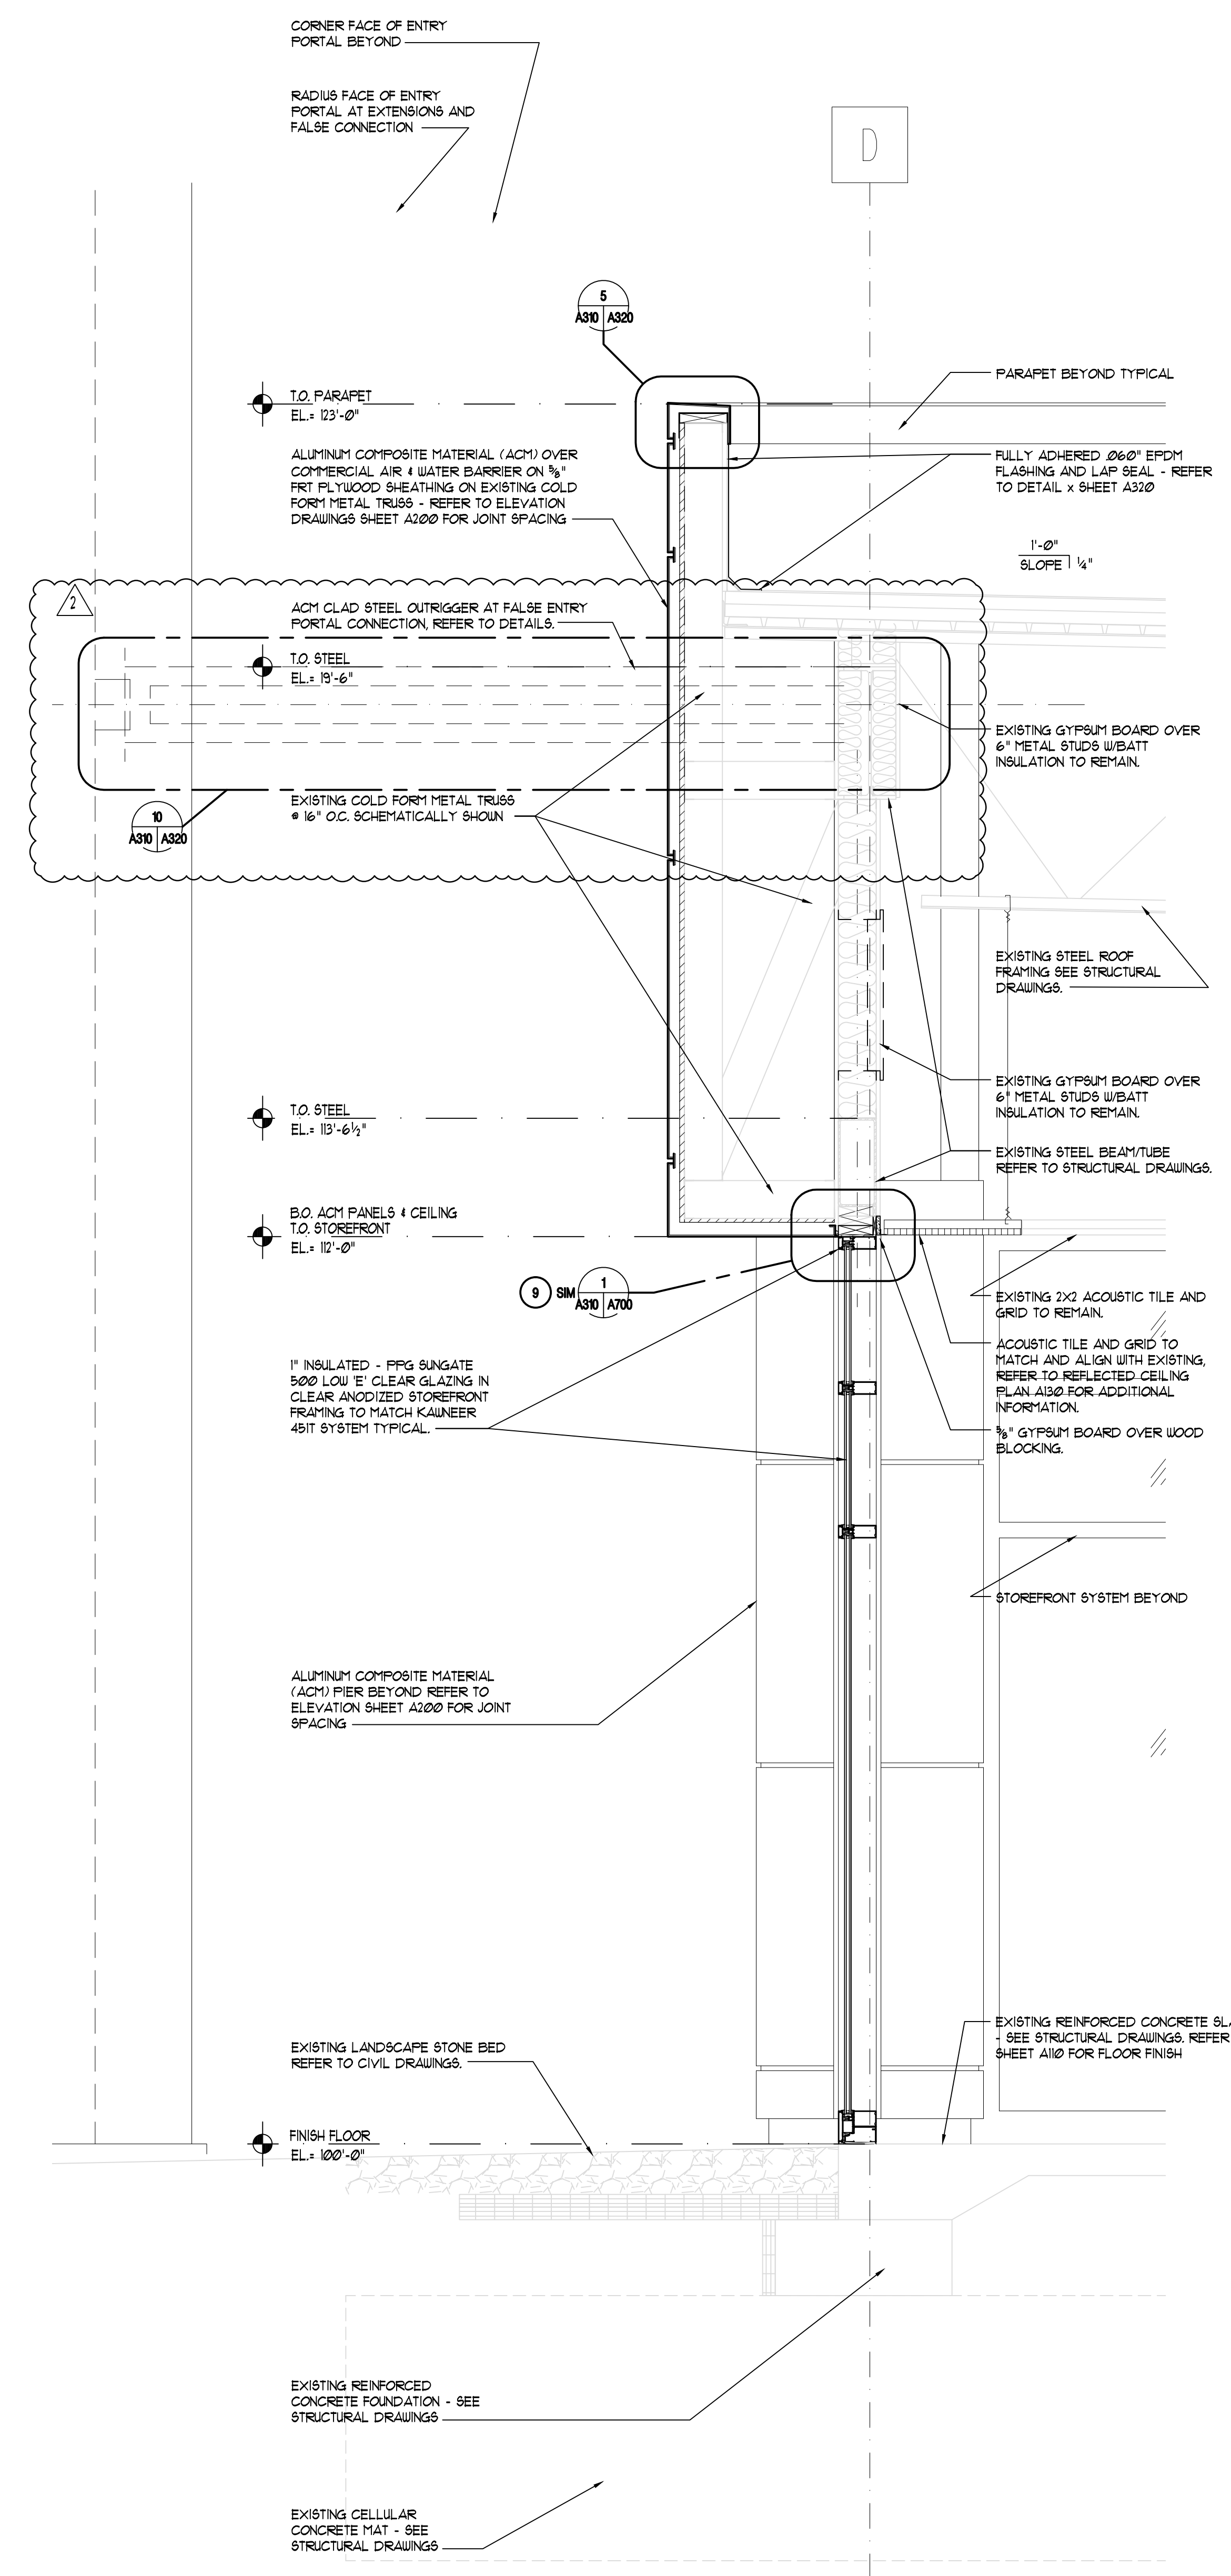

3 WALL SECTION
A300 A310 SCALE: 3/4" = 1'-0"

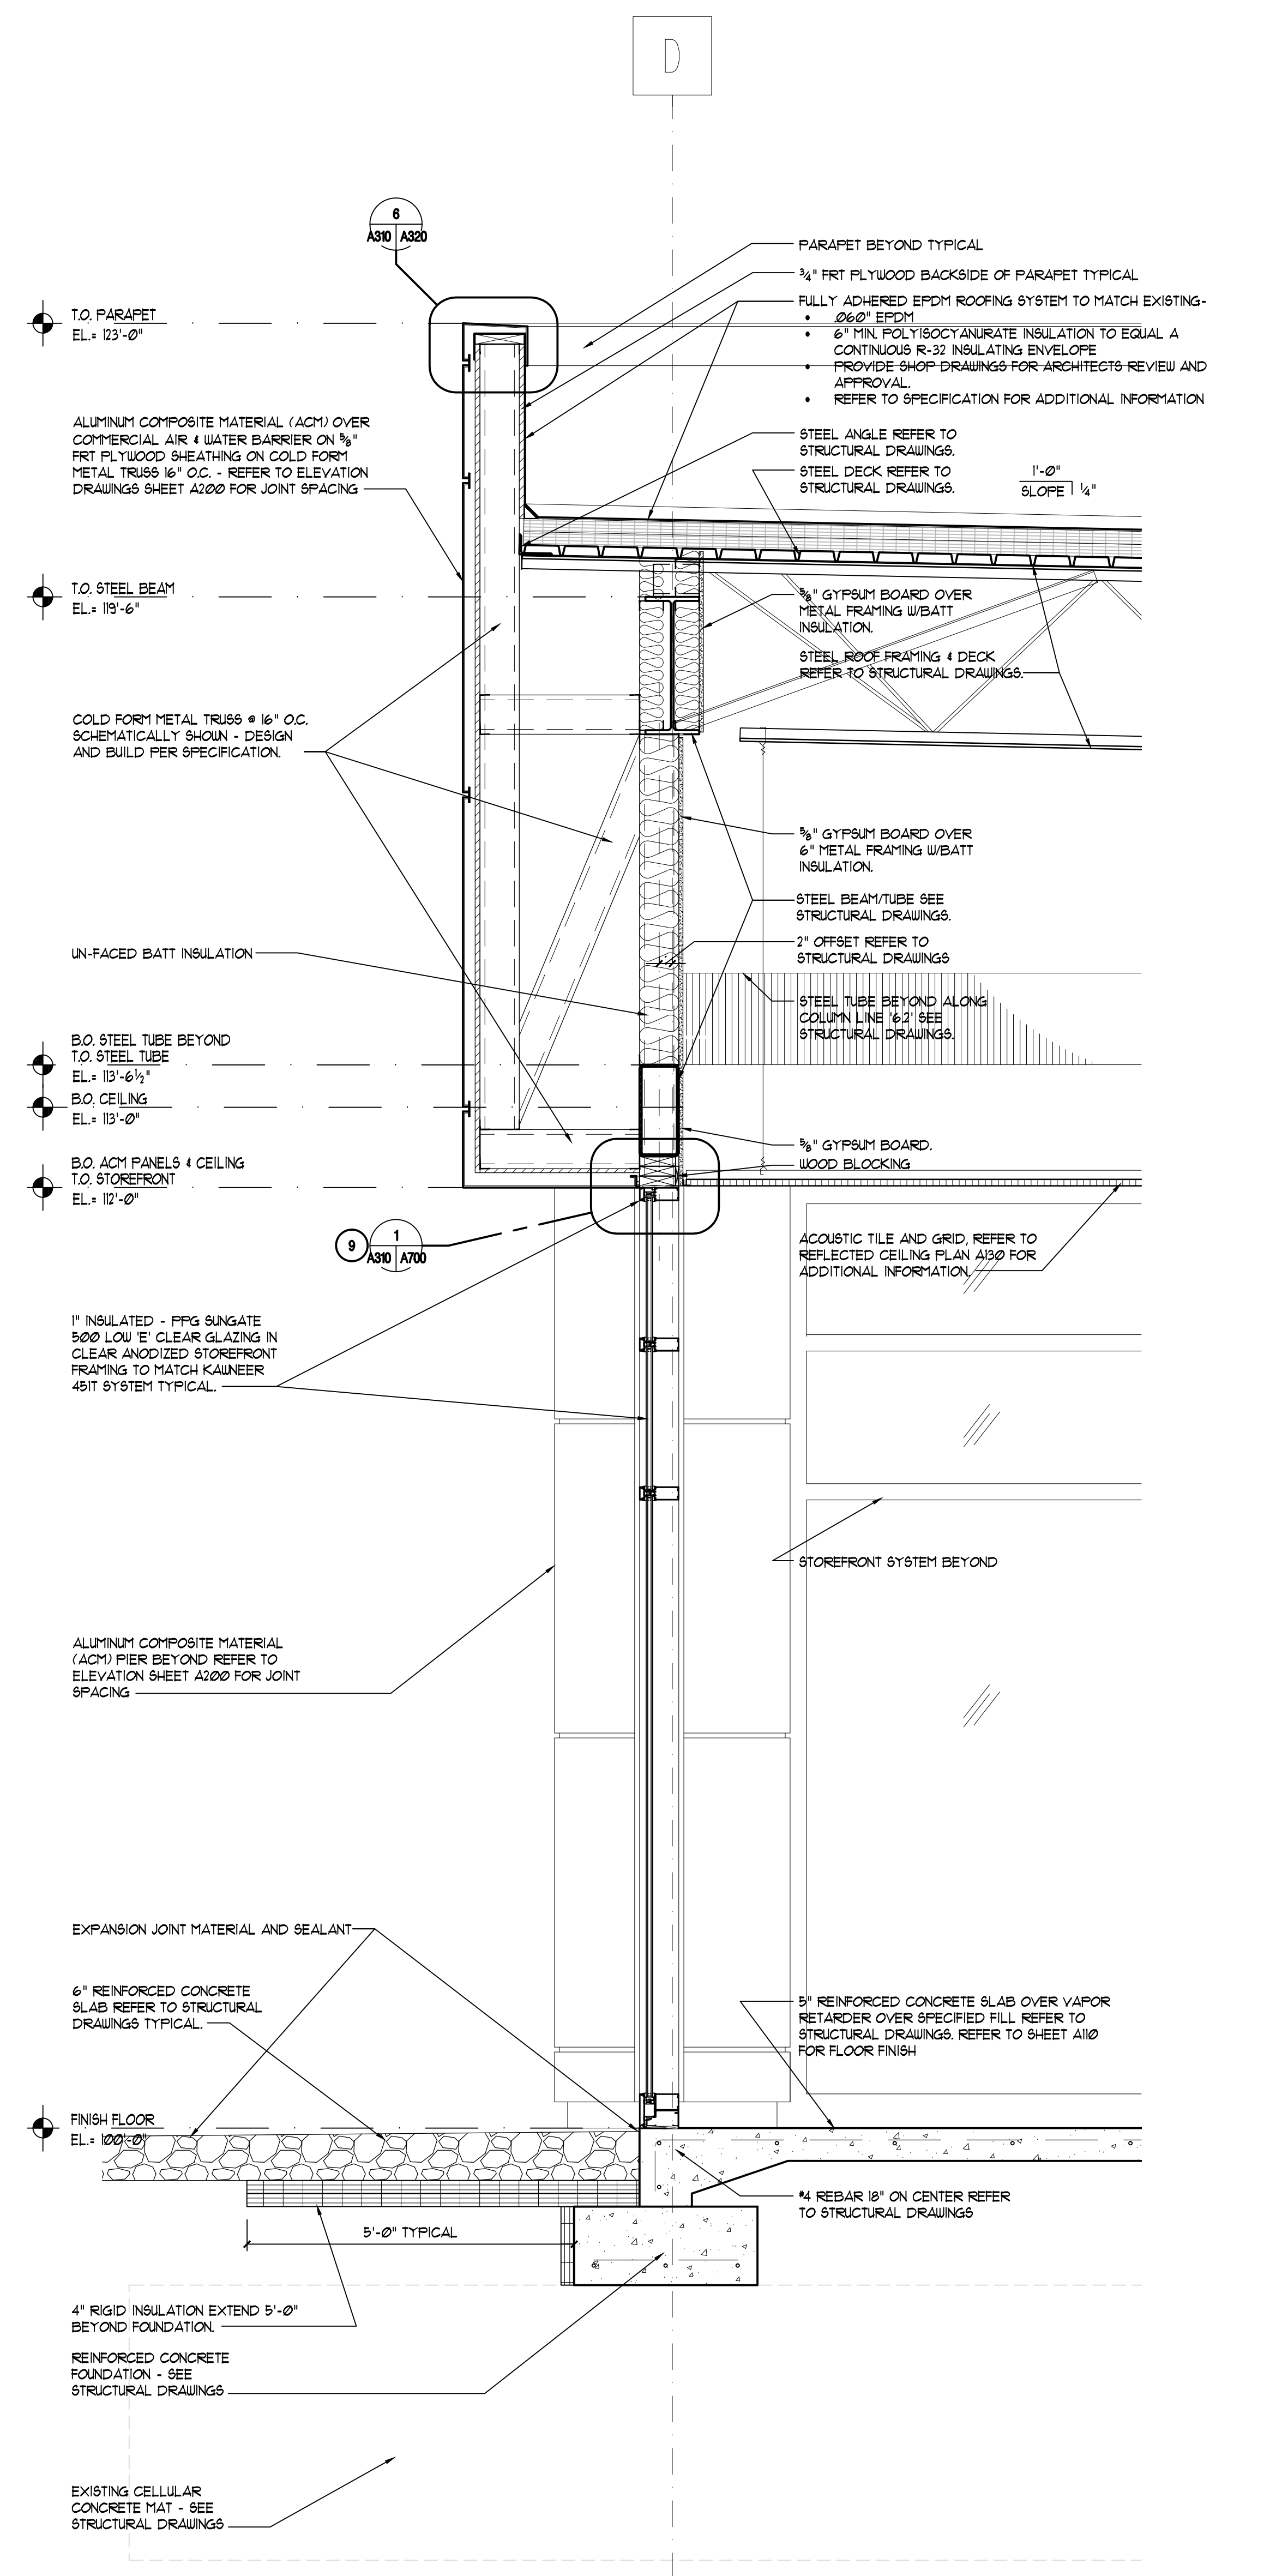

2 WALL SECTION
A300 A310 SCALE: 3/4" = 1'-0"

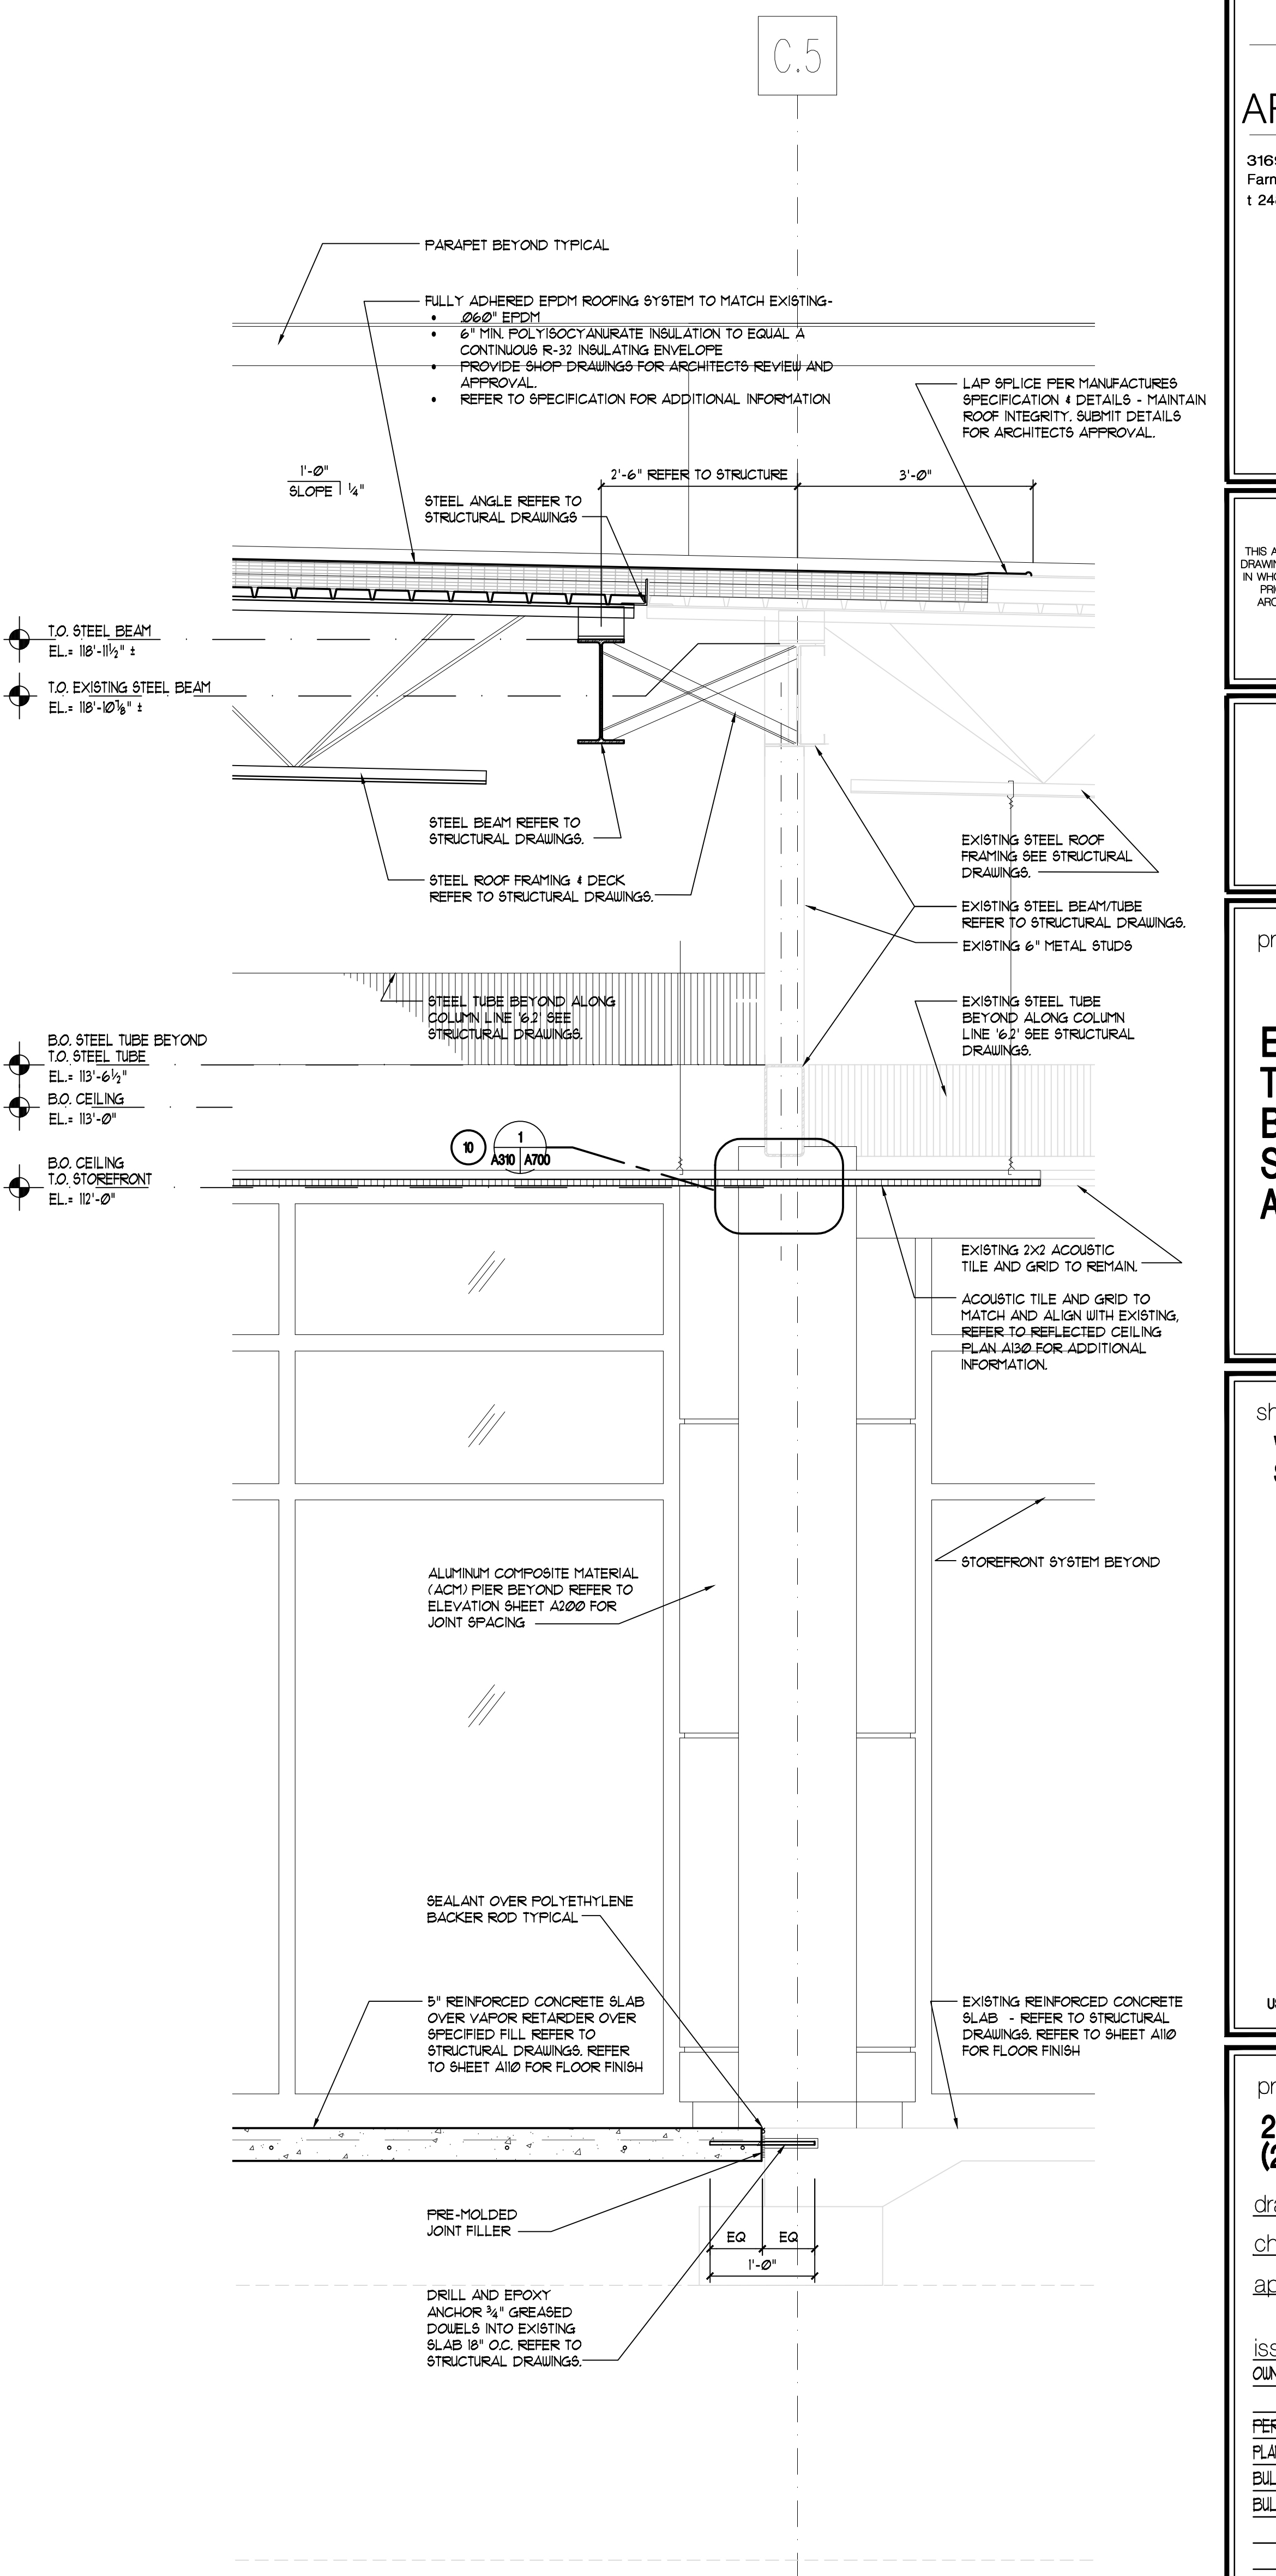

1 WALL SECTION
A300 A310 SCALE: 3/4" = 1'-0"