C'Amar CD all all	N.F. I				<u> </u>	PERMIT IS			
City of Portland,	<b>Maine - B</b>	<b>Suilding or Use</b>	Permi	t Application	n Pe	mit No: Issue 1	Date: 2001	CBL:	011001
389 Congress Street, 04101 Tel: (207) 874-8  Location of Construction: Owner Name		Owner Name:	5, 1 ax. (207) 674-671					268 A	311001
		H J Associates	es I td		Owner Address:  155 Riverside St. For Park LA		Phone: 207-774	5061	
1101250014		Contractor Name	······································		Contractor Address:		Phone	-3801	
n/a Amerail Syste		les			2301A West 12th Street Erie		8144568221		
Lessee/Buyer's Name Phone:					Permit Type:		Zone: /		
n/a n/a				Building Miscellaneous			B4		
Past Use: Proposed Use:				Perm	it Fee: Cost of	Work:	CEO District:	<del>' '</del>	
Commercial / Hotel Same: 1			Replace Existing Balcony			\$276.00 , \$4	2,000.00		
		and Hand-Rail	ls					PECTION:	
						Denied	Use	Group: R-1 PERMITISSUED PURECUREMENTS	Type:
Proposed Project Descrip	tion:		<del></del>				""		1 10
Replace existing balc		Irails			Signar PEDE	ture: JUNY STRIAN ACTIVITIES I	Sign	(P.A.D.)	Affar
					Action		Approved	w/Conditions	Denied
Permit Taken By:	Det	e Applied For:	<u> </u>		Signa			Date:	
cih		5/21/2001				Zoning Appro	oval		
			Spe	cial Zone or Revie	ws	Zoning Appea	1	Historic Pre	correction
1. This permit application does not preclude the Applicant(s) from meeting applicable State and Federal Rules.			Shoreland		☐ Variance				
<ol> <li>Building permits do not include plumbing, septic or electrical work.</li> </ol>		☐ Wetland		☐ Miscellaneous		Does Not Require Review			
3. Building permits are void if work is not started within six (6) months of the date of issuance. False information may invalidate a building permit and stop all work		Flood Zone			Conditional Use		Requires Review		
		Subdivision		Interpretation			Approved		
			☐ Sit	e Plan		Approved		Approved w	'Conditions
			Maj [	Minor MM	) 7	Denied		Denied	
			Date:	5/3/10		Date:		Date:	$\supset$
				2/1/19				PERMIT ISSUED TH REQUIREMENTS	}
I hereby certify that I a I have been authorized jurisdiction. In additio shall have the authority such permit.	n, if a permit	r to make this application of the control of the co	med procation a	s his authorized application is is:	e prop agent	and I agree to confor I certify that the code	rm to all	applicable laws	of this
SIGNATURE OF APPLICA	ANT			ADDRESS		DA	ATE	РНО	NE
RESPONSIBLE PERSON	N CHARGE OF	F WORK, TITLE	<u></u>			DA	ATE	РНО	NE

## THIS IS NOT A PERMIT/CONSTRUCTION CANNOT COMMENCE UNTIL THE PERMIT IS ISSUED

# All Purpose Building Permit Application

If you or the property owner owes real estate or personal property taxes or user charges on any property within the City, payment arrangements must be made before permits of any kind are accepted.

Location/Address of Construction: 155	Riverside	,		
Total Square Footage of Proposed Structure	Square Footage of Lot			
Tax Assessor's Chart, Block & Lot Number Chart# 268 Block# A Lot# 1	Owner: HJ Associates 155 Riverside Street Portland Me. 04103	Telephone#: (207) 774-586]		
Lessee/Buyer's Name (If Applicable)	Wo	st Of ork: Fee: 276, a 12,000 \$		
Current use: Hotel				
If the location is currently vacant, what was prior use: Approximately how long has it been vacant:				
Proposed use: unchanged				
Project description: Replace ex	risting balcony with	new,		
Contractor's Name, Address & Telephone.	Imerail Systems Inc. 301A west 12th street rie PA 16505-4539 (	BIU) 4 <b>5</b> 6 - 8221		
4 Cedar Lane Windham Me 04062 892-3846				
Who should we contact when the permit is rea Telephone: Pay 774-5861 E	dy: Mark Kinne Eves, 892-3846			
If you would like the permit mailed, what mai	ling address should we use:	5/21		
		Rec'd By: CH		
		· · · · · · · · · · · · · · · · · · ·		

#### BUILDING PERMIT REPORT

BUILDING PERMIT REPORT
DATE: 25 MAY 266   ADDRESS: 155 RIVERSIDE STREET CBL: 268-A-\$1)
REASON FOR PERMIT: Replace balconies chandrails
BUILDING OWNER: H. J. ASSOCIATES ITA.
PERMIT APPLICANT: ICONTRACTOR AMERICA SYSTEMS INC.
USE GROUP: R-1 CONSTRUCTION TYPE: CONSTRUCTION COST: 42,000 PERMIT FEES: 276.00
The City's Adopted Building Code (The BOCA National Building Code/1999 with City Amendments) The City's Adopted Mechanical Code (The BOCA National Mechanical Code/1993)
CONDITION(S) OF APPROVAL
This permit is being issued with the understanding that the following conditions shall be met: */*// *38

1. This permit does not excuse the applicant from meeting applicable State and Federal rules and laws.

 Before concrete for foundation is placed, approvals from the Development Review Coordinator and Inspection Services must be obtained. (A 24 hour notice is required prior to inspection) "ALL LOT LINES SHALL BE CLEARLY MARKED BEFORE CALLING."

3. Foundation drain shall be placed around the perimeter of a foundation that consists of gravel or crushed stone containing not more than 10 percent material that passes through a No. 4 sieve. The drain shall extend a minimum of 12 inches beyond the outside edge of the footing. The thickness shall be such that the bottom of the drain is not higher than the bottom of the base under the floor, and that the top of the drain is not less than 6 inches above the top of the footing. The top of the drain shall be covered with an approved filter membrane material. Where a drain tile or perforated pipe is used, the invert of the pipe or tile shall not be higher than the floor elevation. The top of joints or top of perforations shall be protected with an approved filter membrane material. The pipe or tile shall be placed on not less than 2" of gravel or crushed stone, and shall be covered with not less than 6" of the same material. Section 1813.5.2

Foundations anchors shall be a minimum of 1/2" in diameter, 7" into the foundation wall, minimum of 12" from corners of foundation and a

maximum 6' O.C. between bolts. <u>Section 2305.17</u>
5. Waterproofing and dampproofing shall be done in accordance with <u>Section 1813.0</u> of the building code.

6. Precaution must be taken to protect concrete and masonry. Concrete Sections 1908.9-19.8.10/ Masonry Sections 2111.3-2111.4.

It is strongly recommended that a registered land surveyor check all foundation forms before concrete is placed. This is done to verify that the

proper setbacks are maintained.

8. Private garages located beneath habitable rooms in occupancies in Use Group R-1, R-2, R-3 or I-1 shall be separated from adjacent interior spaces by fire partitions and floor/ceiling assembly which are constructed with not less than 1-hour fire resisting rating. Private garages attached side-by-side to rooms in the above occupancies shall be completely separated from the interior spaces and the attic area by means of ½ inch gypsum board or the equivalent applied to the garage side. (Chapter 4, Section 407.0 of the BOCA/1999)

All chimneys and vents shall be installed and maintained as per Chapter 12 of the City's Mechanical Code. (The BOCA National Mechanical

Code/1993). Chapter 12 & NFPA 211

10. Sound transmission control in residential building shall be done in accordance with Chapter 12, Section 1214.0 of the City's Building Code.

11. Guardrails & Handrails: A guardrail system is a system of building components located near the open sides of elevated walking surfaces for the purpose of minimizing the possibility of an accidental fall from the walking surface to the lower level. Minimum height all Use Groups 42". In occupancies in Use Group A, B.H-4, I-1, I-2, M, R, public garages and open parking structures, open guards shall have balusters or be of solid material such that a sphere with a diameter of 4" cannot pass through any opening. Guards shall not have an ornamental pattern that would provide a ladder effect. Handrails shall be a minimum of 34" but not more than 38". Exception: Handrails that form part of a guard shall have a height not less than 36 inches (914 mm) and not more than 42 inches (1067 mm). Handrail grip size shall have a circular cross section with an outside diameter of at least 1 ¼" and not greater than 2". (Sections 1021 & 1022.0). Handrails shall be on both sides of stairway. (Section 1014.7)

12. Headroom in habitable space is a minimum of 7'6". (Section 1204.0)

13. Stair construction in <u>Use Group R-3 & R-4 is a minimum of 10" tread and 7 %" maximum rise.</u> All other Use Group minimum 11" tread, 7" maximum rise. (Section 1014.0)

14. The minimum headroom in all parts of a stairway shall not be less than 80 inches. (6'8") 1014.4

- 15. The Minimum required width of a corridor shall be determined by the most restrictive of the criteria under section 1011.3 but not less then 36".
- 16. Every sleeping room below the fourth story in buildings of Use Groups R and I-1 shall have at least one operable window or exterior door approved for emergency egress or rescue. The units must be operable from the inside without the use of special knowledge or separate tools. Where windows are provided as means of egress or rescue they shall have a sill height not more than 44 inches (1118mm) above the floor. All egress or rescue windows from sleeping rooms shall have a minimum net clear opening width dimension shall be 20 inches (508)mm, and a minimum net clear opening of 5.7 sq. ft. (Section 1010.4)

17. Each apartment shall have access to two (2) separate, remote and approved means of egress. A single exit is acceptable when it exits directly

from the apartment to the building exterior with no communications to other apartment units. (Section 1010.1)

18. All vertical openings shall be enclosed with construction having a fire rating of at least one (1) hour, including fire doors with self closure's. (Over 3 stories in height requirements for fire rating is two (2) hours. (Section 710.0)

19. The boiler shall be protected by enclosing with (1) hour fire rated construction including fire doors and ceiling, or by providing automatic extinguishment. (Table 302.1.1)

- 20. All single and multiple station smoke detectors shall be of an approved type and shall be installed in accordance with the provisions of the City's Building Code Chapter 9, Section 920.3.2 (BOCA National Building Code/1999), and NFPA 101 Chapter 18 & 19. (Smoke detectors shall be installed and maintained at the following locations):
  - In the immediate vicinity of bedrooms
  - In all bedrooms

• In each story within a dwelling unit, including basements

- 21. A portable fire extinguisher shall be located as per NFPA #10. They shall bear the label of an approved agency and be of an approved type. (Section 921.0)
- 22. The Fire Alarm System shall be installed and maintained to NFPA #72 Standard.
- 23. The Sprinkler System shall be installed and maintained to NFPA #13 Standard.
- 24. All exit signs, lights and means of egress lighting shall be done in accordance with Chapter 10 Section & Subsections 1023.0 & 1024.0 of the City's Building Code. (The BOCA National Building Code/1999)
- 25. Section 25 135 of the Municipal Code for the City of Portland states, "No person or utility shall be granted a permit to excavate or open any street or sidewalk from the time of November 15 of each year to April 15 of the following year".
- 26. The builder of a facility to which Section 4594-C of the Maine State Human Rights Act Title 5 MRSA refers, shall obtain a certification from a design professional that the plans commencing construction of the facility, the builder shall submit the certification the Division of Inspection Services.
- 27. Ventilation and access shall meet the requirements of Chapter 12 Sections 1210.0 and 1211.0 of the City's Building Code. (Crawl spaces & attics).
- 28. All electrical, plumbing and HVAC permits must be obtained by Master Licensed holders of their trade. No closing in of walls until all electrical (min. 72 hours notice) and plumbing inspections have been done.
- 29. All requirements must be met before a final Certificate of Occupancy is issued.
- 30. All building elements shall meet the fastening schedule as per Table 2305.2 of the City's Building Code (The BOCA National Building Code/1996).
- 31. Ventilation of spaces within a building shall be done in accordance with the City's Mechanical code (The BOCA National Mechanical Code/1993). (Chapter M-16)
- 32. Please read and implement the attached Land Use Zoning report requirements.
- 33. Boring, cutting and notching shall be done in accordance with Sections 2305.3, 2305.3.1, 2305.4.4 and 2305.5.1 of the City's Building Code.
- 34. Bridging shall comply with Section 2305.16.
- 35. Glass and glazing shall meet the requirements of Chapter 24 of the building code. (Safety Glazing Section 2406.0)

36. All flashing shall comply with Section 1406.3.10.

38 Loads on handrails quands, grub bars shall comply with Sections of the bldg. Code and section 4.4 of ASSE 7-	c/1999).	
	16d6.	ç, c
THE THE BLOOK HOUSE CASIA DECLIBER OF STORE PLACE TO THE		7

Lightses, Building Inspector Light McDougall, PFD

Marge Schmuckal, Zoning Administrator Michael Nugent, Inspection Service Manager


PSH 10/1/00

\*\*This permit is herewith issued, on the basis of plans submitted and conditions placed on these plans, any deviations shall require a separate approval.

\*\*\*THIS PERMIT HAS BEEN ISSUED WITH THE UNDERSTANDING THAT ALL THE CONDITIONS OF THE APPROVAL SHALL BE COMPLETED. THEREFORE, BEFORE THE WORK IS COMPLETED A REVISED PLAN OR STATEMENT FROM THE PERMIT HOLDER SHALL BE SUBMITTED TO THIS OFFICE SHOWING OR EXPLAINING THAT THE CONDITIONS HAVE BEEN MET. IF THIS REQUIREMENT IS NOT RECEIVED YOUR CERTIFICATE OF OCCUPANCY SHALL BE WITHHELD. (You Shall Call for Inspections)

\*\*\*\*ALL PLANS THAT REQUIRE A PROFESSIONAL DESIGNER'S SEAL, (AS PER SECTION 114.0 OF THE BUILDING CODE) SHALL ALSO BE PRESENTED TO THIS DIVISION ON AUTO CAD LT. 2000, DXF FORMAT OR EQUIVALENT.

\*\*\*\*\*CERTIFICATE OF OCCUPANCY FEE \$50.00

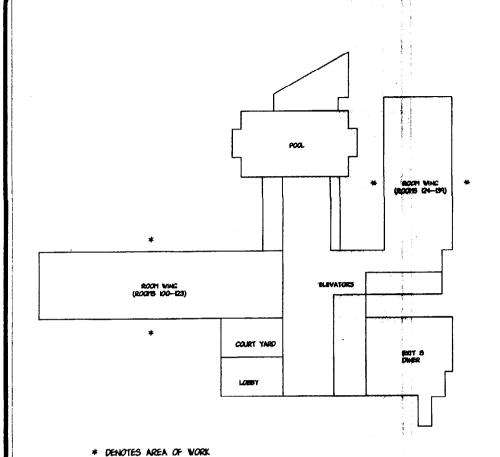


### SCOPE OF WORK:


) REMOVE AND DIPOSE OF BALCONY PAILING AT ALL BALCONY LOCATIONS 2.) INSTALL AMERAIL'S BALCONY PICKE RAILING AT ALL BALCONY LOCATIONS.

#### DRAWING INDEX

A-I TITLE SHEET A-1 TITLE SHEET
A-2 TYPICAL ROOM FRONT ELEVATION
WITH RULING
A-3 BALCONY FLAN VIEWS &
BEVATIONS
A-4 BALCONY CETAILS

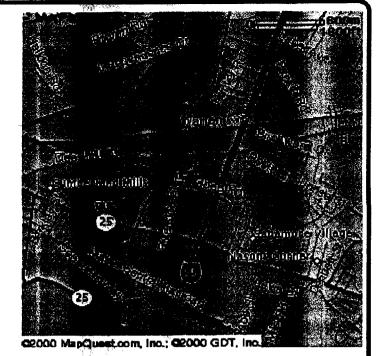

ABBREVIATIONS

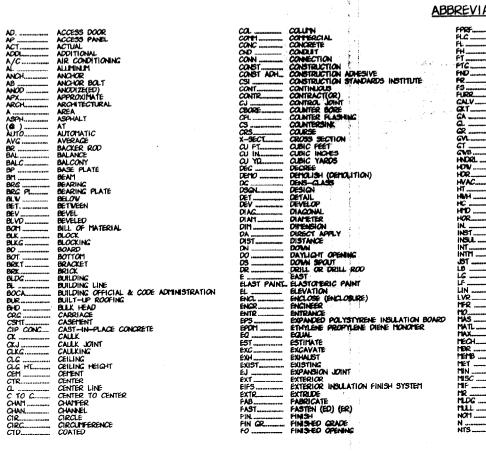

AU	<u>UNO</u>		
	FIREPROOF	NO	NUMBER
		AC.	AN OFNITFO
	FLASHING	OVJ	OPEN WEB JOIST OPENING OPPOSITE
*******	FLAT HEAD	OPNG	OPENING
	FOOT /FEET	OPP	OPPOSITE .
	FOOTING	OPT	OPTIONAL
	FOUNDATION	ORIG	ORIGINAL
	FRANE(ED)(ING) FRANE SIZE	OA	OVERALL
	FRAME SIZE	PNL	PANEL
	FLIRRED /FLIRRING	PARPERIM	PARALLEL
	CALVANIZED	PERIM	PERINETER
	CASKET	PERM	PERPENDICULAR
	GAUCE	Pt-10	PERPENDICULAR
	GLASS/GLAZING	PTH	PHILIPS FLAT HEAD PHILIPS PAN HEAD PHILIPS WASHER HEAD
	CRADE (CRADING)	PPH	PHILLIPS PAN HEAD
	GRAVEL	PWH	PHILLIPS WASHER HEAD
	CROUT	PL	PLATE PLYWOOD POLYVINML CHORIDE
	GYPSUM WALL BOARD	PLYVD	PLYW000
	HANDRAIL	PVC	POLTVINTL CHLORIDE
*******	HARDVARE	PDA	POWDER DRIVEN ANCHOR
	HEADER	PC CONC	POWDER DRIVEN ANCHOR PRECAST CONCRETE PLASTER OPENING
	HEATING, VENTILATION & AIR CONDITIONING	PO	PLASTER OPENING
	HEIQHT	PREFAB	PREFABRICATED PREFINISHED
	HEX WASHER HEAD	PREFIN	PREFINISHED
	HOLLOW CORE	PRELIM	PRELIMINARY
	HOLLOW METAL DOOR	PT	PRESSURE TREATED
	HORIZONTAL	PROD	PRODUCTION
	INCHES	RLG	RAILING
	INSTALL(ATION)	RIG	REFLECTED
	INSULATION	REINF	REINFORCED/REINFORCING
	INTERIOR	RECTO	REINFORCED/REINFORCING REQUIRED
	INTERMEDIATE	RET	RETURN REVISION/REVISED
	J0151	REV	REVISION/REVISED
	LAG BOLT	R	RISER RIVET/RIVETED ROOF DRAIN ROOFING
	LENGTH	RIV	RIVET/RIVETED
	LINEAL FEET	Ø	ROOF DRAIN
***	LINEAR	KP G	RECOPING
	LOUMER	RO	ROUGH CHENING
	MANUFACTURER	RUB	ROUGH OPENING RUBBER SAFETY GLASS
	MASONRY OPENING	9FQL	SAFETY GLASS
	MASONRY	5C	SCALE
	MATERIAL	3CH	SCHELULE
	MAXUMUM	SCR	SCREV
	MECHANICAL/MECHANICALLY	SNT SECT	SEALANI
	MEMBER	SECT	SECTION
	MEMBRANE	SHITHG	SHEATHING
	METAL	SH	SHEET
	MINIMUM	Sim	SIMILAR
	MISCELLANEOUS	SLV	SLEEVE
	MODIFY IN FIELD	SLV SLOT	SLOTTED
	MOISTURE RESISTANT	SLHWH	SLOTTED HEX WASHER HE
	MOLDING	5	SOUTH
	MULLION	SPEC	SLOTTED HEX WASHER HE SOUTH SPECIFICATION(S)
	NOMINAL.	SQ FT	SQUARE FOOT SQUARE INCH
**********	NORTH	SQ IN	SQUARE INCH
************	NOT TO SCALE	SO YD	SOLIARE YARD

STAINLESS STEEL
STAIRS
STAINARD
STAINARD BUILDING CODE
STANDARD BUILDING CODE
STANDARD BUILDING CODE
CONFERENCE INTERNATIONAL
STEEL
STEEL FLATE
STEEL FLATE
STEICTURAL
SUPPORT
SUPPORT
THE AND GRAVEL
TONGLE AND GROOVE
THESHOLD
THROUGH
TOP OF FOOTING
TOP OF SLAB
TRAISON
TREAD
TUBING
TYPICAL
VAPOR BURRIER
VENET
VATER RESISTANT
V 

SYMBOLS Willia-- SIFS (FOAH) --- SHEET NUMBER - CONCRETE - SYMPLETIC STUCCO CLADDING LABEL TAG - SHINGLE ROOF



2301-A WEST 12TH STREET
ERIE, PA 18505
PHONE (814) 456-221
FACSIMILE (814) 456-7725
WEBSITE AMERALSYS.COM

NOSNHON PORTLAND, MAINE HOWARD

TITLE SPEET

Contents:

CONFIDENTIAL CONI-IDEN ITAL
THESE PLANS, PRODUCT
DETAILS & DESIGNS ARE
THE PROPERTY OF
THE PROPERTY OF
THE PROSONAL USE OF
OUR CUSTOMER. PLANS,
DESIGNS & PRODUCTS ARE
NOT TO SE REPRODUCED
IN ANY WAY WITHOUT
WRITTEN CONSENT. OF
AMERAL SYSTEMS, INC.

Owner's

Revisions: MARK DESCRIPTION DATE

Scole: N/A Drawn By: JRH Approved By:

,109A-1



TYP. ROOMFRONT ELEVATION
WITH RAILING

A2 SCHE 1/2"-1-0"

HOWARD JOHNSON PORTLAND, MAINE

TYP. ROOMFRONT BLEV. WITH RALING

CONFIDENTIAL
THESE PLANS, PRODUCT
DETALS & DESIGNER ARE
THE PROPERTY OF
AMERICA, SYSTEMS, NC.
THEY ARE INTENDED FOR
THE PERSONAL USE OF
OUR CUSTOMER, PLANS,
NOT TO BE REPRODUCED
IN ANY WAY WITHOUT
WRITTEN CONSENT OF
AMERICAL SYSTEMS, INC. Owner's Approval:


DATE:

Revisions: MARK DESCRIPTION DATE

Scale: 1/2"=1'-0"

Drawn By: LAC Approved By:

.109A-2

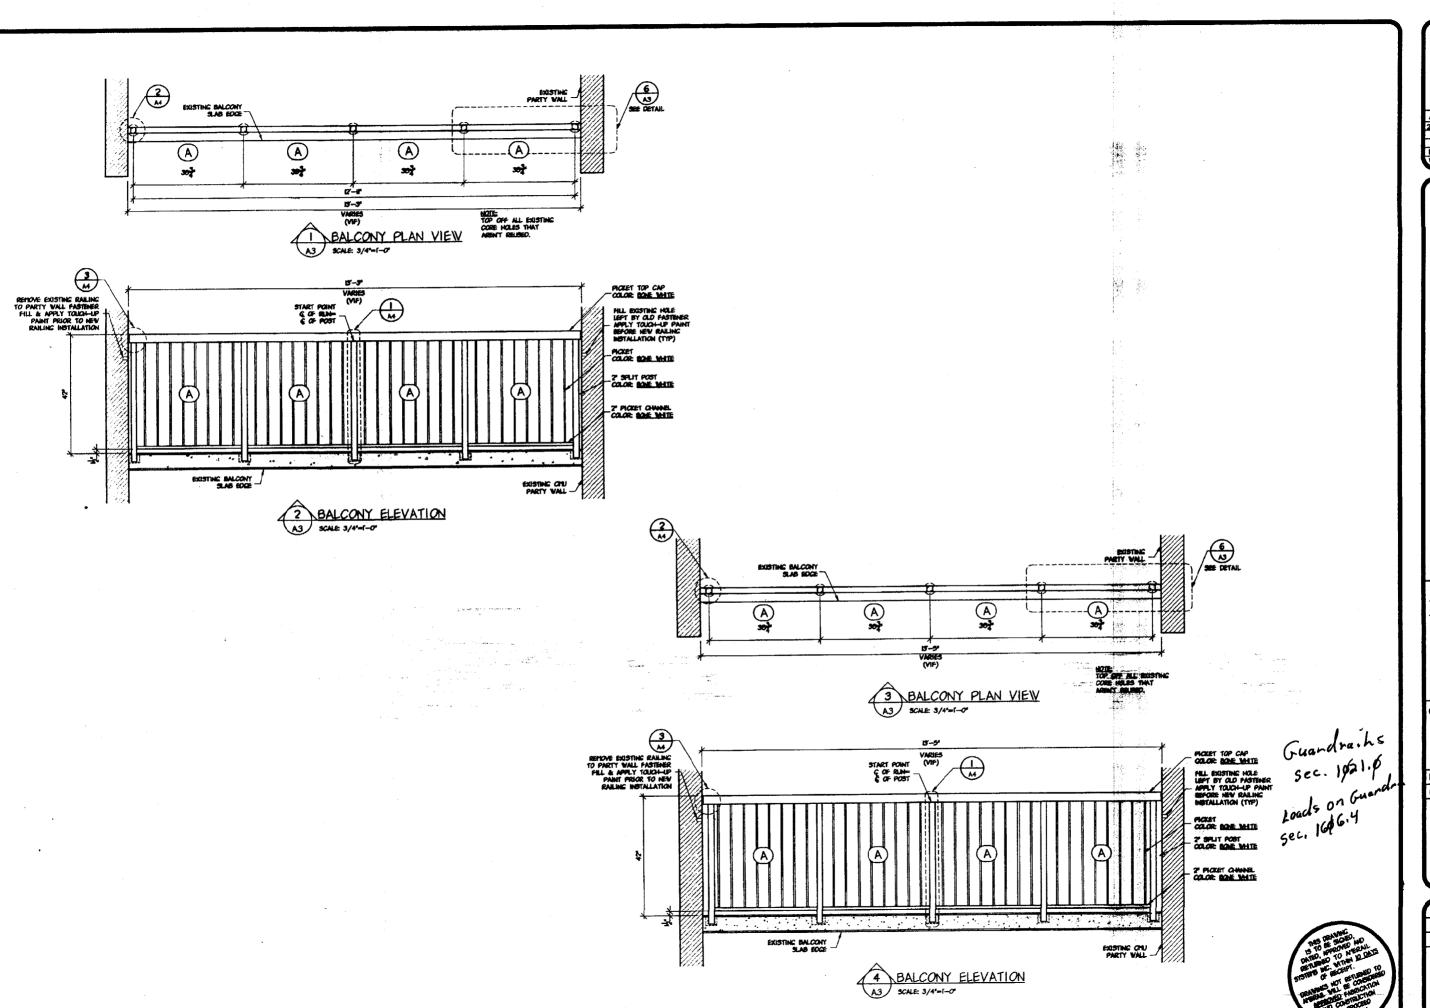



BALCONY PLAN VEWS & ELEVATIONS

HOWARD JOHNSON PORTLAND, MAINE

CONFIDENTIAL
THESE PLANS, PRODUCT
DETALS & DESIGNS APE
THE PROPERTY, INC.
THEY ARE INTENDED FOR
THE PERSONAL USE OF
OUR CUSTOMER, PLANS,
DESIGNS & PRODUCTS ARE


Owner's Approval:

DATE: Revisions:

MARK DESCRIPTION DATE

Scale: 3/4"=1"-0" Drawn By: JRH Approved By: Drawing Number:

.109A-3

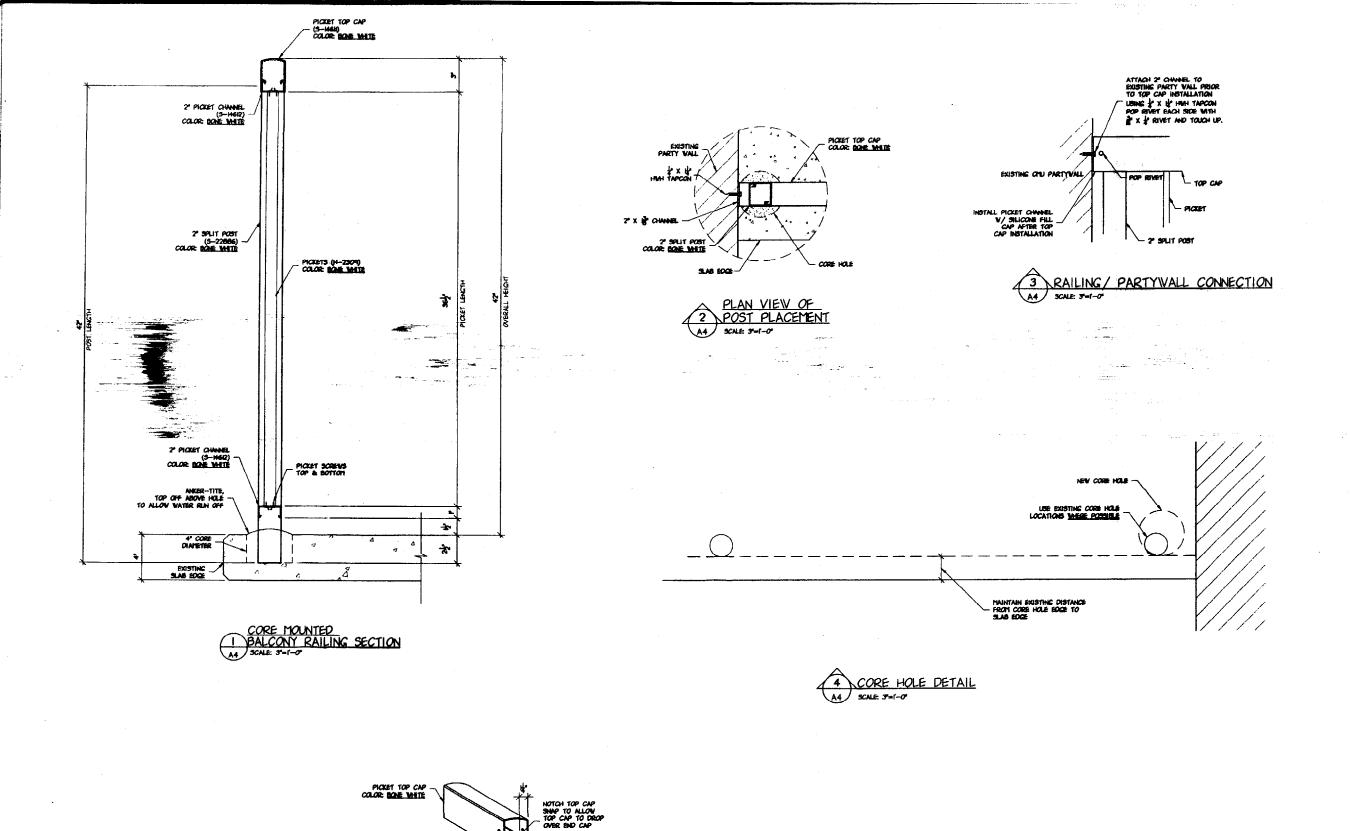

ATTACH ? CHANNELTO
EXISTING PARTY WALL
PRIOR TO TOP CAP
INSTALLATION USING

\$ X \$ HAM TAPCON

POINTETER HOLE DRILL THRU SCREW BOSS

5 TOP CAP INSTALLATION DETAIL
A4 SCALE 3-1-0

POP RIVET



HOWARD JOHNSON PORTLAND, MANE RALING SECTIONS & DETALS

CONFIDENTIAL

CONFIDENTIAL.
THESE PLANS, PRODUCT
DETAILS & DESIGNS AME
THE PROPERTY OF
AMERAL SYSTEMS, INC.
THEY ARE INTENDED FOR
THE PRESONAL USE OF
OUR CUSTOMER. PLANS,
DESIGNS & PRODUCTS AME
NOT TO 8E REPRODUCED
DISTRIBUTED OR UTILIZED
IN ANY WAY WITHOUT
AMERAL SYSTEMS, INC.

Revisions:

MARK DESCRIPTION DATE

Scole: 3"=1'-0" Drawn By: JRH

Approved By:

.109A-4