



FIRST FLOOR PLAN

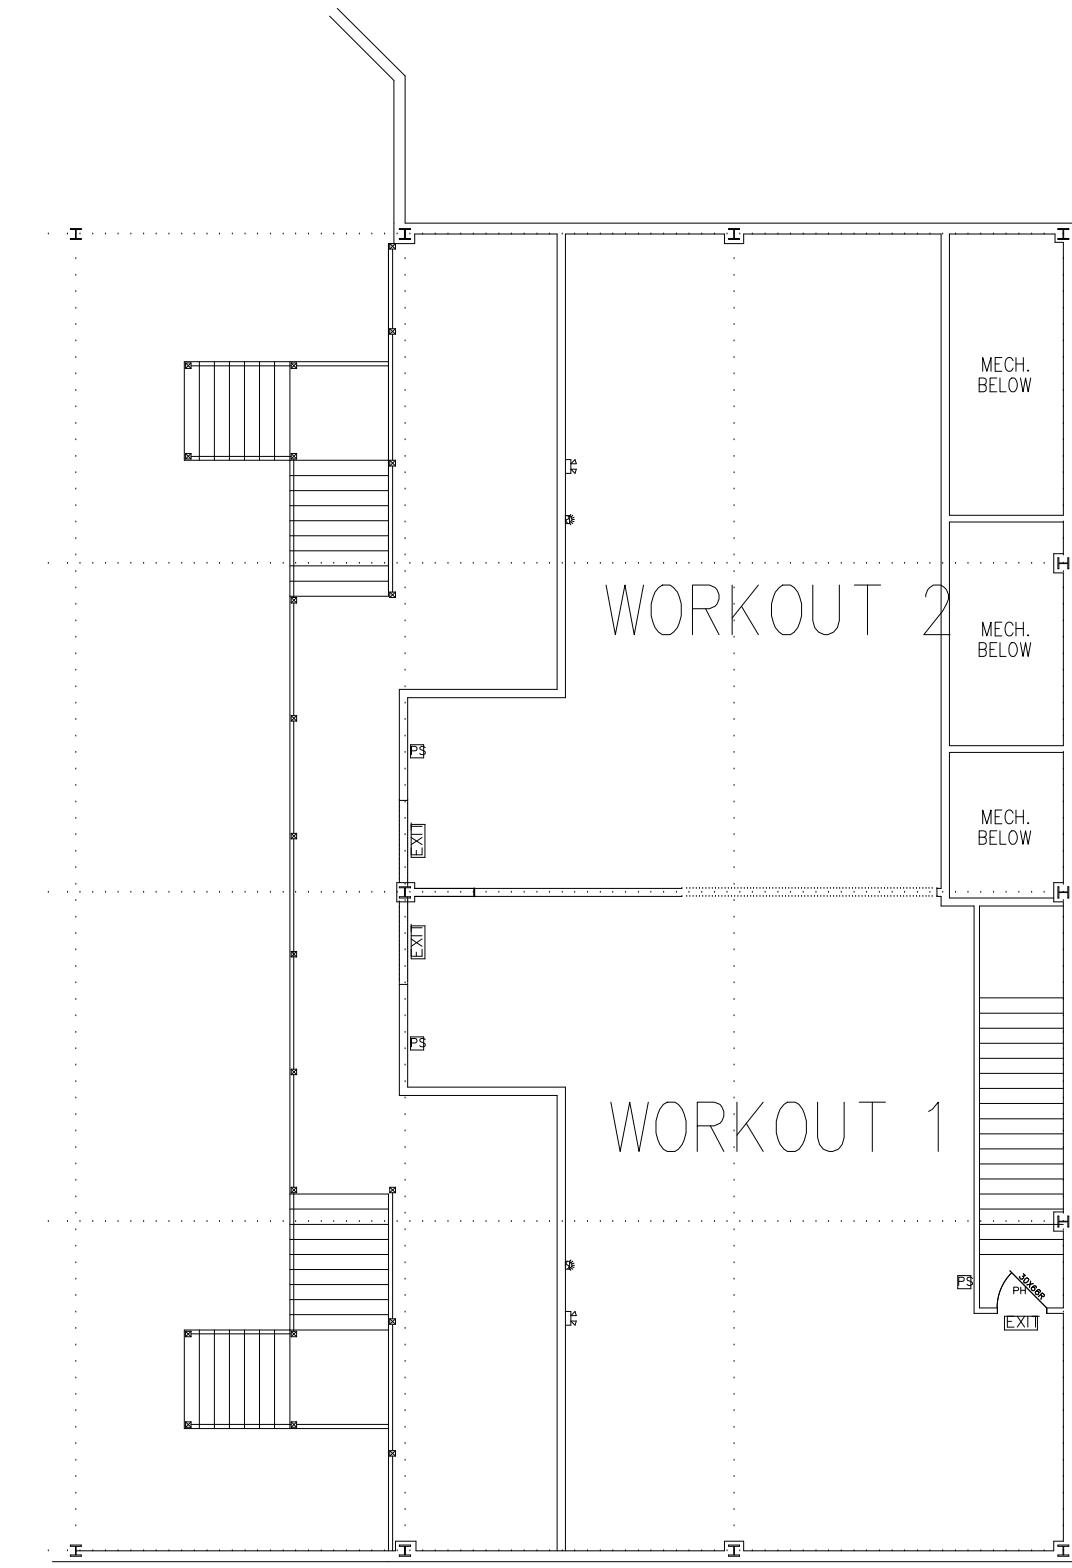

SECOND FLOOR PLAN

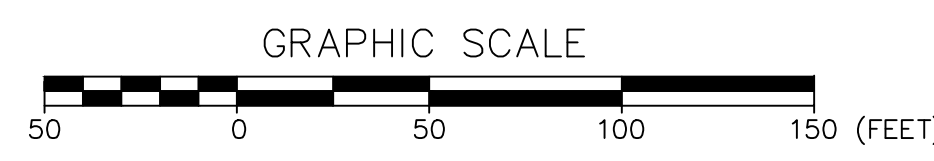

NO.	DESCRIPTION	DATE

**GYM LAYOUT  
PORTLAND SPORTS CENTER  
WARREN AVENUE, PORTLAND, MAINE**

FOR: JIM GRATTELO  
PORTLAND SPORTS REALTY, LLC  
550 WARREN AVE  
PORTLAND, MAINE 04103

**ATTAR ENGINEERING, INC.**  
CIVIL • STRUCTURAL • MARINE  
1284 STATE ROAD - ELIOT, MAINE 03903  
PHONE: (207)439-6023 FAX: (207)439-2128

SCALE: -	APPROVED BY:	DRAWN BY:
DATE: 9/23/14		REVISION : DATE
JOB NO: C068-14	CAD FILE: DOME_CEILING	SHEET 1