

THIS IS NOT A BOUNDARY SURVEY

INSPECTION OF PREMISES

I HEREBY CERTIFY TO CLASSIC TITLE,
PEOPLES HERITAGE AND ITS TITLE
INSURER

The monumentation is ~~not~~ in harmony with current deed description.

The building setbacks are ~~not~~ in conformity with town zoning requirements.

The land and ~~not~~ the dwelling do not appear to fall within the special flood hazard zone as delineated by the Federal Emergency Management Agency.

21 WOODVALE STREET
PORTLAND, MAINE



Job Number: 158-36

Inspection Date: 10-21-91

Scale: 1" = 20'

OWNER: GERARD A AND PAMELA F CONCANNON

N
6 feet to
Property line

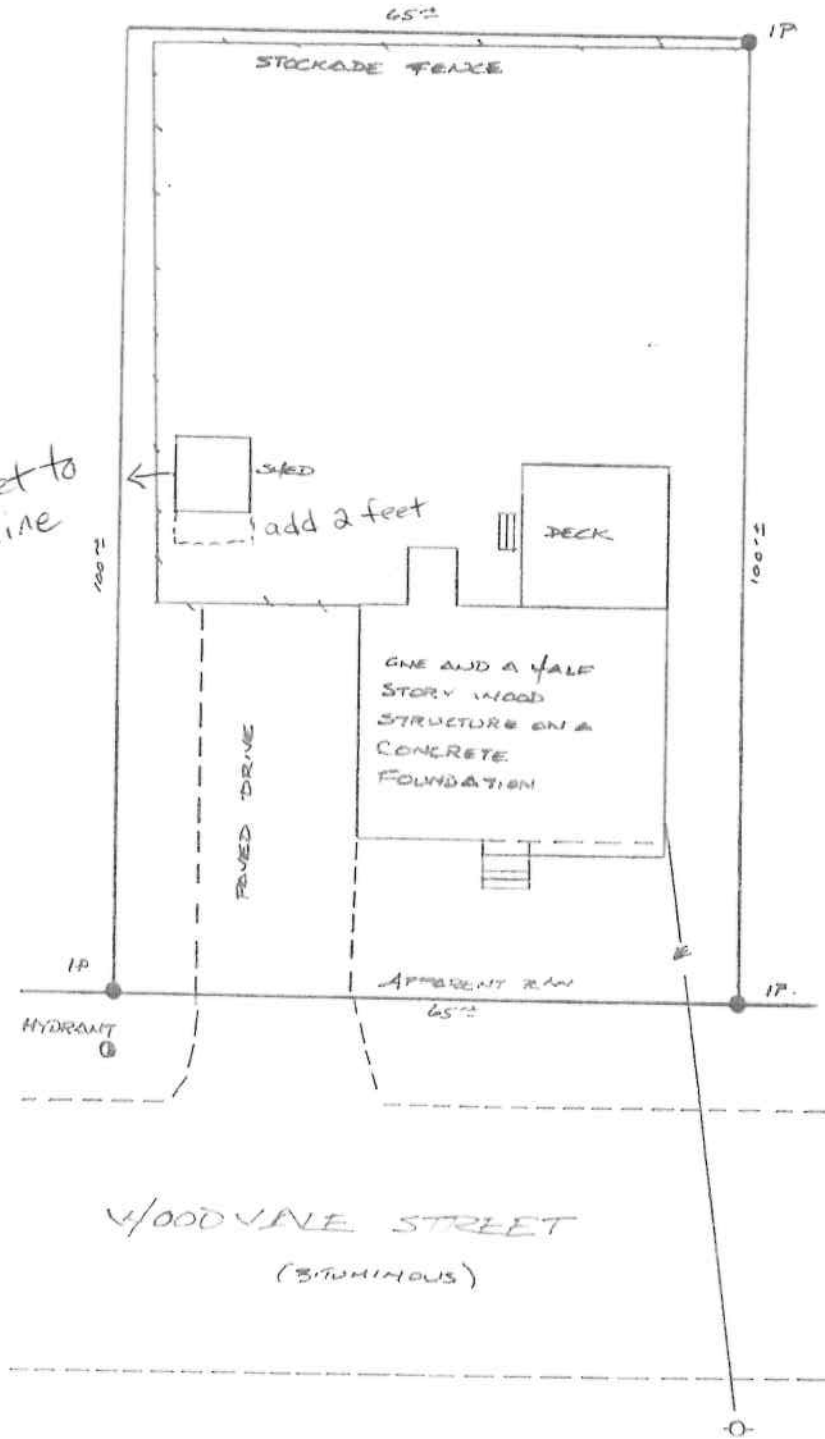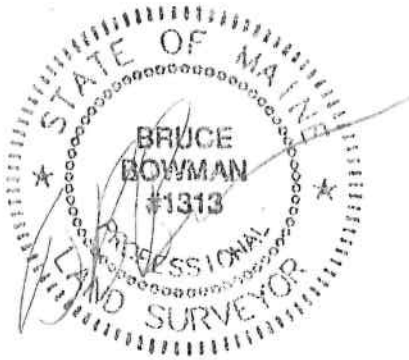

THIS PROPERTY IS SUBJECT TO ALL RIGHTS AND EASEMENTS OF RECORD. THOSE THAT ARE EVIDENT ARE SHOWN. THIS PLAN MIGHT NOT REVEAL CONFLICTS WITHIN ABUTTING DEEDS.

BRUCE R. BOWMAN, INC.
20 Forest Avenue
Cumberland, Maine
Phone: (207)829-3959

PLAN BOOK 45 PAGE 64 LOT 37
DEED BOOK 4787 PAGE 93 COUNTY CUMBERLAND

THIS PLAN IS NOT FOR RECORDING

Drawn by: JC